
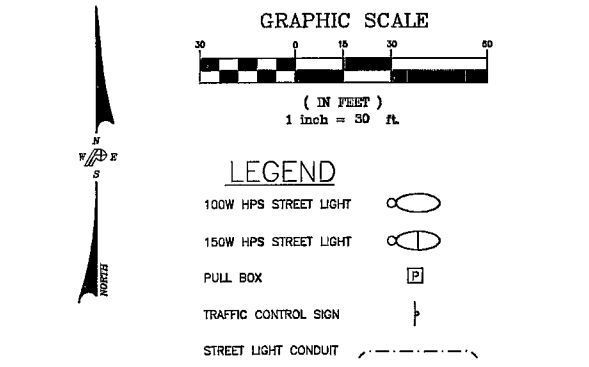


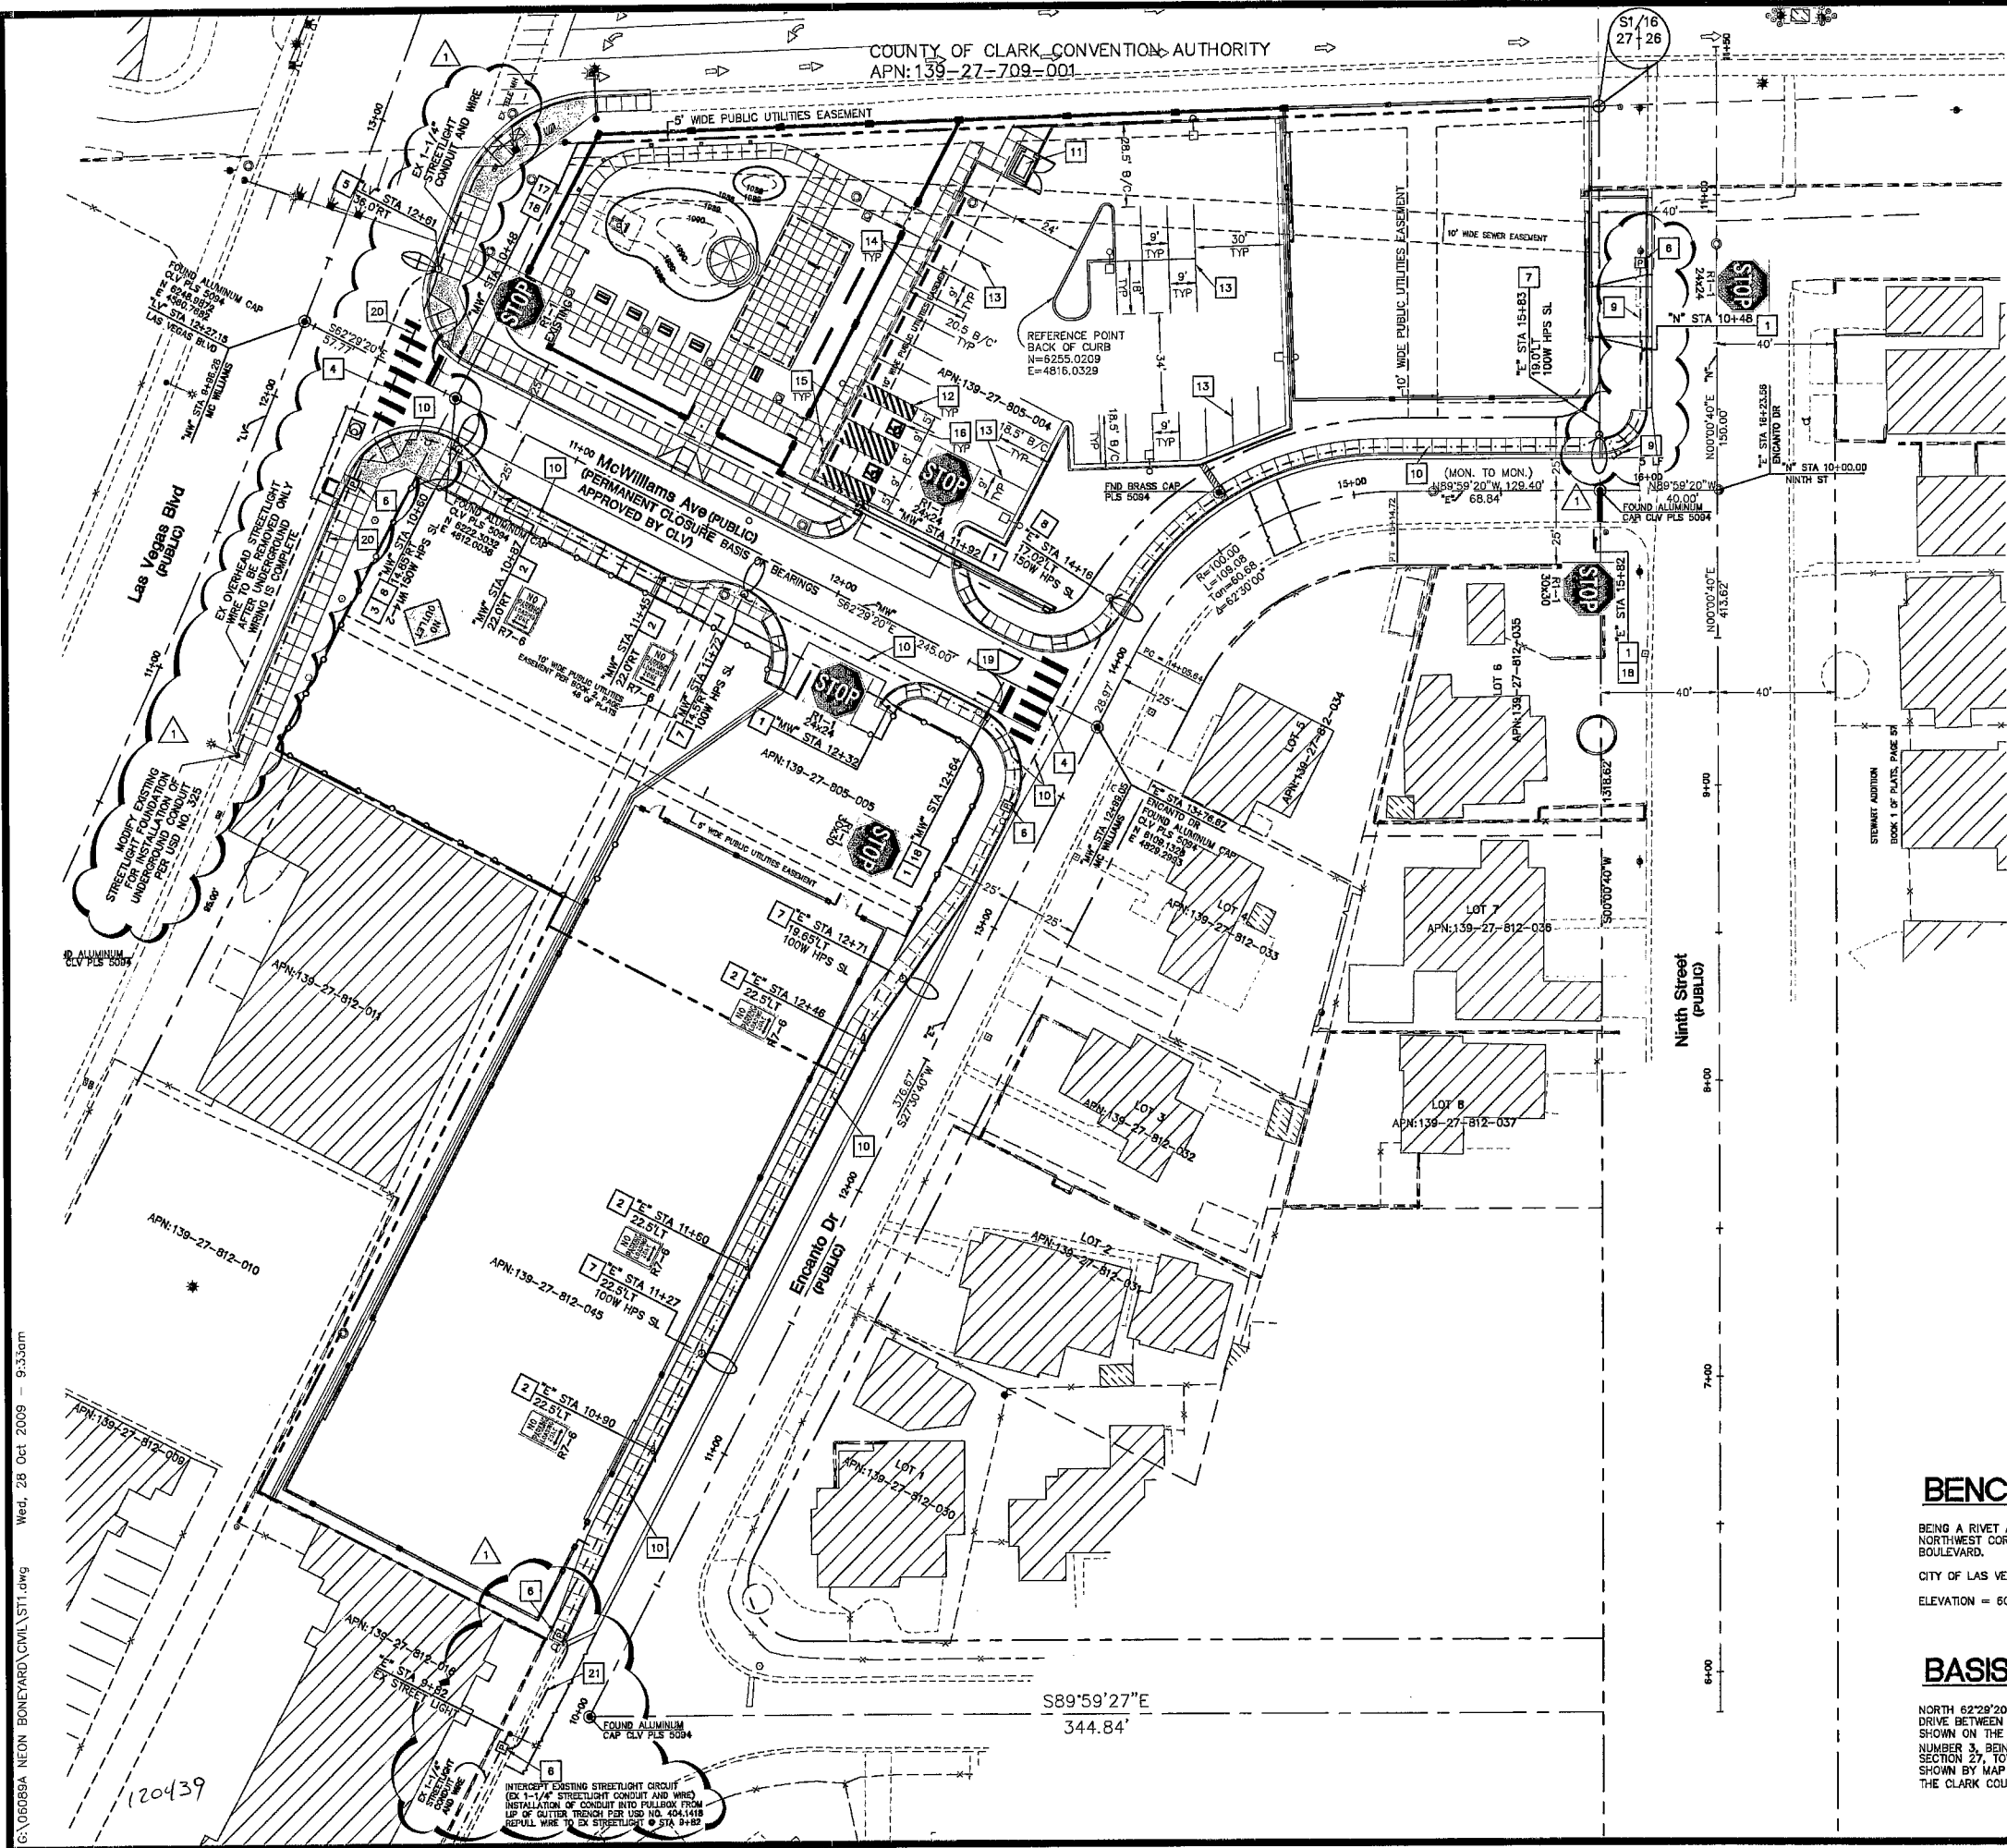

STREETLIGHT AND TRAFFIC NOTES

1. INSTALL PERMANENT SIGN (GROUND MOUNTED) R1-1, STOP SIGN PER USD 249A, SIZE PER PLAN.
2. INSTALL PERMANENT SIGN (GROUND MOUNTED) R7-8, "NO PARKING" SIGN PER USD 249A.
3. INSTALL PERMANENT SIGN (STREETLIGHT POLE MOUNTED) W14-2, "NO OUTLET" SIGN.
4. INSTALL NDOT TYPE 2 MARKING FILM FOR CROSSWALKS AND STOP BARS IN ACCORDANCE WITH USD NO. 254A.
5. RELOCATE EXISTING STREETLIGHT. CONSTRUCT NEW FOUNDATION PER USD NO. 321. INTERCEPT EXISTING 1-1/4" STREETLIGHT CONDUIT AND STUB INTO NEW STREETLIGHT FOUNDATION. INSTALL 2" PVC CONDUIT AND CONDUCTORS TO RELOCATED STREETLIGHT.
6. INSTALL NO. 3 1/2 PULL BOX PER USD NO. 326.
7. INSTALL 100 WATT HPS STREET LIGHT PER USD NO. 314, 319, & 321.
8. INSTALL 150 WATT HPS STREET LIGHT PER USD NO. 314, 319, & 321.
9. INSTALL 1-1/4" PVC CONDUIT (STUB AND CAP) WITH #8 PULLWIRE FOR FUTURE USE.
10. INSTALL 1-1/4" PVC CONDUIT WITH 2 #4 AND 1 #8 THW WIRES PER USD NO. 501.
11. INSTALL TRASH ENCLOSURE PER DETAILS SHOWN ON SHEETS DT2, DT3, AND DT4.
12. APPLY 4" WIDE DIAGONAL WHITE STRIPING AT 2' ON CENTER.
13. APPLY 4" WIDE WHITE STRIPING FOR PARKING STALL.
14. INSTALL PRECAST BUMPER BLOCK PER USD 238.
15. INSTALL PERMANENT SIGN (GROUND MOUNTED) R7-8 AND RPC-44 PER DETAILS SHEET DT1.
16. INSTALL HANDICAP SYMBOL PAVEMENT MARKING PER DETAIL 2 ON SHEET DT1.
17. RELOCATE SIGN TO NEW SIGN POST (GROUND MOUNTED), R1-1 STOP SIGN PER USD 249A.
18. RELOCATE SIGN TO NEW SIGN POST (GROUND MOUNTED), STREET NAME SIGNS PER USD 249.
19. INSTALL PERMANENT SIGNS (DATE MOUNTED) PER DETAILS 10 & 11 SHEET DT3.
20. INSTALL 2" PVC CONDUIT WITH 2 #4 AND 1 #8 THW WIRES.
21. INSTALL 1-1/4" PVC CONDUIT WITH 2 #4 AND 1 #8 THW WIRES IN LIP OF GUTTER TRENCH PER USD NO. 404.1419.

BENCHMARK

BEING A RIVET AND PLATE IN THE TOP OF CURB AT THE NORTHWEST CORNER OF BONANZA ROAD AND LAS VEGAS BOULEVARD.
CITY OF LAS VEGAS BENCHMARK NUMBER 1LV01 27SSE6
ELEVATION = 608.5592 (M) 1996.58 (F) (NAVD 88 DATUM)

BASIS OF BEARING

NORTH 62°29'20" WEST BEING THE CENTERLINE OF MCWILLIAMS DRIVE BETWEEN LAS VEGAS BOULEVARD AND ENCANTO DRIVE AS SHOWN ON THE FINAL MAP OF BILTMORE ADDITION ANNEX NUMBER 3, BEING IN THE SOUTHEAST QUARTER (SE1/4) OF SECTION 27, TOWNSHIP 20 SOUTH, RANGE 91 EAST, N.M.M., AS SHOWN BY MAP THEREOF IN BOOK 02, PAGE 48 OF PLATS, IN THE CLARK COUNTY RECORDER'S OFFICE, CLARK COUNTY, NEVADA

FOR REVISION A ONLY

Call before you dig
Call before you dig
Underground Overhead

REVISIONS		NO.		DATE:	DESCRIPTION	APPD