

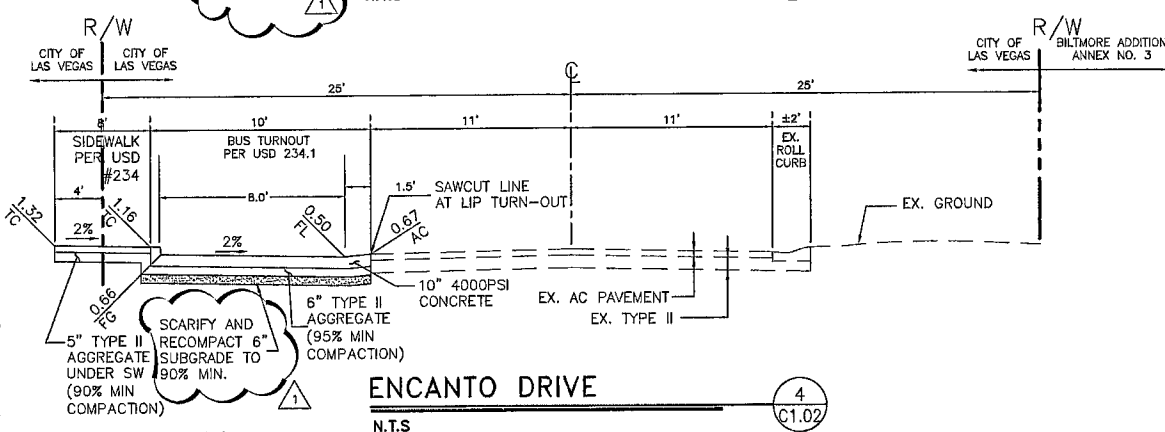
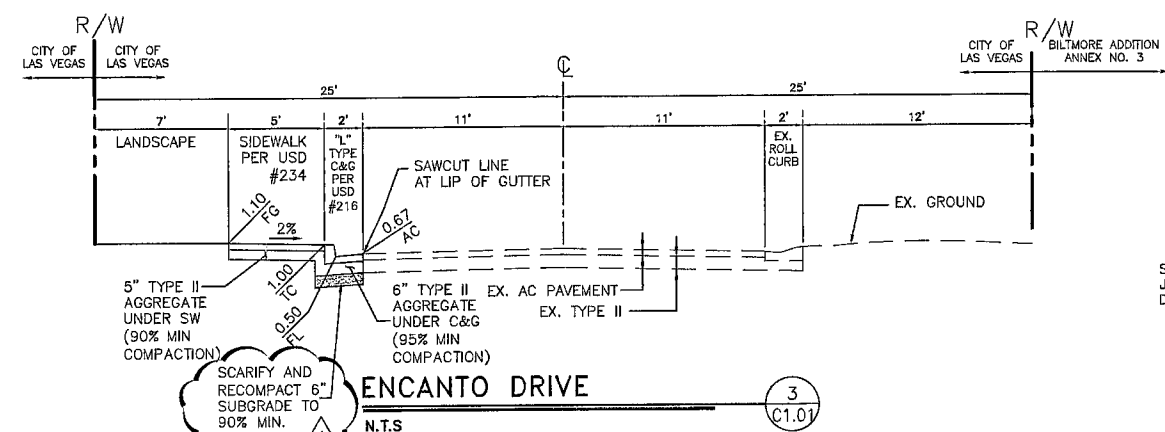
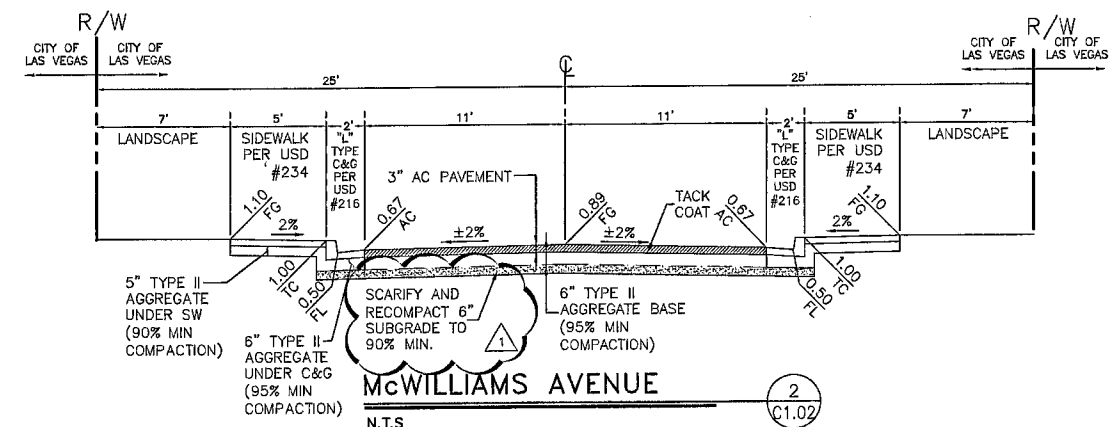
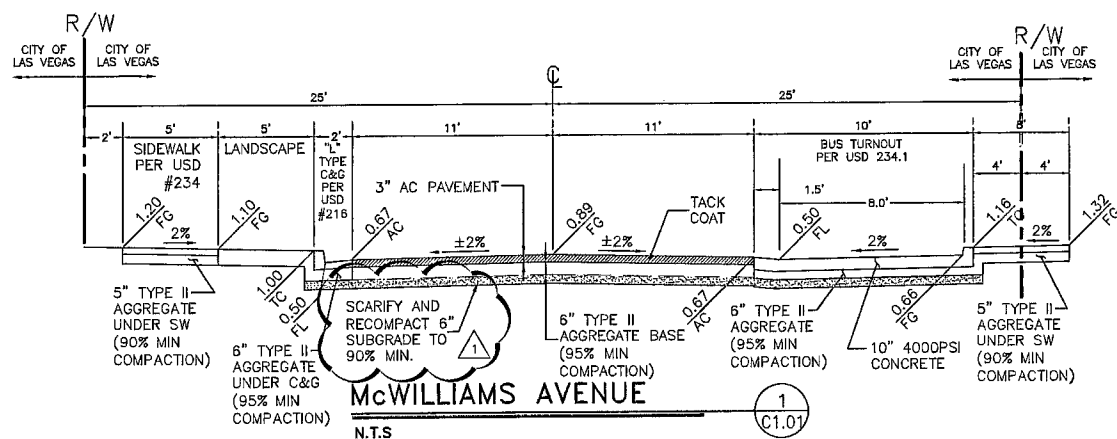
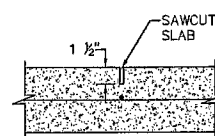
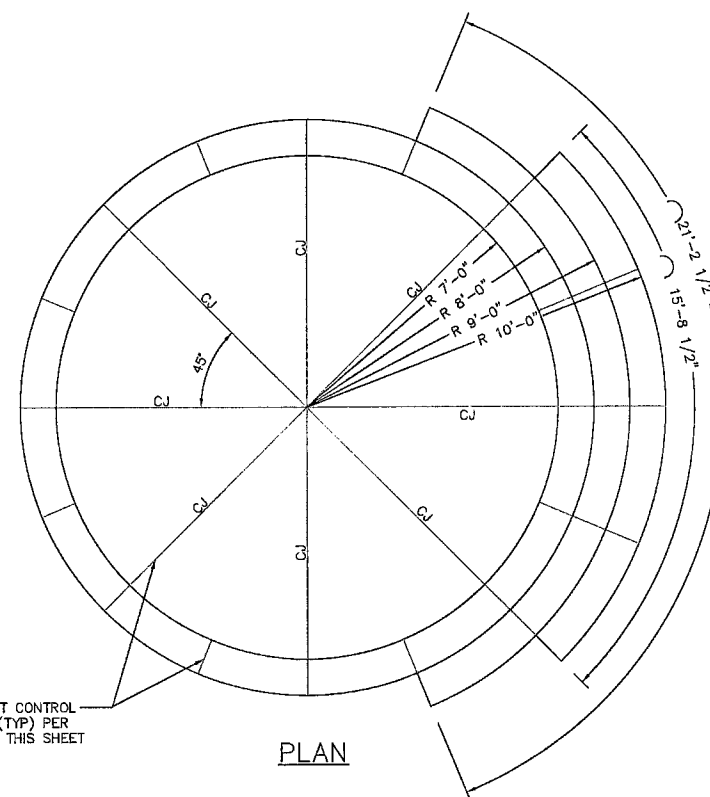
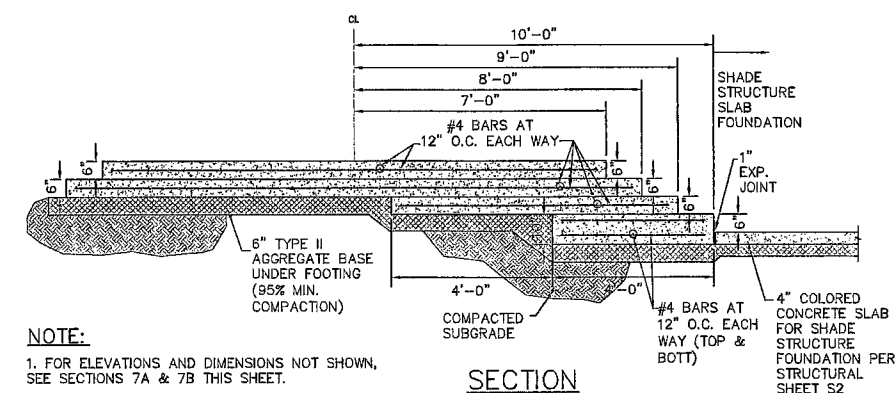


PARKING LOT
ASPHALT SECTION

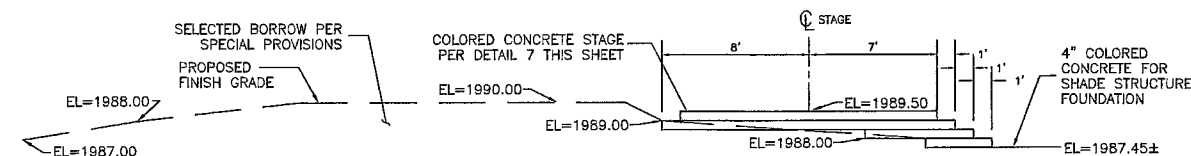



SAWCUT CONTROL JOINT

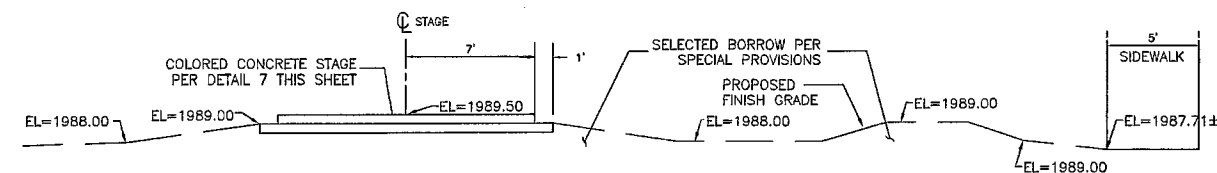

NOTE:

1. FOR ELEVATIONS AND DIMENSIONS NOT SHOWN, SEE SECTIONS 7A & 7B THIS SHEET.
2. REINFORCING IN 6" THICK SLAB SHALL BE CENTERED IN EACH SLAB. REINFORCING IN 10" THICK SLAB SHALL BE PLACED AS SHOWN - BOTTOM MAT SHALL HAVE 3" COVER FROM BOTTOM AND TOP MAT SHALL HAVE 2" COVER FROM TOP
3. COLORED CONCRETE STAGE COLOR DESCRIPTION AND FINISH PER LANDSCAPE PLANS.

COLORED CONCRETE STAGE (7)
N.T.S

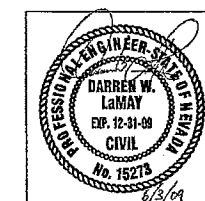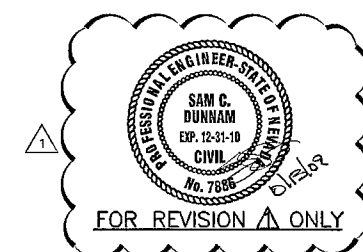[illegible]

DEPARTMENT OF PUBLIC WORKS

poggemeyer
design group, inc.
Rentsch #10 • Las Vegas, NV 89128 • p) 702.255.8100 • f) 702.255.8375

TITLE: NEON BONEYARD PARK

TYPICAL SECTIONS AND CONCRETE STAGE DETAILS

DRAWN BY: BMR/BKB/BAM	5/4/09
DESIGNED BY: BMR/BKB/BAM	5/4/09
CHECKED BY: WK/SCD	5/4/09
PROJECT NO: 060903C	SCALE: N.T.S.

HANSEN NO. 17994

Sheet

TY1
10 of 37
CLV DRAWING NO
676-12

Thu, 15 Oct 2009 - 4:45pm

AVOID HITTING OVERHEAD POWER LINES. IT'S COSTLY Call before you Dig Avoid hitting underground utility lines. It's costly.	AVOID HITTING UNDERGROUND POWER LINES. IT'S COSTLY Call before you Dig Avoid hitting underground utility lines. It's costly.
