


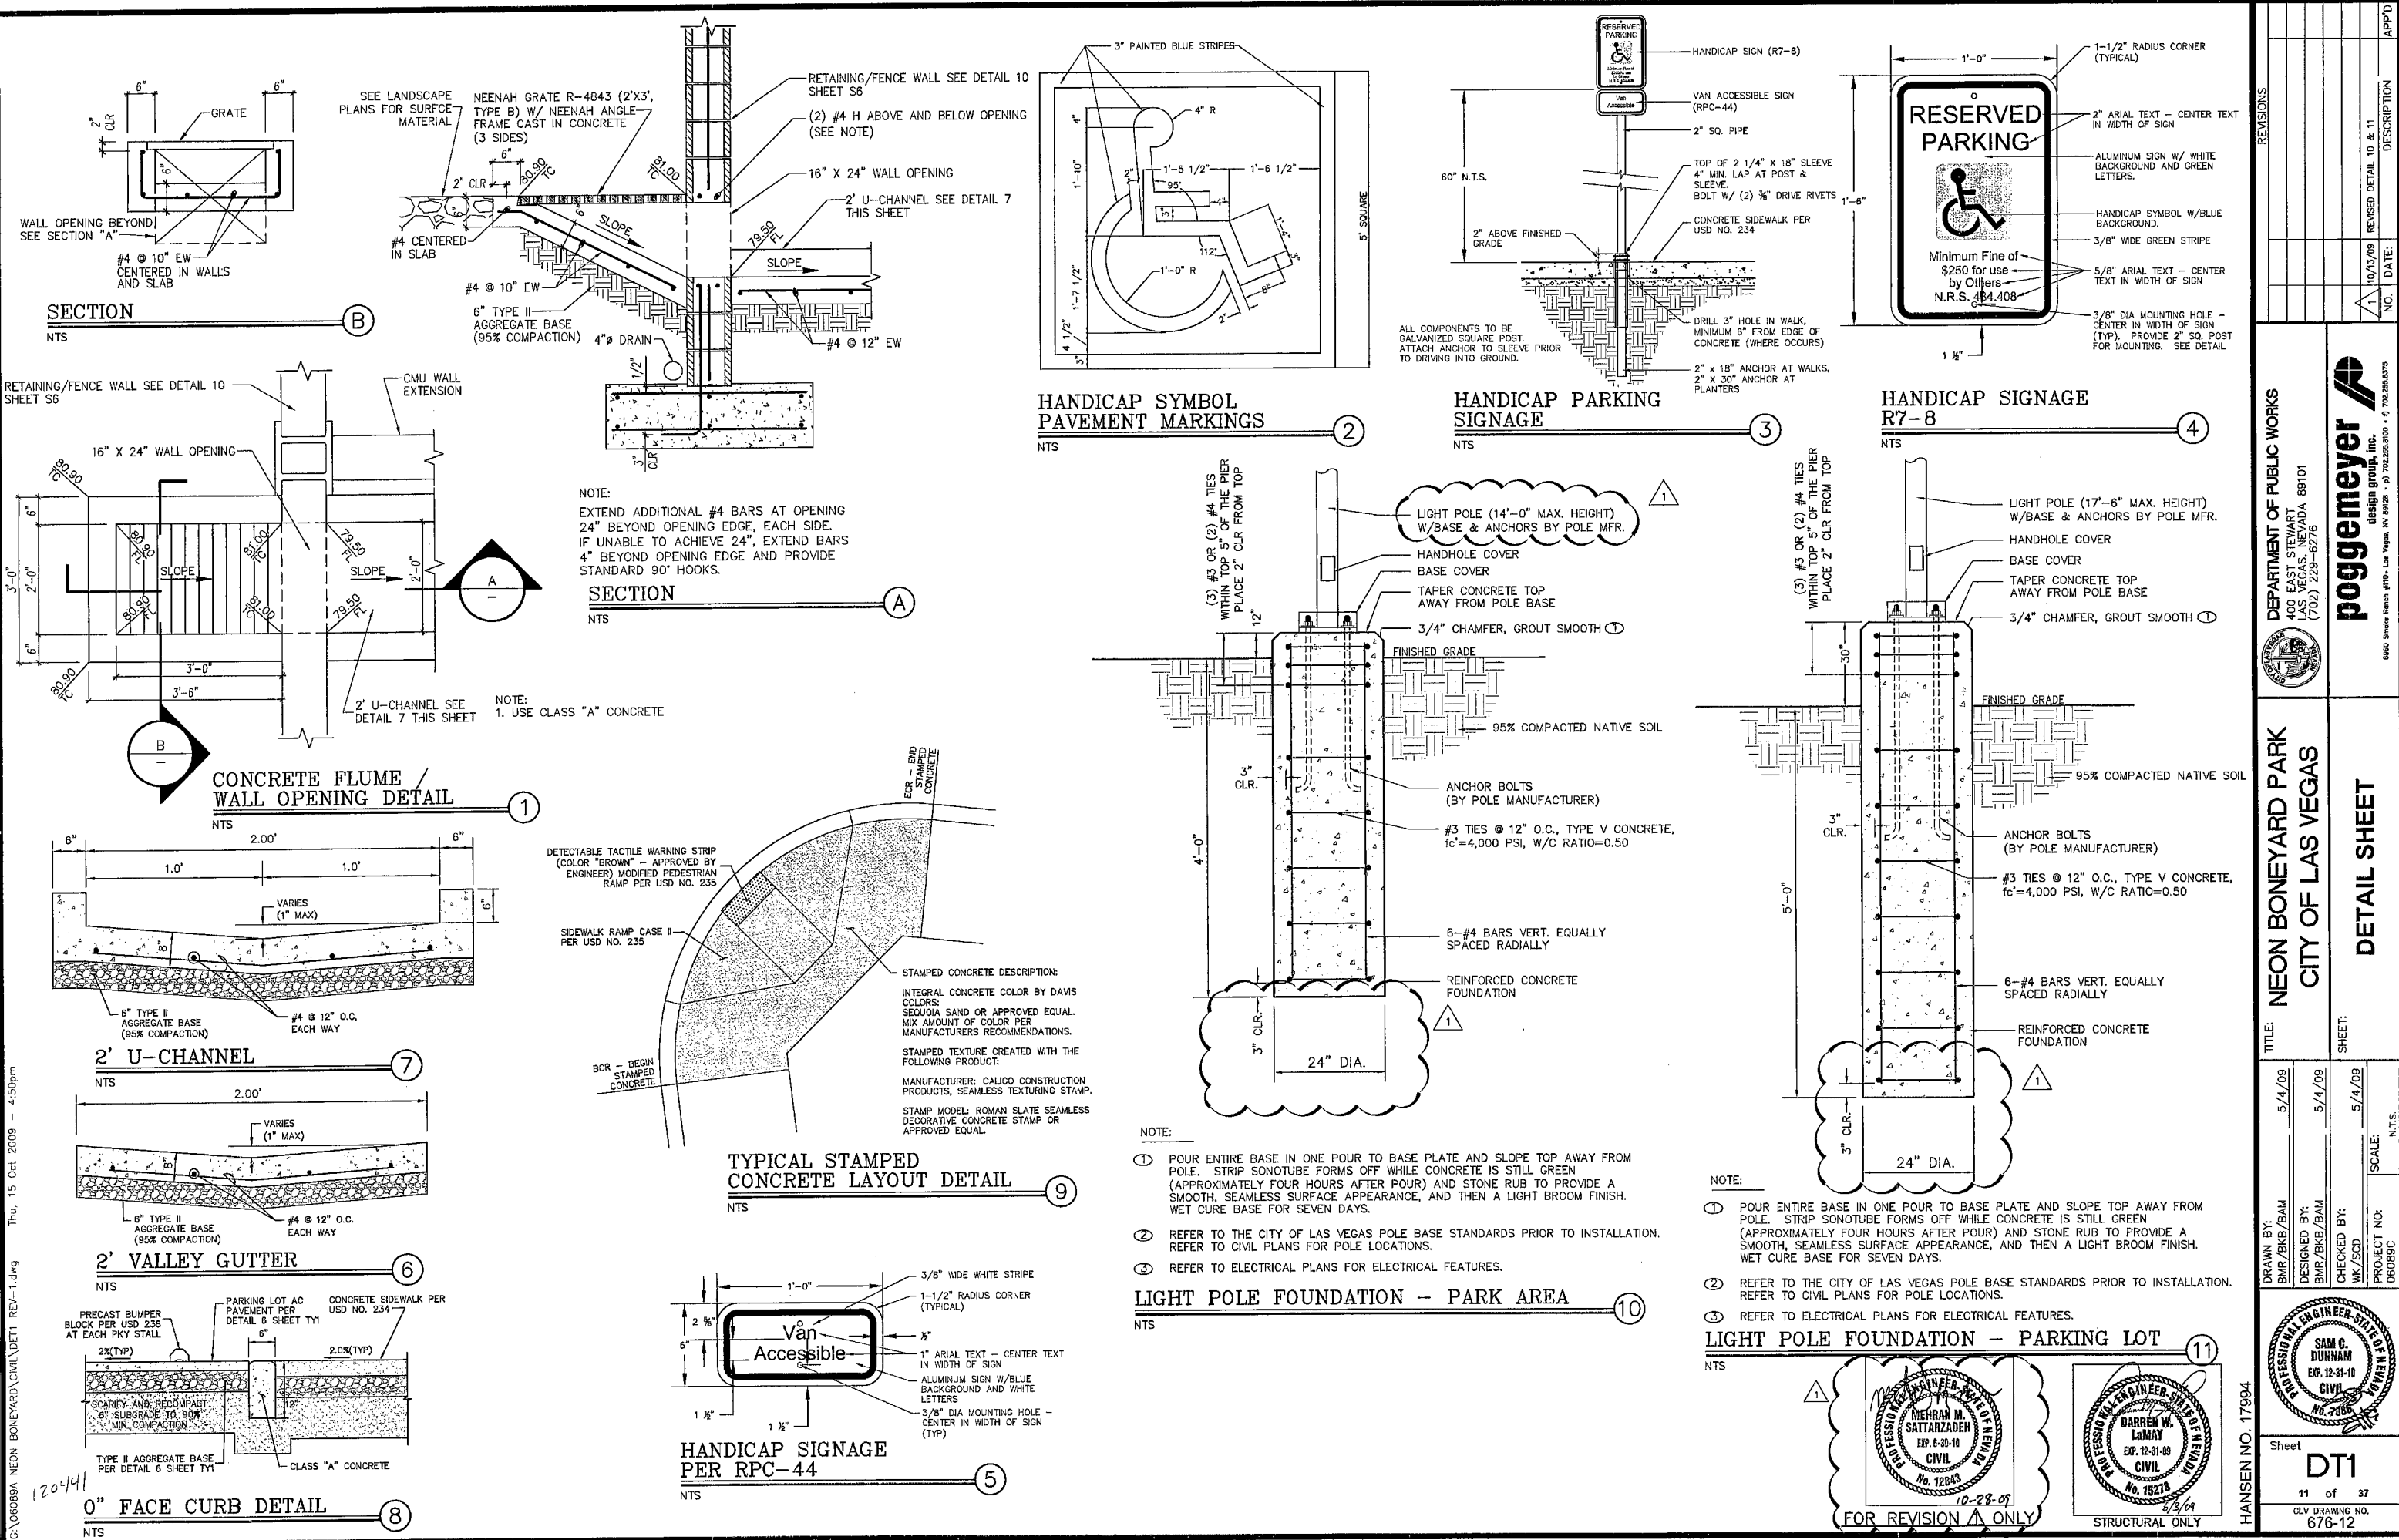

REVISIONS		DESCRIPTION	
NO.	DATE	REVISION	DETAIL 10 & 11
1	10/13/09	REVISED	

DEPARTMENT OF PUBLIC WORKS		poggemeyer design group, inc.	
EAST ST. STEWART		400 EAST ST. STEWART	
LAS VEGAS, NEVADA 89101		(702) 228-6276	
6050 Saddle Ranch #110 • Las Vegas, NV 89120 • p 702.265.6100 • f 702.265.6175			

TITLE: NEON BONEYARD PARK CITY OF LAS VEGAS		SHEET: 11	
DRAWN BY: BMR/BKE/BAM		5/14/09	
DESIGNED BY: BMR/BKE/BAM		5/14/09	
PROJECT NO: 06099C		SCALE: N.T.S.	

PROFESSIONAL ENGINEER - STATE OF NEVADA		PROFESSIONAL ENGINEER - STATE OF NEVADA	
MEHRAN M. SATTARZADEH		DARREN W. LAMAY	
EXP. 6-30-10		EXP. 12-31-08	
No. 12843		No. 15273	
10-28-09		6/3/04	
FOR REVISION ONLY		STRUCTURAL ONLY	

HANSEN NO. 17994		Sheet DT1	
		11 of 37	
		CLV DRAWING NO. 676-12	