



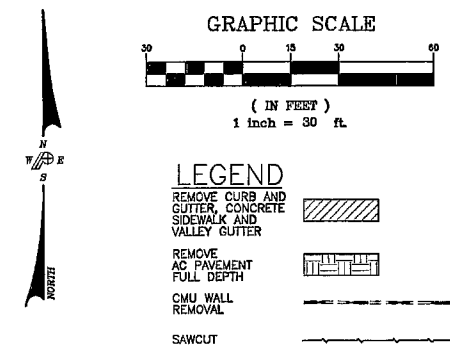

DEMOLITION NOTES

- 1 REMOVE CURB AND GUTTER
- 2 REMOVE 6-FOOT CMU WALL
- 3 REMOVE AND SALVAGE FENCE. CONTACT CLV OFFICE OF CULTURAL AFFAIRS TO COORDINATE REMOVAL OF EXISTING RENTAL FENCE. INSTALL A SIMILAR SECURITY FENCE IN ACCORDANCE WITH THE SPECIFICATIONS. THOSE PORTIONS OF SECURITY FENCE THAT WILL BE REPLACED WITH CMU WALL WITH THIS CONTRACT CAN BE TEMPORARY. THE OTHER PORTIONS OF FENCE SHALL REMAIN AS PERMANENT SECURITY FENCINGS.
- 4 REMOVE CONCRETE SIDEWALK
- 5 REMOVE CROSS GUTTER SPANDREL - PROTECT IN PLACE EXISTING 3.0 FOOT CROSS GUTTER BETWEEN EXISTING CONSTRUCTION JOINTS PER USD NO. 228
- 6 PROTECT EXISTING JOINT USE POLES AND OVERHEAD UTILITIES IN PLACE. TO BE REMOVED BY NV ENERGY, EMBARQ, AND COX.
- 7 REMOVE AC PAVEMENT. ASPHALT REPLACEMENT PER SECTIONS 1 AND 2 ON SHEET 11.
- 8 REMOVE SIGN POST AND FOUNDATION
- 9 PROTECT EXISTING TRAFFIC SIGNAL IN PLACE
- 10 PROTECT EXISTING HYDRANT IN PLACE - ADJUST TO GRADE
- 11 REMOVE EXISTING DRIVEWAY AND CONCRETE
- 12 PROTECT EXISTING MANHOLE COVER IN PLACE AND ADJUST TO GRADE AS NECESSARY
- 13 EXISTING WATER METER & BOX AND SERVICE LATERAL. SEE NOTE 5 SHEET UT1
- 14 PROTECT EXISTING TRAFFIC PULL BOX IN PLACE
- 15 PROTECT EXISTING TRAFFIC SIGNAL CONTROL CABINET IN PLACE
- 16 PROTECT EXISTING FIBER OPTIC PULL BOX IN PLACE ADJUST TO GRADE
- 17 EXISTING WATER VALVE, SEE NOTE 12 SHEET UT1
- 18 REMOVE EXISTING DROP INLET. SEE SHEET PP-1 FOR FOR REPLACEMENT.
- 19 REMOVE AND SALVAGE CONCRETE BARRICADES AND DELIVER TO THE CITY OF LAS VEGAS EAST SERVICE YARD AT 3104 EAST BONANZA ROAD. CALL CLV FIELD OPERATIONS DEPT. AT (702) 249-3063 TO ARRANGE DELIVERY TIME. GIVE 7 DAYS PRIOR NOTICE. CONTRACTOR MUST HAVE A MEANS TO UNLOAD EQUIPMENT AND SHALL BE RESPONSIBLE FOR ALL DAMAGES INCURRED IN THIS PROCESS.
- 20 REPLACE EXISTING CONCRETE SEWER MANHOLE COVER w/ NEW FRAME & COVER PER DOWNS DWS. NO. SD-2 (ADJUST TO GRADE WITH NEW GRADE RINGS AS NEEDED).
- 21 REMOVE EXISTING TREES
- 22 PROTECT EXISTING GAS MAIN
- 23 EXISTING WATER METER, SEE NOTE 11, SHEET UT1
- 24 RELOCATE STREET NAME SIGNS PER SHEET ST1
- 25 RELOCATE STOP SIGN PER SHEET ST1
- 26 RELOCATE STREETLIGHT. SEE SHEET ST1 FOR NEW LOCATION
- 27 EXISTING POWER POLE TO REMAIN. PROTECT IN PLACE
- 28 SAWCUT AND REMOVE EXISTING AC PAVEMENT TO LIMITS SHOWN ON PLANS
- 29 SALVAGE JOSHUA TREE IN ACCORDANCE WITH SPECIAL PROVISIONS SECTION 212

NOTE TO CONTRACTOR
CONTRACTOR TO INSTALL NV ENERGY, EMBARQ, AND COX COMMUNICATIONS FACILITIES. SAWCUT, TRENCH, AND REPLACE EXISTING PAVEMENT, LANDSCAPING, AND IRRIGATION SYSTEMS AS REQUIRED FOR UTILITY ENTITY FACILITY INSTALLATION IN ACCORDANCE WITH ATTACHED UTILITY ENTITY PLANS.

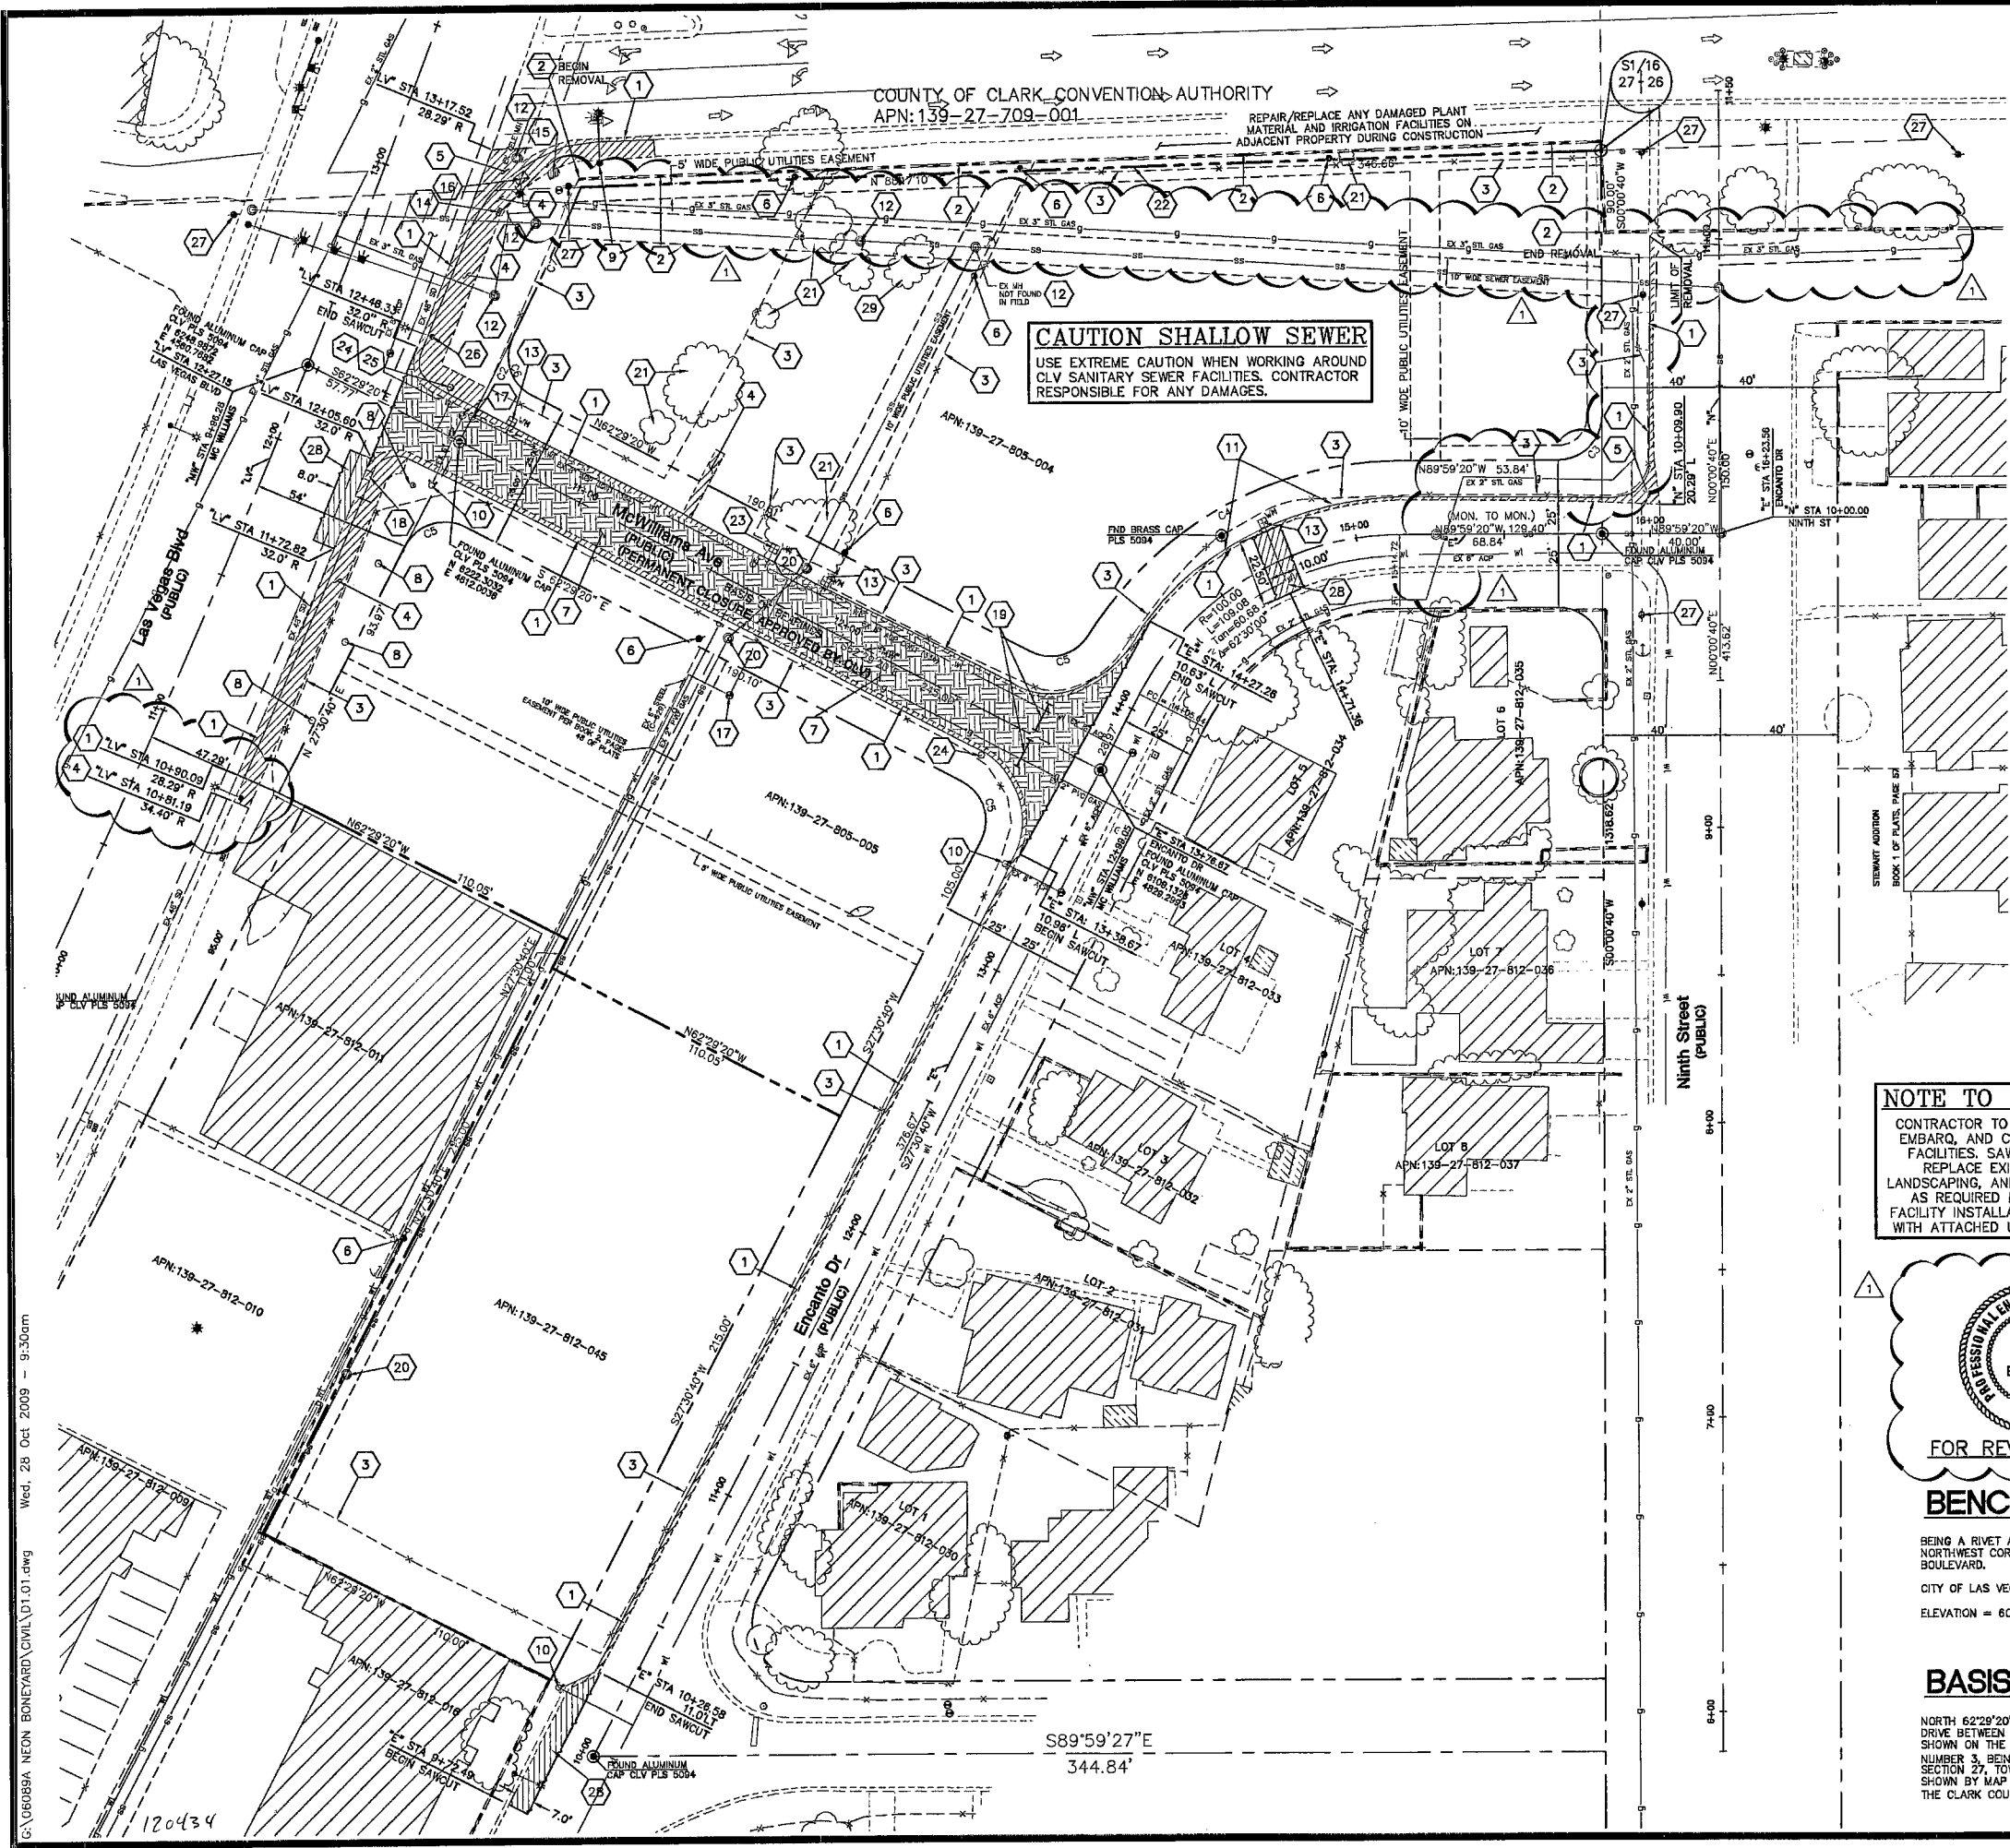

FOR REVISION A ONLY

BENCHMARK

BEING A RIVET AND PLATE IN THE TOP OF CURB AT THE NORTHWEST CORNER OF BONANZA ROAD AND LAS VEGAS BOULEVARD.
CITY OF LAS VEGAS BENCHMARK NUMBER 11V01 27SS58
ELEVATION = 608.5592 (M) 1996.58 (F) (NAVD 88 DATUM)

BASIS OF BEARING

NORTH 62°29'20" WEST BEING THE CENTERLINE OF MCWILLIAMS DRIVE BETWEEN LAS VEGAS BOULEVARD AND ENCANTO DRIVE AS SHOWN ON THE FINAL MAP OF BILTMORE ADDITION ANNEX NUMBER BEING IN THE SOUTHEAST QUARTER (SE1/4) OF SECTION 27, TOWNSHIP 20 SOUTH, RANGE 91 EAST, M.D.M., AS SHOWN BY MAP THEREOF IN BOOK 02, PAGE 48 OF PLATS, IN THE CLARK COUNTY RECORDER'S OFFICE, CLARK COUNTY, NEVADA

PROPERTY LINE CURVE TABLE					
CURVE	RADIUS	LENGTH TANGENT	CHORD	DELTA	
C1	1040.00	74.63	37.33	74.61	4°06'41"
C2	1040.00	18.78	9.39	18.78	1°02'05"
C3	15.00	23.58	15.00	21.21	90°00'00"
C4	125.00	126.49	69.28	121.17	57°38'50"
C5	15.00	22.38	13.88	20.38	85°28'50"
C6	15.00	23.29	14.73	21.02	88°57'58"
C7	1040.00	55.85	27.93	55.84	3°04'36"



REVISIONS

NO.	DATE	DESCRIPTION
1	10/13/09	ADDED ADDITIONAL SIDEWALK REMOVAL AND REVISIONS

DEPARTMENT OF PUBLIC WORKS
400 EAST STEWART
LAS VEGAS, NEVADA 89101
(702) 229-6276

poggemeyer
design group, inc.
6950 Saddle Road #110 • Las Vegas, NV 89123 • P: 702.255.8100 • F: 702.255.8575

**NEON BONEYARD PARK
CITY OF LAS VEGAS**

DEMOLITION PLAN

TITLE: 5/4/09

DRAWN BY: BMR/BKB/BAM

DESIGNED BY: BMR/BKB/BAM

CHECKED BY: WK/SCD

PROJECT NO: 06089C

SCALE: 1"=30'

HANSEN NO. 17994

Sheet **D1.01**

4 of 37

CLV DRAWING NO. 676-12