
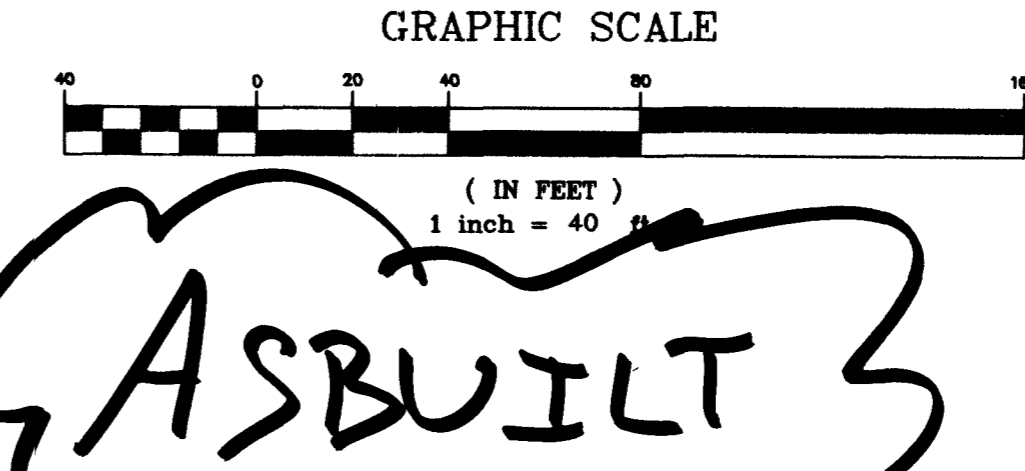


- SANITARY SEWER NOTES:** (NOT ALL SANITARY SEWER NOTES ARE USED IN THIS DRAWING)
- (ALT. A): INSTALL 12 INCH PVC SANITARY SEWER.
(ALT. B): INSTALL 8 INCH PVC SANITARY SEWER.
 - CONSTRUCT STANDARD ECCENTRIC MANHOLE (48" O.C.) PER DCSWCS DRAWING NO. SD-1; INSTALL CONCRETE COLLAR PER SD-2.
 - SAWCUT AND REMOVE EXISTING AC PAVT. INSTALL PIPE IN TRENCH SECTION & REPLACE PAVT. PER CCAUSD NO. 504.
 - 12-INCH AND 8-INCH WATER LINES PER MARSHALL C. DARNELL ELEMENTARY SCHOOL IMPROVEMENT PLANS (BY NEVADA BY DESIGN) (NOT A PART).
 - CONSTRUCT DEEP MANHOLE W/ LANDING PER DETAIL ON SHEET C2.06.
 - INSTALL PIPE IN TRENCH SECTION PER CCAUSD NO. 504.
 - 18" STORM DRAIN & 8" BLEEDER LINE PER MARSHALL C. DARNELL ELEMENTARY SCHOOL IMPROVEMENT PLANS (BY NEVADA BY DESIGN) (NOT A PART).

SCALE: 1" = 40' HORIZ.
1" = 4' VERT.

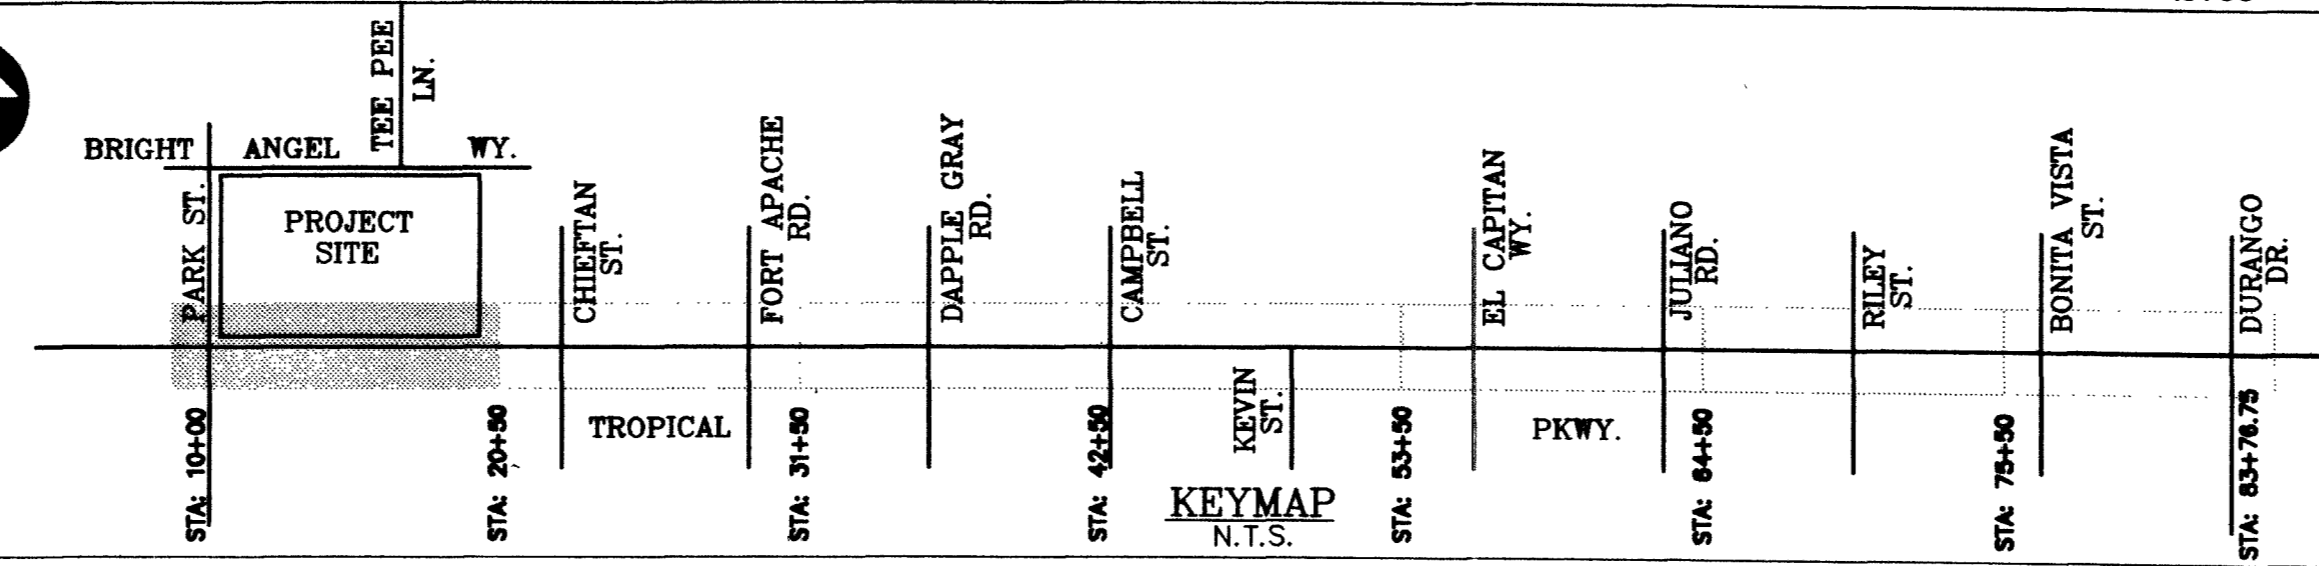

MATCH SHEET C2.01 -- STATION 20+50




| REVISIONS | | | |
|-----------|-------------|------|----|
| REV | DESCRIPTION | DATE | BY |
| | | | |
| | | | |

© JMA ARCHITECTURE STUDIOS 1999

AVOID OVERHEAD POWER LINE CONTACT. IT'S COSTLY. **Call before you Overhead** 1-702-593-6111 NEVADA-POWER ENVIRONMENT AND SAFETY SERVICES DEPARTMENT

AVOID CUTTING UNDERGROUND UTILITY LINES. IT'S COSTLY. **Call before you Dig** 1-800-227-2600 UNDERGROUND SERVICE (USA)

DO NOT SCALE DRAWINGS

All designs, arrangements and plans indicated or presented by this drawing, or instruments of service, are owned by and the property of the ARCHITECTS. To alter these documents for any project by anyone other than the original architect is a violation of NRS 623. The plans and/or specifications shall be restricted to the original site for which they were prepared and publication thereof is expressly limited to such use. Reproduction, publication or reuse by any method in whole or in part, is prohibited. None of such designs, arrangements or plans shall be used by or disclosed to any person, firm, agency, or corporation without the written permission of ARCHITECTS. Visual contact with these plans and specifications shall constitute prima facie evidence of acceptance of these restrictions.

STATE OF NEVADA
REGISTERED PROFESSIONAL CIVIL ENGINEER
No. 6951
ANDERSON

DATE: 03-21-2001
SCALE: AS SHOWN
SHEET NO.: 04 OF 10
DRAWING NUMBER: 715-133

NEVADA BY DESIGN
427 S. Maryland Parkway
Las Vegas, Nevada 89119
702.488.1525 - fax
702.488.1526 - tel

JMA ARCHITECTURE STUDIOS
10100 CENTENNIAL CROSS DRIVE | SUITE 1000 | LAS VEGAS, NEVADA 89144 | 702.488.1525

CLARK COUNTY SCHOOL DISTRICT
CONSTRUCTION MANAGEMENT
4828 PEARL ST.
LAS VEGAS, NEVADA 89121

MARSHALL C. DARNELL ELEMENTARY SCHOOL
(AKA TROPICAL / TEE PEE ELEMENTARY SCHOOL)

SEWER PLAN AND PROFILE STA: 10+00 - 20+50

SHEET NO. **C2.00**
SHEET 04 of 10
DRAWING NUMBER
715-133