



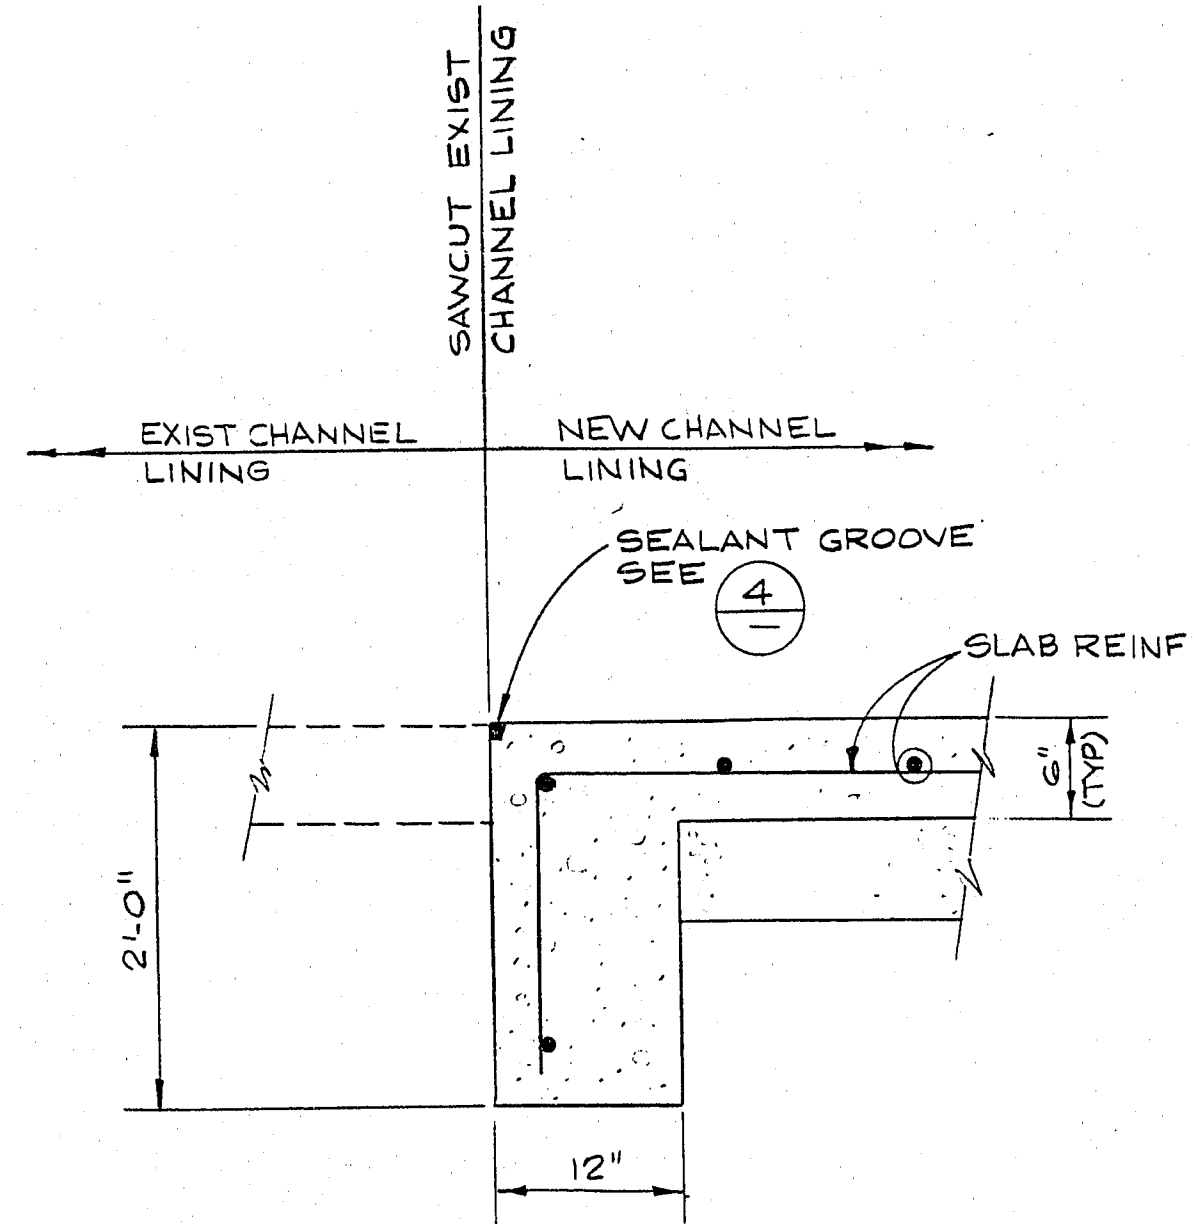


SECTION
SCALE: 1"=1'-0"

A

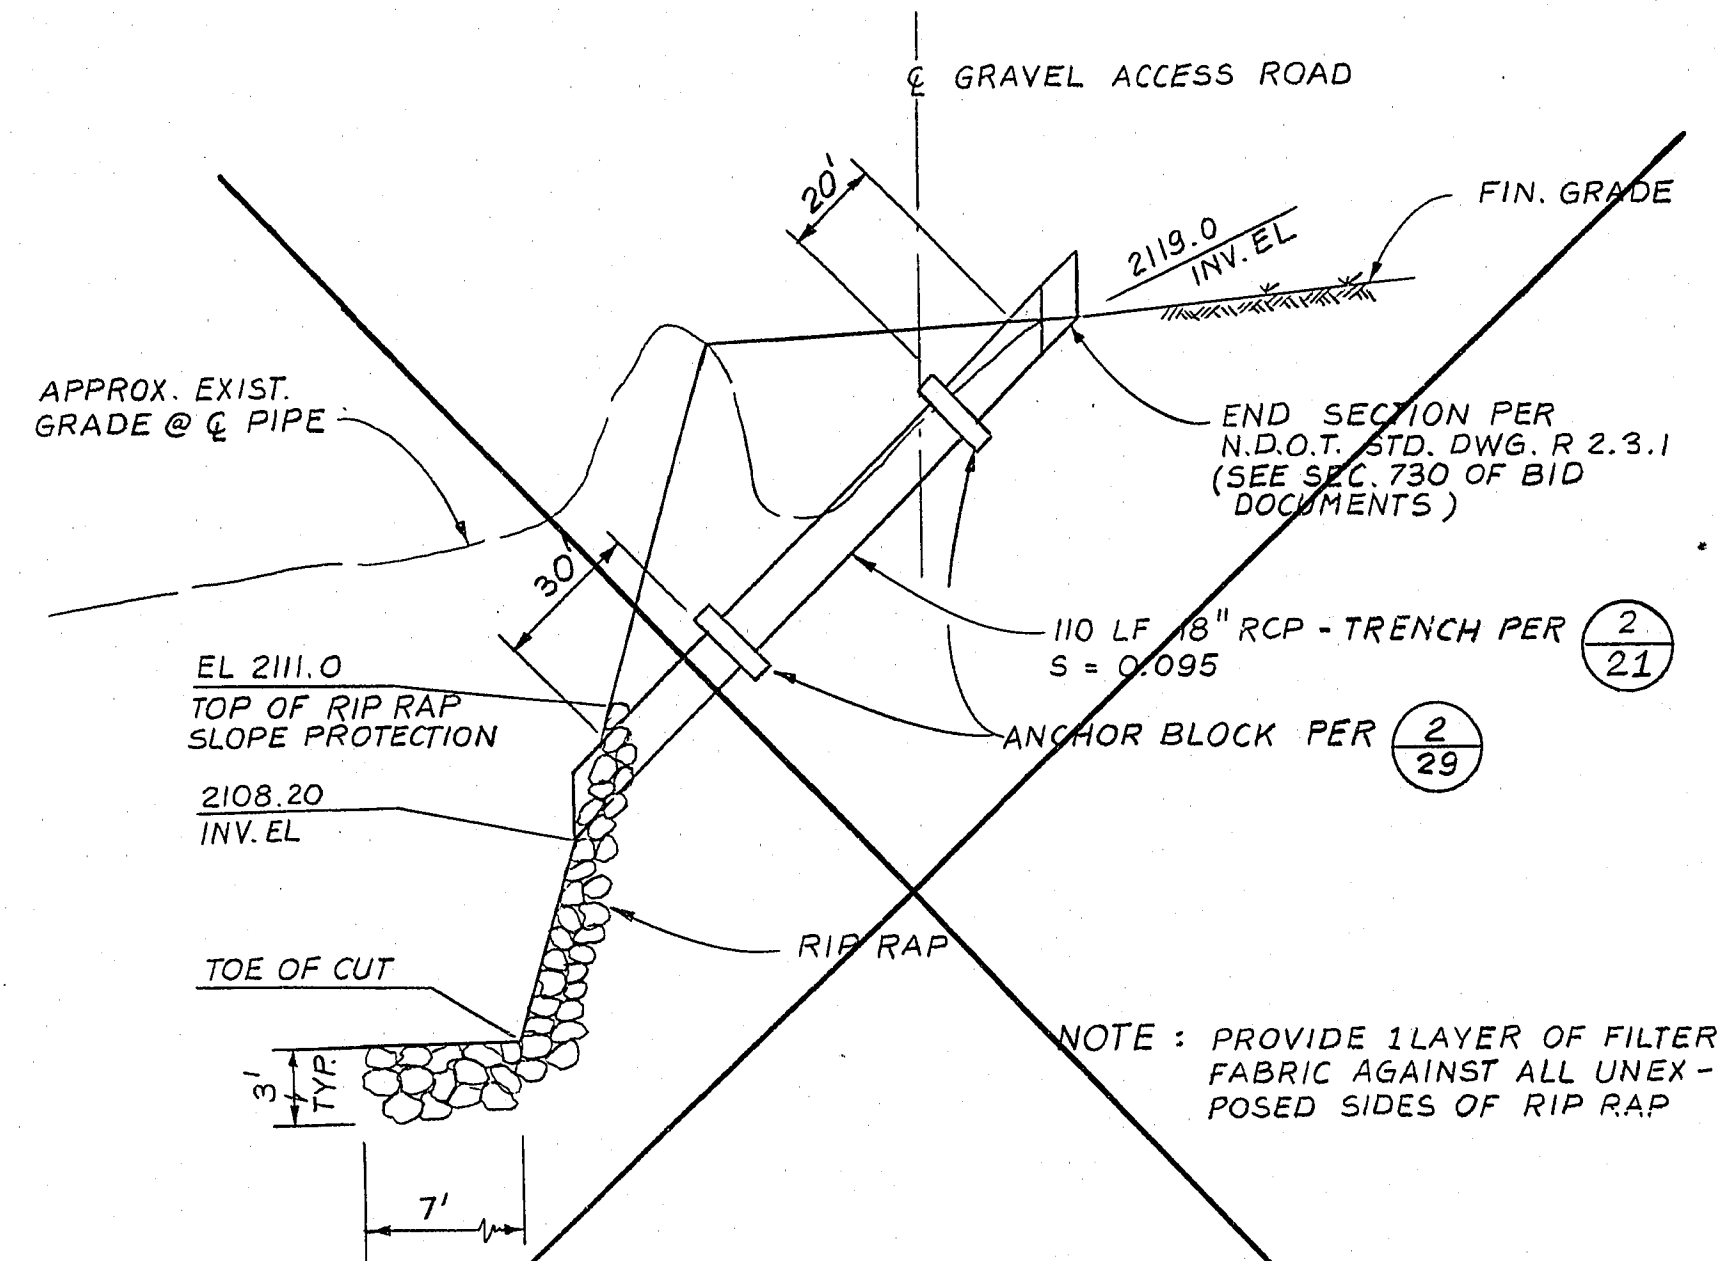

18" RCP INLET PROFILE
SCALE: HORIZ. 1"=40'
VERT. 1"=4'

1

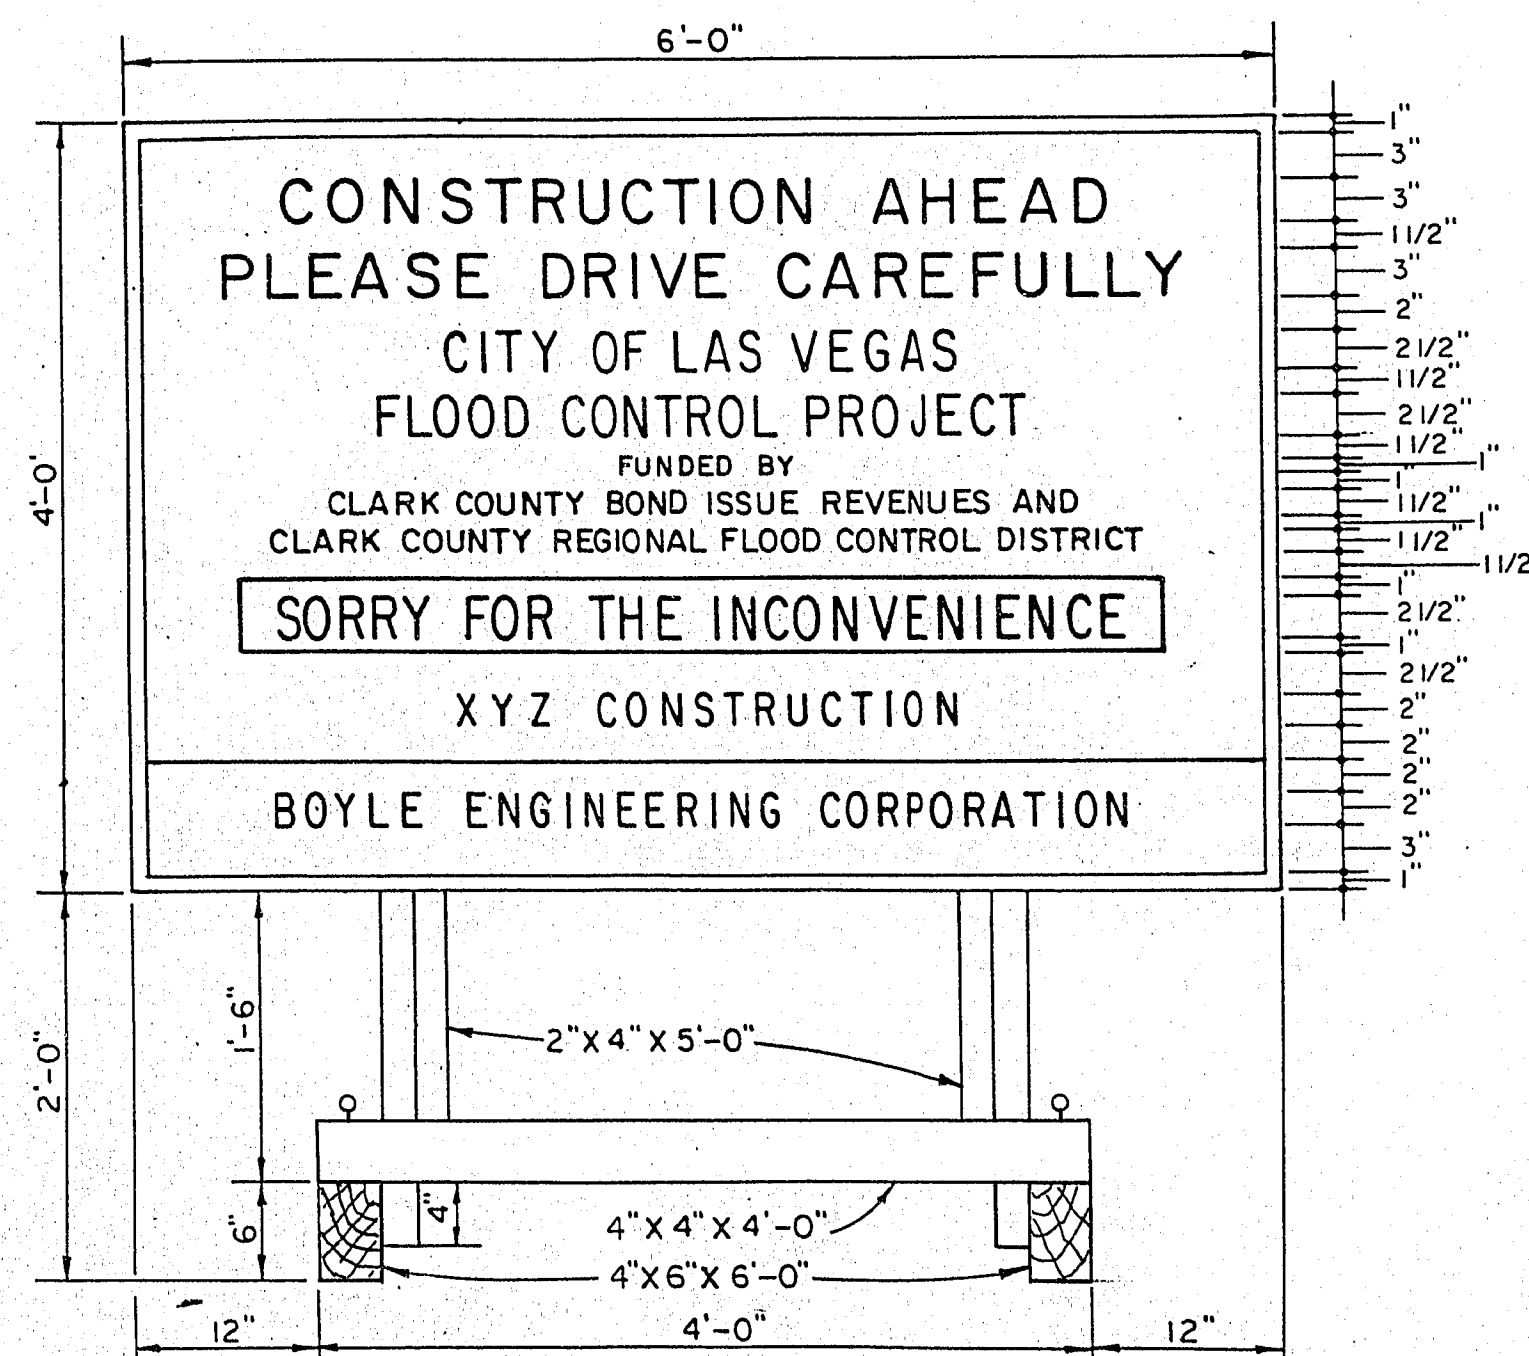


- NOTES
1. SIGN SHALL BE PAINTED WHITE WITH 1" BLACK BORDER. ALL LETTERING TO BE BLACK EXCEPT TOP LINE WHICH SHALL BE RED.
 2. FOR LOCATION OF SIGN SEE SHEET NO. 2
 3. FRAME MEMBERS SHALL BE DRILLED & BOLTED TOGETHER W/MACHINE SCREWS


CONSTRUCTION SIGN TYPE 'A'

SCALE: 1"=1'-0"

5

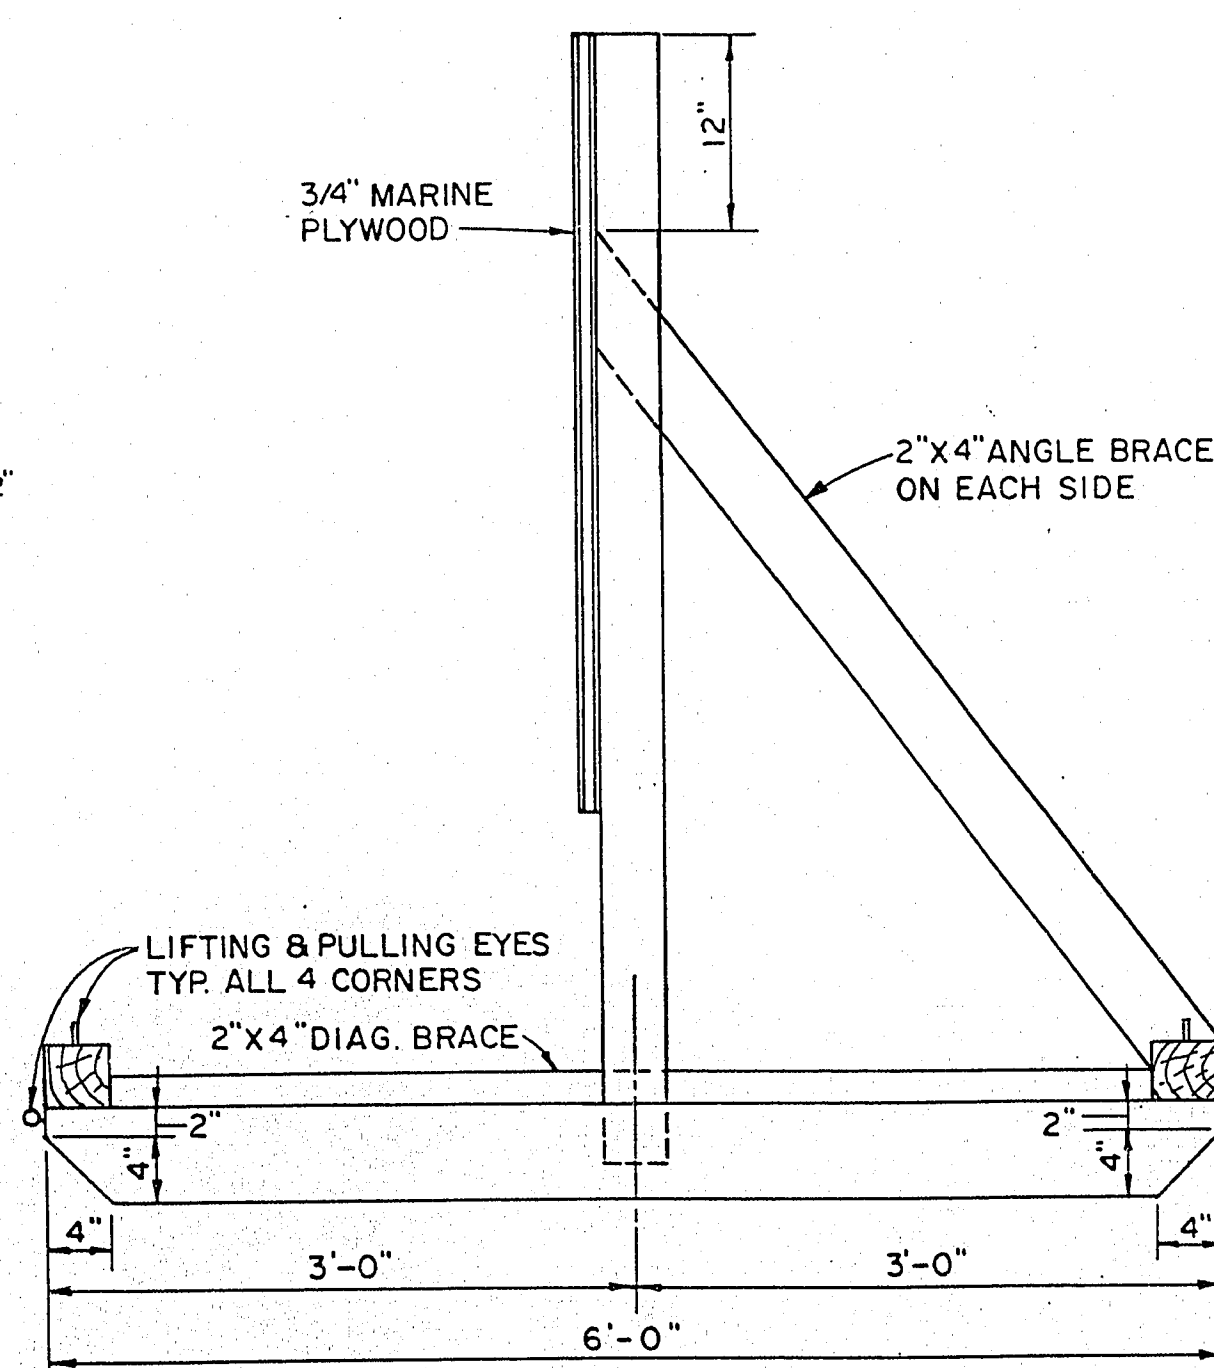


5

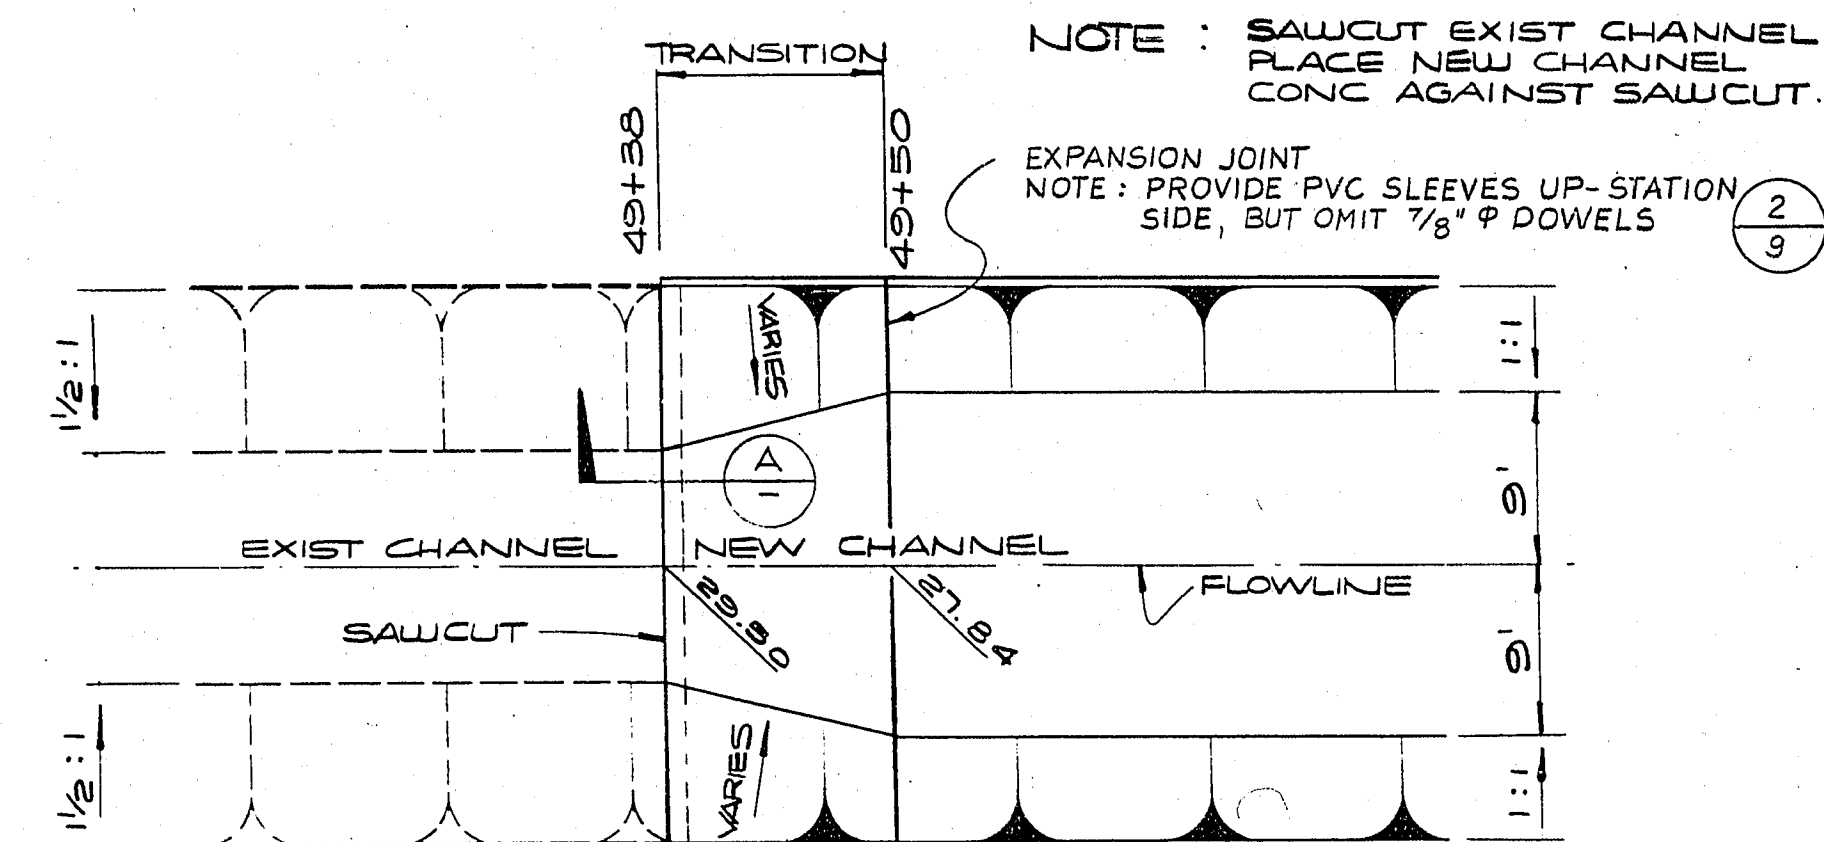

CHANNEL TRANSITION
SCALE: 1"=10'

2

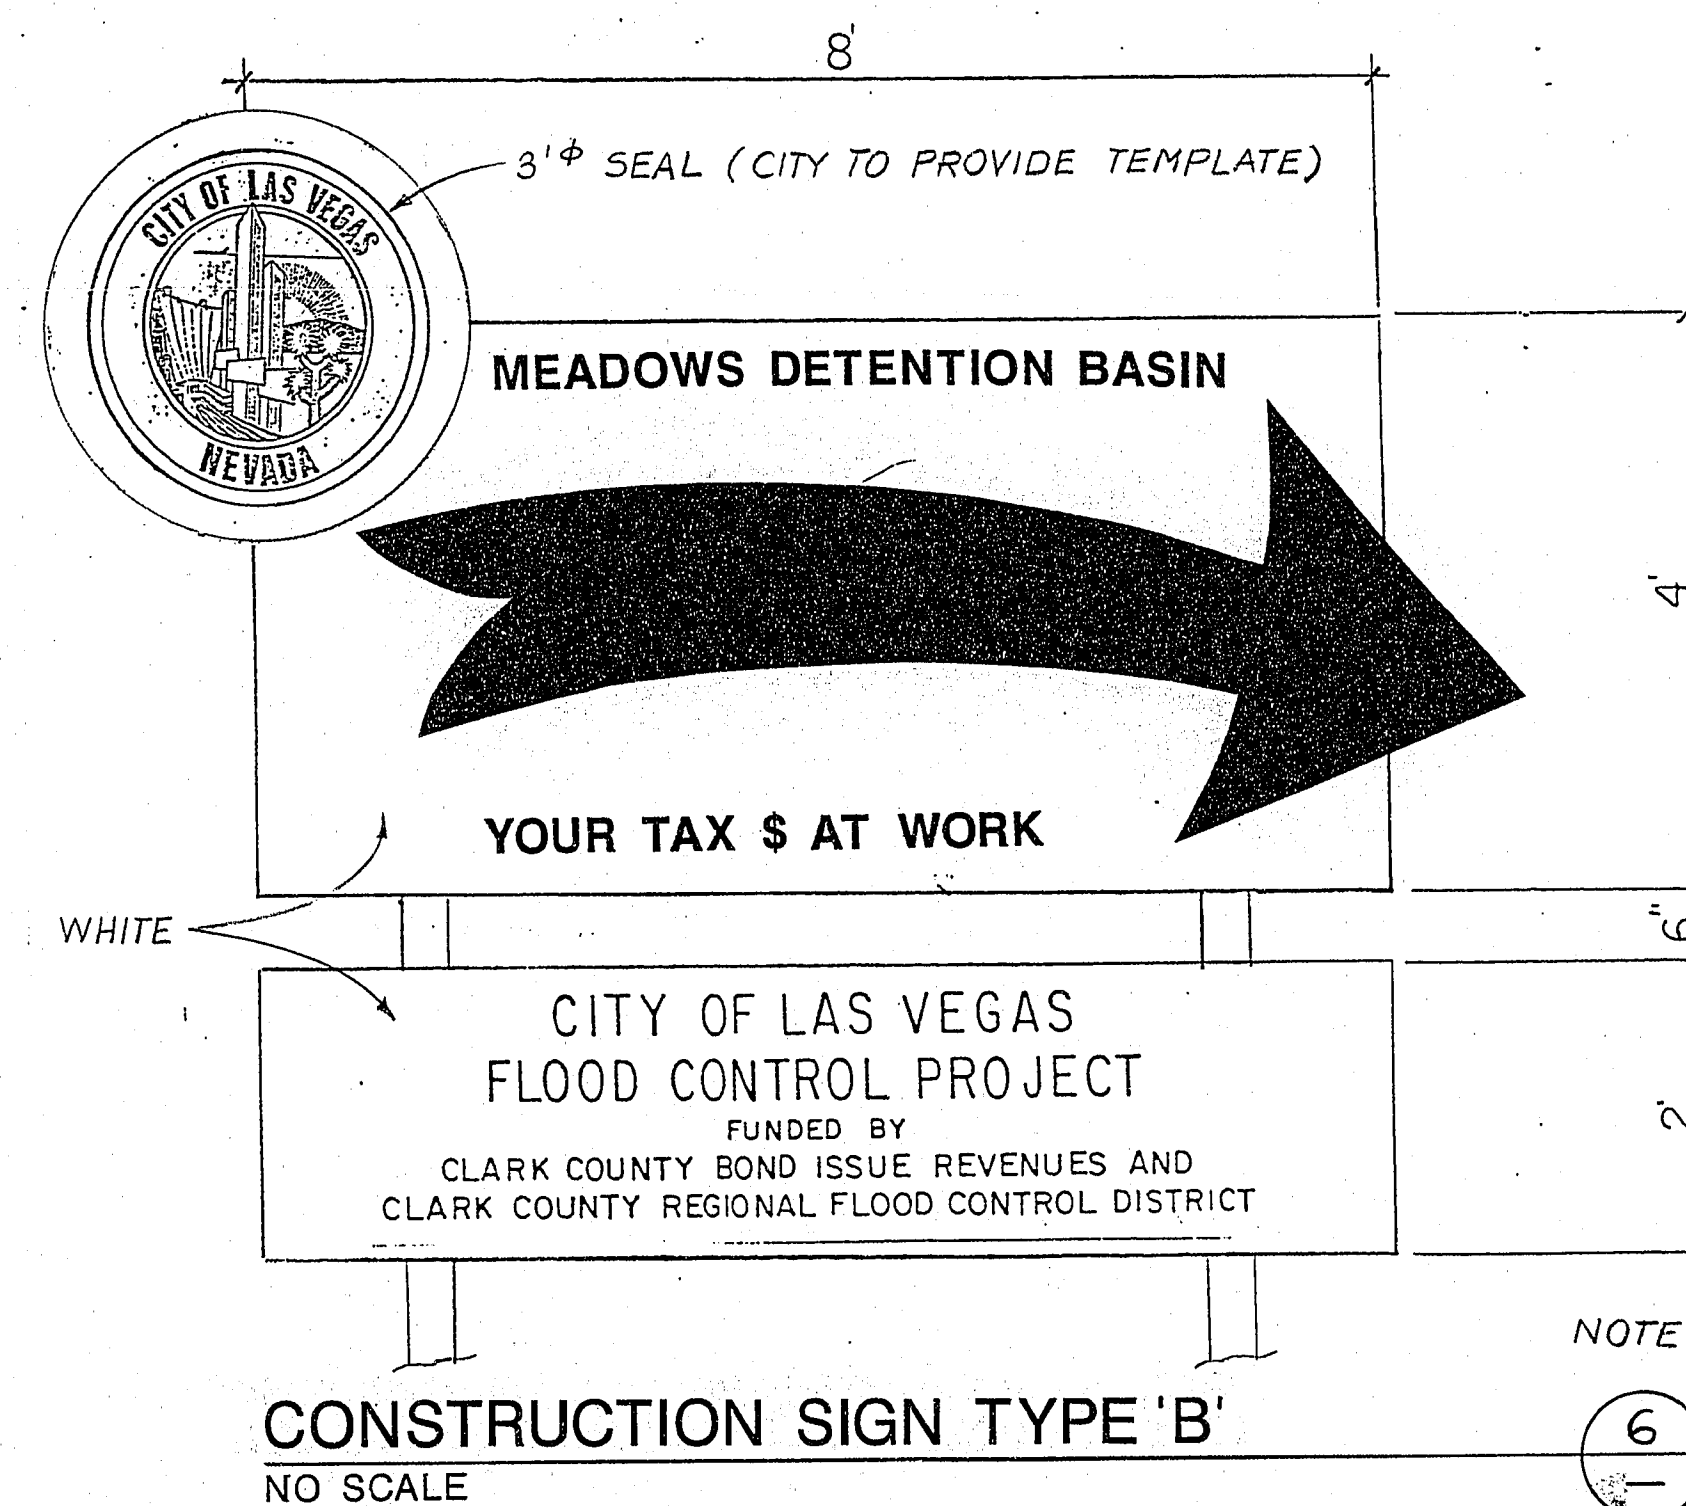


CONSTRUCTION SIGN TYPE 'B'

NO SCALE

- NOTE: CONTRACTOR TO PROVIDE SUPPORT STRUCTURE. SIGN MUST BE VISIBLE FROM HIGHWAY.

6

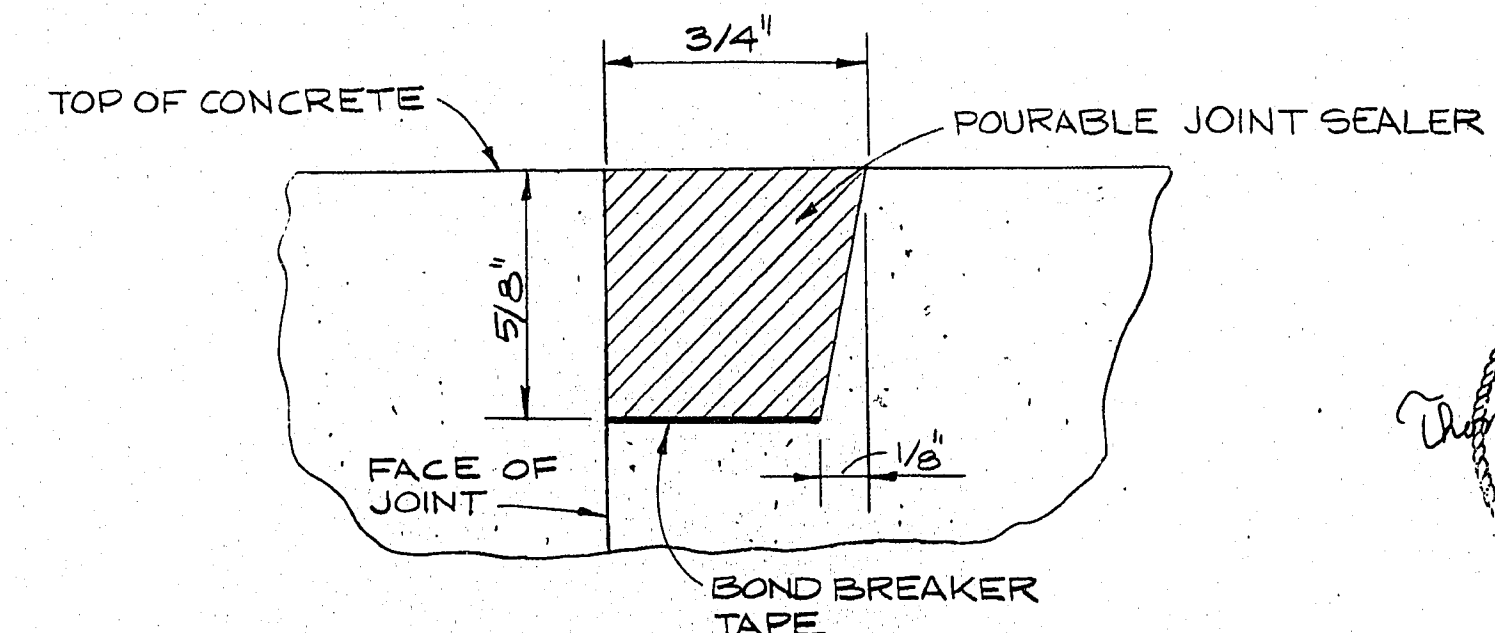

SEALANT GROOVE DETAIL
NO SCALE

4

DESIGNED	JPU	PROJECT MANAGER	5563	8/19/87
DRAWN	AH	PROJECT ENGINEER	8/19/87	
CHECKED	TDG			

Boyle Engineering Corporation	ALCA
consulting engineers	ENGINEERING & SURVEYING, INC.
1785 EAST SAHARA AVENUE, SUITE 300	CIVIL ENGINEERING & LAND SURV.
LAS VEGAS, NEVADA 89104	820 S. VALLEY VIEW BLVD., LAS VEGAS,
TELEPHONE (702) 731-5511	(702) 878-3358

CITY OF LAS VEGAS

MEADOWS DETENTION BASIN
MISCELLANEOUS DETAILS

DRAWING NO.
731-45B-1A
SHEET NO.
26 OF 29