


CERTIFICATE.

I hereby certify that this plan represents a true and correct survey of the lands here shown; and that the monuments exist as indicated hereon. This survey is not intended to be a subdivision as per Subdivision Act, Section 5063, Nevada Compiled Laws, Supplement 1943-1949.

L. M. Robeau
L.M. Robeau Engineer & Surveyor,
United States Mineral Surveyor,
206 Stewart Street Las Vegas Nevada.

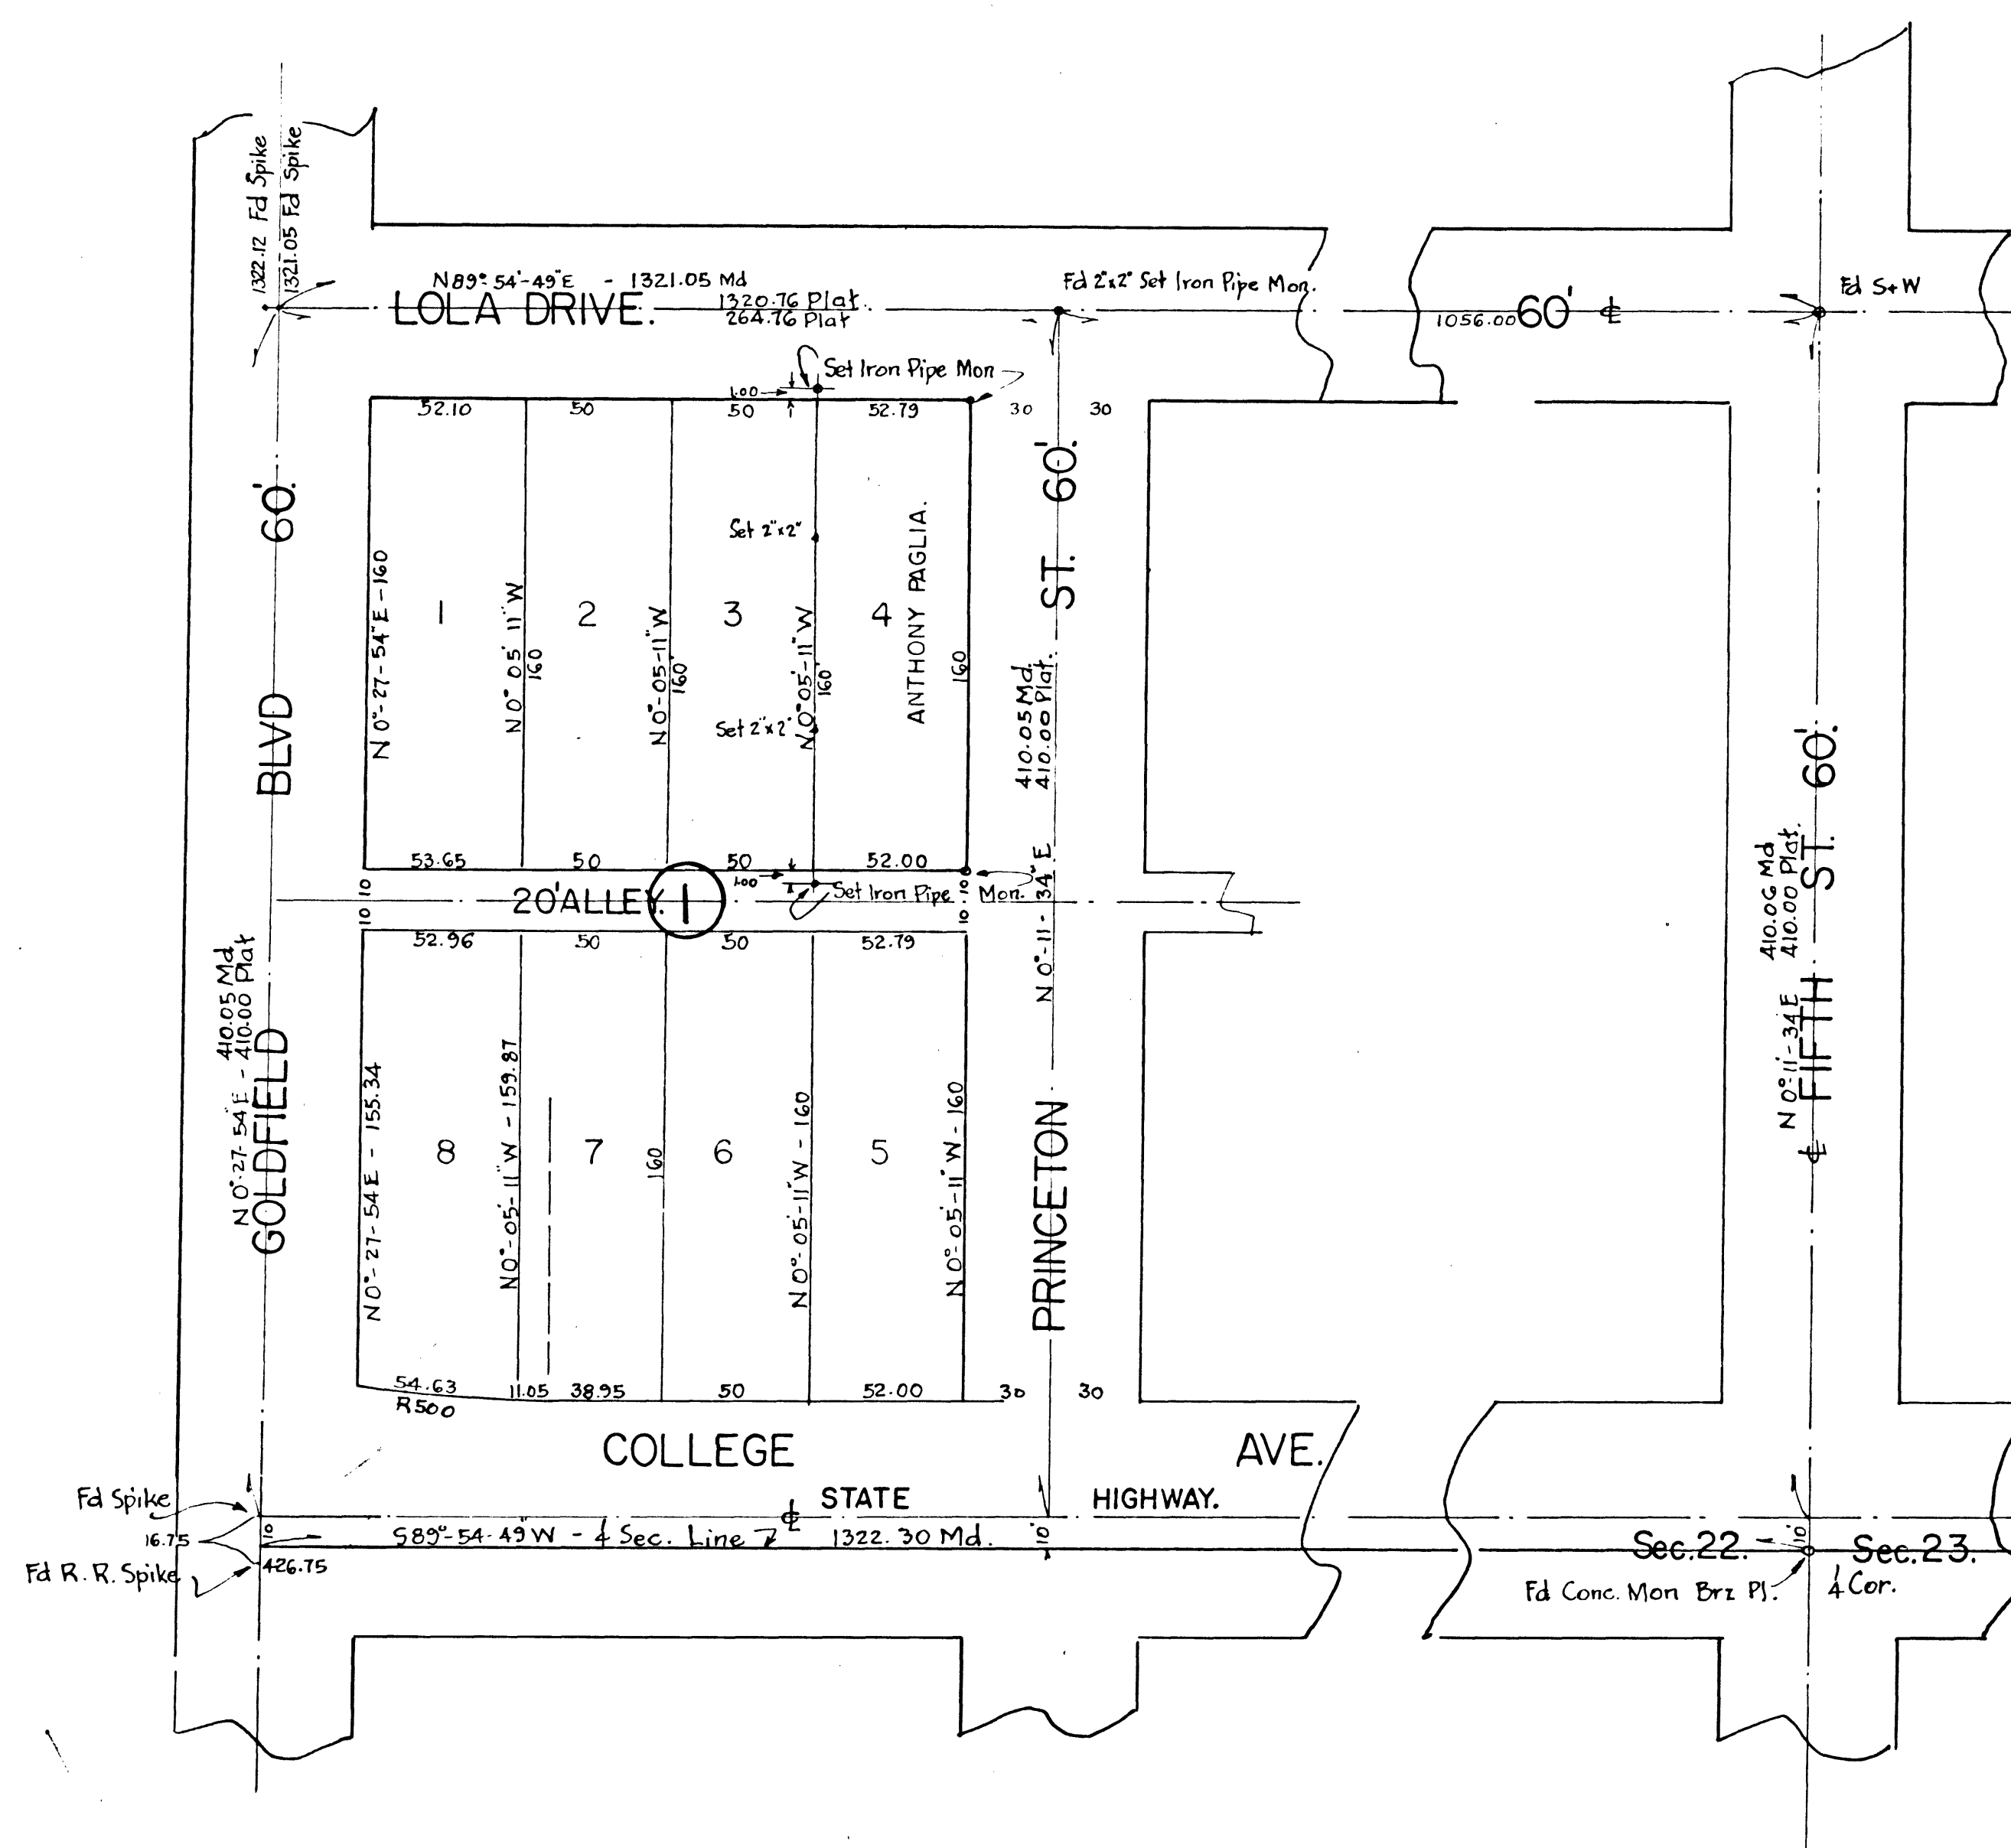

NO 87526
L.M. Robeau
8-27-56 1:46P
6 44

L. M. Robeau

1.20 MK

106

1.30 MK

SURVEY.
OF
LOT 4, BLOCK I,
NORTH FIFTH STREET SUBDIVISION,
NORTH LAS VEGAS.
FOR
ANTHONY PAGLIA.

717.2-11


8-4-56



CERTIFICATE



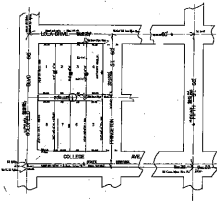



SURVEY
 OF
 LOT 4, BLOCK 1,
 NORTH FIFTH STREET SUBDIVISION,
