


LEGEND

- SET TYPE III MONUMENT PLS 7008
- SET BRASS DISC IN TOP OF CURB
- CENTERLINE

SCALE: 1"=40'

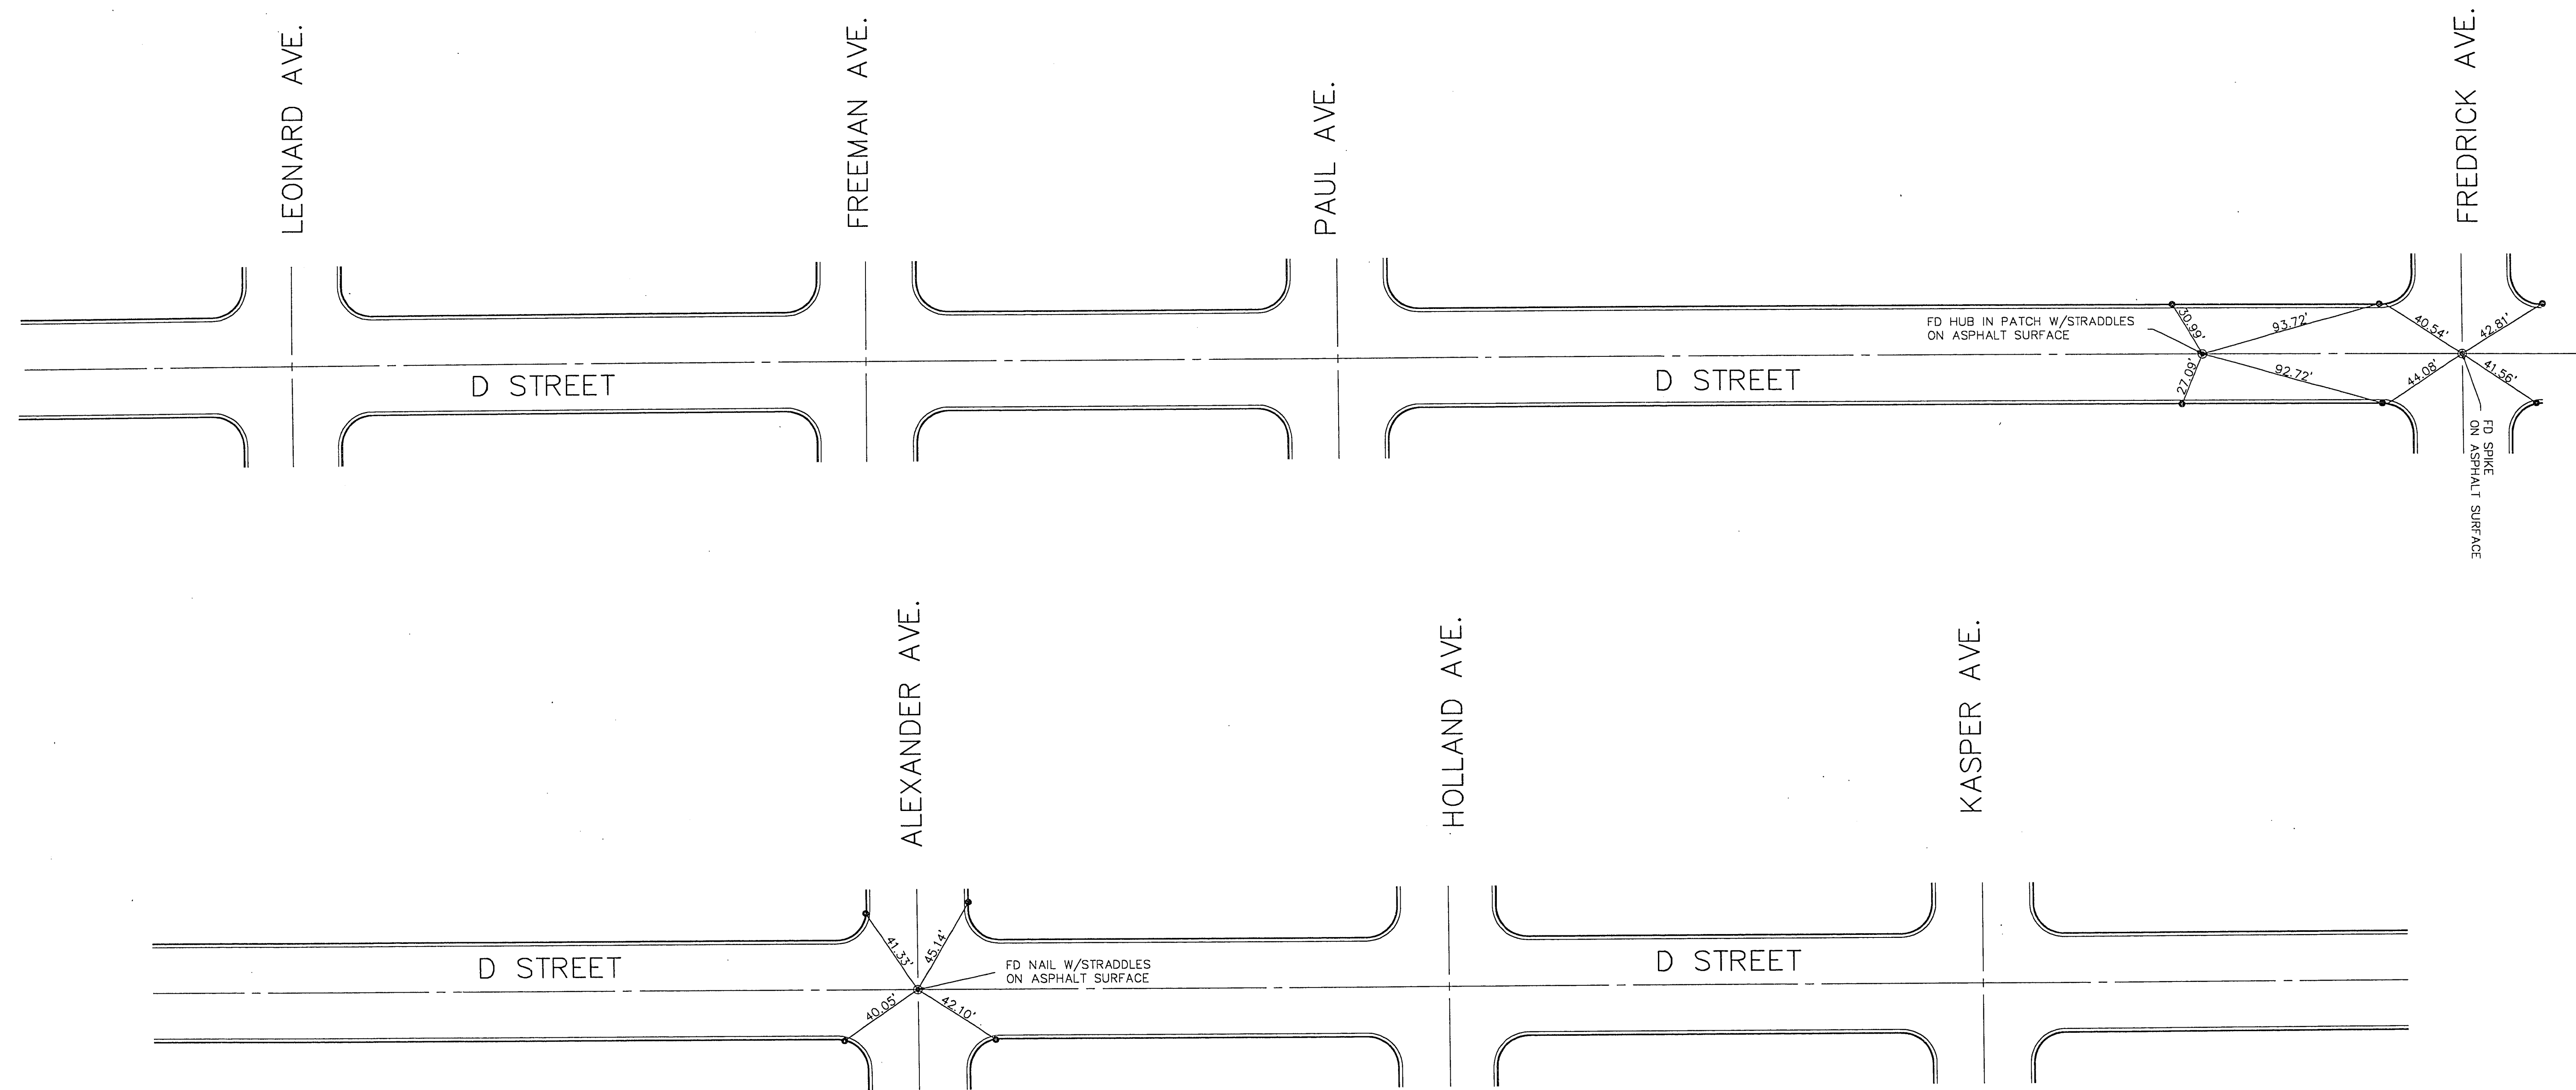

JOB No.		DESIGNED:		DRAWN:		CHECKED:	
SHEET		2		2		2	
OF 2 SHEETS							
MONUMENTATION MAP "D" STREET REHABILITATION "D" STREET - WASHINGTON AVE TO LAKE MEAD BLVD. CITY OF LAS VEGAS CLARK COUNTY, NEVADA							
SOUTHWEST SURVEYING, INC. GERALD "CROCKETT" WIRTHLIN PLS #7008							
201-0006 OFFICE 370-0382 MOBILE							
REV	DATE	BY	REVISION				

Ties 107-V1852

25-3-130