

approved date

City Engineer
Chief of Civil Engineering
Chief of Traffic Engineering
City Project Administrator
Chief of Project Control
Chief of Construction Services
Director of General Services
Chief of Maintenance

Director of Parks, Recreation & Senior Activities

Director of Public Services
Chief of Electrical Services

Director of Community Planning & Development

Director of Building & Safety

Regional Transportation Commission

Nevada State Department of Transportation

Central Telephone Company

Las Vegas Valley Water District

Nevada Power Company

Southwest Gas


Cable Television

index of sheets

description

SEE SHEET G-2

location map

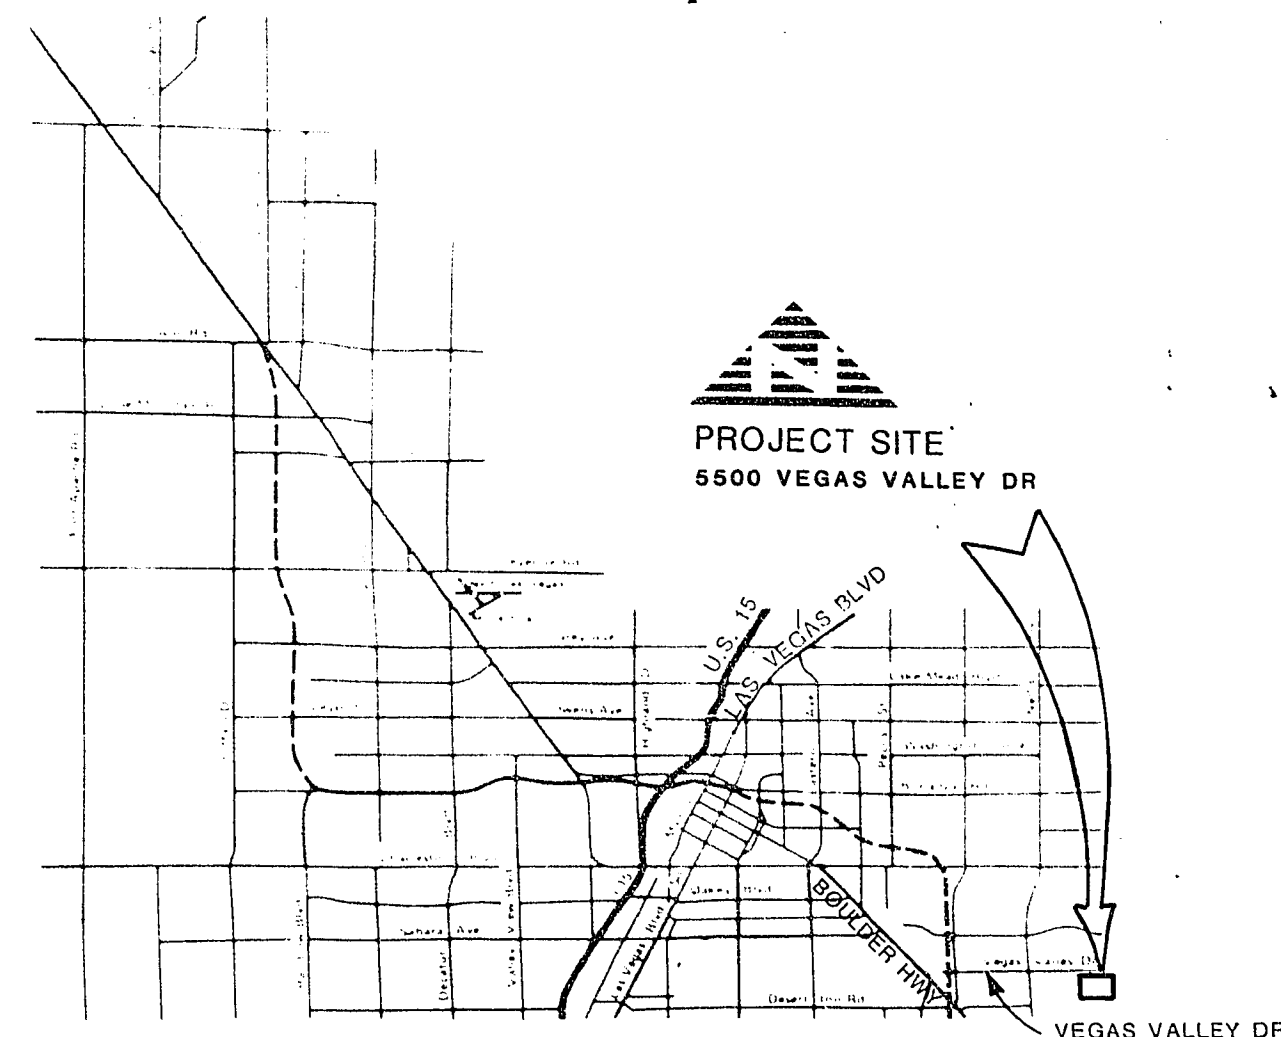

mayor:

Ron Lurie

councilmen:

Arnie Adamsen

W. Wayne Bunker

Steve Miller

Bob Nolen

city manager:

Ashley Hall

director of public works:

Richard D. Goecke

revisions

ADDENDUM # 1

CORRECTED ACCORDING TO CONSTRUCTION RECORDS

DAP 5/89
MJH 12/90

no.	description	by	date	app.
-----	-------------	----	------	------



MAINTENANCE & STORAGE BUILDINGS
CONTRACT V **BID N° 89.7254.5**

date
3/11/25
drawing number
G-1
sheet 1 of 57

7-1-81 311.25