



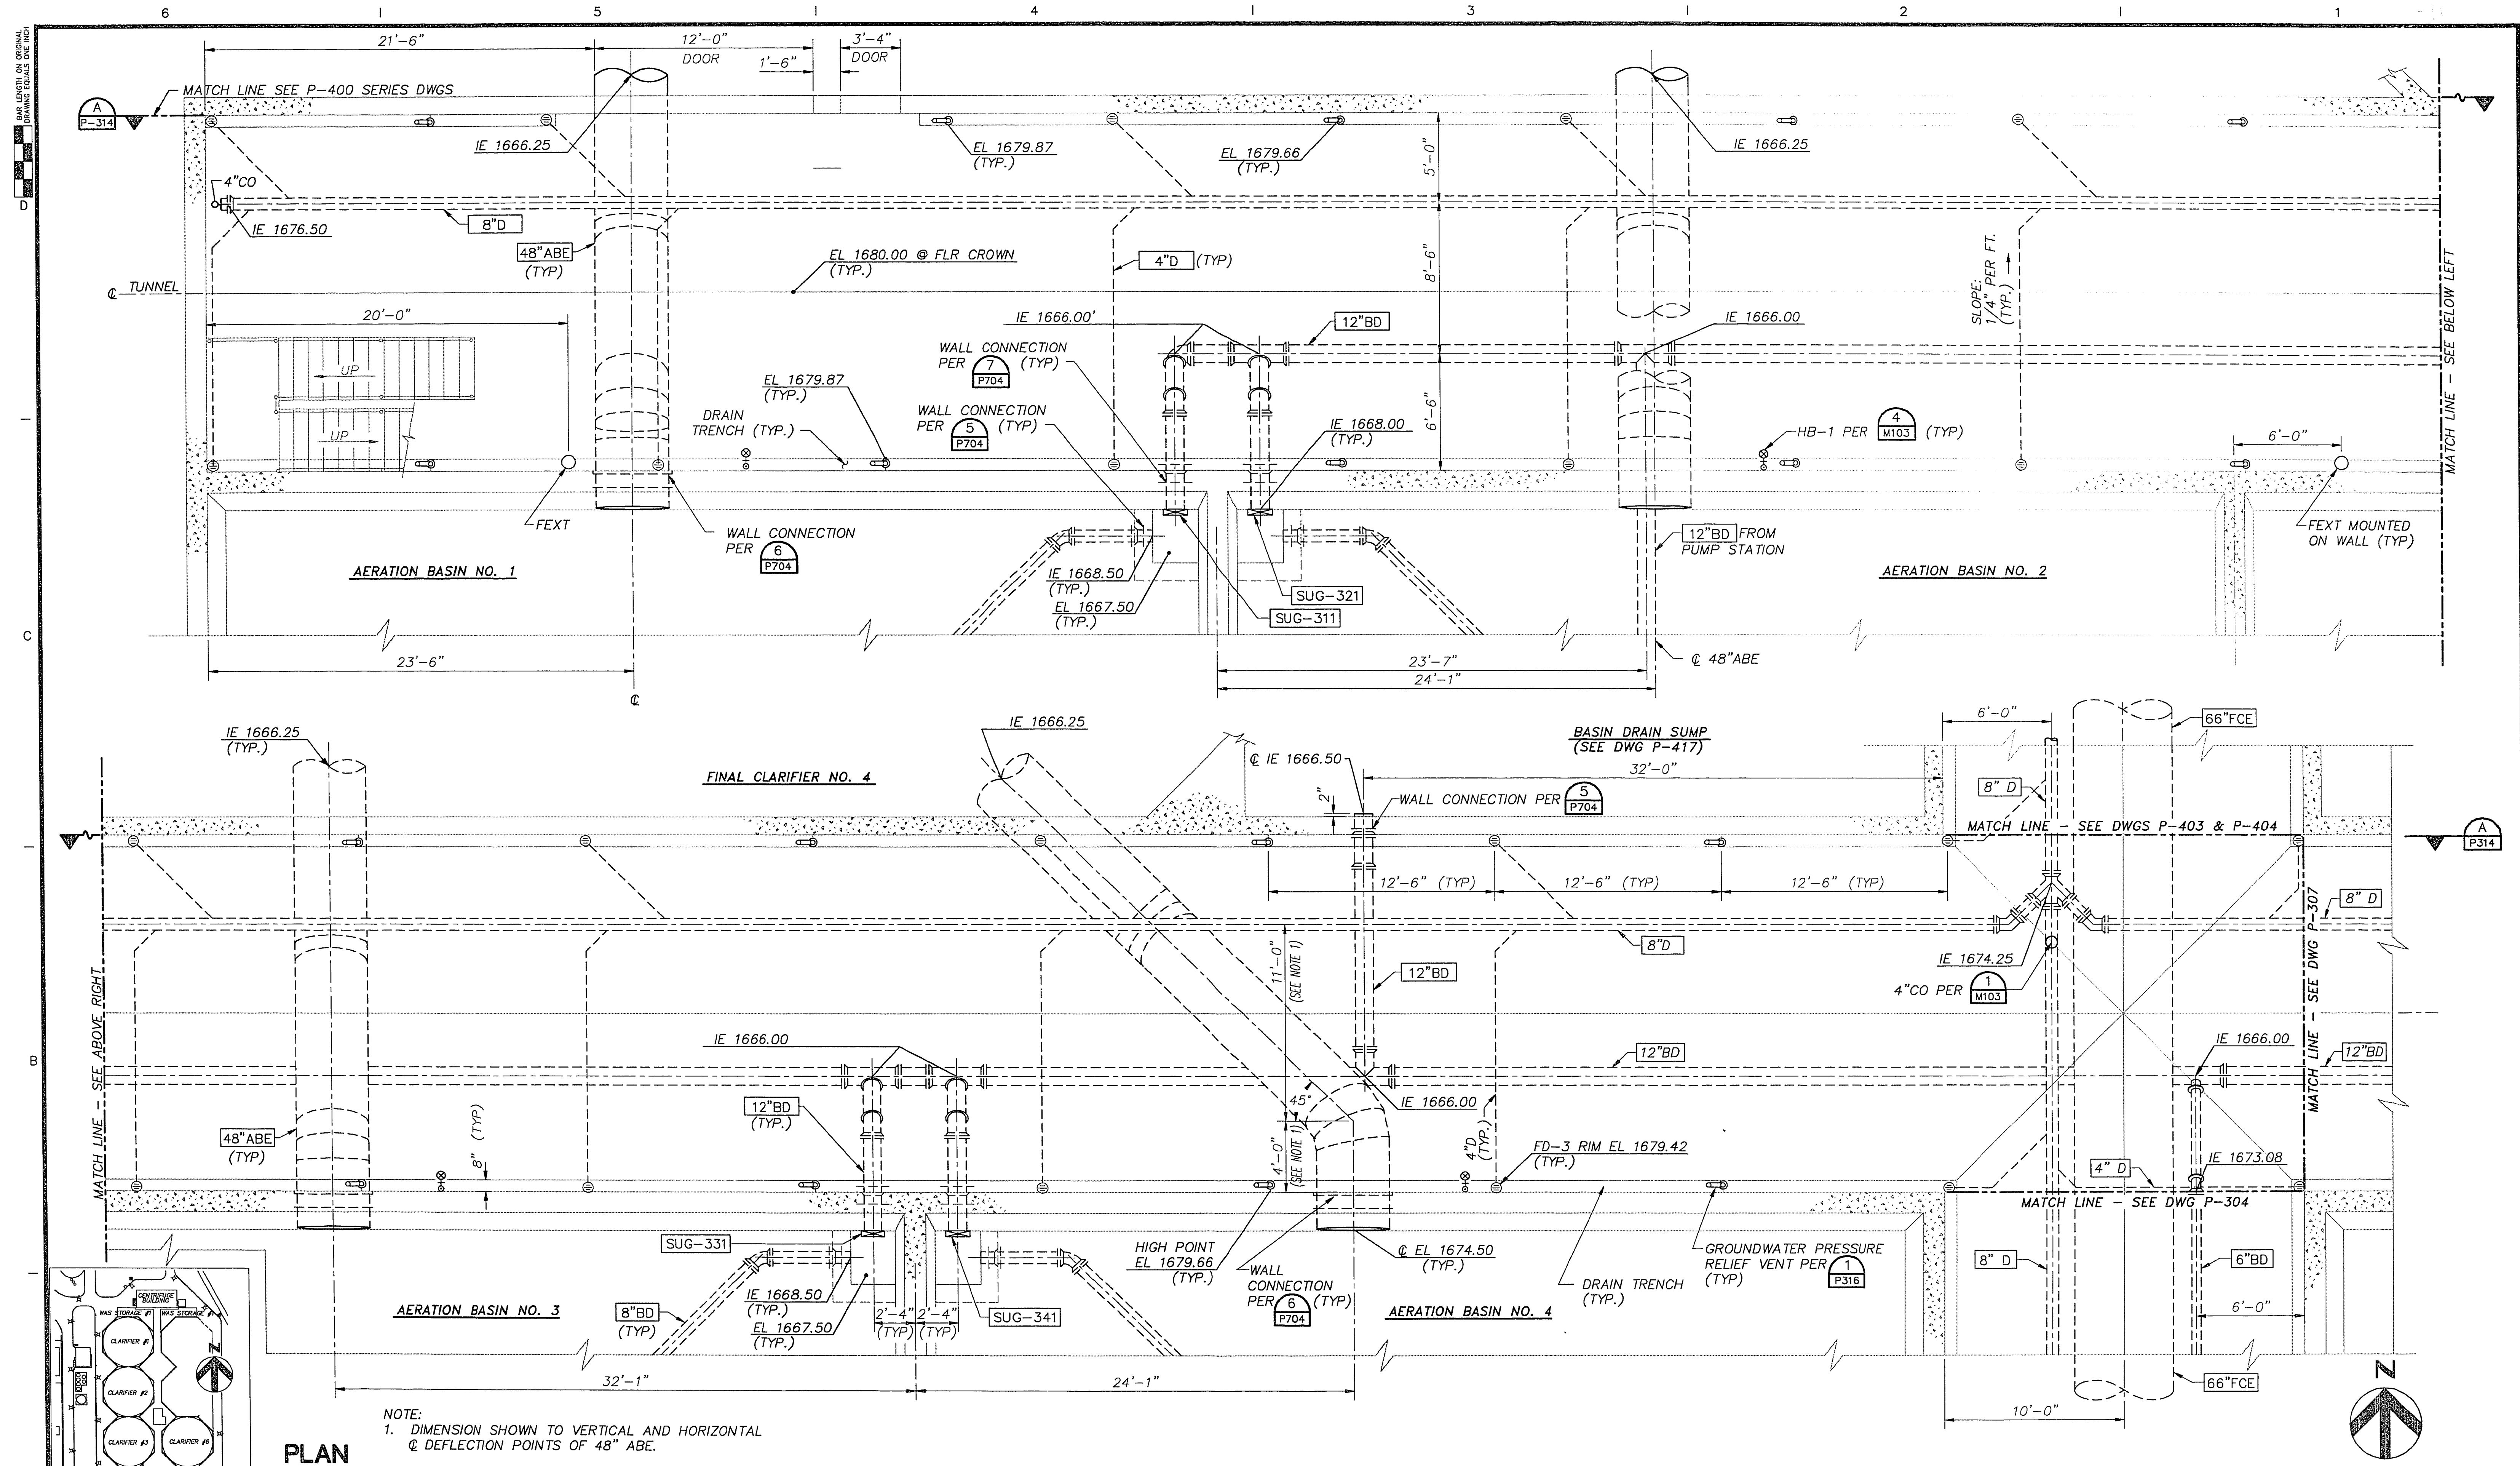


NOTE:
1. DIMENSION SHOWN TO VERTICAL AND HORIZONTAL
 & DEFLECTION POINTS OF 48\"/>

PLAN
SCALE: 1/4"=1'-0"

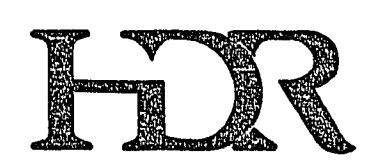

HDR Engineering, Inc.

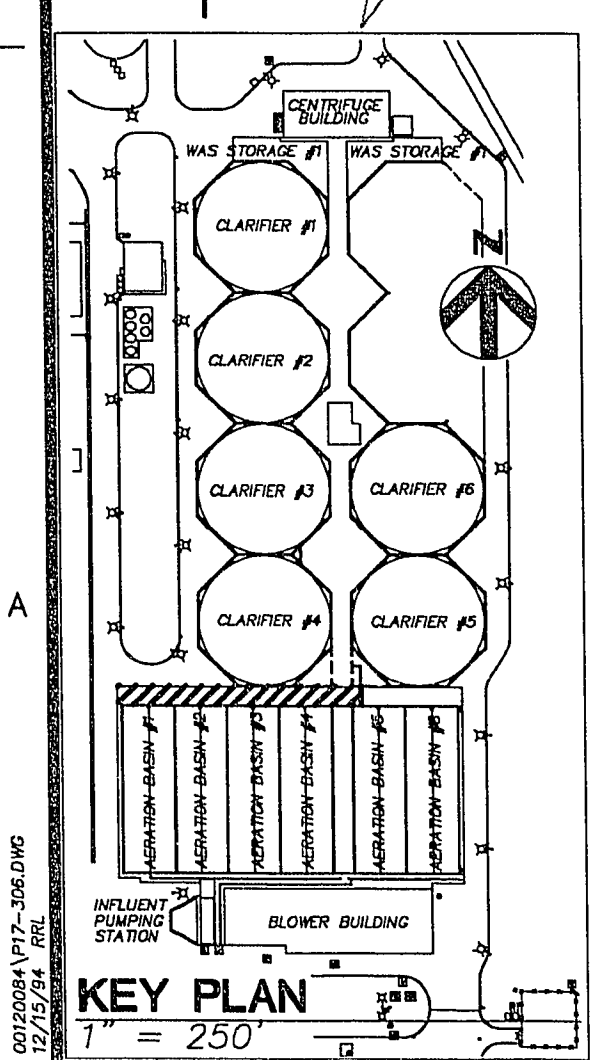

1	CORRECTED ACCORDING TO CONSTRUCTION RECORD	1/95	RRL	EFH	MJH	JJC
0	ISSUED FOR CONSTRUCTION	8/20/92	PHS	GWJ	JJC	
Issue No.	Description	Date	Drawn	Chkd.	Resp. Engr.	Proj. Mgr.

Project Manager	JOHN J. CHUEH
Architect	R.ATTANASIO
Civil	
Mechanical	
Electrical	
Structural	
Drawn By	P.SAUNDERS

City of Las Vegas
**Water Pollution Control Facility
Nitrification / Filtration Facilities**
Contract 17
NITRIFICATION COMPLEX

AERATION BASINS WEST TUNNEL LOWER PLAN @ EL 1684.00			
Date	APRIL 1992	Project No.	00120-084-141
Scale	1/4" = 1'-0"	Drawing No.	P-306
		Issue	1