


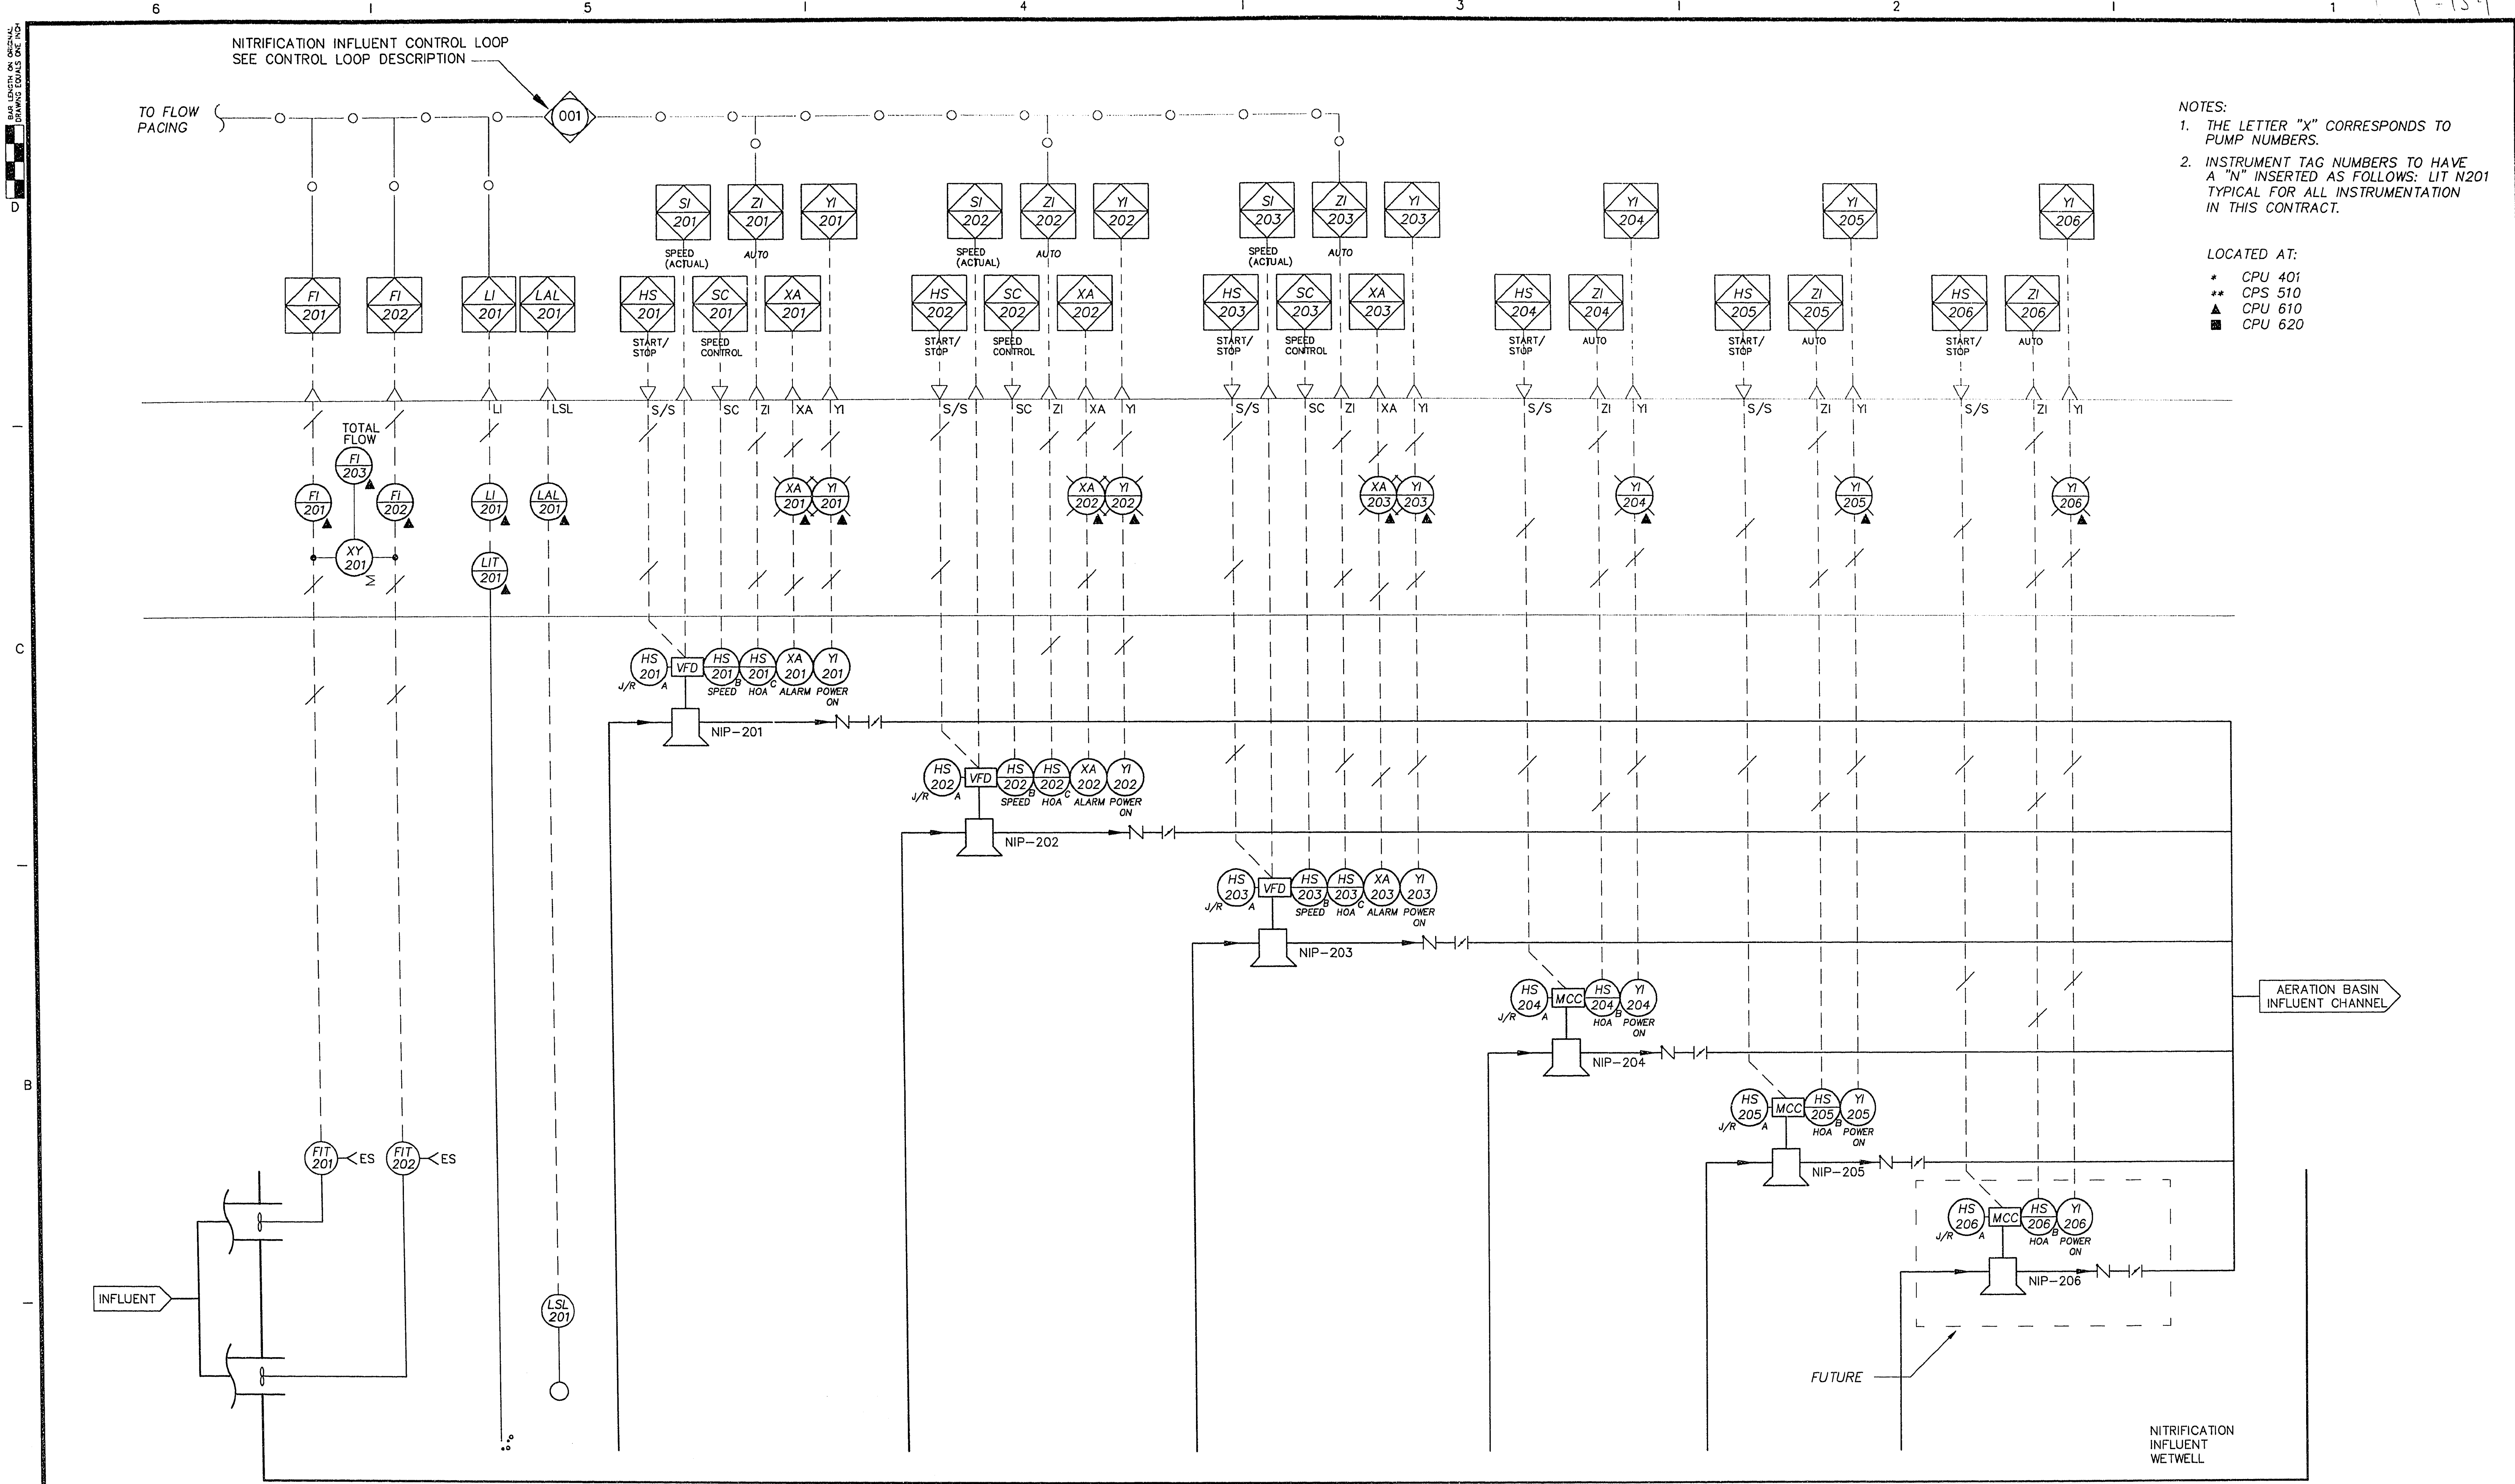

- NOTES:
1. THE LETTER "X" CORRESPONDS TO PUMP NUMBERS.
 2. INSTRUMENT TAG NUMBERS TO HAVE A "N" INSERTED AS FOLLOWS: LIT N201 TYPICAL FOR ALL INSTRUMENTATION IN THIS CONTRACT.
- LOCATED AT:
- * CPU 401
 - ** CPS 510
 - ▲ CPU 610
 - CPU 620

NITRIFICATION PUMPING STATION



HDR Engineering, Inc.

1	CORRECTED ACCORDING TO CONSTRUCTION RECORD	1/95	RRL	EFH	MJH	JJC
A	ISSUED FOR BIDS	4/20/92	RCB	LDS	LDS	JJC
Issue No.	Description	Date	Drawn	Checked	Responsible Engr.	Project Mgr.

Project Manager	JOHN J. CHUEH
Architect	L. SMITHEY
Civil	
Electrical	
Drawn By	R. BURNS

City of Las Vegas
Water Pollution Control Facility
Nitrification / Filtration Facilities
Contract 17
NITRIFICATION COMPLEX

NITRIFICATION PUMPING STATION
INSTRUMENTATION DIAGRAM

Date	APRIL 1992	Project No.	00120-084-141	Drawing No.	I-002	Issue	1
Scale	NONE						