


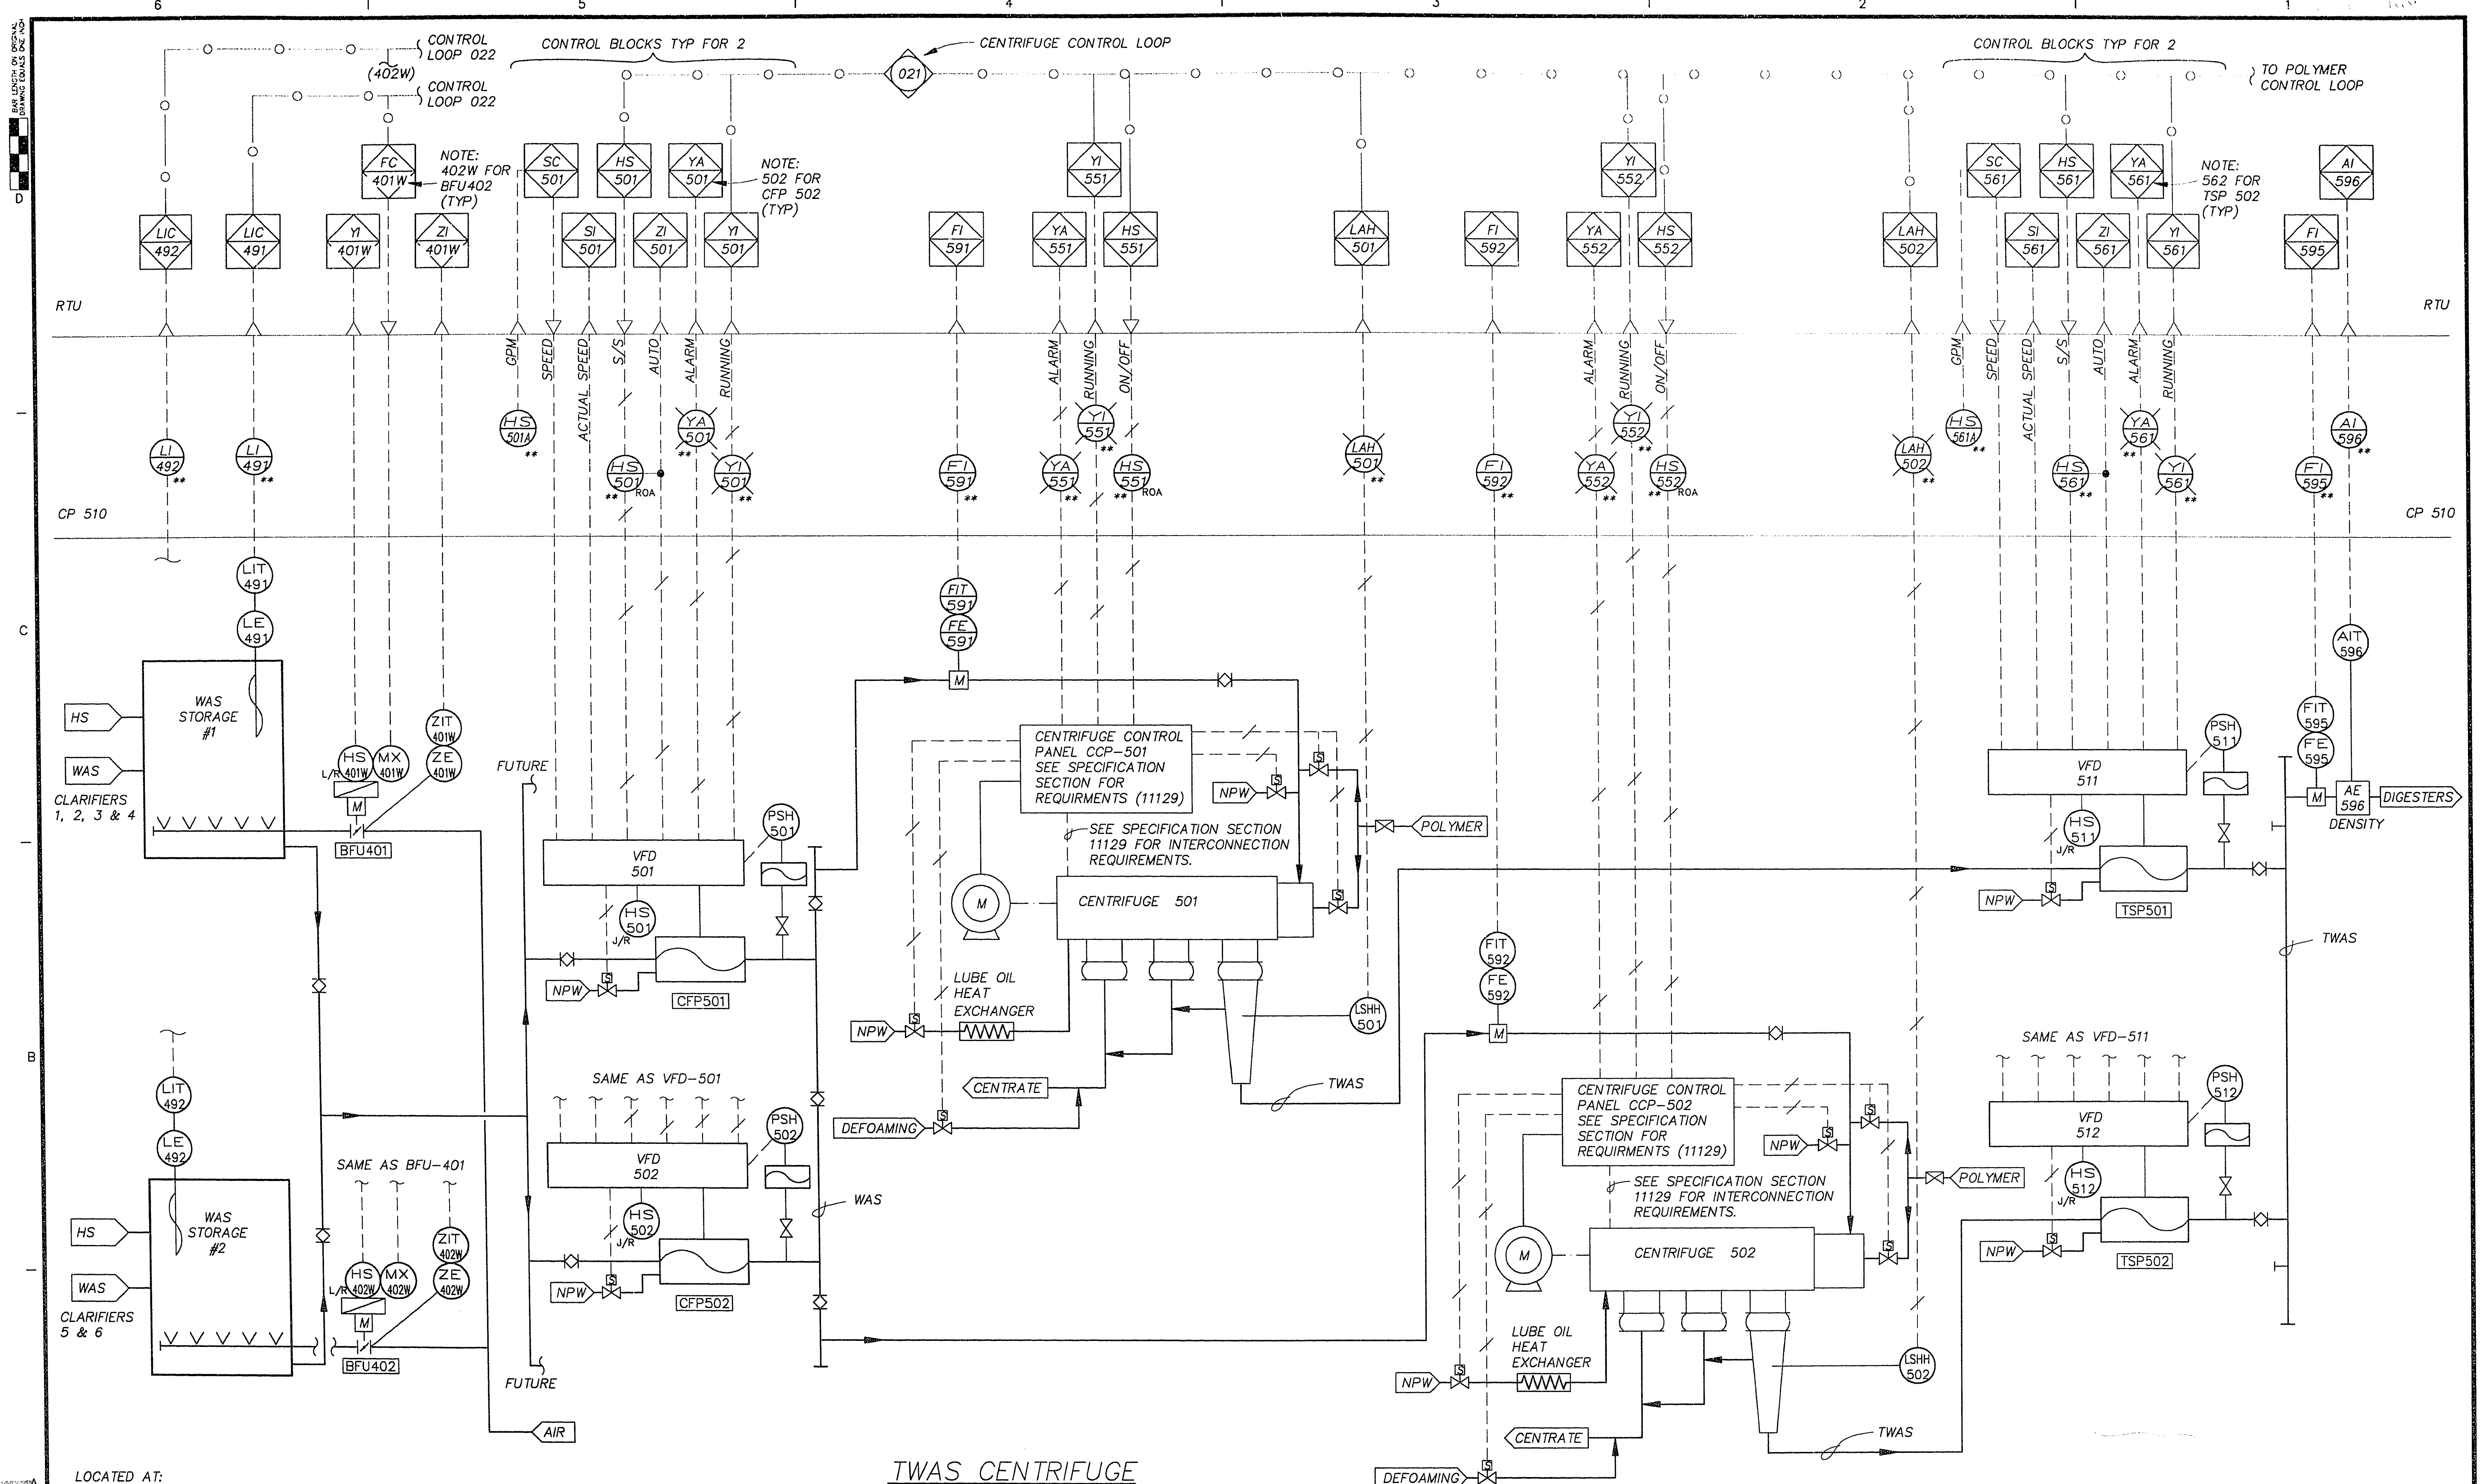

HDR Engineering, Inc.

1	CORRECTED ACCORDING TO CONSTRUCTION RECORD	1/95	RRL	EFH	MJH	JJC
A	ISSUED FOR BIDS	4/20/92	RCB	LDS	LDS	JJC
Issue No.	Description	Date	Drawn	Chd.	Resp. Engr.	Proj. Mgr.

Project Manager	JOHN J. CHUEH
Architect	L. SMITHEY
Civil	
Electrical	
Structural	
Drawn By	R. BURNS

City of Las Vegas
Water Pollution Control Facility
Nitrification / Filtration Facilities
 Contract 17
NITRIFICATION COMPLEX

TWAS CENTRIFUGE INSTRUMENTATION DIAGRAM

Date	APRIL 1992	Project No.	00120-084-141	Drawing No.	I-003	Issue	1
Scale	NONE						