


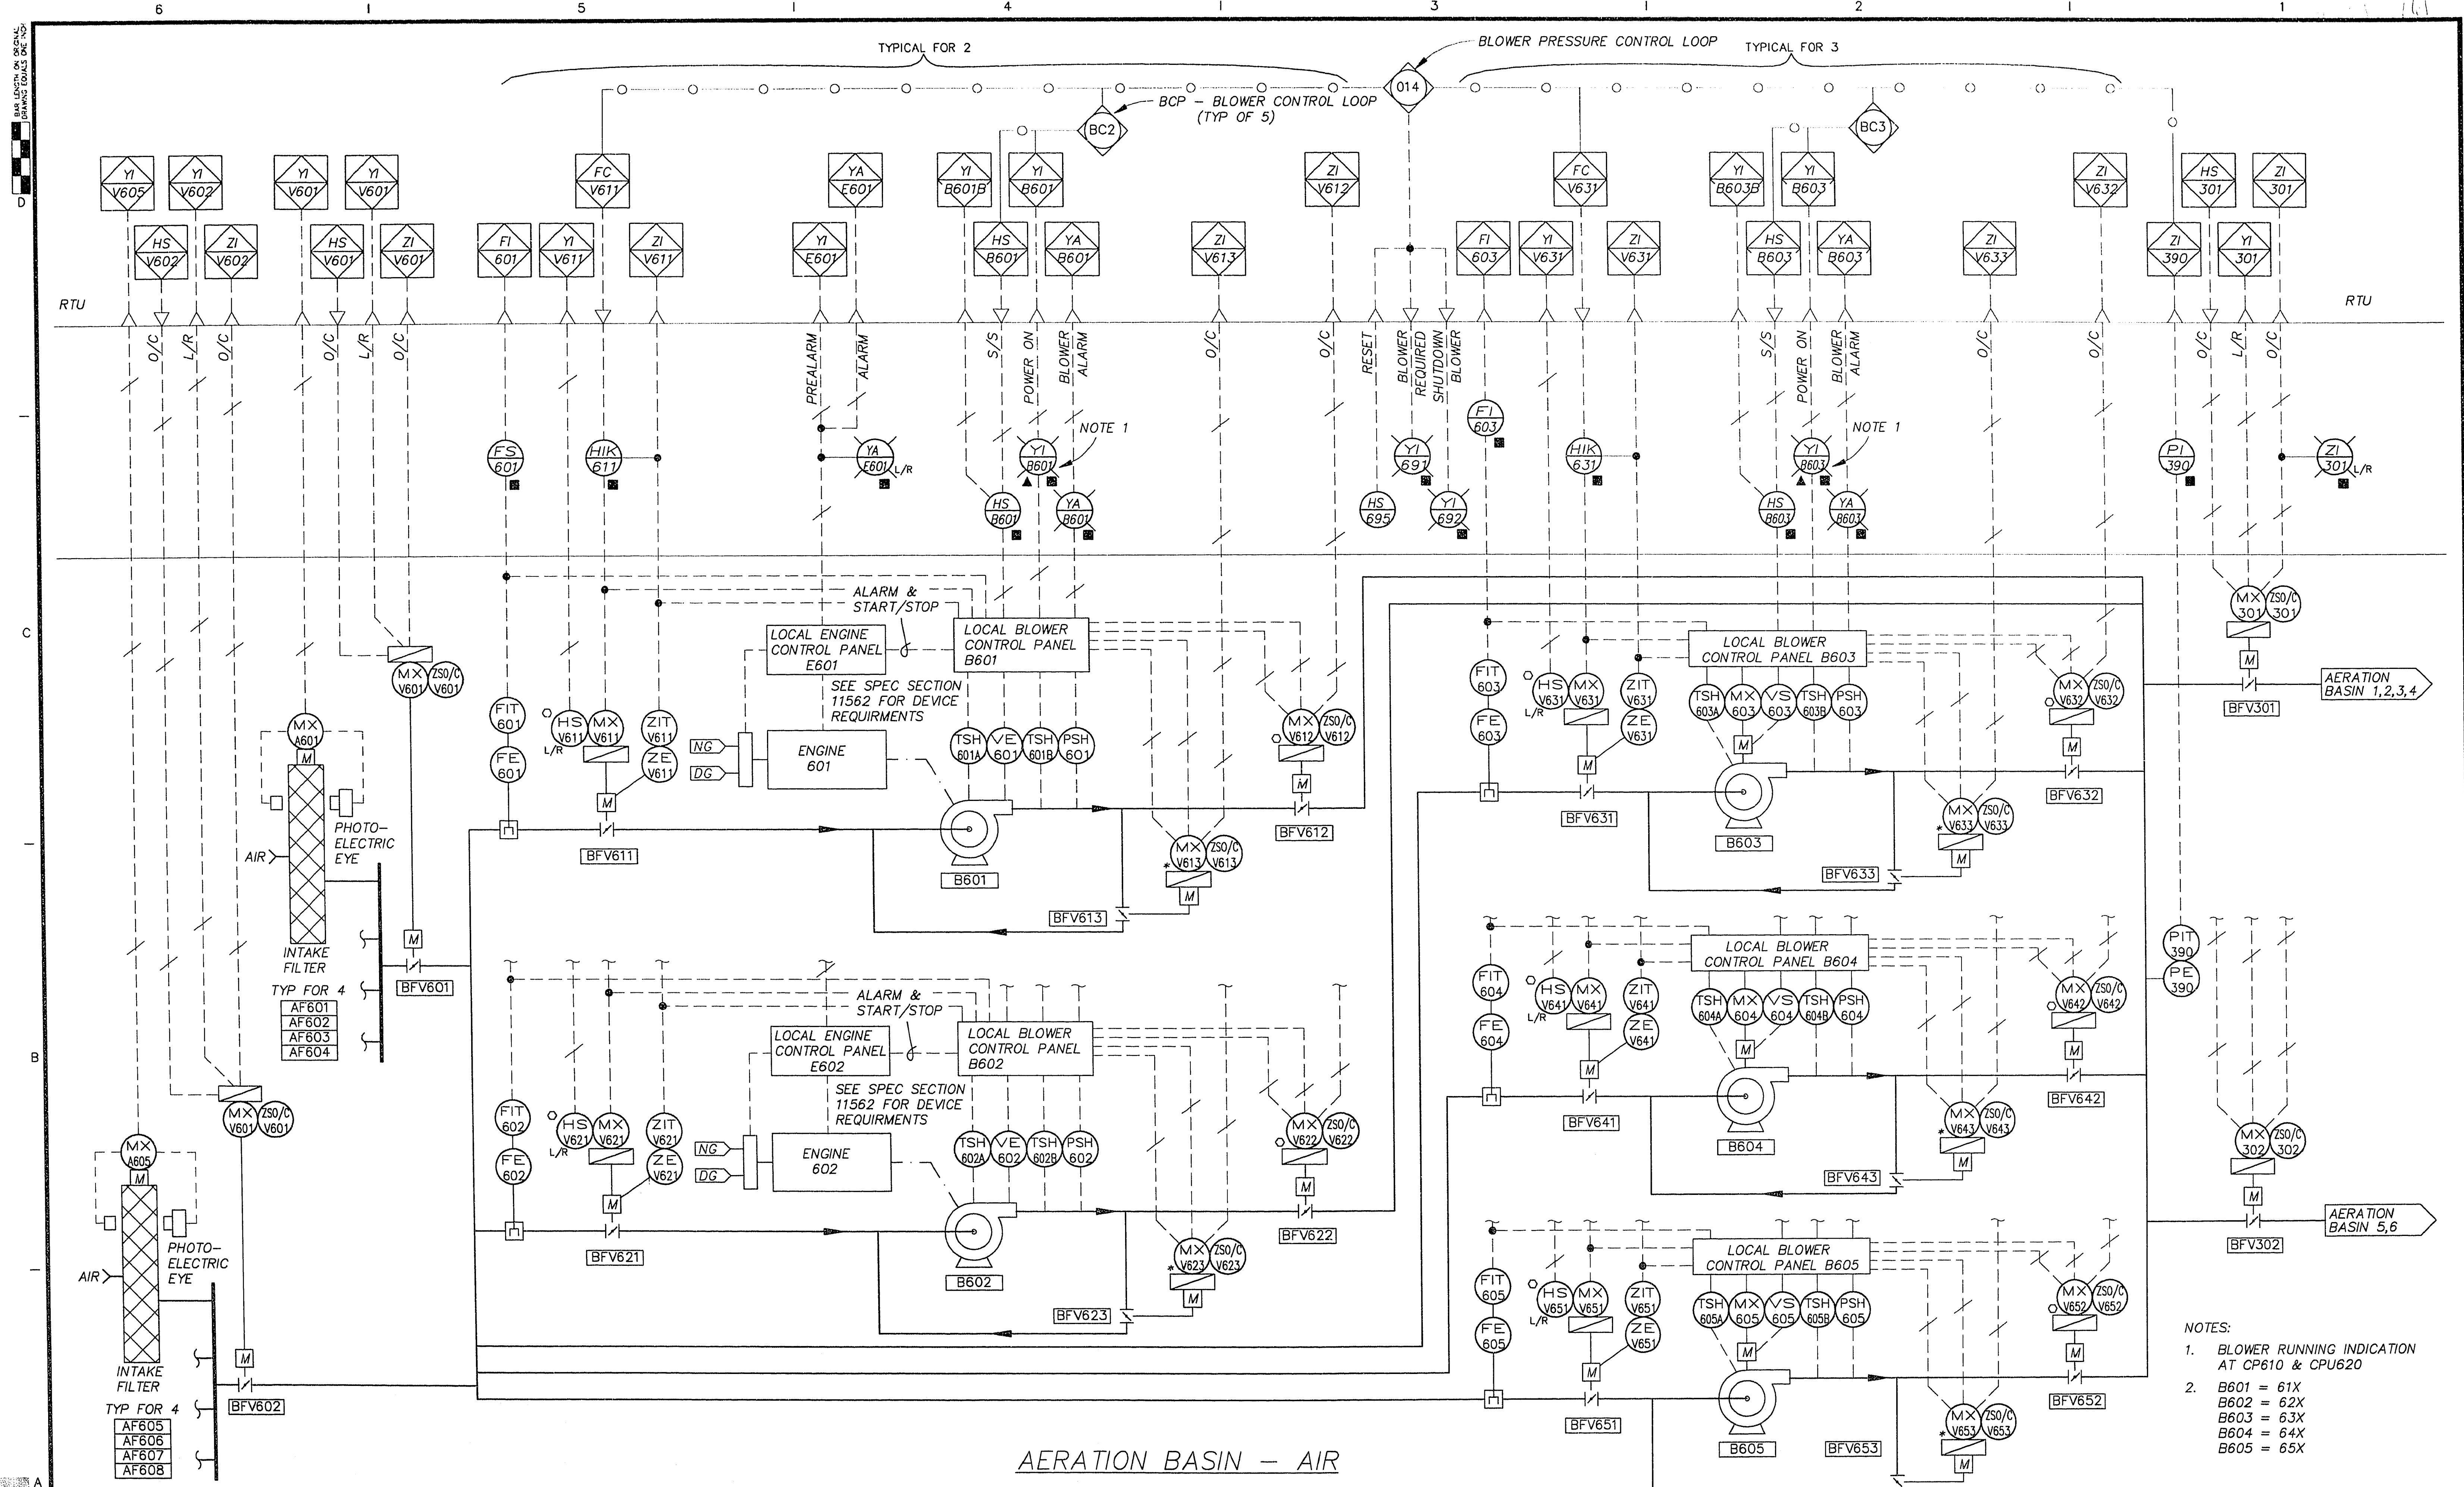

- NOTES:
1. BLOWER RUNNING INDICATION AT CP610 & CPU620
 2. B601 = 61X
B602 = 62X
B603 = 63X
B604 = 64X
B605 = 65X

LOCATED AT:
 * CPU 401
 ** CPS 510
 ▲ CPU 610
 ■ CPU 620
 ○ MOUNT VALVE CONTROL STATION IN LOCAL BLOWER CONTROL PANEL
HDR Engineering, Inc.

1	CORRECTED ACCORDING TO CONSTRUCTION RECORD	1/95	RRL	EFH	MJH	JJC
A	ISSUED FOR BIDS	4/20/92	RCB	LDS	LDS	JJC
Issue No.	Description	Date	Drawn	Checked	Responsible	Project Mgr.

Project Manager
JOHN J. CHUEH
 Architect
L. SMITHEY
 Civil
 Electrical
 Drawn By
R. BURNS

City of Las Vegas
**Water Pollution Control Facility
 Nitrification / Filtration Facilities**
 Contract 17
NITRIFICATION COMPLEX

AERATION AIR INSTRUMENTATION DIAGRAM
 Date **APRIL 1992**
 Scale **NONE**
 Project No. **00120-084-141**
 Drawing No. **I-004**
 Issue **1**