


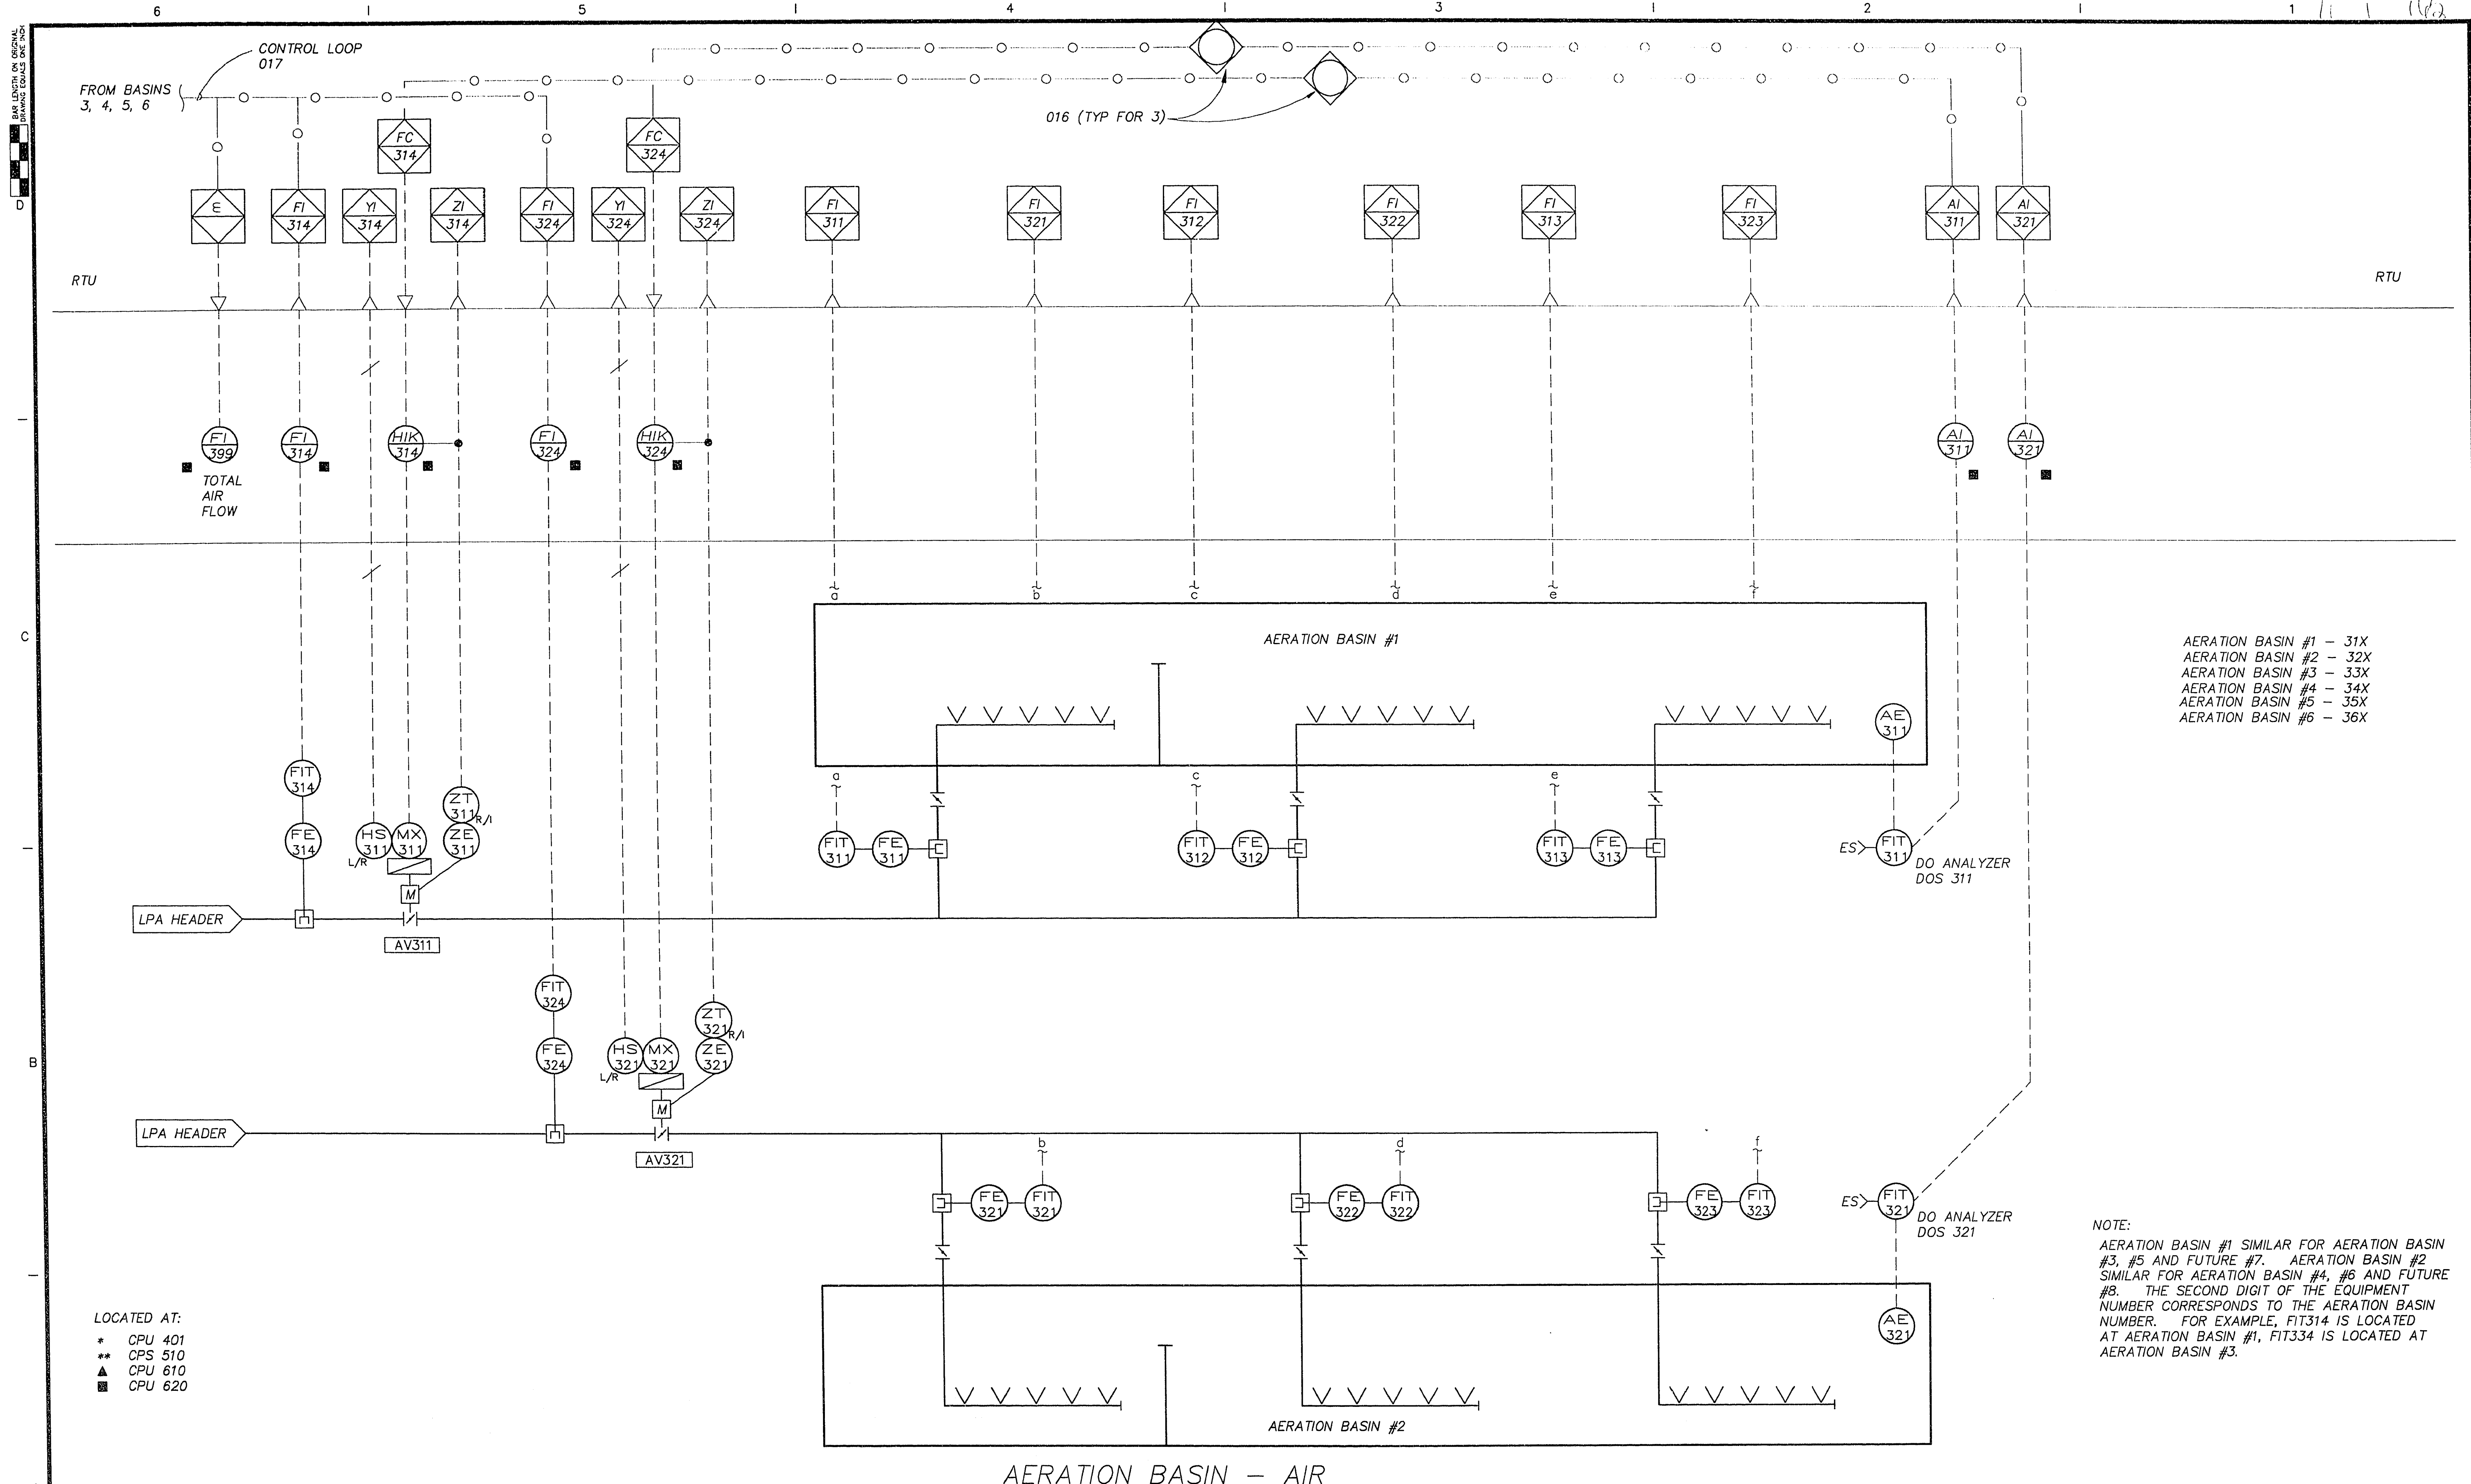

HDR Engineering, Inc.

Issue No.	Description	Date	Drawn	Checked	Responsible	Project Manager
1	CORRECTED ACCORDING TO CONSTRUCTION RECORD	1/95	TDC	EFH	MJH	JJC
A	ISSUED FOR BIDS	4/20/92	RCB	LDS	LDS	JJC

Project Manager	JOHN J. CHUEH
Architect	L. SMITHEY
Civil	Mechanical
Electrical	Structural
Drawn By	R. BURNS

City of Las Vegas

Water Pollution Control Facility
Nitrification / Filtration Facilities

Contract 17
NITRIFICATION COMPLEX

AIR PIPING INSTRUMENTATION DIAGRAM

Date	APRIL 1992	Project No.	00120-084-141	Drawing No.	I-005	Issue	1
Scale	NONE						