



6 1 5 4 3 2 1 11 12 13 

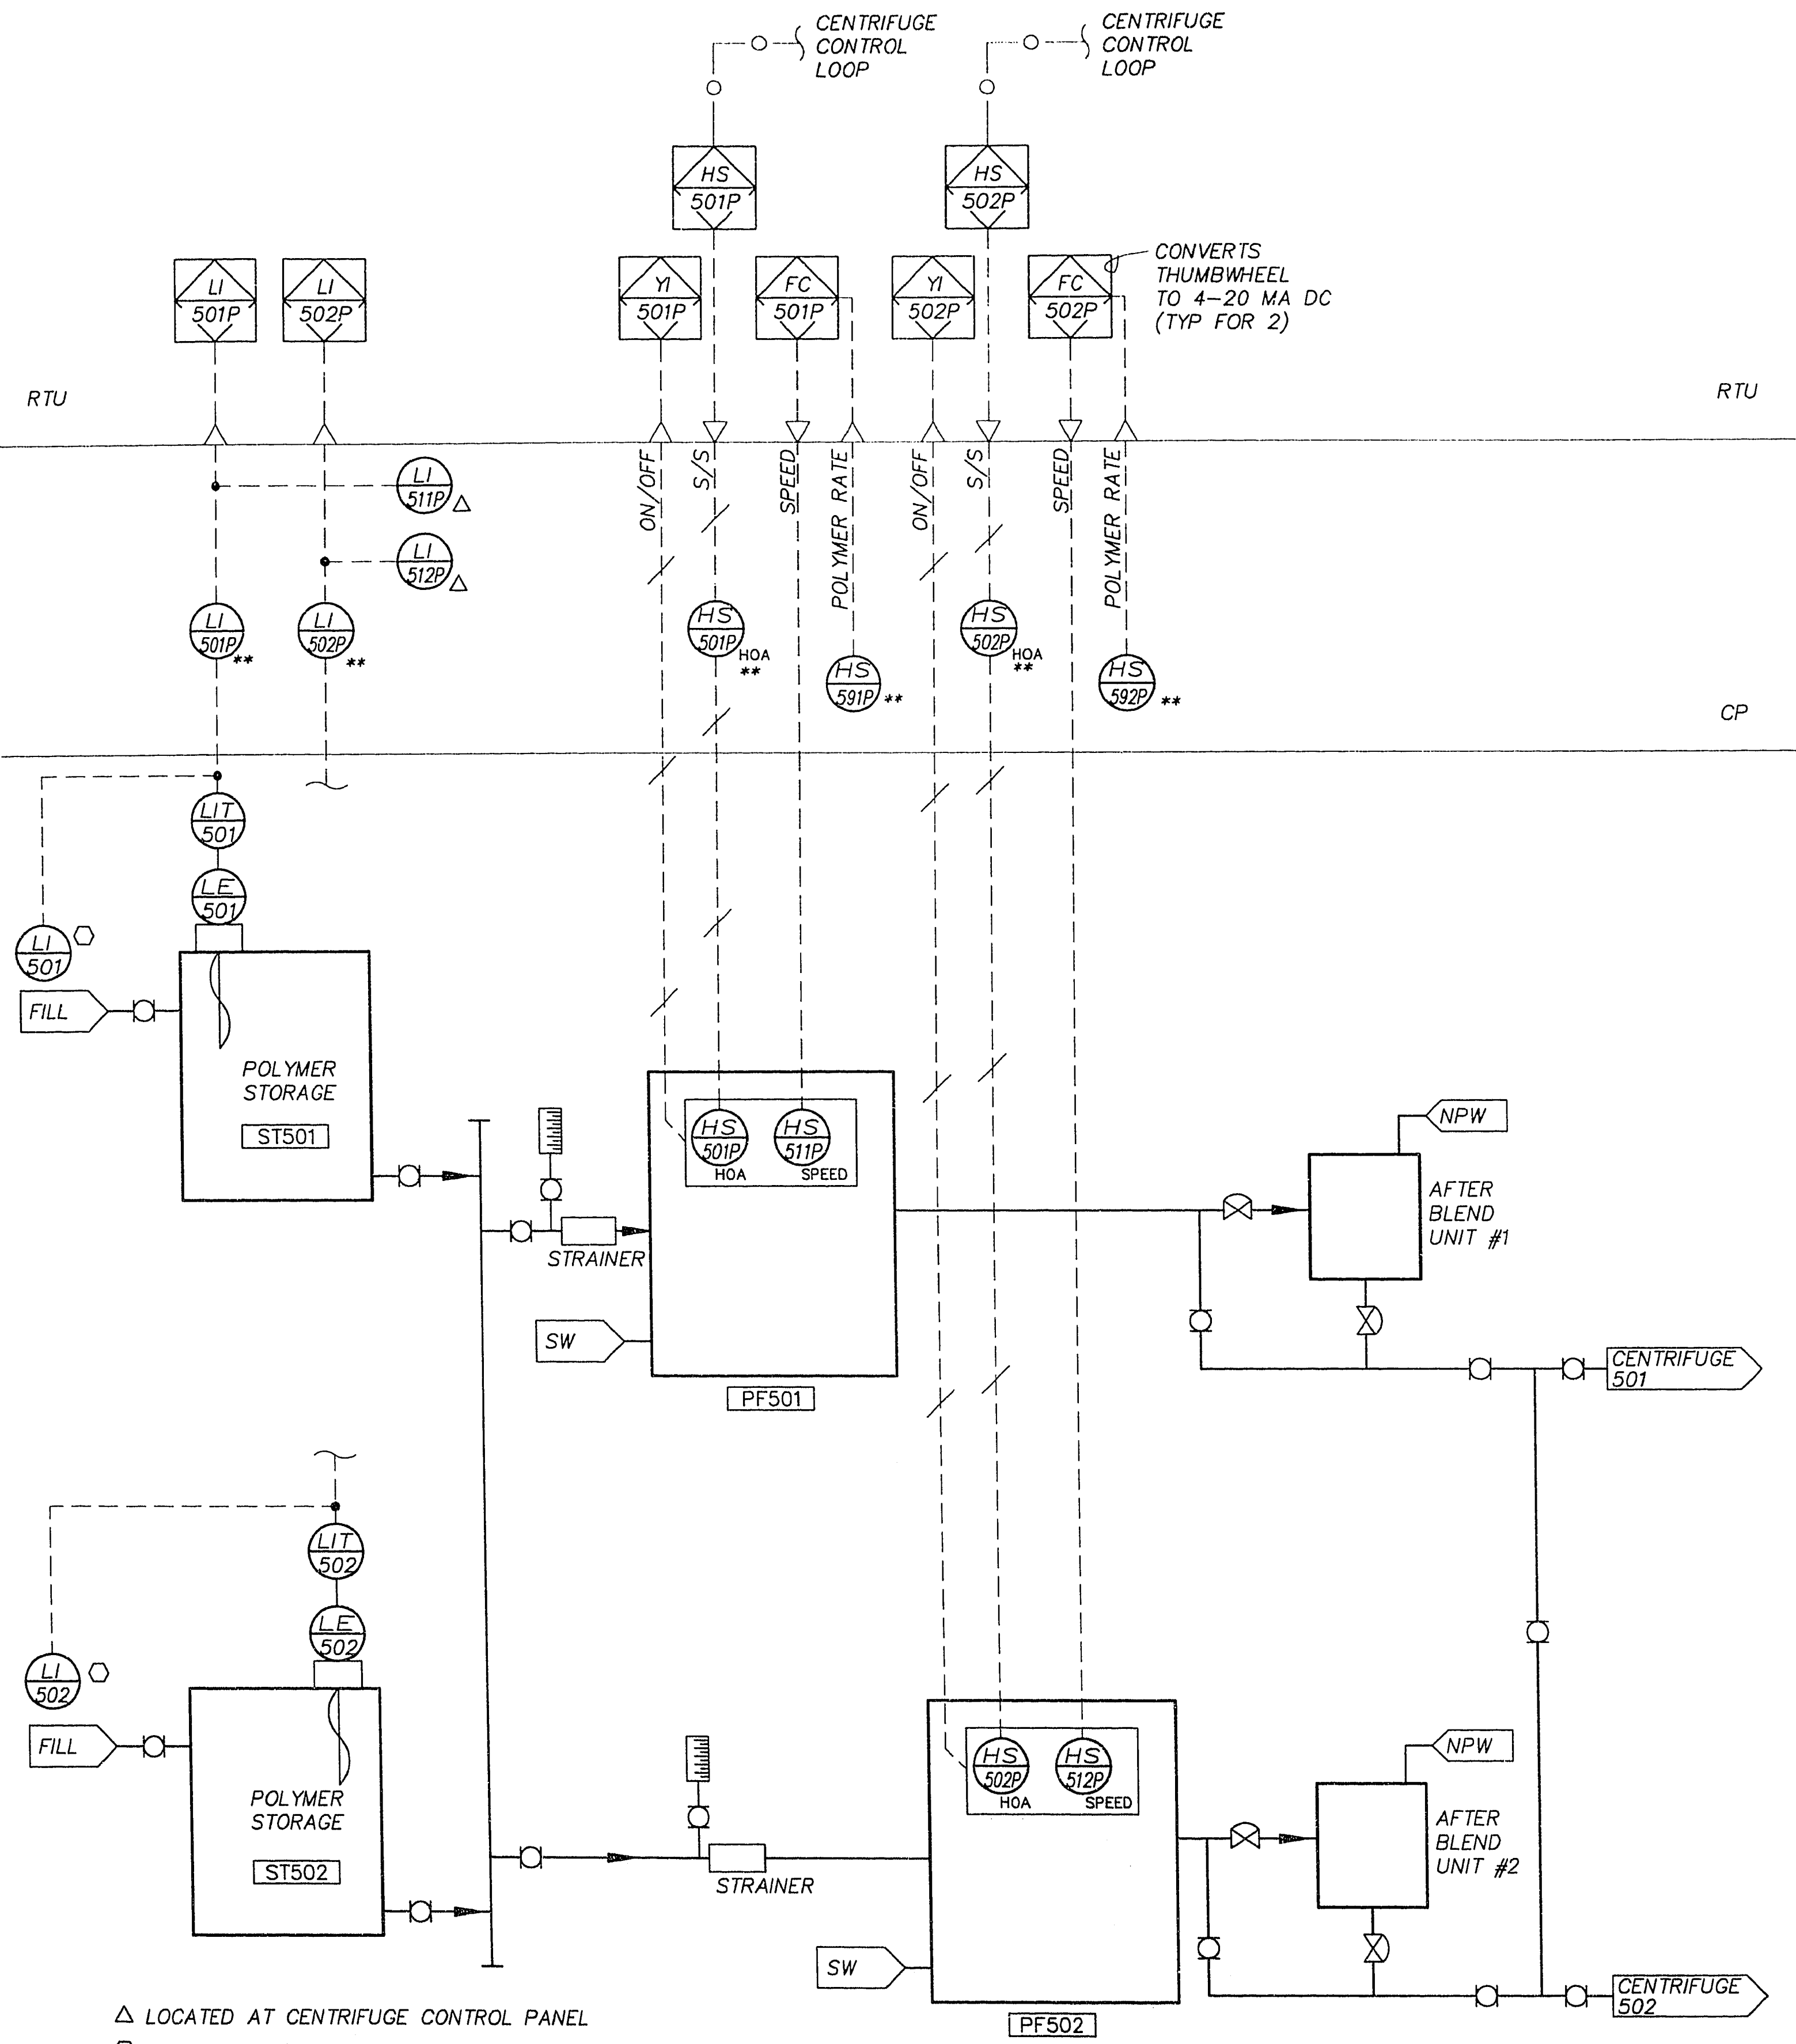

POLYMER

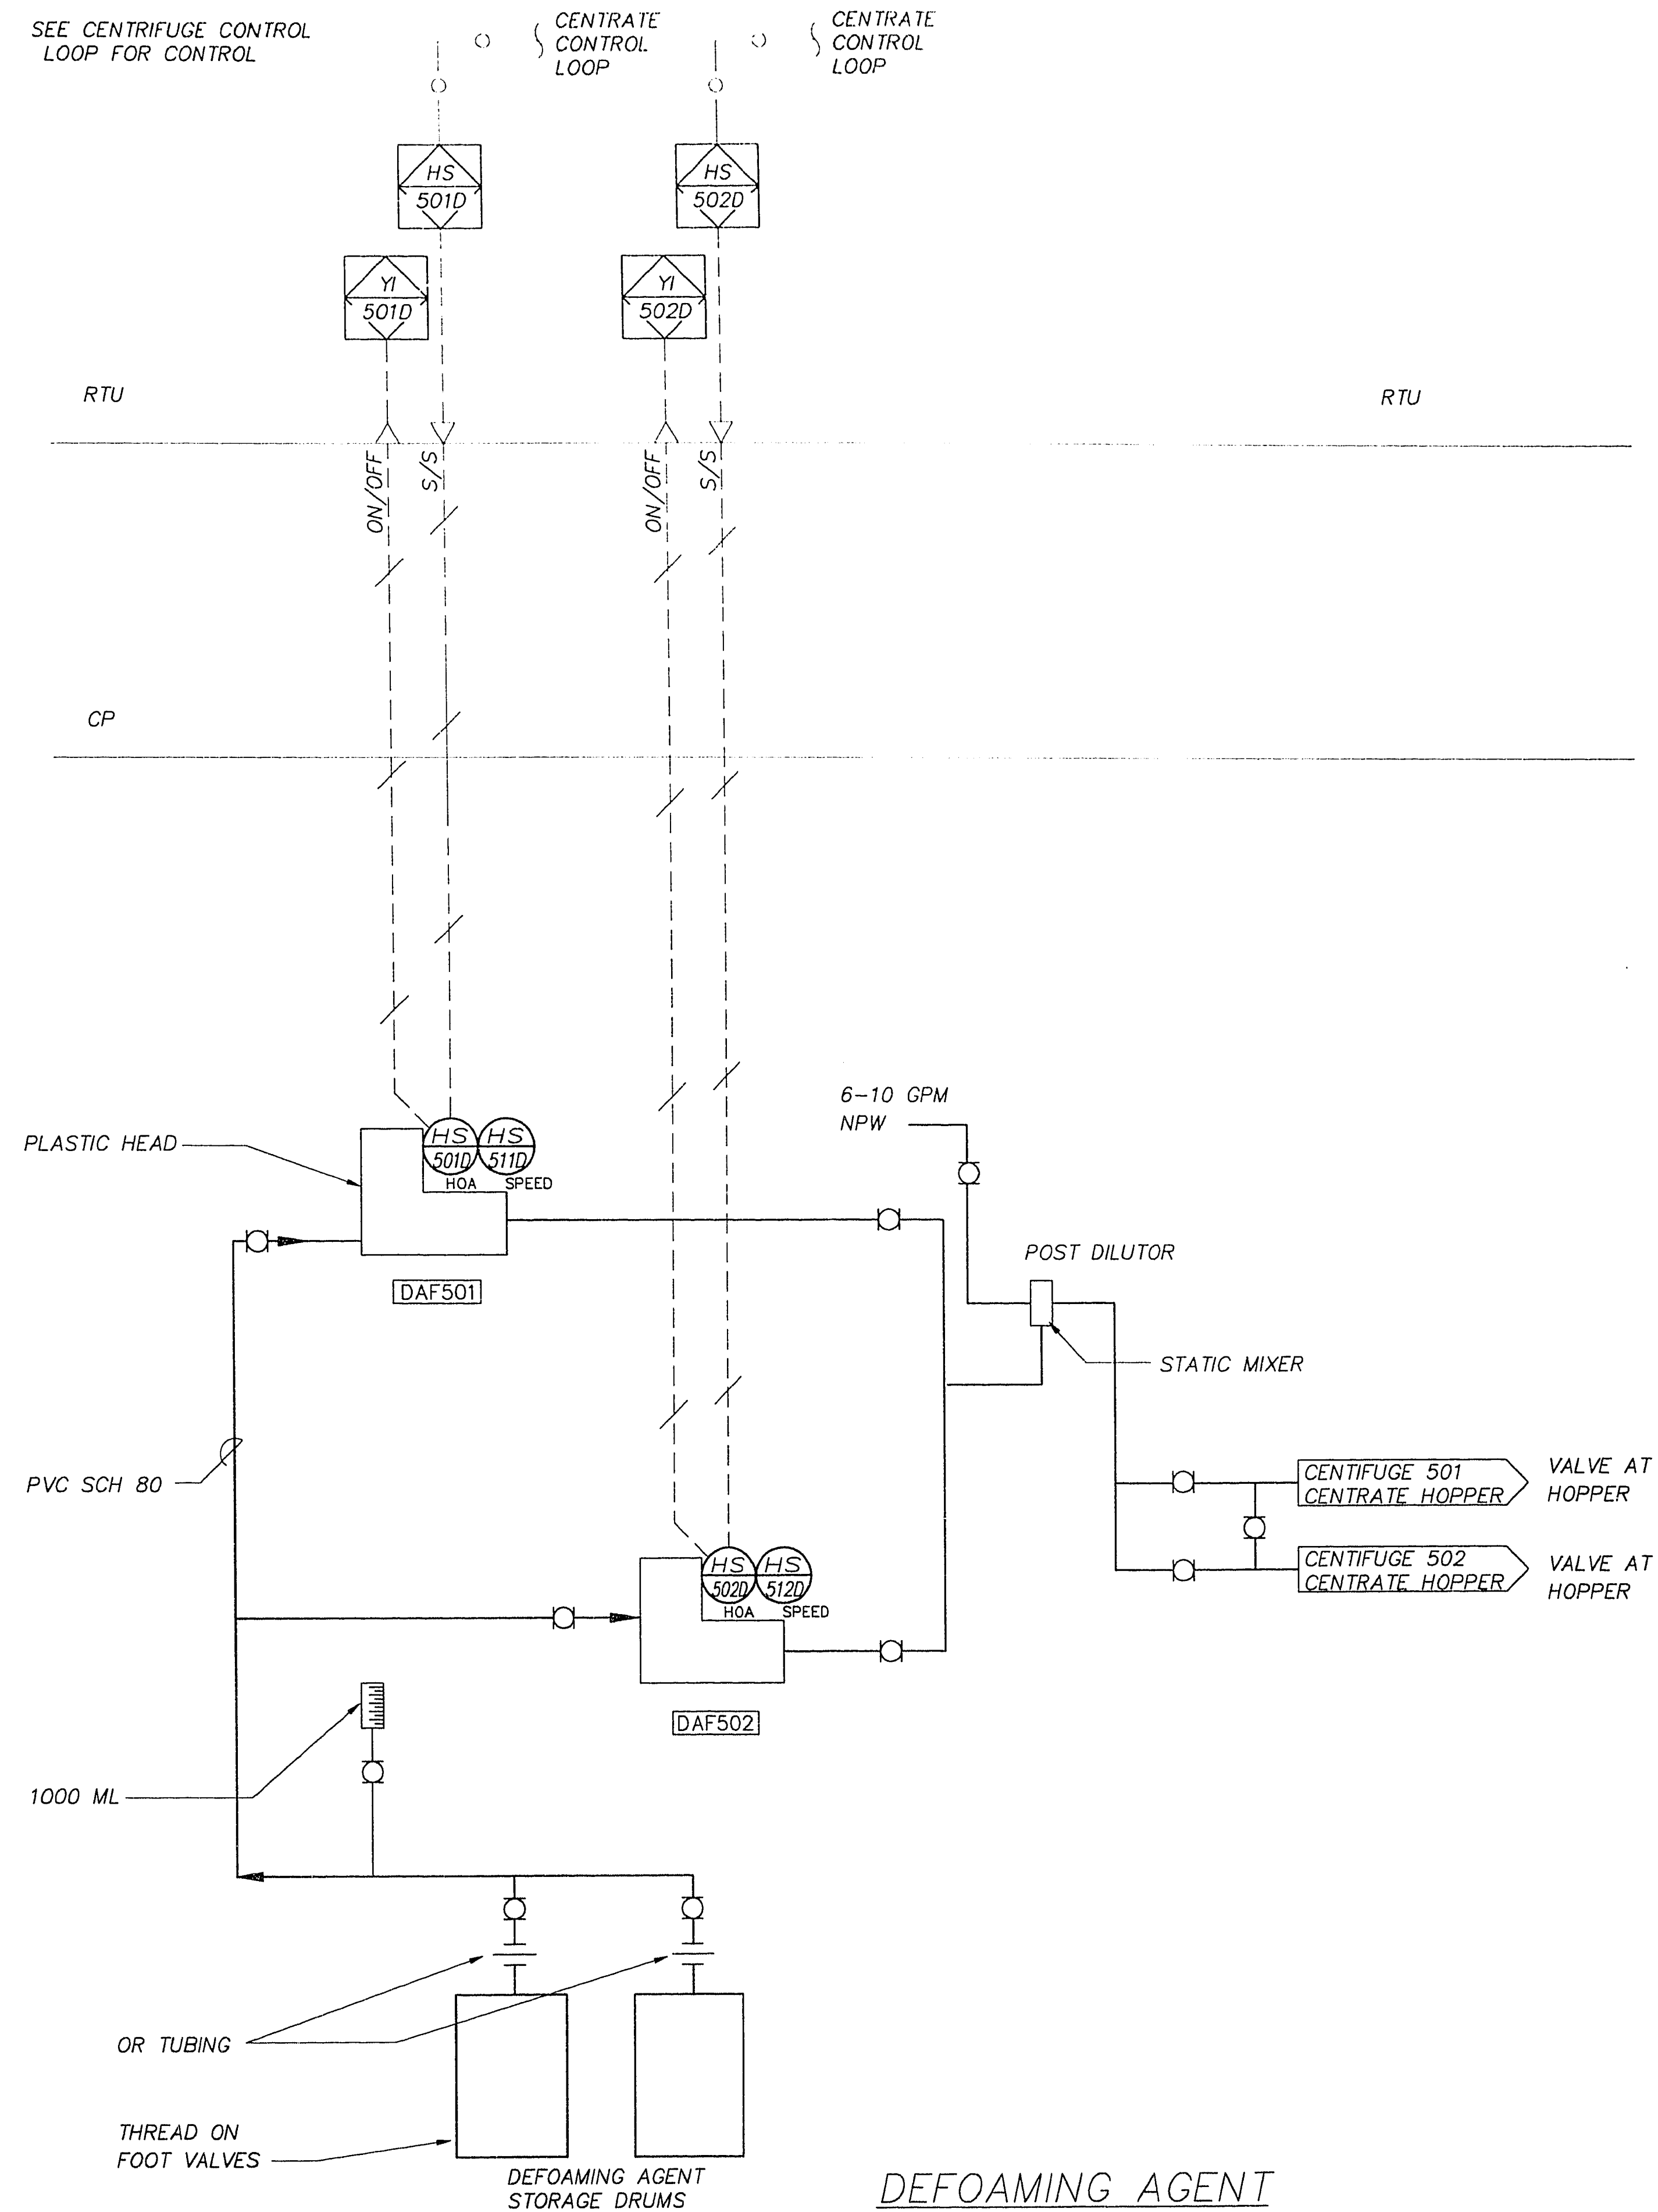

DEFOAMING AGENT



HDR Engineering, Inc.

1	CORRECTED ACCORDING TO CONSTRUCTION RECORD	1/95	RRL	EFH	MJH	JJC
A	ISSUED FOR BIDS	4/20/92	RCB	LDS	LDS	JJC
Issue No.	Description	Date	Drawn	Checked	Responsible Engr.	Project Mgr.

Project Manager	JOHN J. CHUEH
Architect	L. SMITHEY
Civil	Mechanical
Electrical	Structural
Drawn By	R. BURNS

City of Las Vegas
Water Pollution Control Facility
Nitrification / Filtration Facilities
Contract 17
NITRIFICATION COMPLEX

POLYMER & DEFOAMING AGENT
INSTRUMENTATION DIAGRAMS

Date	APRIL 1992	Project No.	00120-084-141	Drawing No.	I-008	Issue	1
Scale	NONE						