


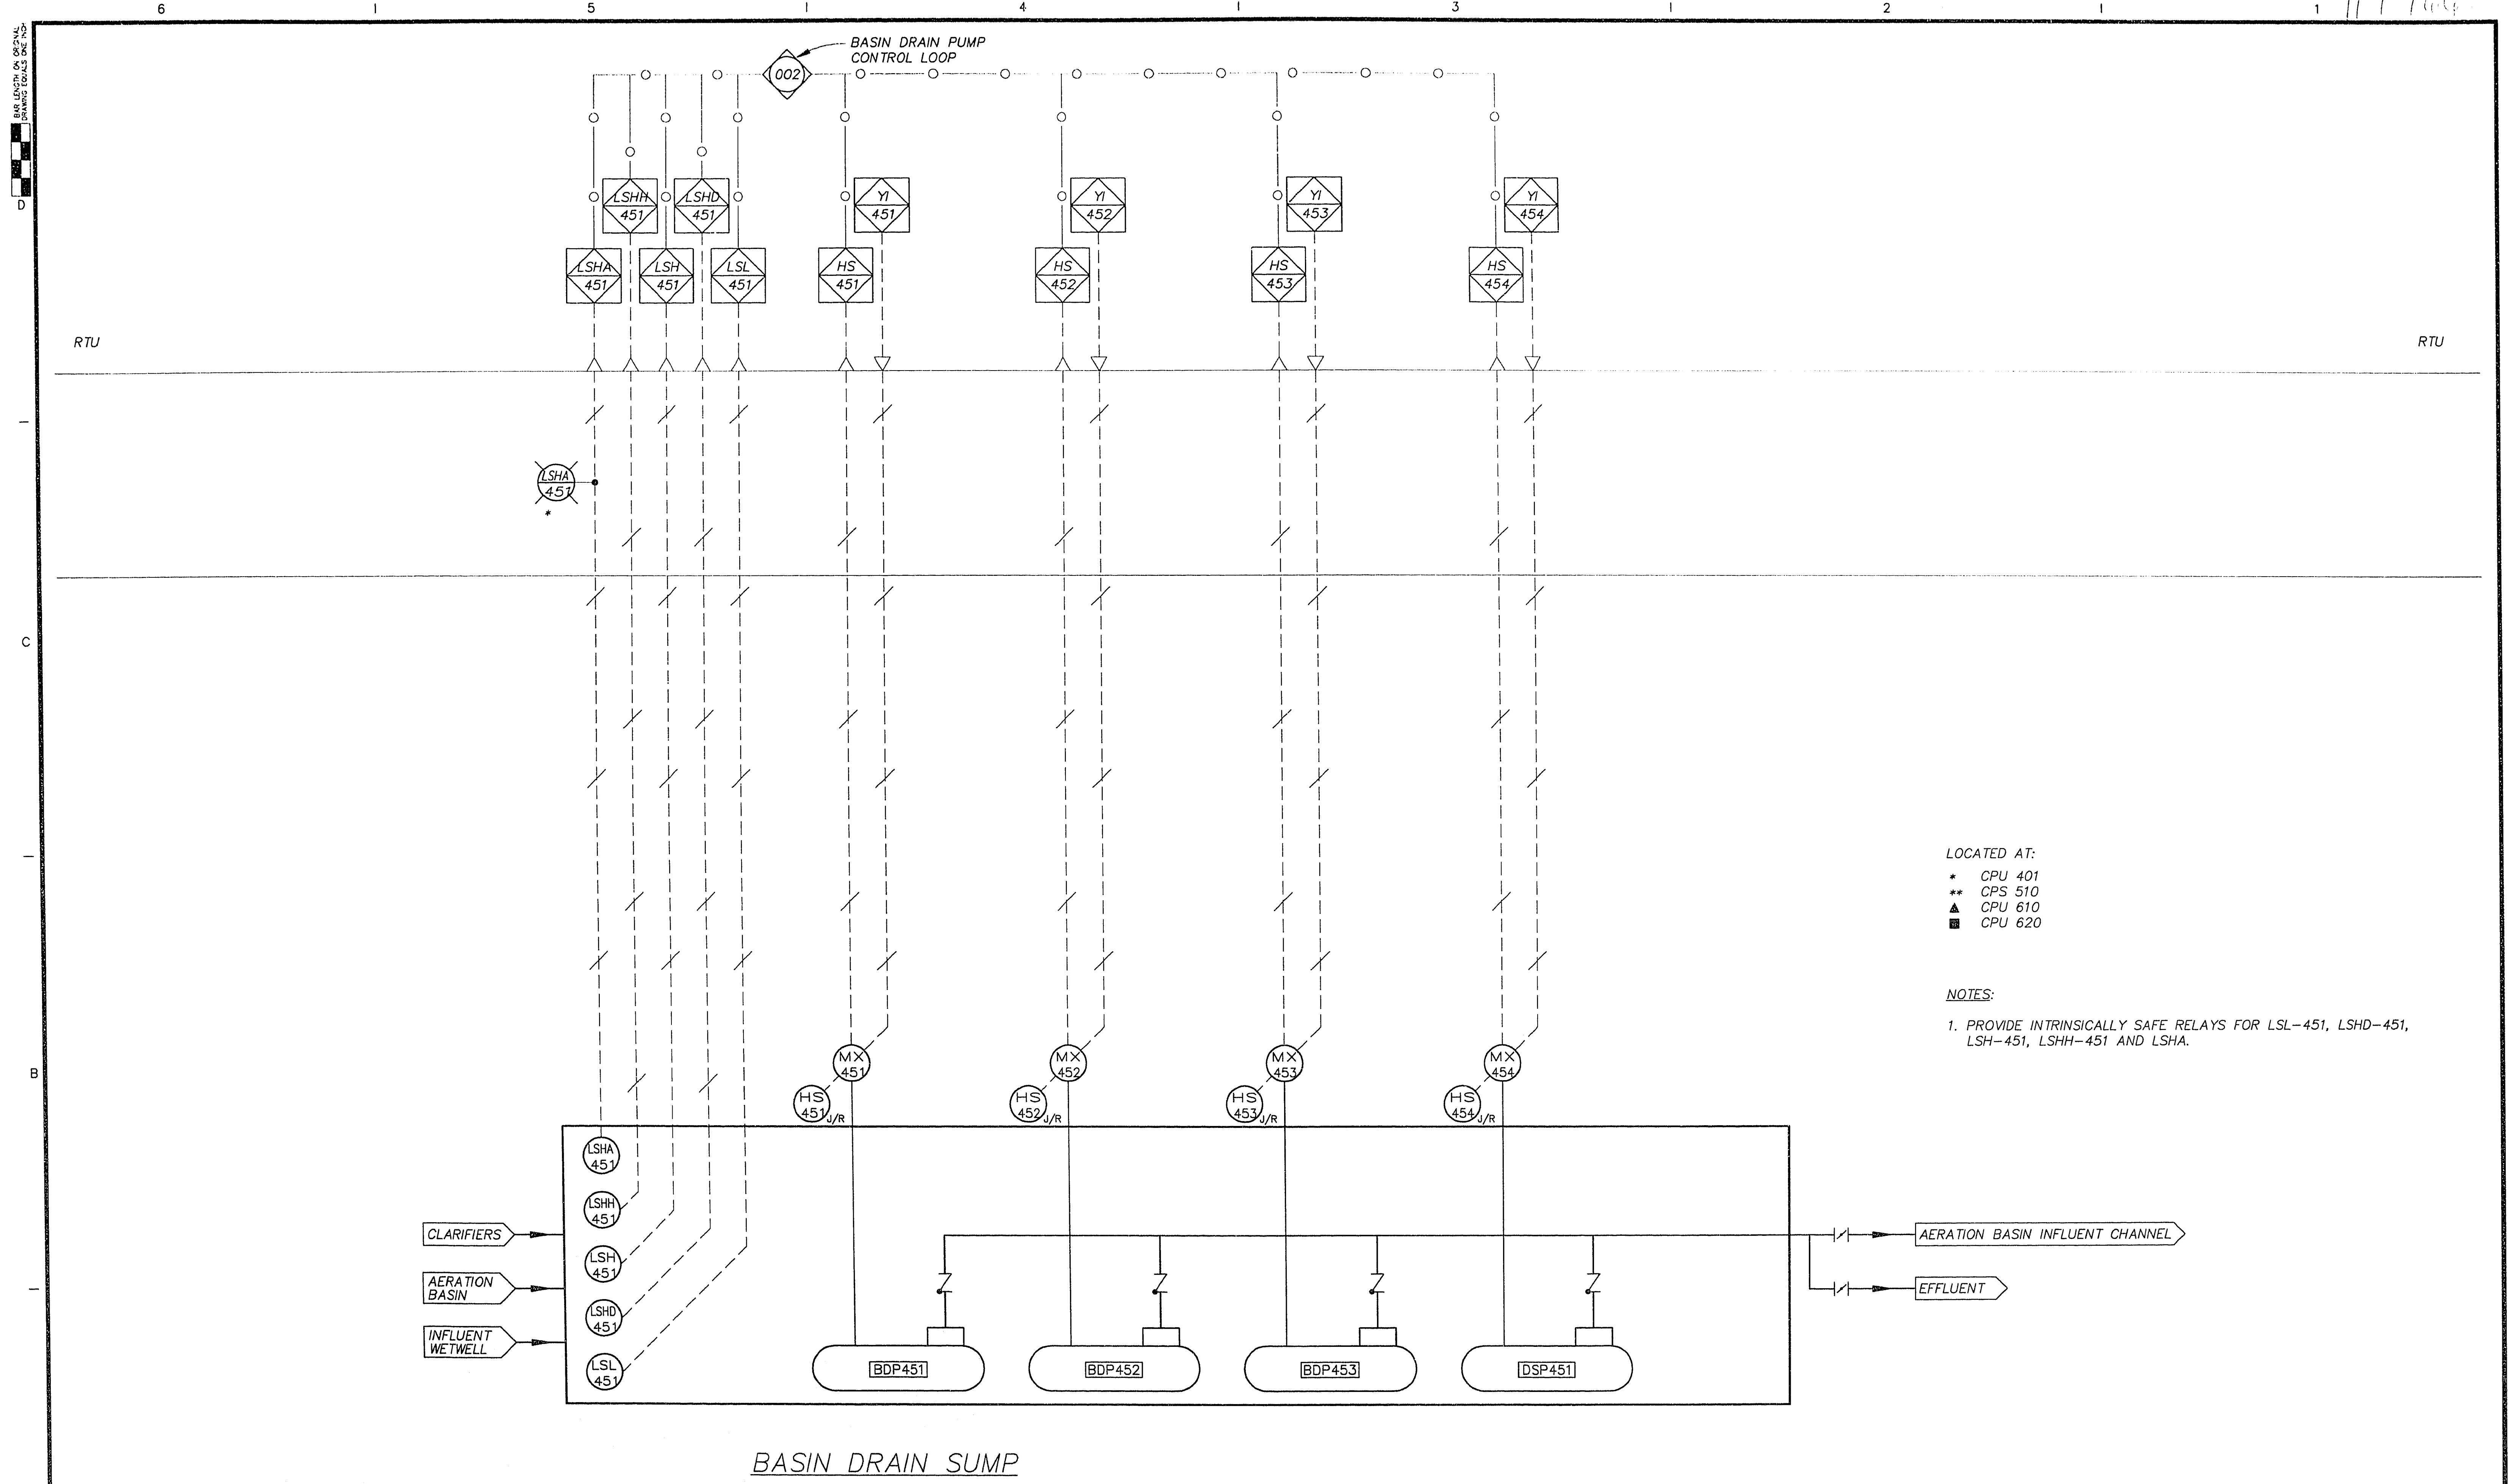

LOCATED AT:
* CPU 401
** CPU 510
▲ CPU 610
■ CPU 620

NOTES:
1. PROVIDE INTRINSICALLY SAFE RELAYS FOR LSL-451, LSHD-451, LSH-451, LSHH-451 AND LSHA.



HDR Engineering, Inc.

1	CORRECTED ACCORDING TO CONSTRUCTION RECORD	1/95	RRL	EFH	MJH	JJC
0	ISSUED FOR CONSTRUCTION	8/20/92	RCB	LDS	LDS	JJC
Issue No.	Description	Date	Drawn	Chkd.	Resp. Engr.	Proj. Mgr.

Project Manager	JOHN J. CHUEH
Architect	L. SMITHEY
Civil	
Electrical	
Drawn By	R. BURNS

City of Las Vegas
Water Pollution Control Facility
Nitrification / Filtration Facilities
Contract 17
NITRIFICATION COMPLEX

BASIN DRAIN SUMP INSTRUMENTATION DIAGRAM

Date	AUGUST 1992	Project No.	00120-084-141	Drawing No.	I-009	Issue	1
Scale	NONE						