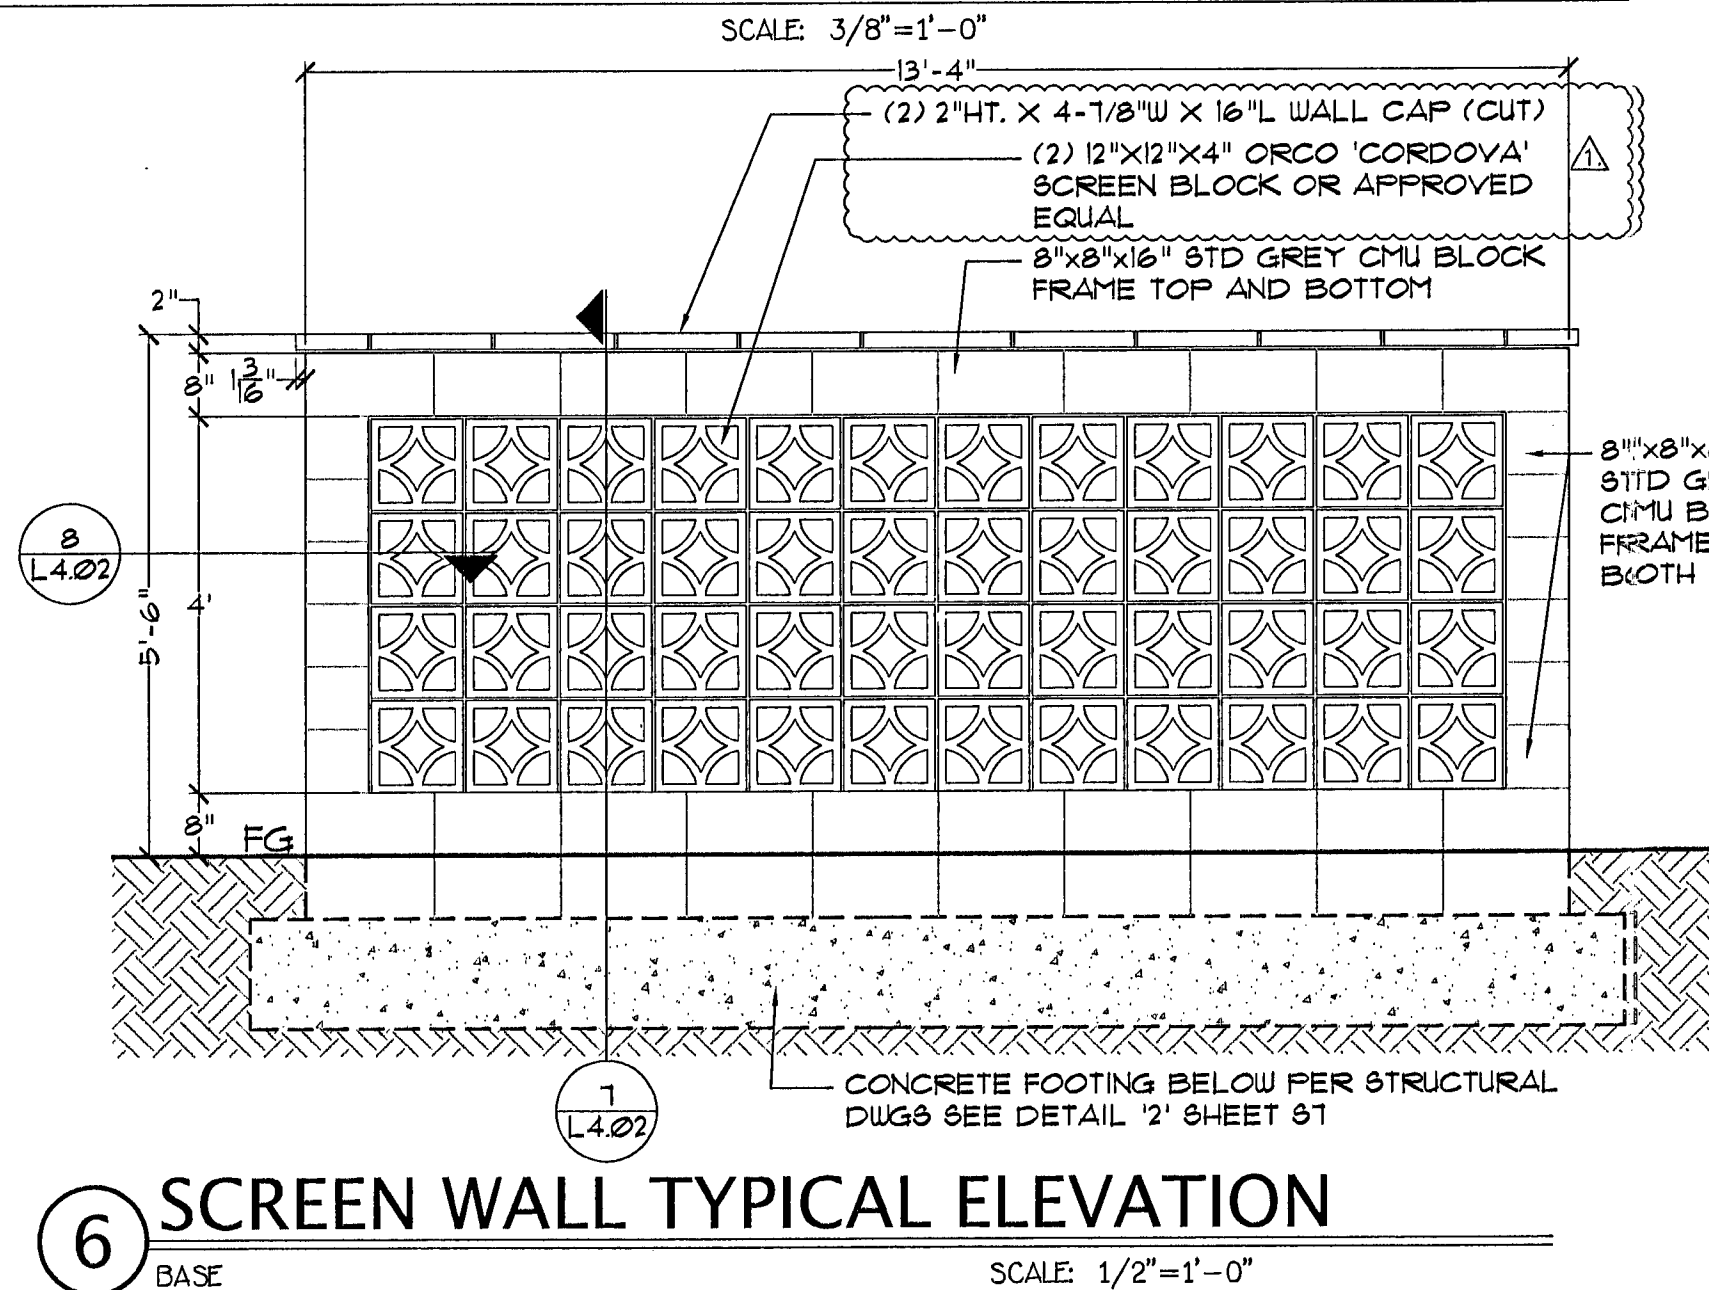
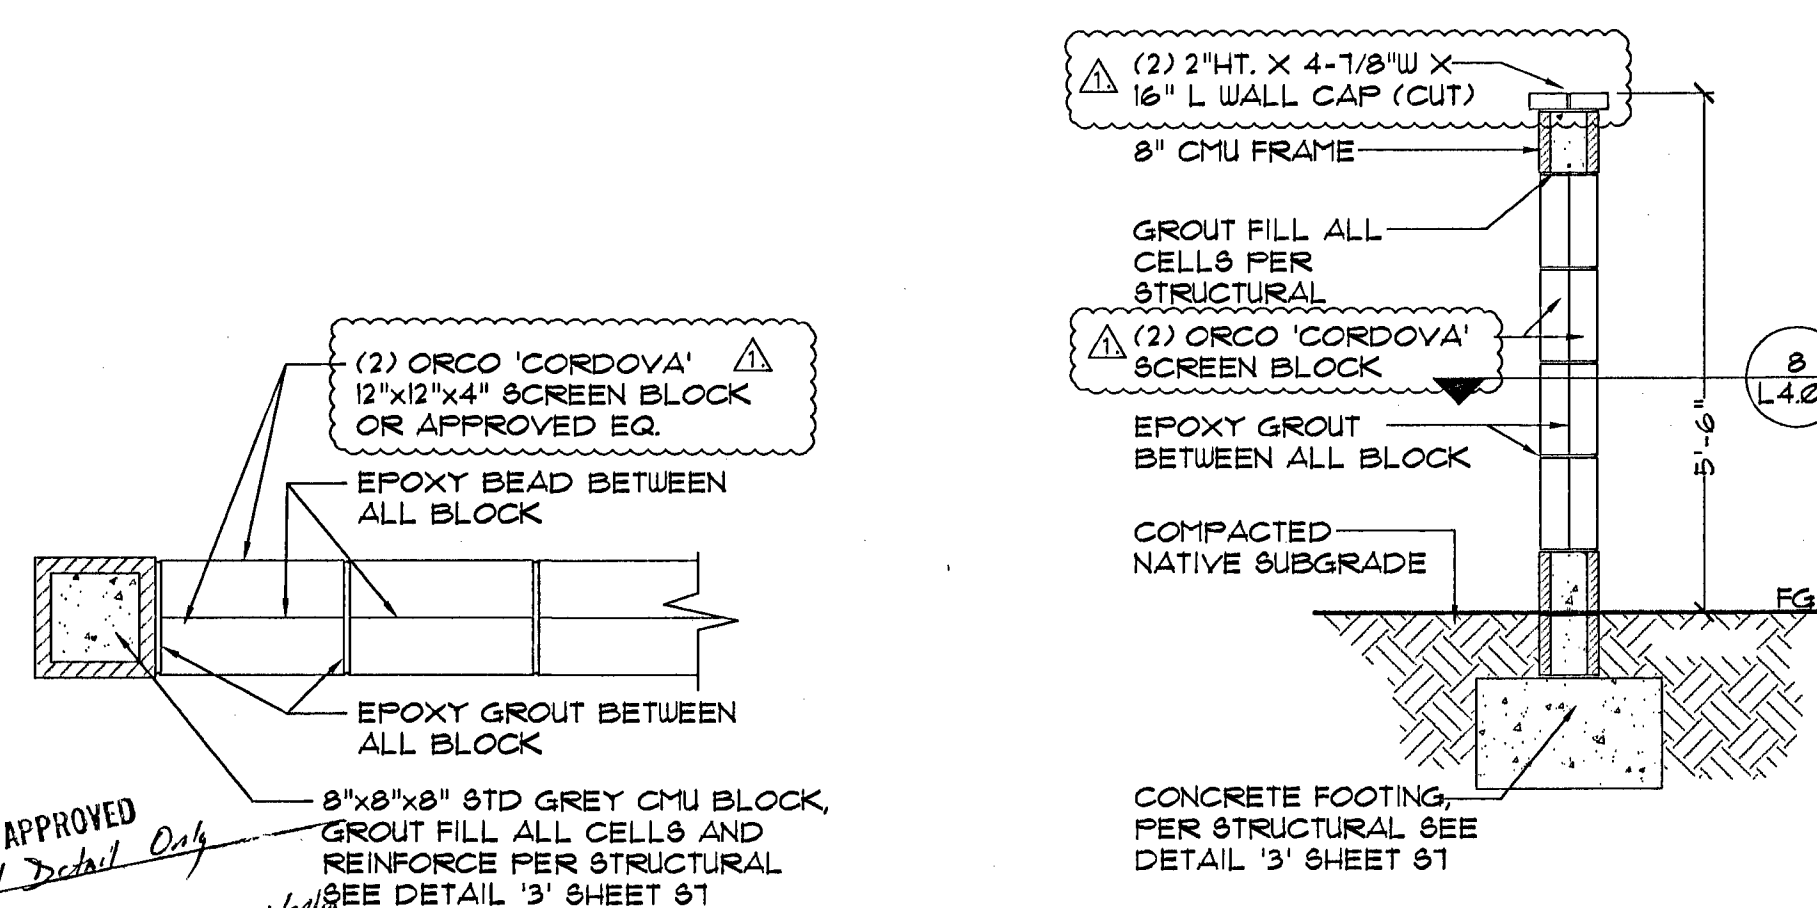
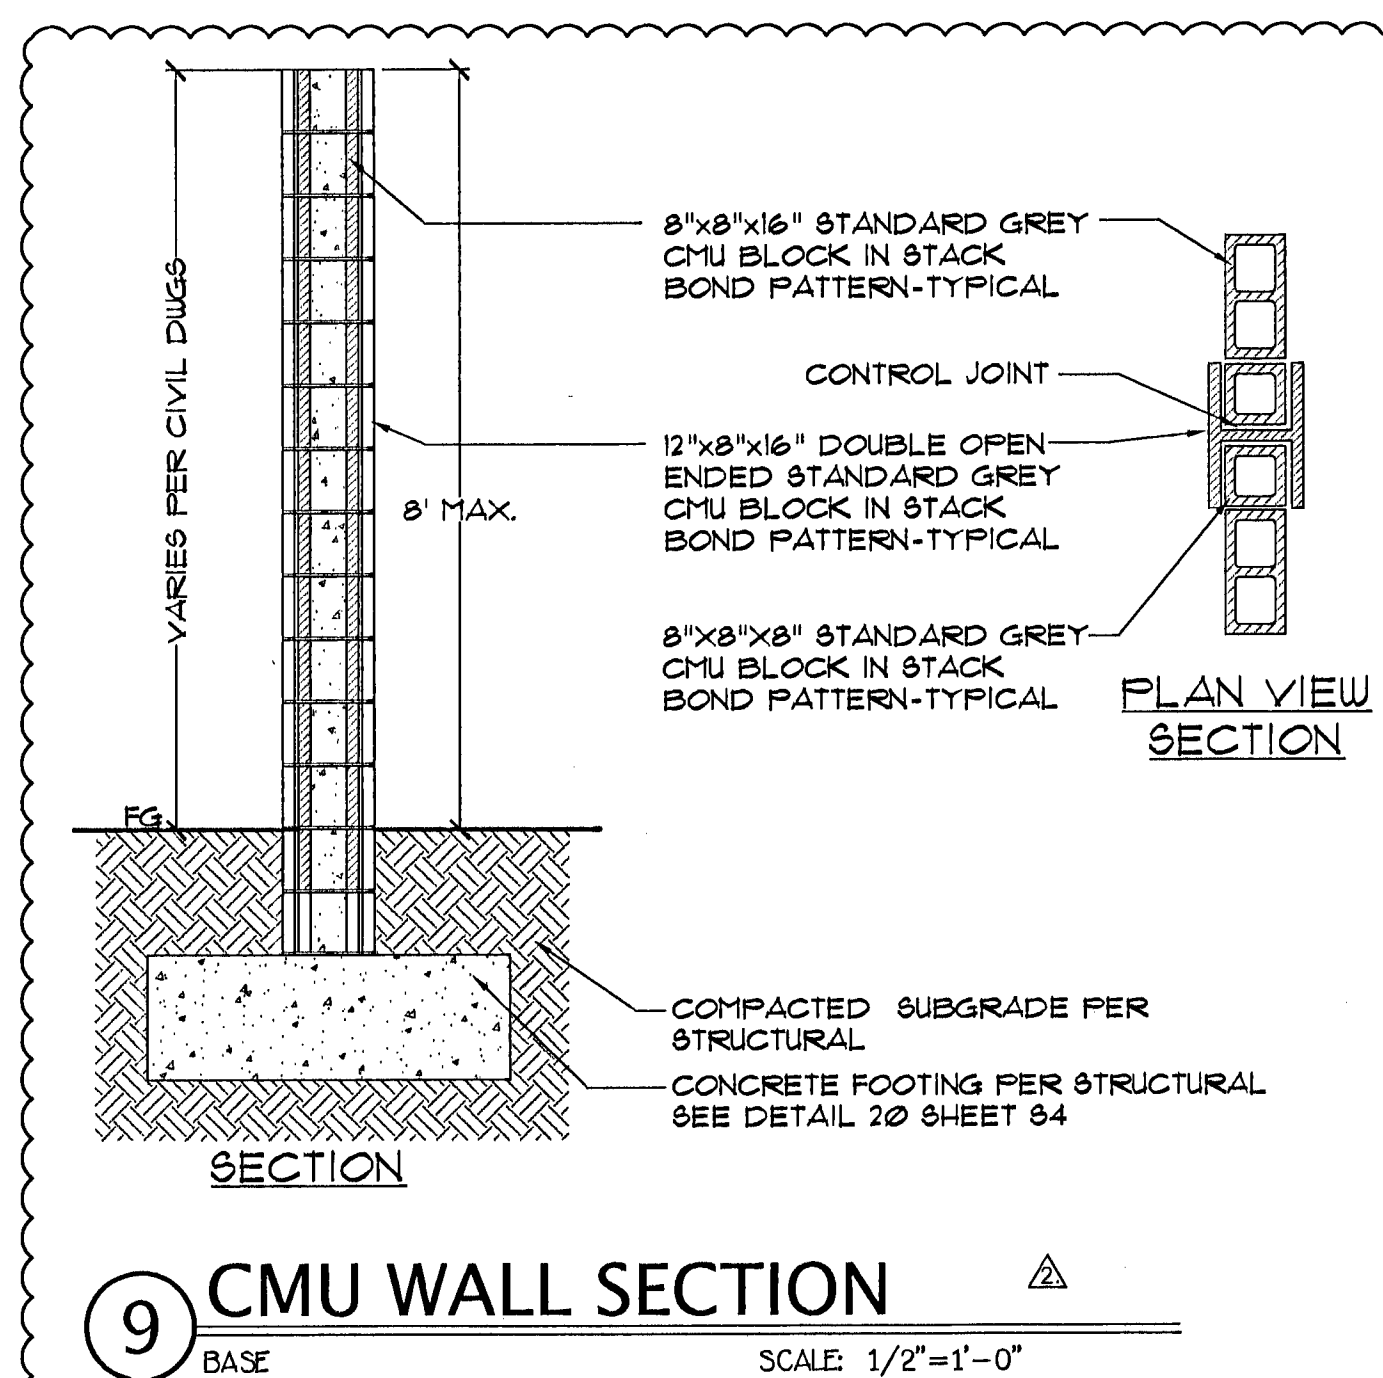
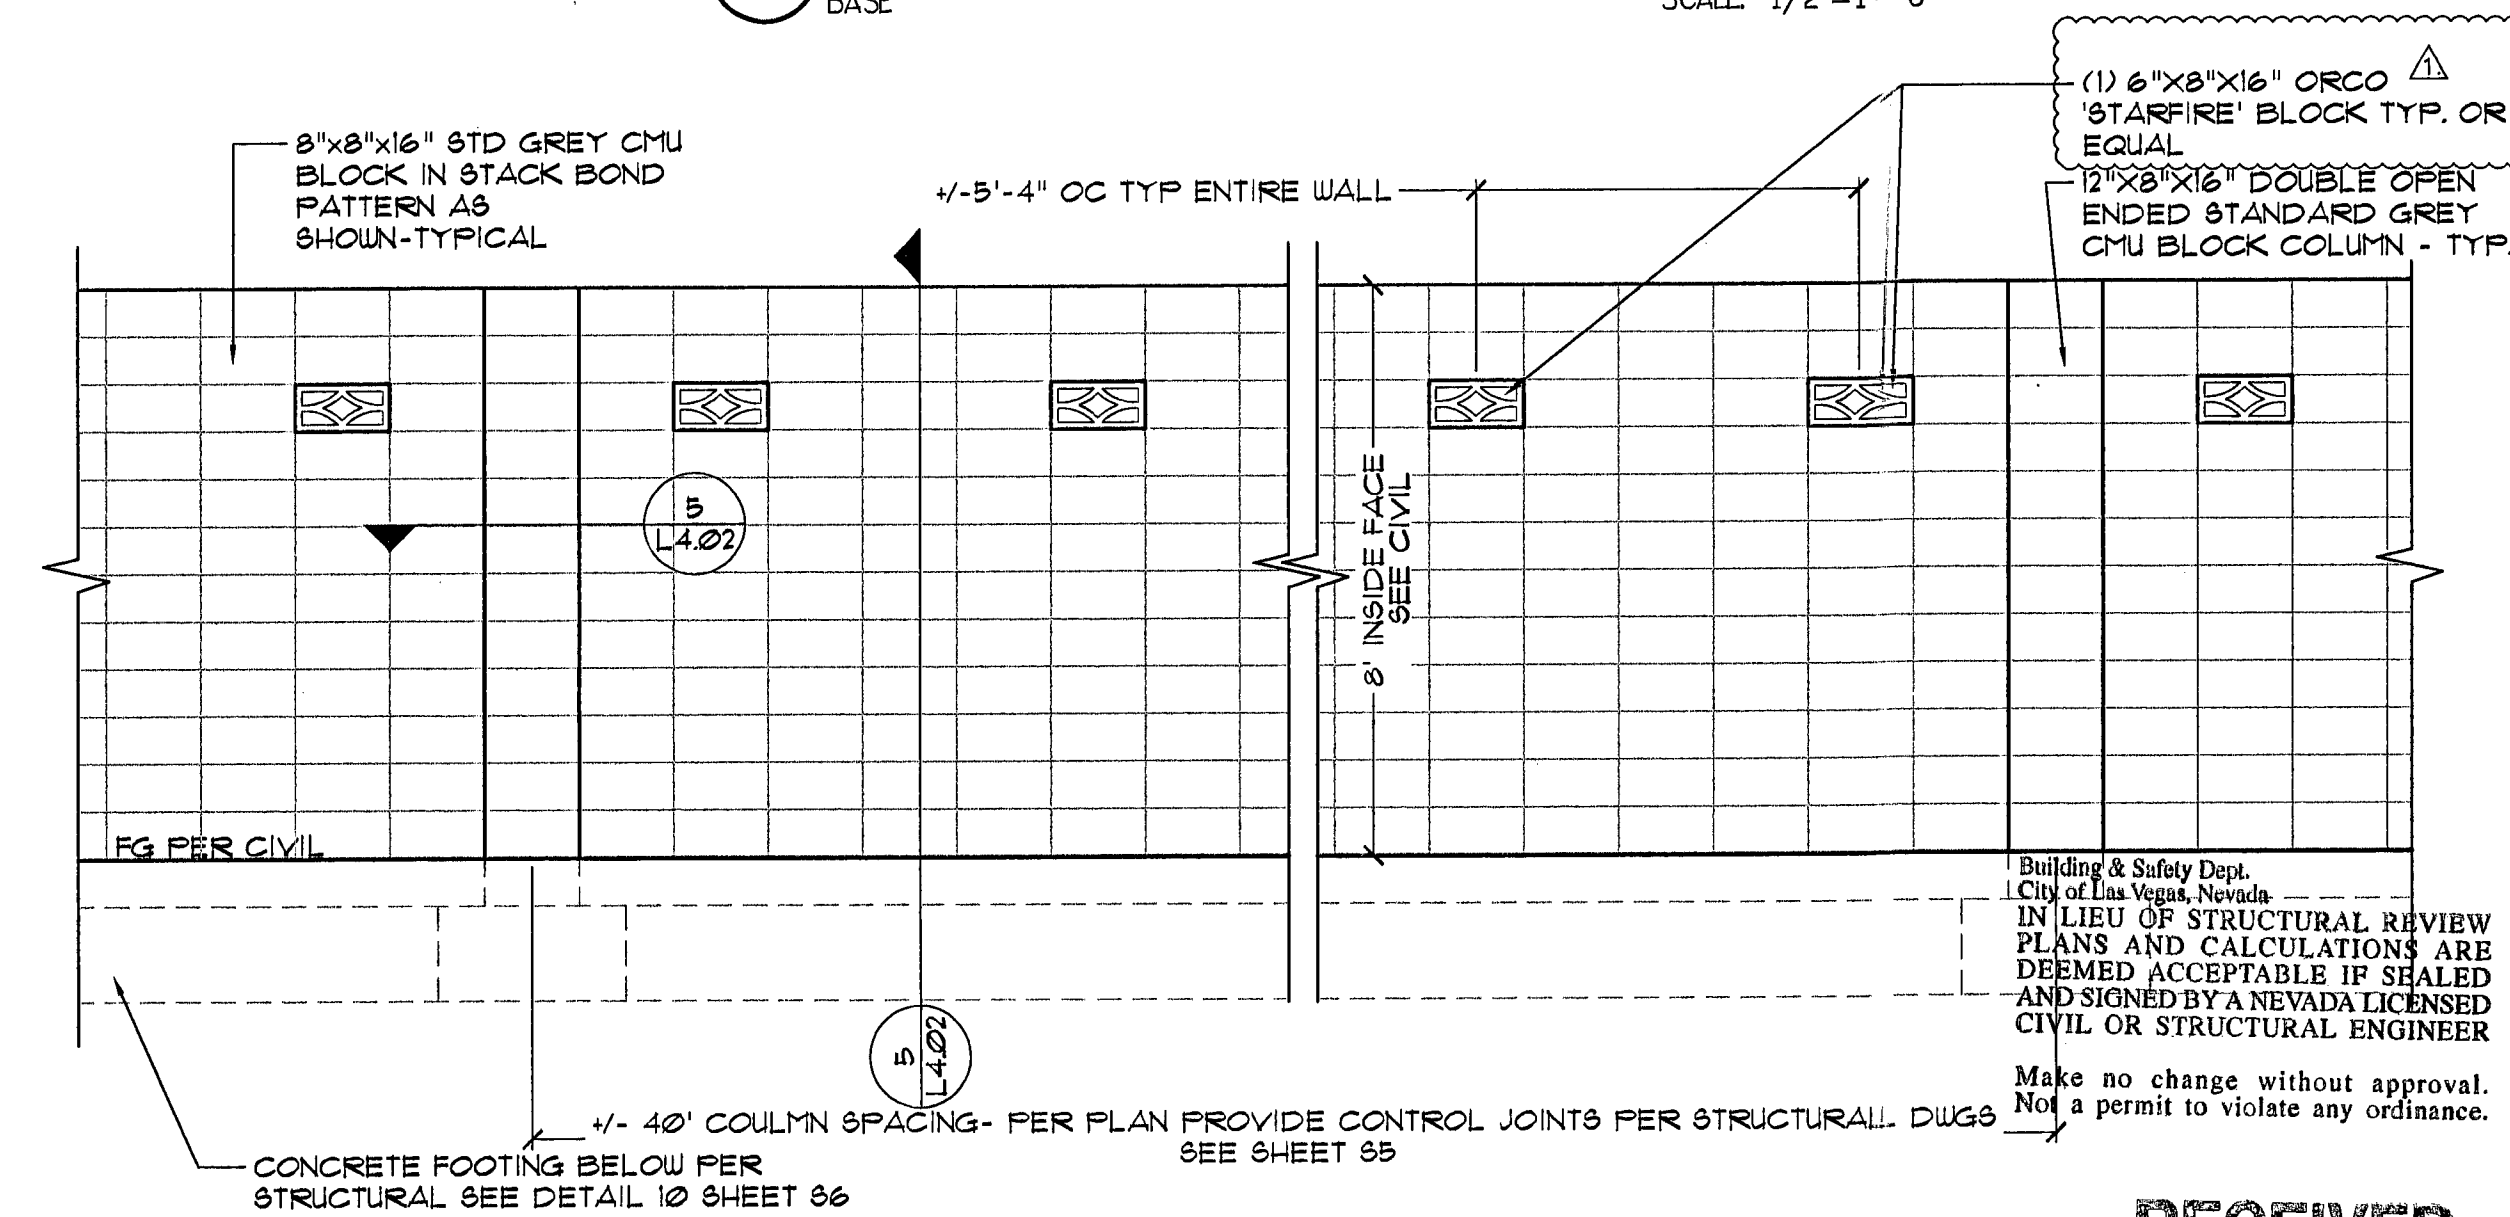
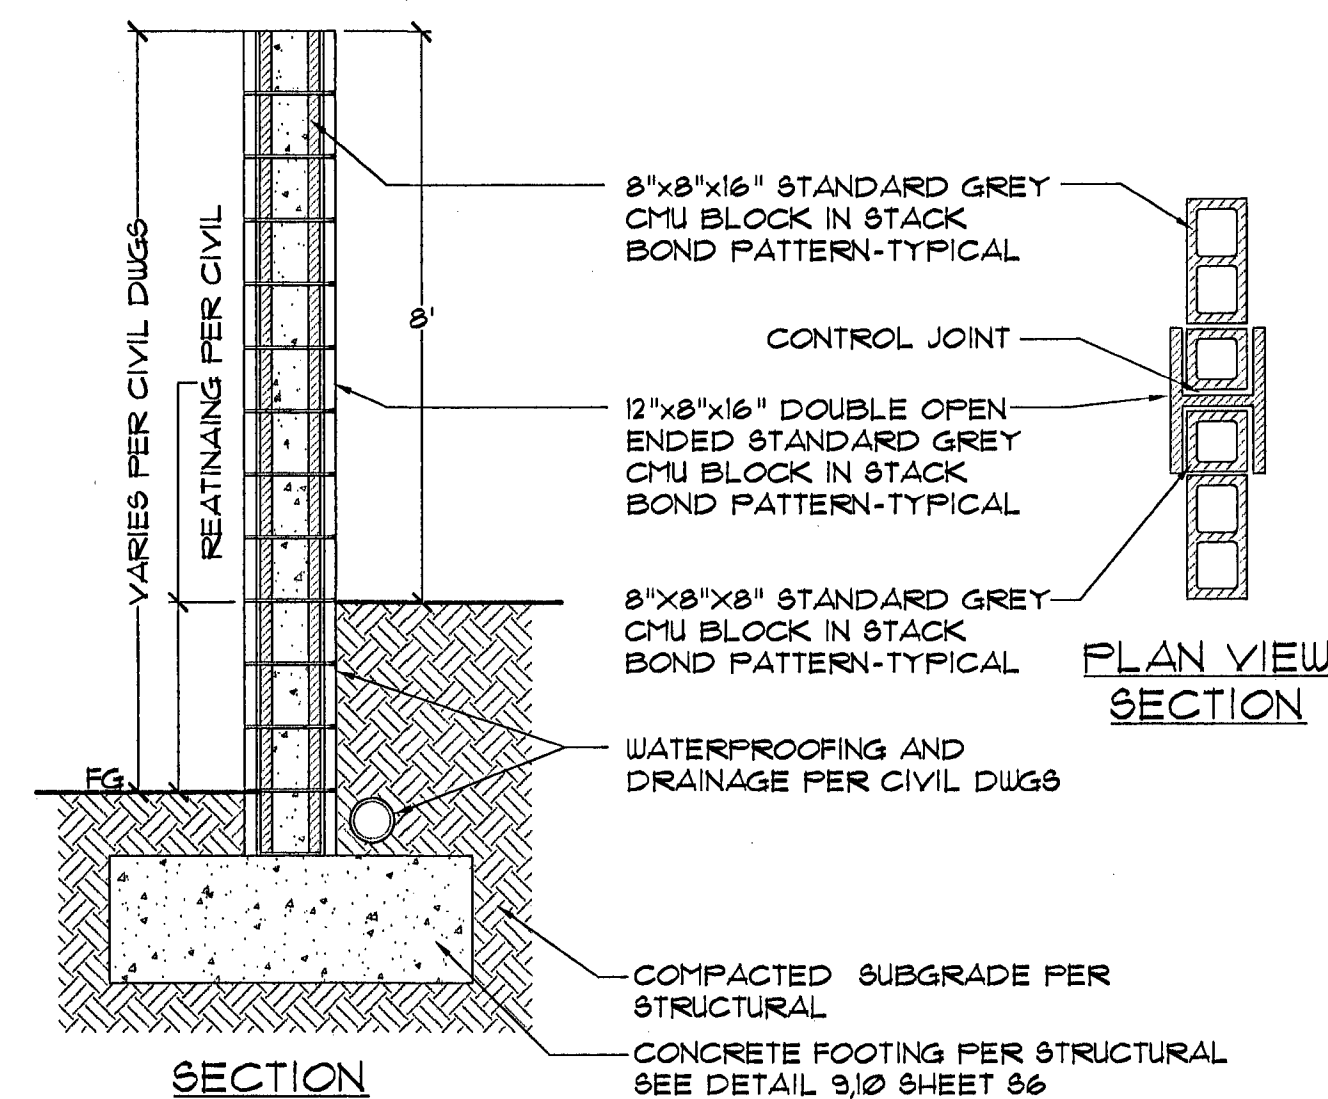
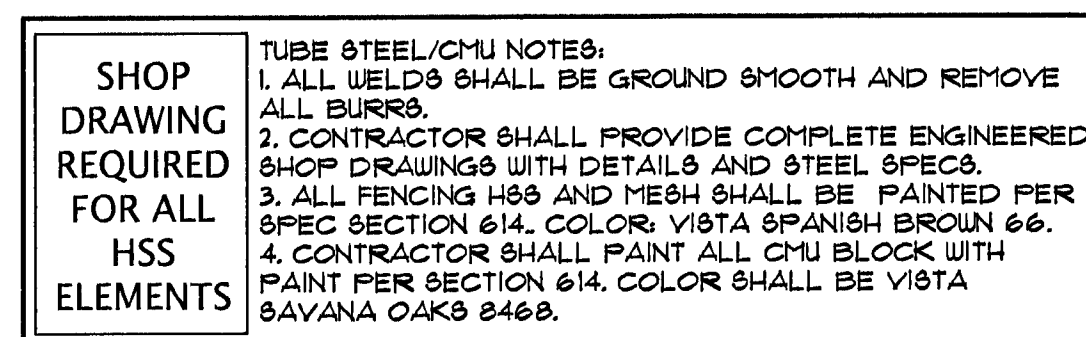
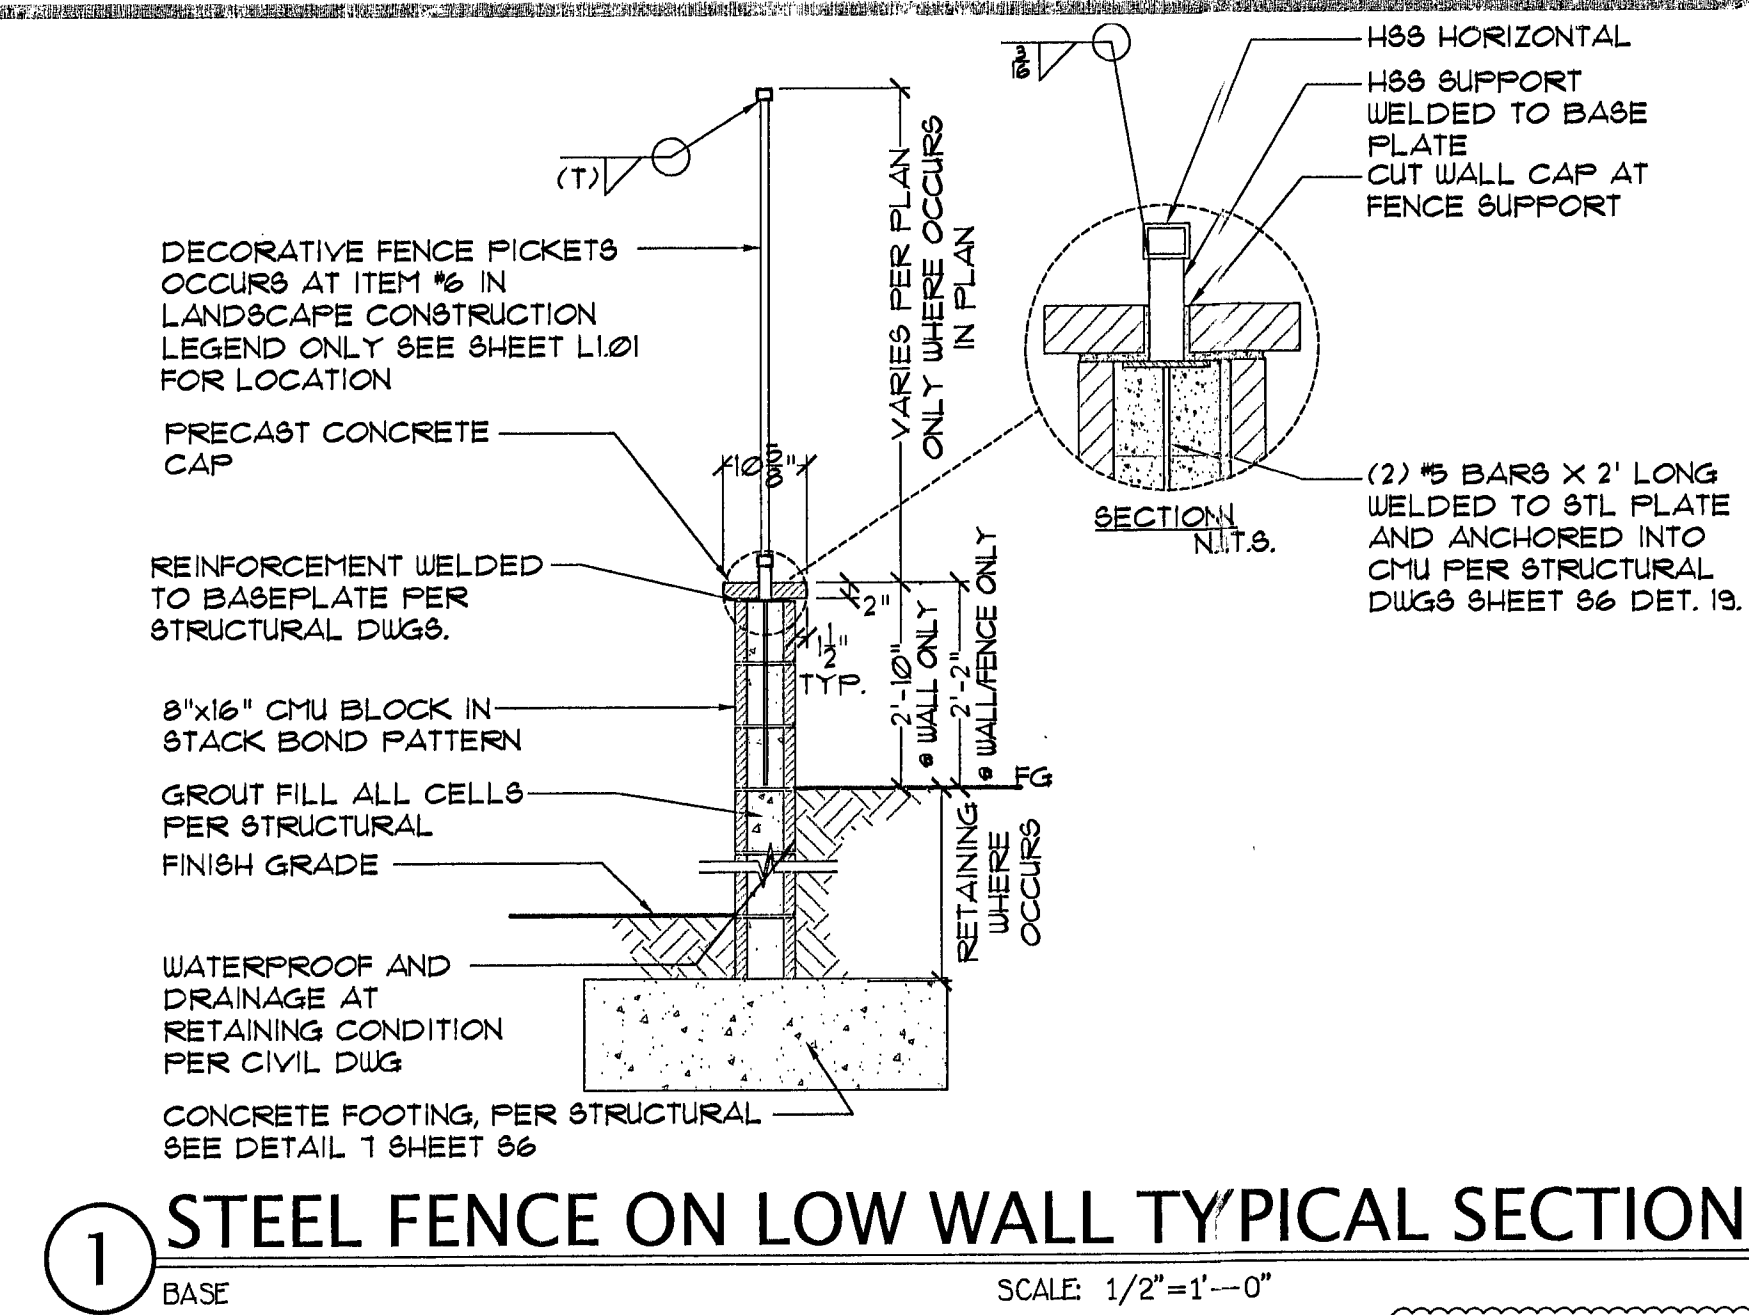
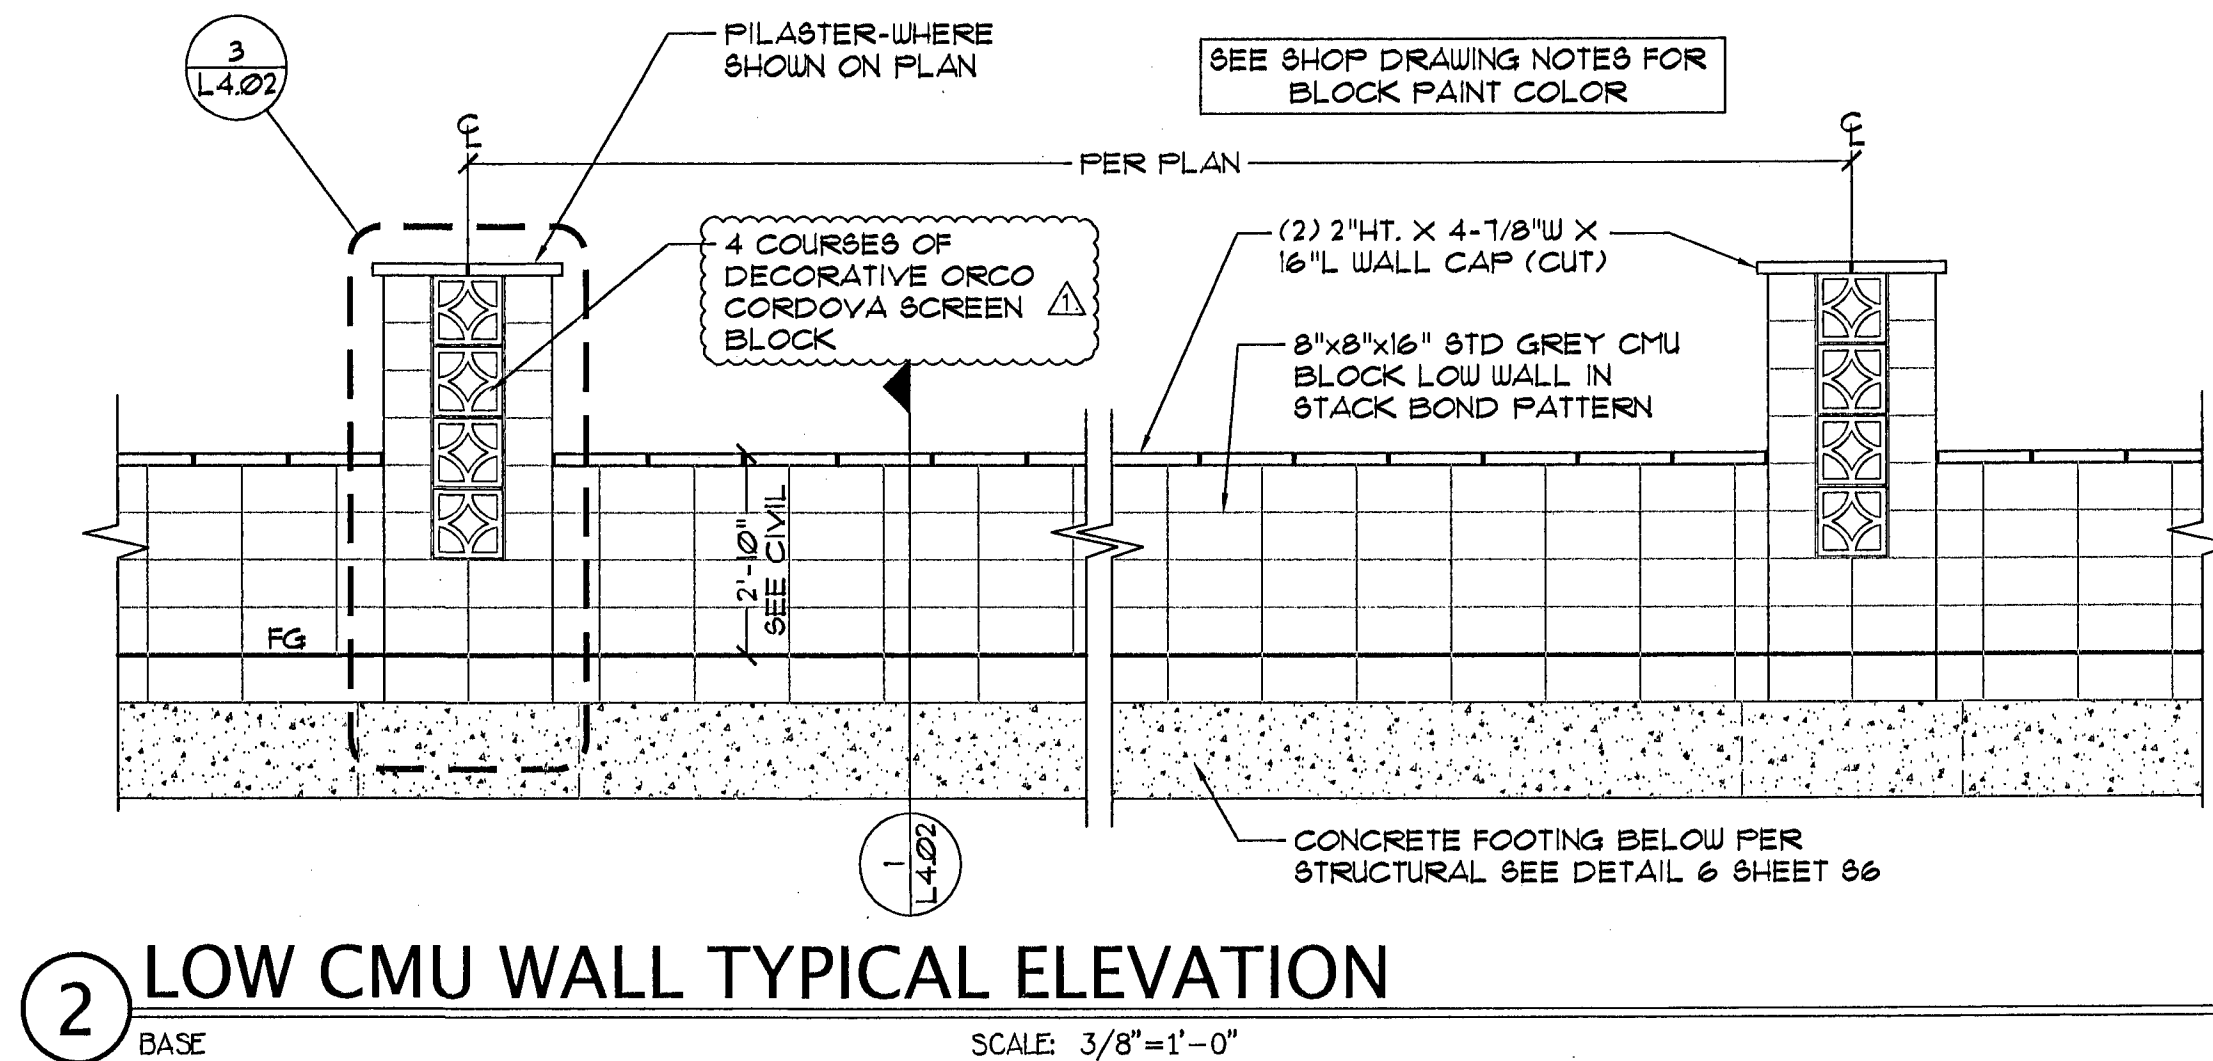
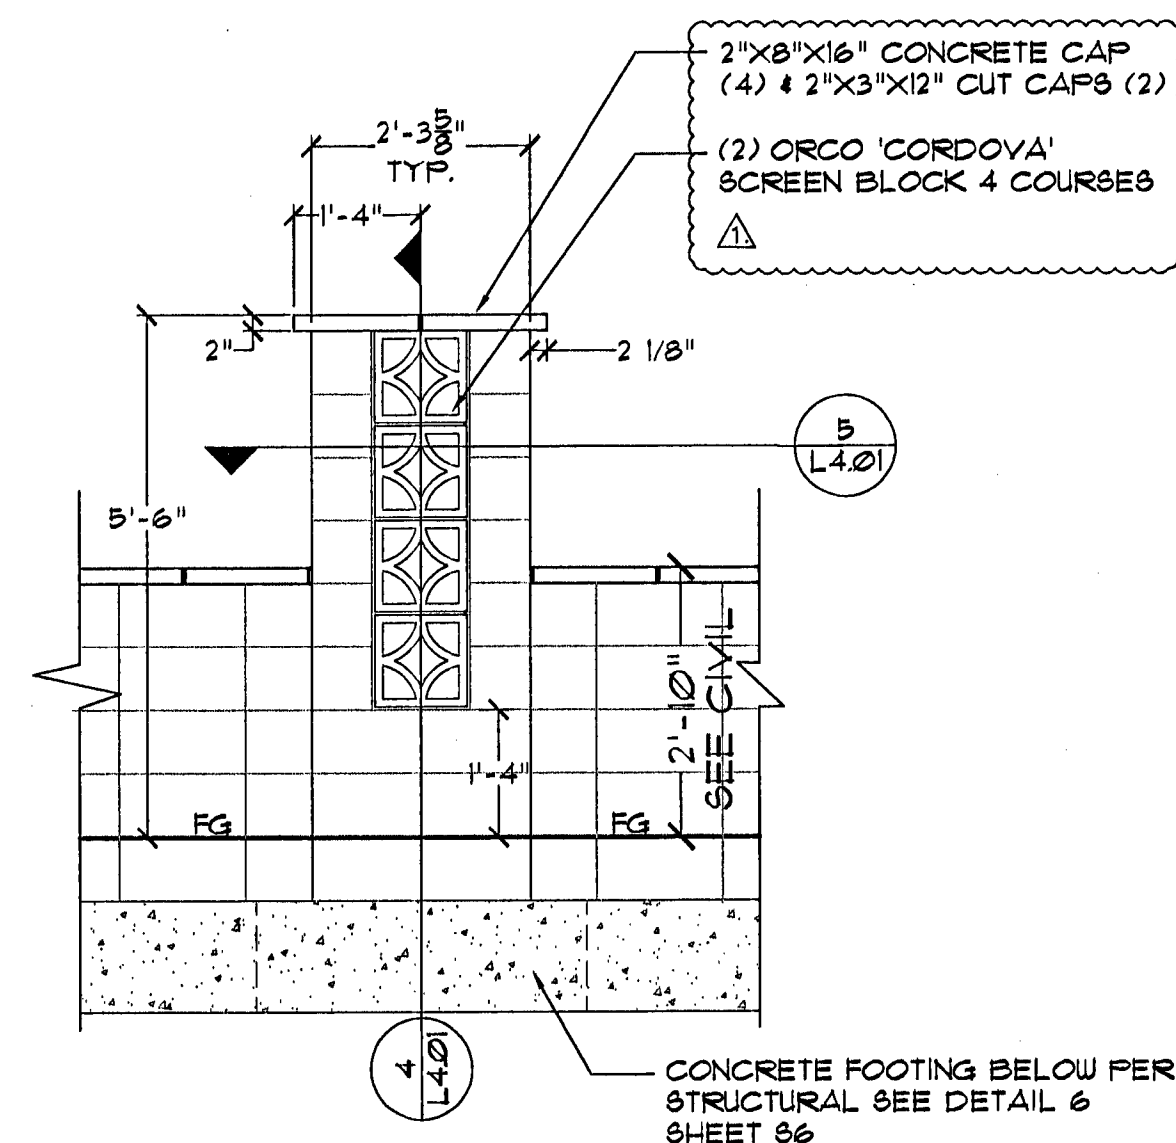


[illegible]

DEPARTMENT OF PUBLIC WORKS
400 EAST STEWART
LAS VEGAS, NEVADA 89101

NAME: **NEON BONEYARD PARK**
CITY OF LAS VEGAS

	DRAWN BY: RSN, S.M.A.C.	_____
	DESIGNED BY: CNA, R.B.	_____
	CHECKED BY: CNA, R.B.	_____
	PROJECT NO:	_____
	SCALE:	_____

Sheet **L4.02**
30 of 37
CLV DRAWING NO.
676-12

(702) 229-6276

poggemeyer
design group, inc.



RECEIVED

JUN 28 2010
CITY OF LAS VEGAS
PERMITS

