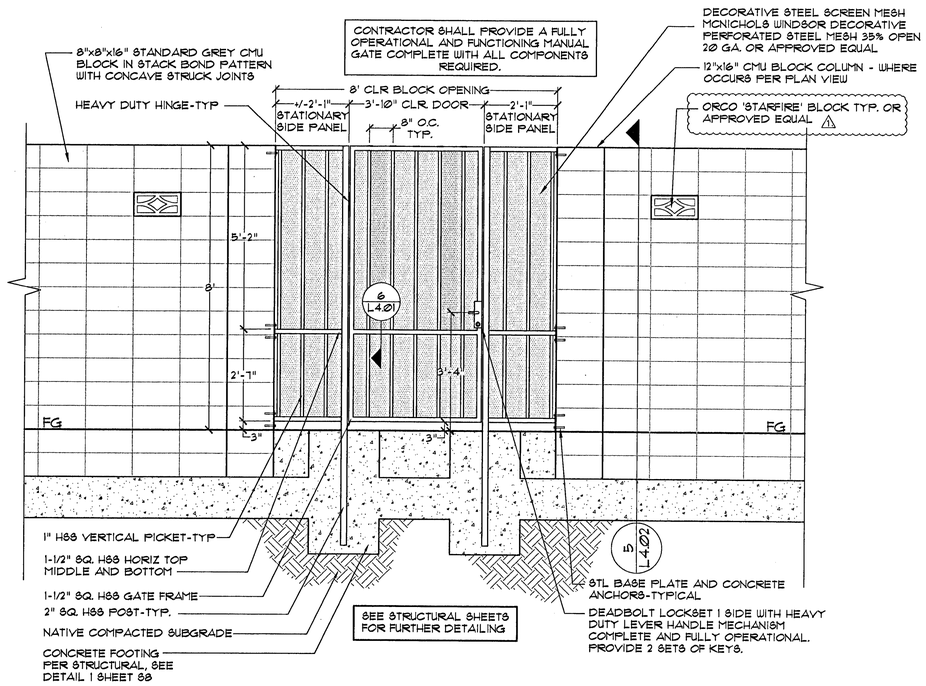


## 2 4' CLR PEDESTRIAN EGRESS GATE TYPICAL ELEVATION

BASE SCALE: 1/2"=1'-0"

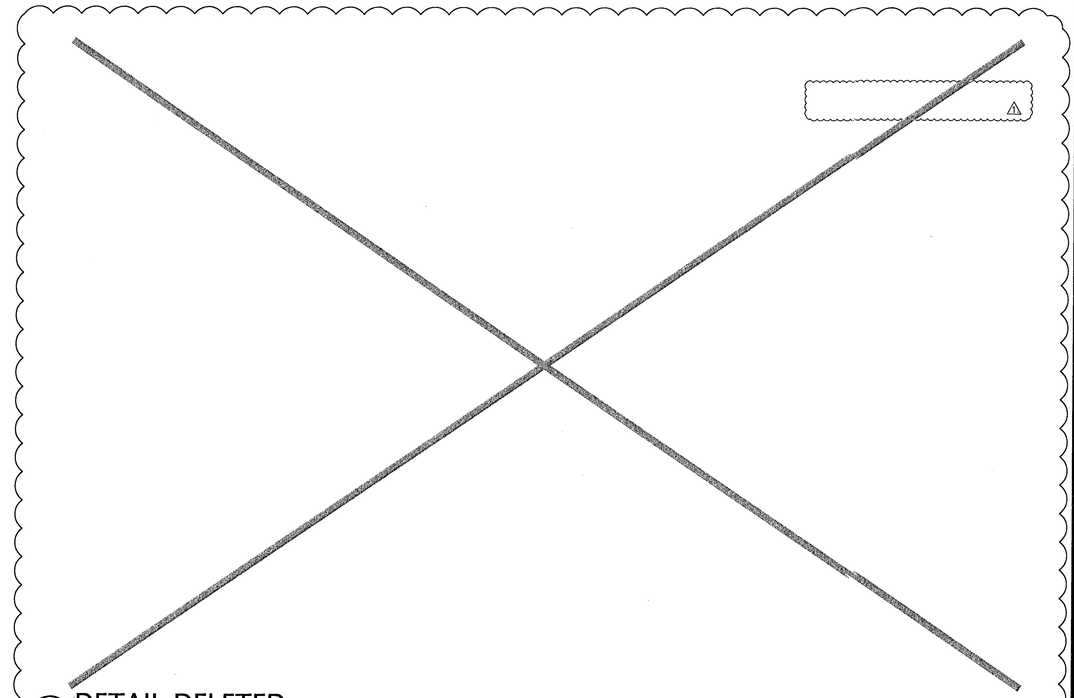


## 1 DETAIL DELETED 1

BASE SCALE: 1/2"=1'-0"

| SHOP DRAWING REQUIRED FOR ALL HSS ELEMENTS | TUBE STEEL/CMU NOTES:<br>1. ALL WELDS SHALL BE GROUND SMOOTH AND REMOVE ALL BURRS.<br>2. CONTRACTOR SHALL PROVIDE COMPLETE ENGINEERED SHOP DRAWINGS WITH DETAILS AND STEEL SPECS.<br>3. ALL FENCING HSS AND MESH SHALL BE PAINTED PER SPEC SECTION 614. COLOR: VISTA SPANISH BROWN 66.<br>4. CONTRACTOR SHALL PAINT ALL CMU BLOCK WITH PAINT PER SECTION 614. COLOR SHALL BE VISTA SAVANA OAKS 8468. |
|---|---|

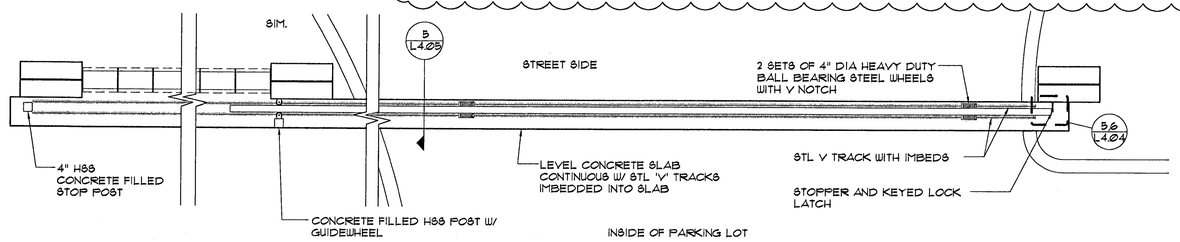


## 4 4' HEIGHT SLIDING VEHICLE GATE – PLAN VIEW

BASE SCALE: 3/8"=1'-0"

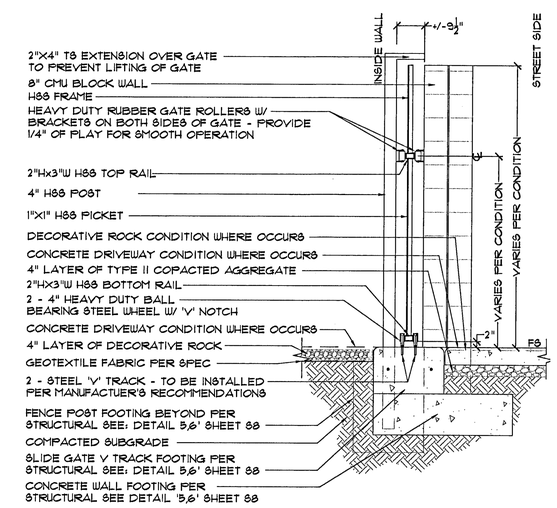


## 5 TYPICAL SLIDING GATE SECTION

BASE SCALE: 1/2"=1'-0"

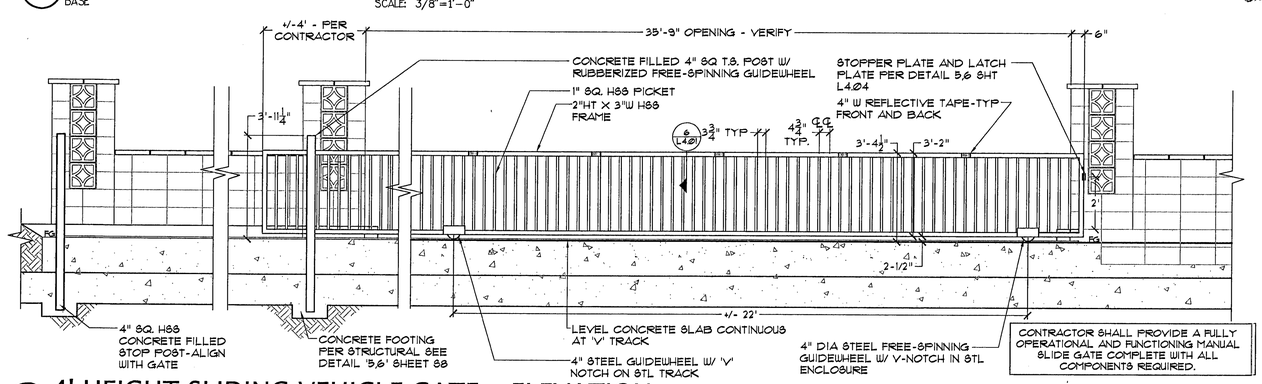


## 3 4' HEIGHT SLIDING VEHICLE GATE – ELEVATION

BASE SCALE: 3/8"=1'-0"

Building & Safety Dept.
City of Las Vegas, Nevada
IN LIEU OF STRUCTURAL REVIEW PLANS AND CALCULATIONS ARE DEEMED ACCEPTABLE IF SEALED AND SIGNED BY A NEVADA LICENSED CIVIL OR STRUCTURAL ENGINEER

Make no change without approval. Do not violate any ordinance.

RECEIVED
JUN 28 2010
CITY OF LAS VEGAS PERMITS

REGISTERED LANDSCAPE ARCHITECT CHRIS N. ATTANASIO 460 EXP. 6-30-10 STATE OF NEVADA
ADDENDA 1 ONLY

REGISTERED LANDSCAPE ARCHITECT CHRIS N. ATTANASIO 460 EXP. 6-30-10 STATE OF NEVADA
6-24-10
DELTA 2

ATTANASIO LANDSCAPE ARCHITECTURE
9516 W. Flamingo Rd. Suite 210
Las Vegas, NV 89147
P: 702.255.7160
F: 702.255.7169

REVISIONS

| NO. | DATE: | DESCRIPTION | APP'D |
|---|---|---|---|
| 1 | 10-27-09 | ADDENDA #1 | |
| 2 | 06-23-10 | GENERAL REVISION – DETAIL DELETED | |

DEPARTMENT OF PUBLIC WORKS
400 EAST STEWART
LAS VEGAS, NEVADA 89101
(702) 229-6276

poggemeyer design group, inc.
6960 Smoke Ranch #110 • Las Vegas, NV 89128 • P) 702.255.8100 • F) 702.255.8375

TITLE: NEON BONEYARD PARK
CITY OF LAS VEGAS

SHEET: LANDSCAPE SITE DETAILS

DRAWN BY: RSN,SM,KC
DESIGNED BY: CNA
CHECKED BY: CNA
PROJECT NO: 06-0145
SCALE:

Sheet L4.05
33 of 37
CLV DRAWING NO. 676-12

126021