

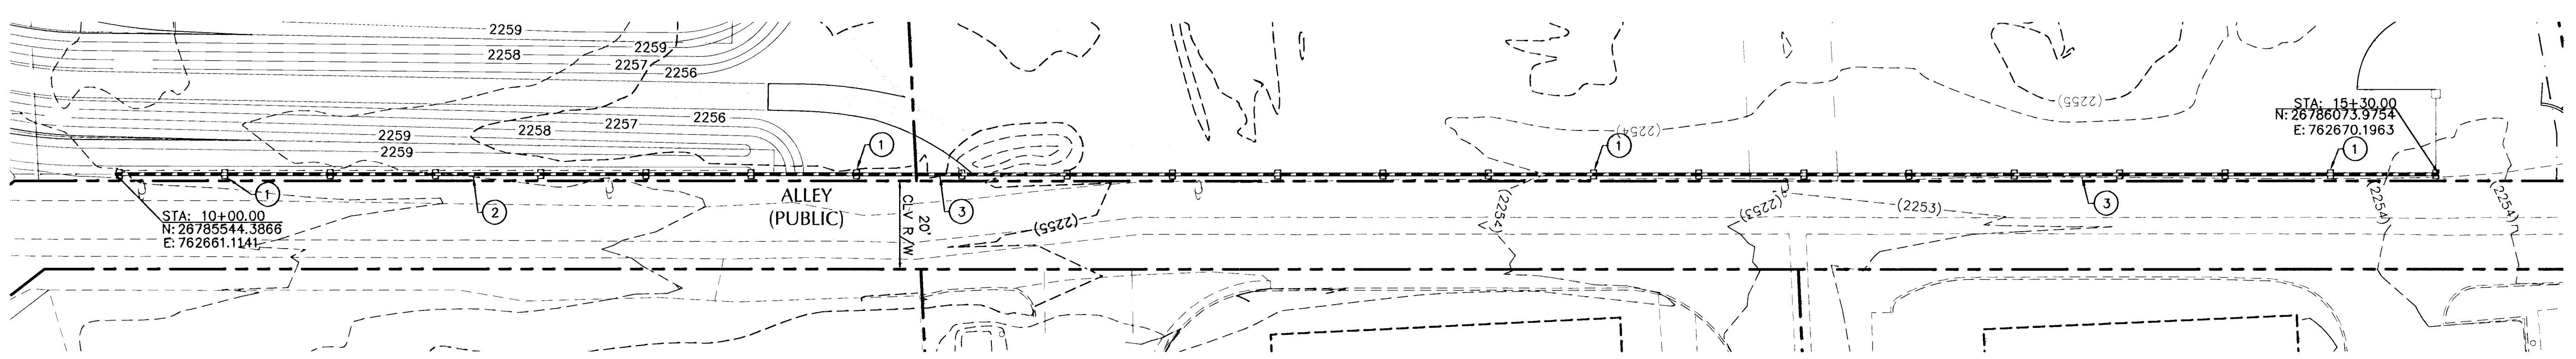
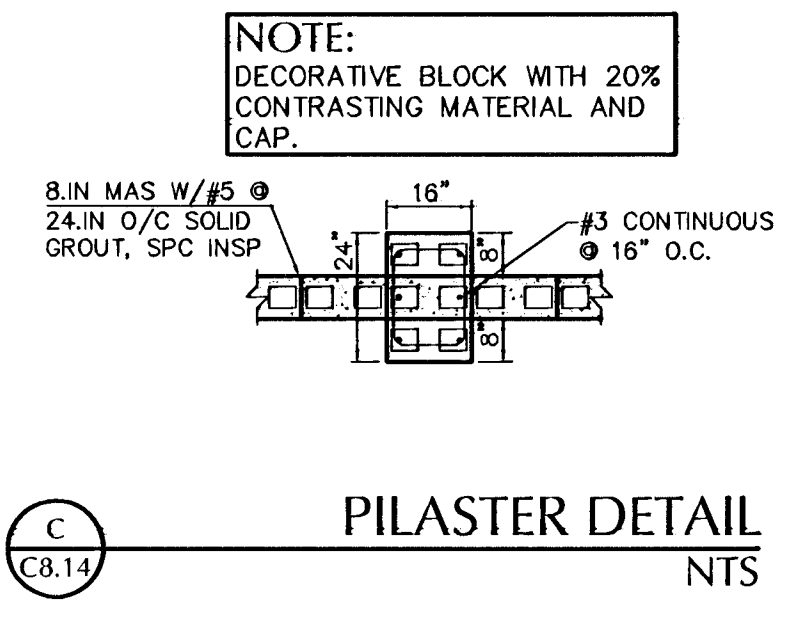


CONSTRUCTION NOTES

NO.	ITEM	CCUSD - CLARK COUNTY UNIFORM STANDARD DRAWING
1	CONSTRUCT CONCRETE PILASTER PER DETAIL 'C' SHEET C8.14.	
2	CONSTRUCT RETAINING WALL PER DETAIL 'A' SHEET C8.14.	
3	CONSTRUCT FLOOD WALL PER DETAIL 'B' SHEET C8.14.	

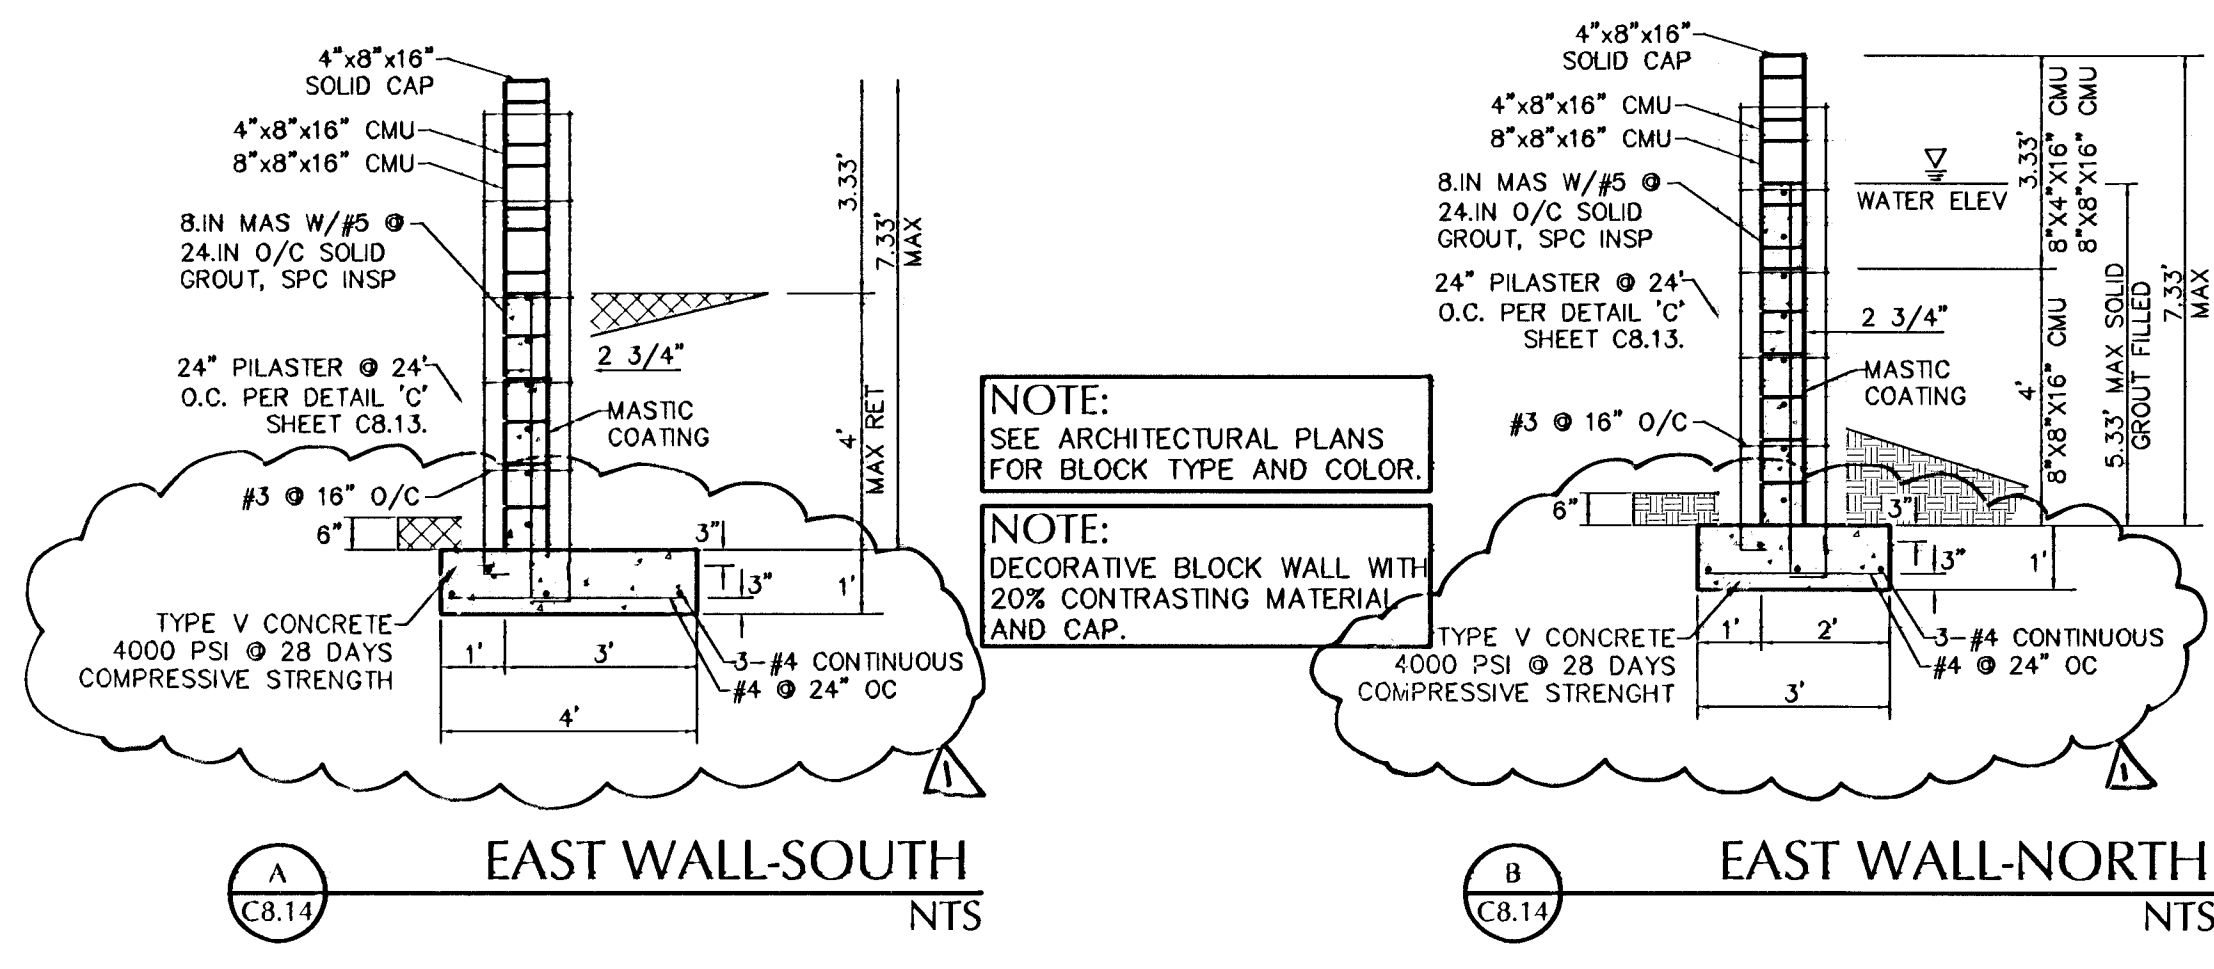

EAST WALL - PLAN VIEW
SCALE: 1"=20'

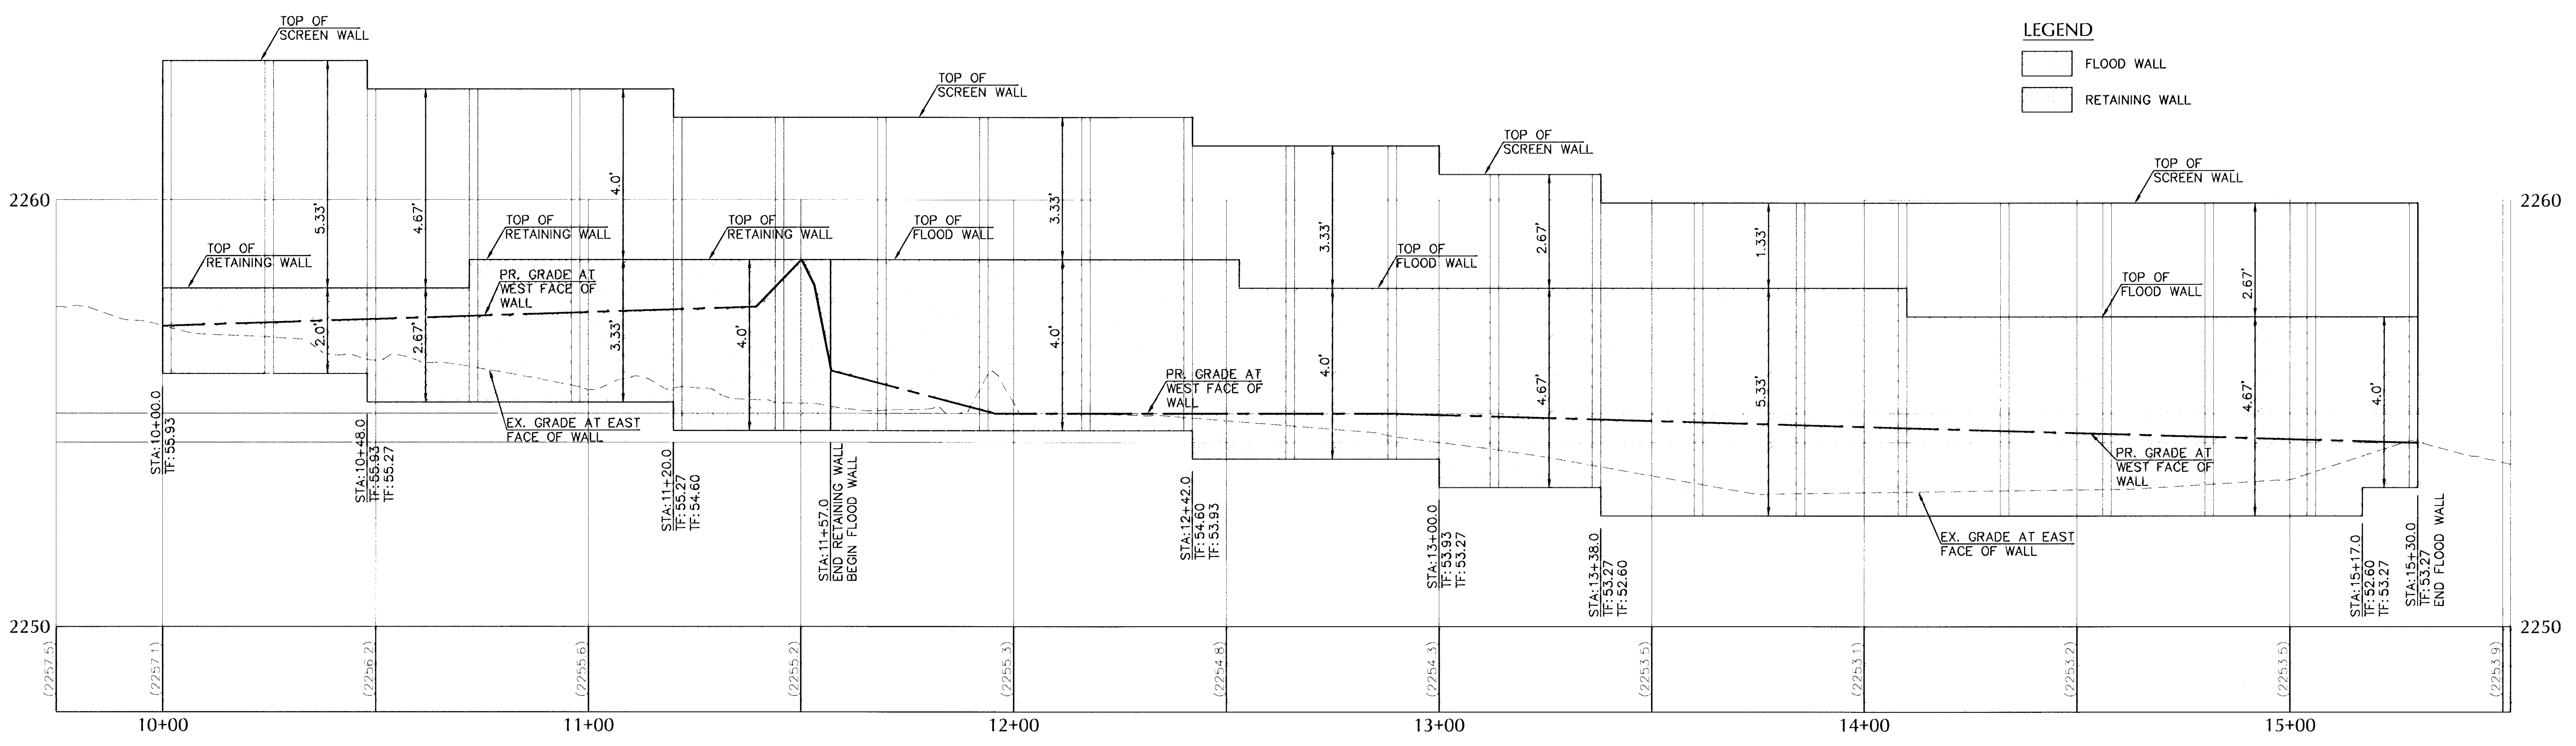

EAST WALL - PROFILE VIEW
SCALE: H: 1"=20'
V: 1"=2'

DATE: 08/20/10
JOB NUMBER: 3077
DESIGN BY: R. COEBEL
DRAWN BY: R. COEBEL
CHECKED BY: T. MILLER, P.E.

PROFESSIONAL ENGINEER
THOMAS D. MILLER
EXP. 12-31-11
CIVIL
NO. 15776

DEPARTMENT OF VETERANS AFFAIRS
NORTHWEST LAS VEGAS OUTPATIENT CLINIC
APN: 138-12-102-001, 002, 138-12-110-011

MARTIN & MARTIN
Civil Engineers
1909 S. Jones Boulevard
Las Vegas, Nevada 89146
Phone (702) 248-8000
Fax (702) 248-8070

SHEET NUMBER
C8.14
SHEET 61 OF 69
H# 38756
CLV# 107V5514

125290
126489