
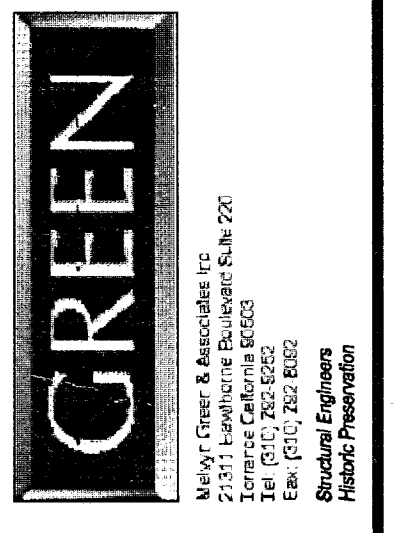
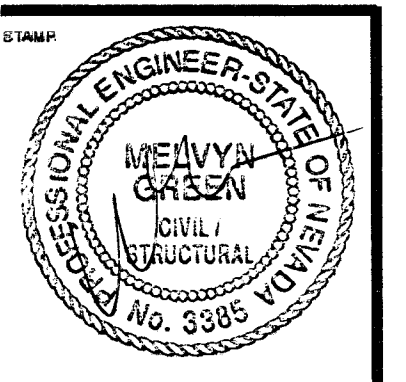
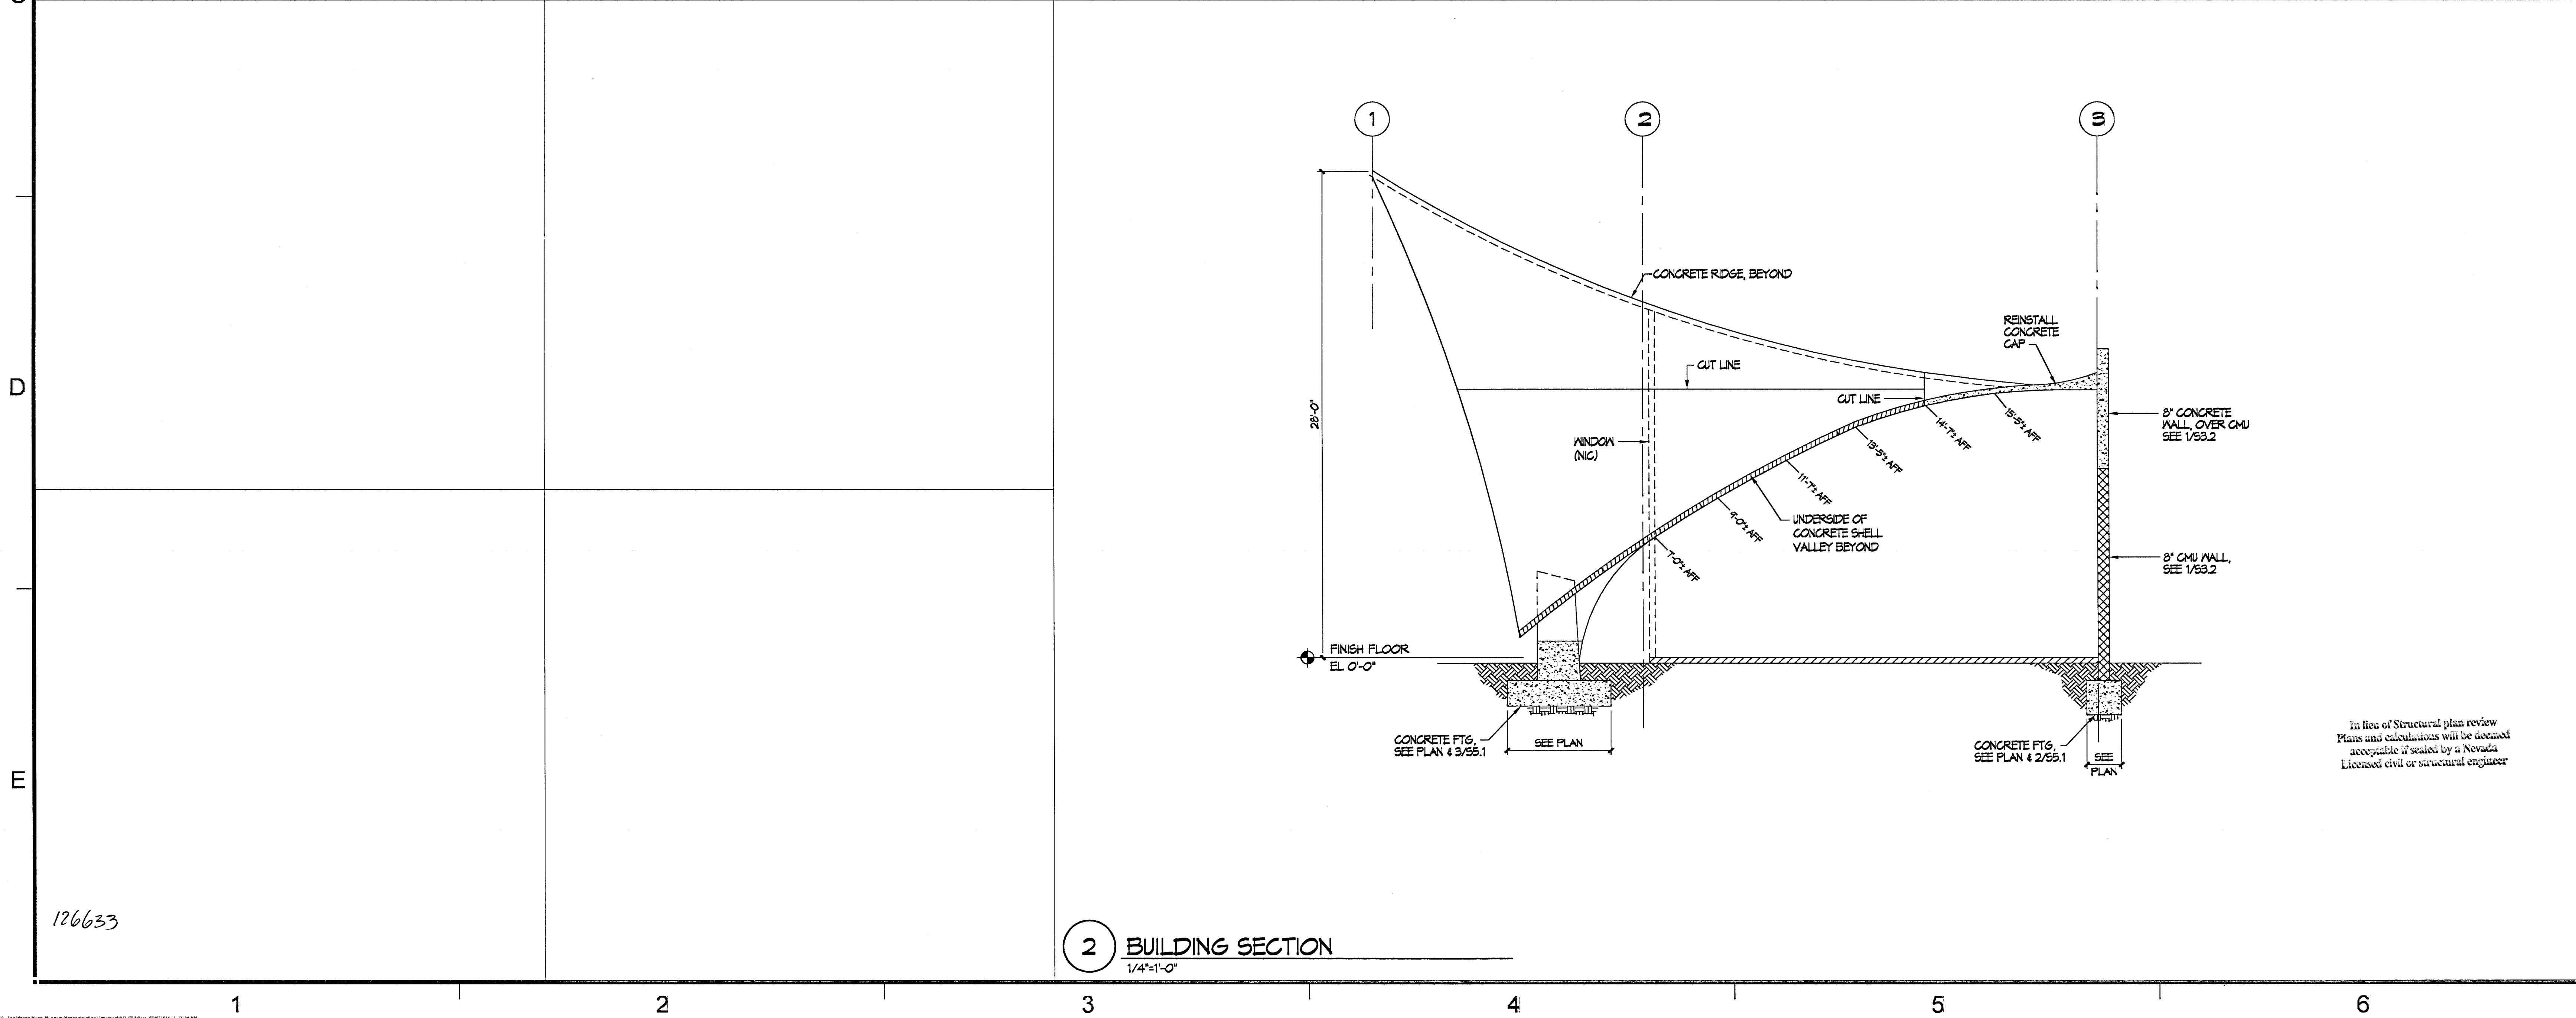


DRAWING BY: COLUMBIA RIVER CADD 07-007 126633


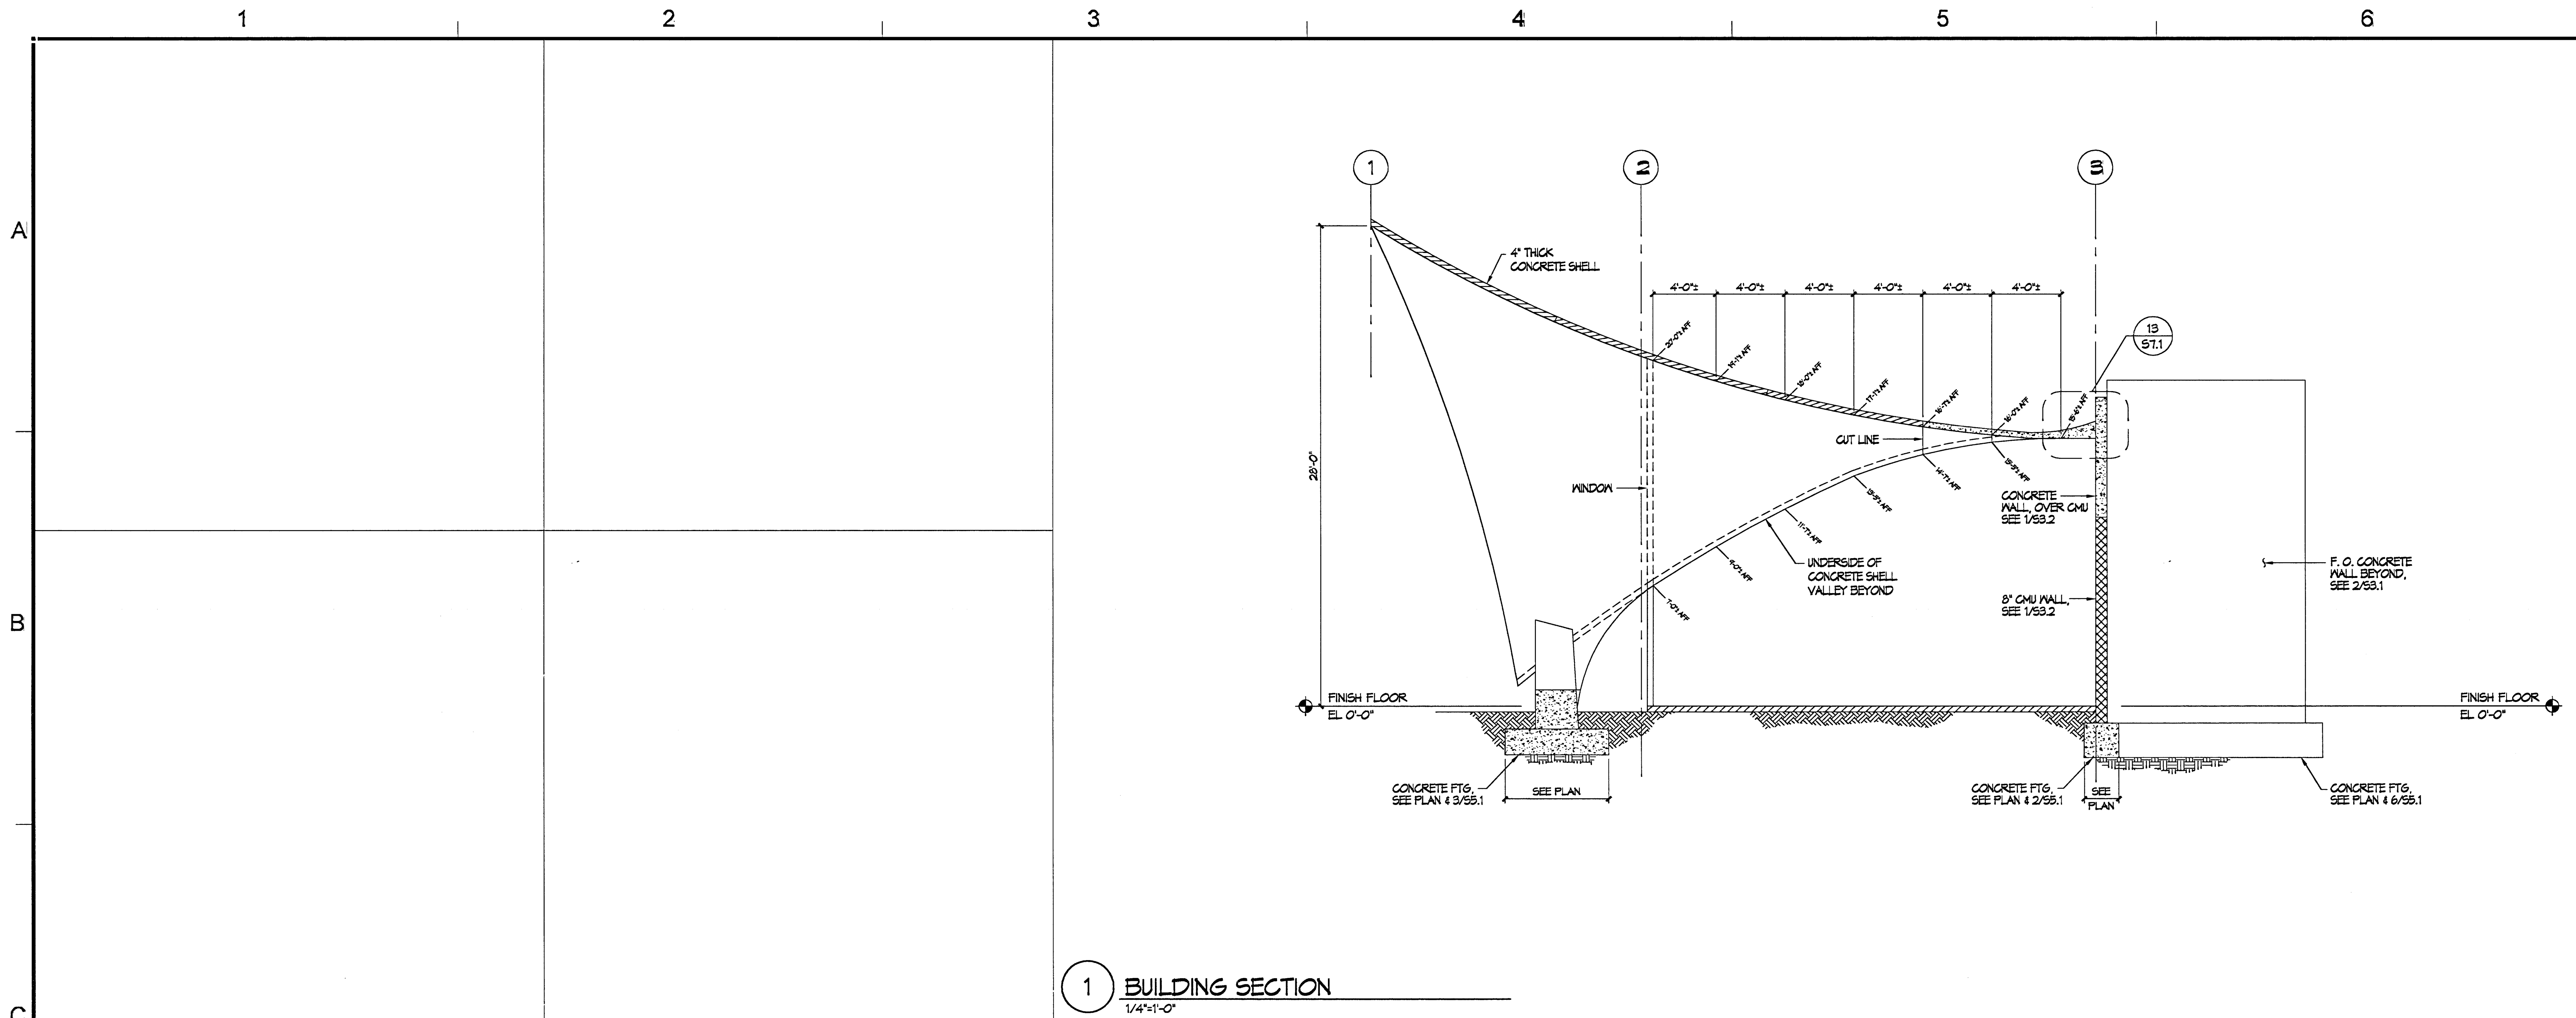

PROJECT NAME  
**NEON MUSEUM and BONEYARD**  
770 NORTH LAS VEGAS BLVD.  
LAS VEGAS, NEVADA 89101

DESIGNED BY  
**DAVB**  
CHECKED BY  
**MG**  
ISSUED DATE  
**06/20/07**  
JOB NUMBER  
**20060127**  
SHEET NAME  
**BUILDING ELEVATIONS**  
SHEET NUMBER  
**S3.1**