



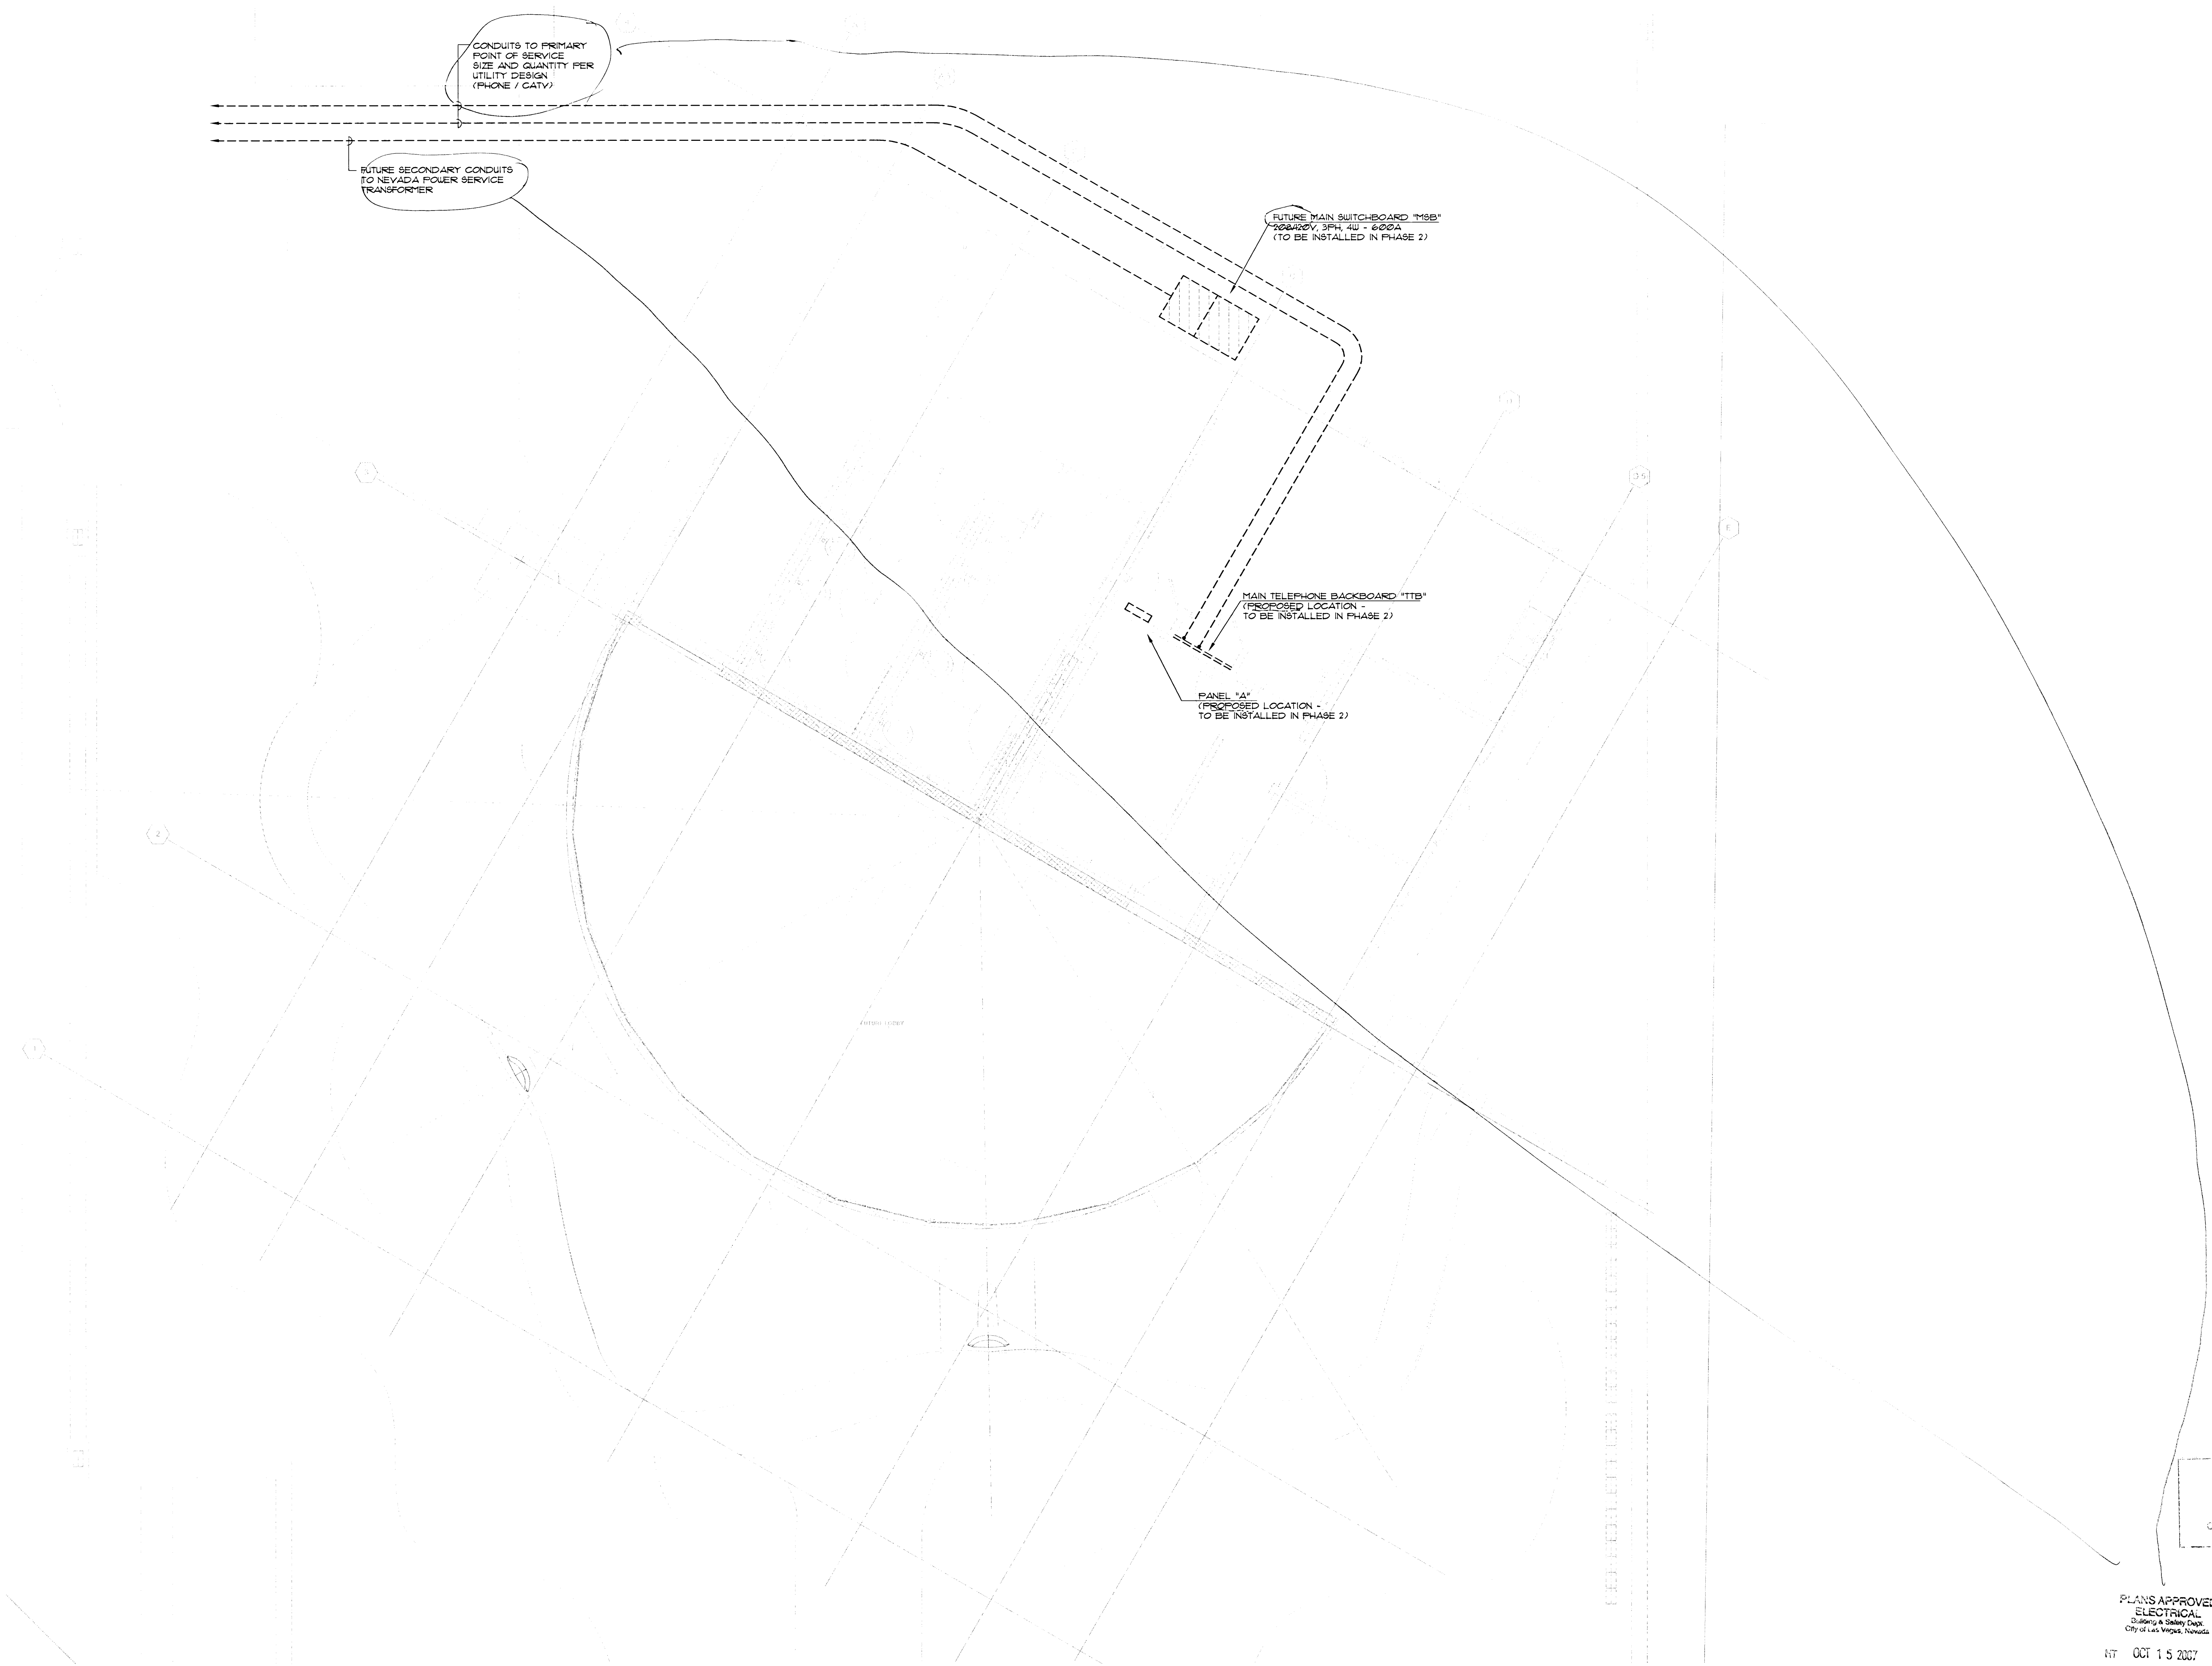


RECEIVED
OCT 15 2007
CITY OF LAS VEGAS
PERMIT

PLANS APPROVED
ELECTRICAL
City of Las Vegas, Nevada
NT OCT 15 2007
Do not include Structural, Architectural, Plumbing/Mechanical or Civil Engineering Notes on this drawing. Without Approval Plans are Not a Permit or Waiver Any Certificate

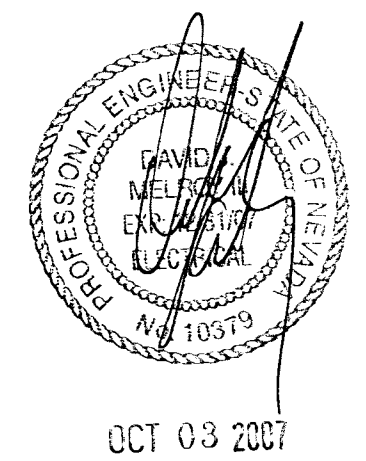

REVISIONS	BY

PROJECTS CONSULTANTS
msa
7115 Arroyo Street
Suite 100
Las Vegas, NV 89119
P 702.896.1100
F 702.896.1133
email: msa@msa-nv.com

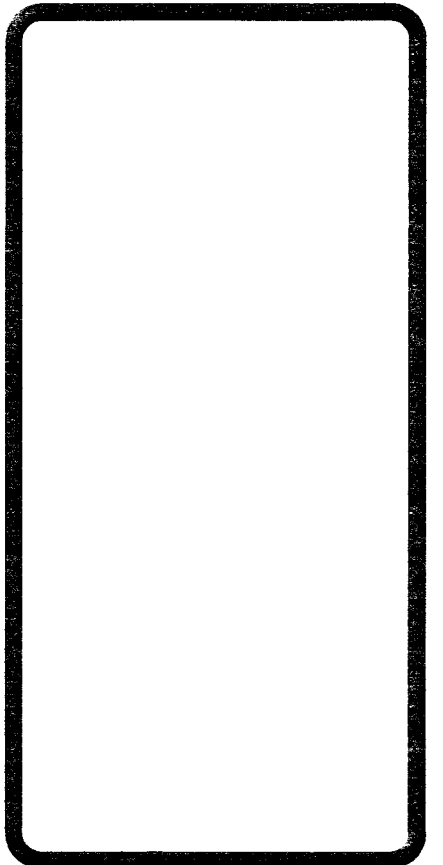

PROJECT:
**THE NEON MUSEUM
LAS VEGAS, NEVADA**

SHEET TITLE:
**ELECTRICAL
PLAN**

DRAWN MSA
CHECKED DM
DATE 10/03/2007
SCALE NOTED
JOB NO. LOT1933
SHEET



126642