
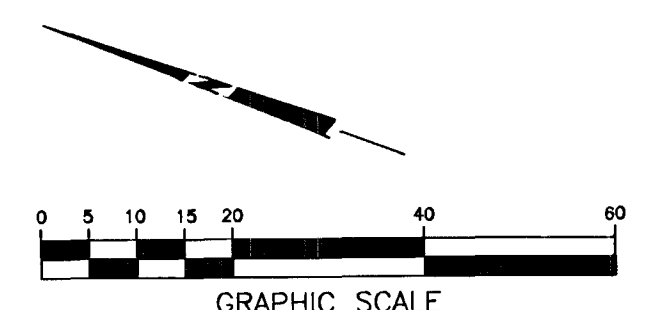


3/22/12  
DATE

| CODE | DESCRIPTION                       | DETAIL REF. |
|------|-----------------------------------|-------------|
| U2a  | FIRE LINE (6")                    | -           |
| U10  | RELOCATED FIRE HYDRANT ASSEMBLY   | 1-C8.1      |
| U12a | TAPPING SLEEVE AND VALVE (10"x6") | -           |
| U13a | GATE VALVE (6")                   | -           |
| U20a | SANITARY SEWER SERVICE (8")       | -           |
| U22  | SANITARY SEWER MANHOLE            | 4-C8.1      |
| U23  | CLEANOUT                          | 6-C8.1      |

UTILITY NOTES:

1. SEE SHEET C2.0 FOR UTILITY NOTES.
2. SEE SHEET C7.0 FOR BENCHMARK.

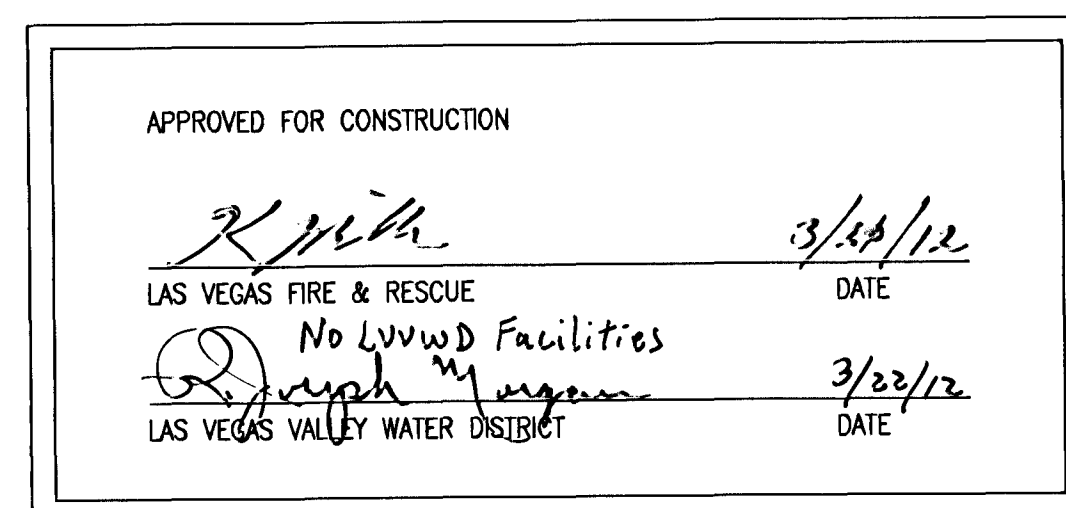

## UTILITY PLAN

**REPLOT**

H 41374

lonv 3043-A


**MOUNTAIN VIEW HOSPITAL  
EMERGENCY & ICU DEPARTMENT ADDITIONS  
and INTERIOR RENOVATIONS**

**OWNER / DEVELOPER**  
SUNRISE MOUNTAINVIEW HOSPITAL  
3100 N TENAYA WAY  
LAS VEGAS, NV 89128  
P. (702) 225-5065



**LITTLEJOHN  
ENGINEERING  
ASSOCIATES**

935 21ST AVENUE SOUTH, NASHVILLE, TENNESSEE 37212  
F 615.385.4144 F 615.385.4020 WWW.LEAN.COM

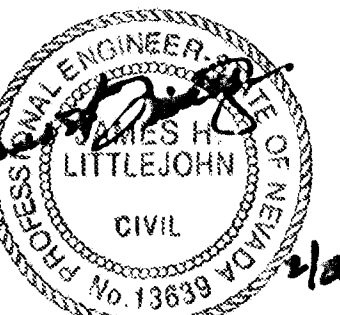

EXPIRATION DATE: 12/31/2014  
12/31/2013

EA PROJECT  
IDENTIFICATION # 29187

Sheet Number

27.2

## 57.2

**HEET 25 OF 33**