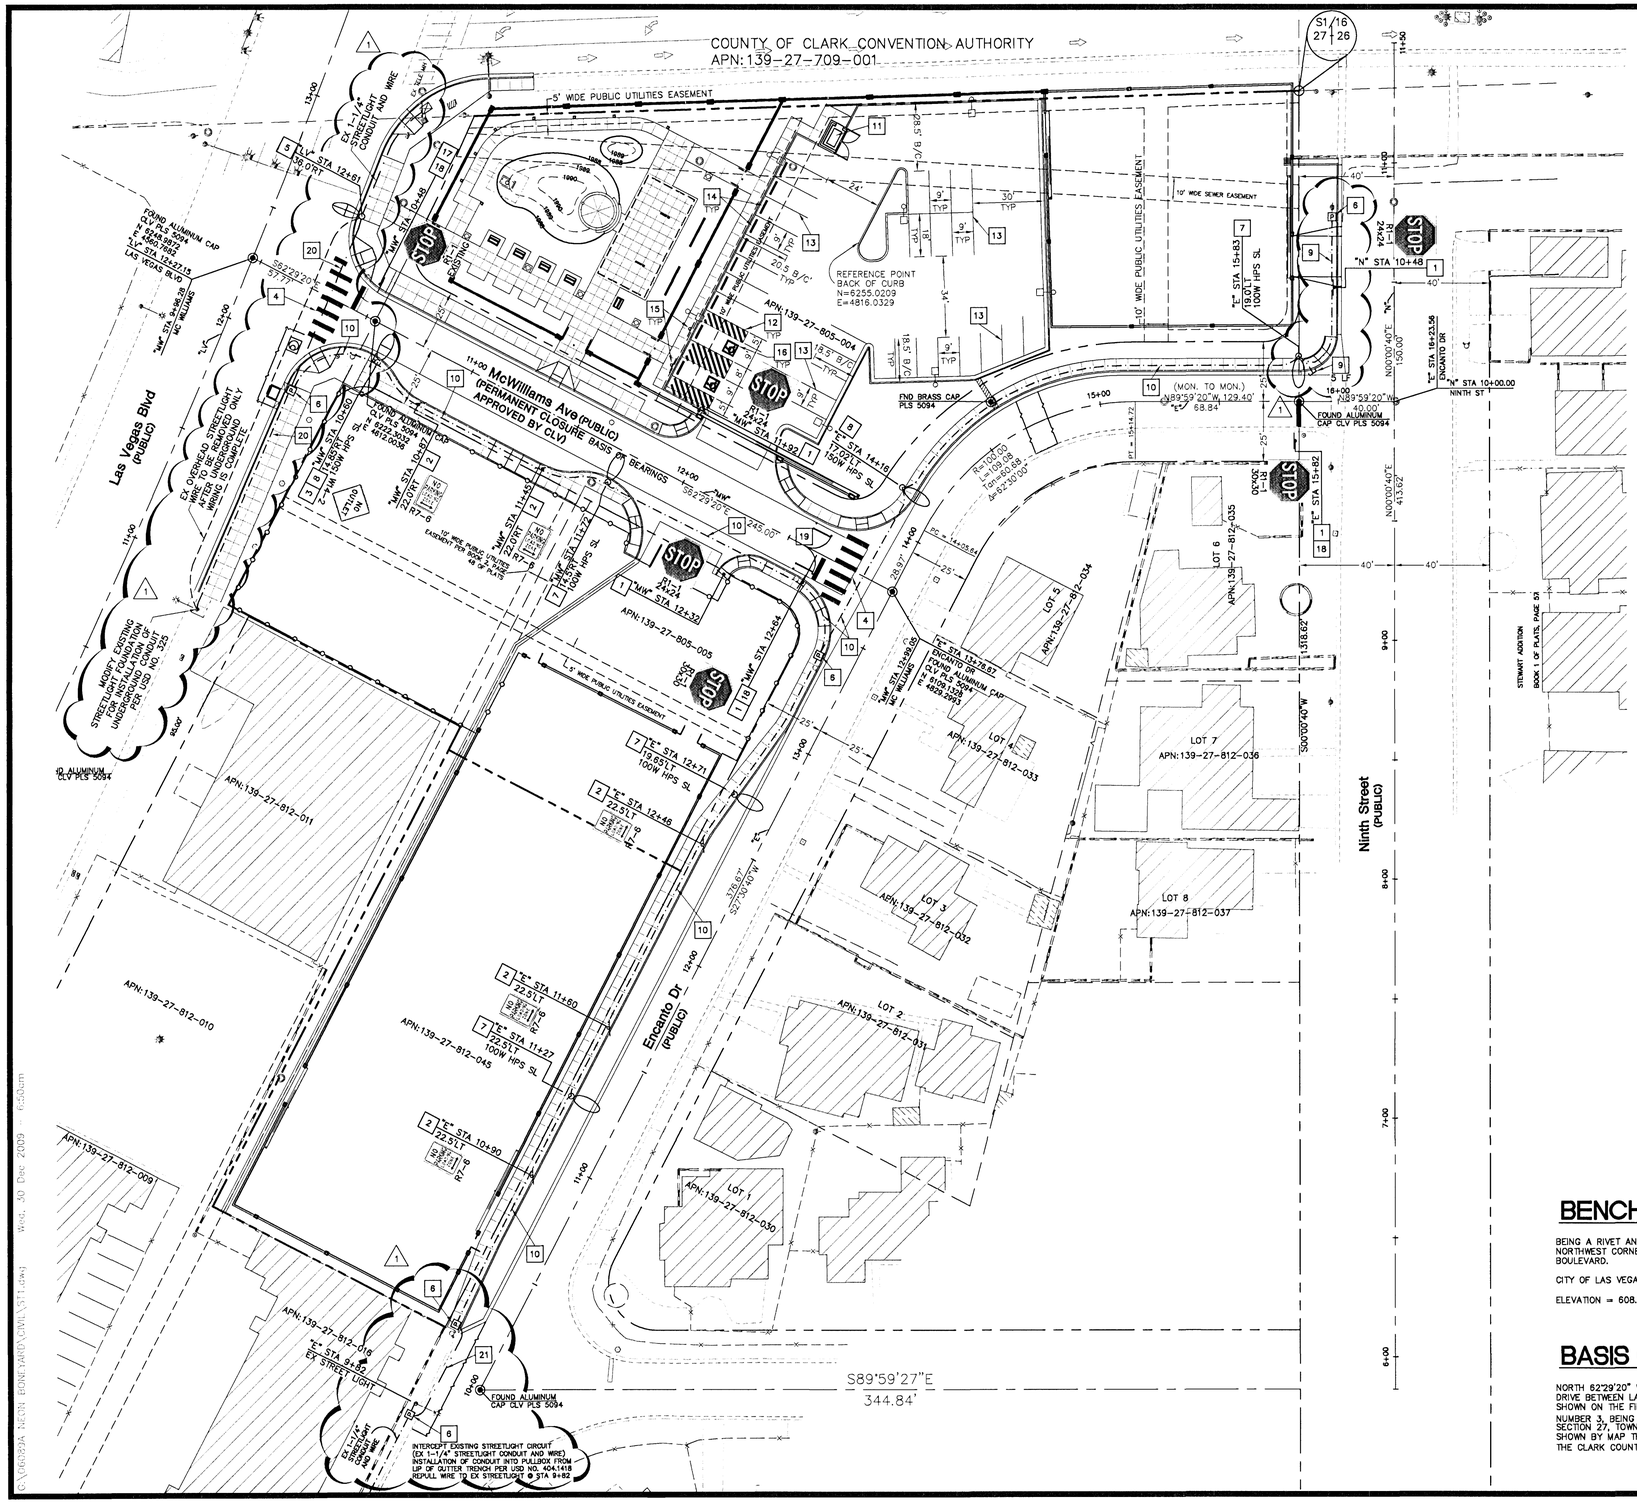

ASBUILT'S

GRAPHIC SCALE

30 0 15 30 60

(IN FEET)
1 inch = 30 ft.

NORTH

LEGEND

- 100W HPS STREET LIGHT
- 150W HPS STREET LIGHT
- PULL BOX
- TRAFFIC CONTROL SIGN
- STREET LIGHT CONDUIT

STREETLIGHT AND TRAFFIC NOTES

1. INSTALL PERMANENT SIGN (GROUND MOUNTED) R1-1, STOP SIGN PER USD 249A, SIZE PER PLAN
2. INSTALL PERMANENT SIGN (GROUND MOUNTED) R7-6, "NO PARKING" SIGN PER USD 249A
3. INSTALL PERMANENT SIGN (STREETLIGHT POLE MOUNTED) W14-2, "NO OUTLET" SIGN.
4. INSTALL NDOT TYPE 2 MARKING FILM FOR CROSSWALKS AND STOP BARS IN ACCORDANCE WITH USD NO. 254A
5. RELOCATE EXISTING STREETLIGHT. CONSTRUCT NEW FOUNDATION PER USD NO. 321. INTERCEPT EXISTING 1-1/4" STREETLIGHT CONDUIT AND WIRES AND STUB INTO NEW STREETLIGHT FOUNDATION. INSTALL 2" PVC CONDUIT AND CONDUCTORS TO RELOCATED STREETLIGHT.
6. INSTALL NO. 3 1/2 PULL BOX PER USD NO. 326
7. INSTALL 100 WATT HPS STREET LIGHT PER USD NO. 314, 319, & 321
8. INSTALL 150 WATT HPS STREET LIGHT PER USD NO. 314, 319, & 321
9. INSTALL 1-1/4" PVC CONDUIT (STUB AND CAP) WITH #8 PULLWIRE FOR FUTURE USE.
10. INSTALL 1-1/4" PVC CONDUIT WITH 2 #4 AND 1 #8 THW WIRES PER USD NO. 501
11. INSTALL TRASH ENCLOSURE PER DETAILS SHOWN ON SHEETS DT2, DT3, AND DT4
12. APPLY 4" WIDE DIAGONAL WHITE STRIPING AT 2' ON CENTER
13. APPLY 4" WIDE WHITE STRIPING FOR PARKING STALL
14. INSTALL PRECAST BUMPER BLOCK PER USD 238
15. INSTALL PERMANENT SIGN (GROUND MOUNTED) R7-8 AND RPC-44 PER DETAILS SHEET DT1
16. INSTALL HANDICAP SYMBOL PAVEMENT MARKING PER DETAIL 2 ON SHEET DT1
17. RELOCATE SIGN TO NEW SIGN POST (GROUND MOUNTED), R1-1 STOP SIGN PER USD 249A
18. RELOCATE SIGN TO NEW SIGN POST (GROUND MOUNTED), STREET NAME SIGNS PER USD 249
19. INSTALL PERMANENT SIGNS (GATE MOUNTED) PER DETAILS 10 & 11 SHEET DT3
20. INSTALL 2" PVC CONDUIT WITH 2 #4 AND 1 #8 THW WIRES
21. INSTALL 1-1/4" PVC CONDUIT WITH 2 #4 AND 1 #8 THW WIRES IN LIP OF GUTTER TRENCH PER USD NO. 404.1418

BENCHMARK

BEING A RIVET AND PLATE IN THE TOP OF CURB AT THE NORTHWEST CORNER OF BONANZA ROAD AND LAS VEGAS BOULEVARD.

CITY OF LAS VEGAS BENCHMARK NUMBER 1LV01 27SSE6

ELEVATION = 608.5592 (M) 1996.58 (F) (NAVD 88 DATUM)

BASIS OF BEARING

NORTH 62°29'20" WEST BEING THE CENTERLINE OF MCWILLIAMS DRIVE BETWEEN LAS VEGAS BOULEVARD AND ENCANTO DRIVE AS SHOWN ON THE FINAL MAP OF BILTMORE ADDITION ANNEX NUMBER 3, BEING IN THE SOUTHEAST QUARTER (SE¼) OF SECTION 27, TOWNSHIP 20 SOUTH, RANGE 61 EAST, M.D.M., AS SHOWN BY MAP THEREOF IN BOOK 02, PAGE 48 OF PLATS, IN THE CLARK COUNTY RECORDER'S OFFICE, CLARK COUNTY, NEVADA

FOR REVISION 1 ONLY

PROFESSIONAL ENGINEER-STATE OF NEVADA
SAM C. DUNNAM
EXP. 12-31-10
CIVIL
No. 7886
10/13/09

AVOID HITTING UNDERGROUND TRAFFIC SIGNAL SYSTEM AND STREET LIGHT SYSTEM CONDUITS. IT IS COSTLY
Call before you Dig
Call before you Underground
Call before you Overhead
AVOID HITTING OVERHEAD POWER LINES. IT'S COSTLY
Call before you Dig
1-702-455-7911
CLARK COUNTY TRAFFIC SIGNAL
1-702-455-5300
CITY OF LAS VEGAS TRAFFIC SIGNAL SYSTEM
1-702-455-5300
CITY OF LAS VEGAS STREET LIGHT SYSTEM
1-702-227-2929
NEVADA POWER DAMAGE PREVENTION AND SAFETY SERVICES DEPARTMENT
1-800-227-2600
OR
1-702-455-7544
CLARK COUNTY TRAFFIC OPERATIONS

NO.	DATE:	DESCRIPTION	APP'D
1	10/13/09	ADDED AND REVISED CONDUIT	

REVISIONS

DEPARTMENT OF PUBLIC WORKS
400 EAST STEWART
LAS VEGAS, NEVADA 89101
(702) 229-6276

poggemeyer design group, inc.
6960 Smoke Ranch #10 • Las Vegas, NV 89128 • (t) 702.255.8100 • (f) 702.255.8375

TITLE: NEON BONEYARD PARK
CITY OF LAS VEGAS

SHEET: STREETLIGHT & TRAFFIC CONTROL PLAN

DRAWN BY: BMR/BKB/BAM	5/4/09	
DESIGNED BY: BMR/BKB/BAM	5/4/09	
CHECKED BY: WK/SCD	5/4/09	SCALE: 1"=30'
PROJECT NO: 06089C		

PROFESSIONAL ENGINEER-STATE OF NEVADA
SAM C. DUNNAM
EXP. 12-31-10
CIVIL
No. 7886
10/13/09

Sheet
ST1
9 of 37

CLV DRAWING NO.
676-12

HANSEN NO. 17994

E:\06089A NEON BONEYARD\CIVIL\ST1.dwg Wed, 30 Dec 2009 8:50am