
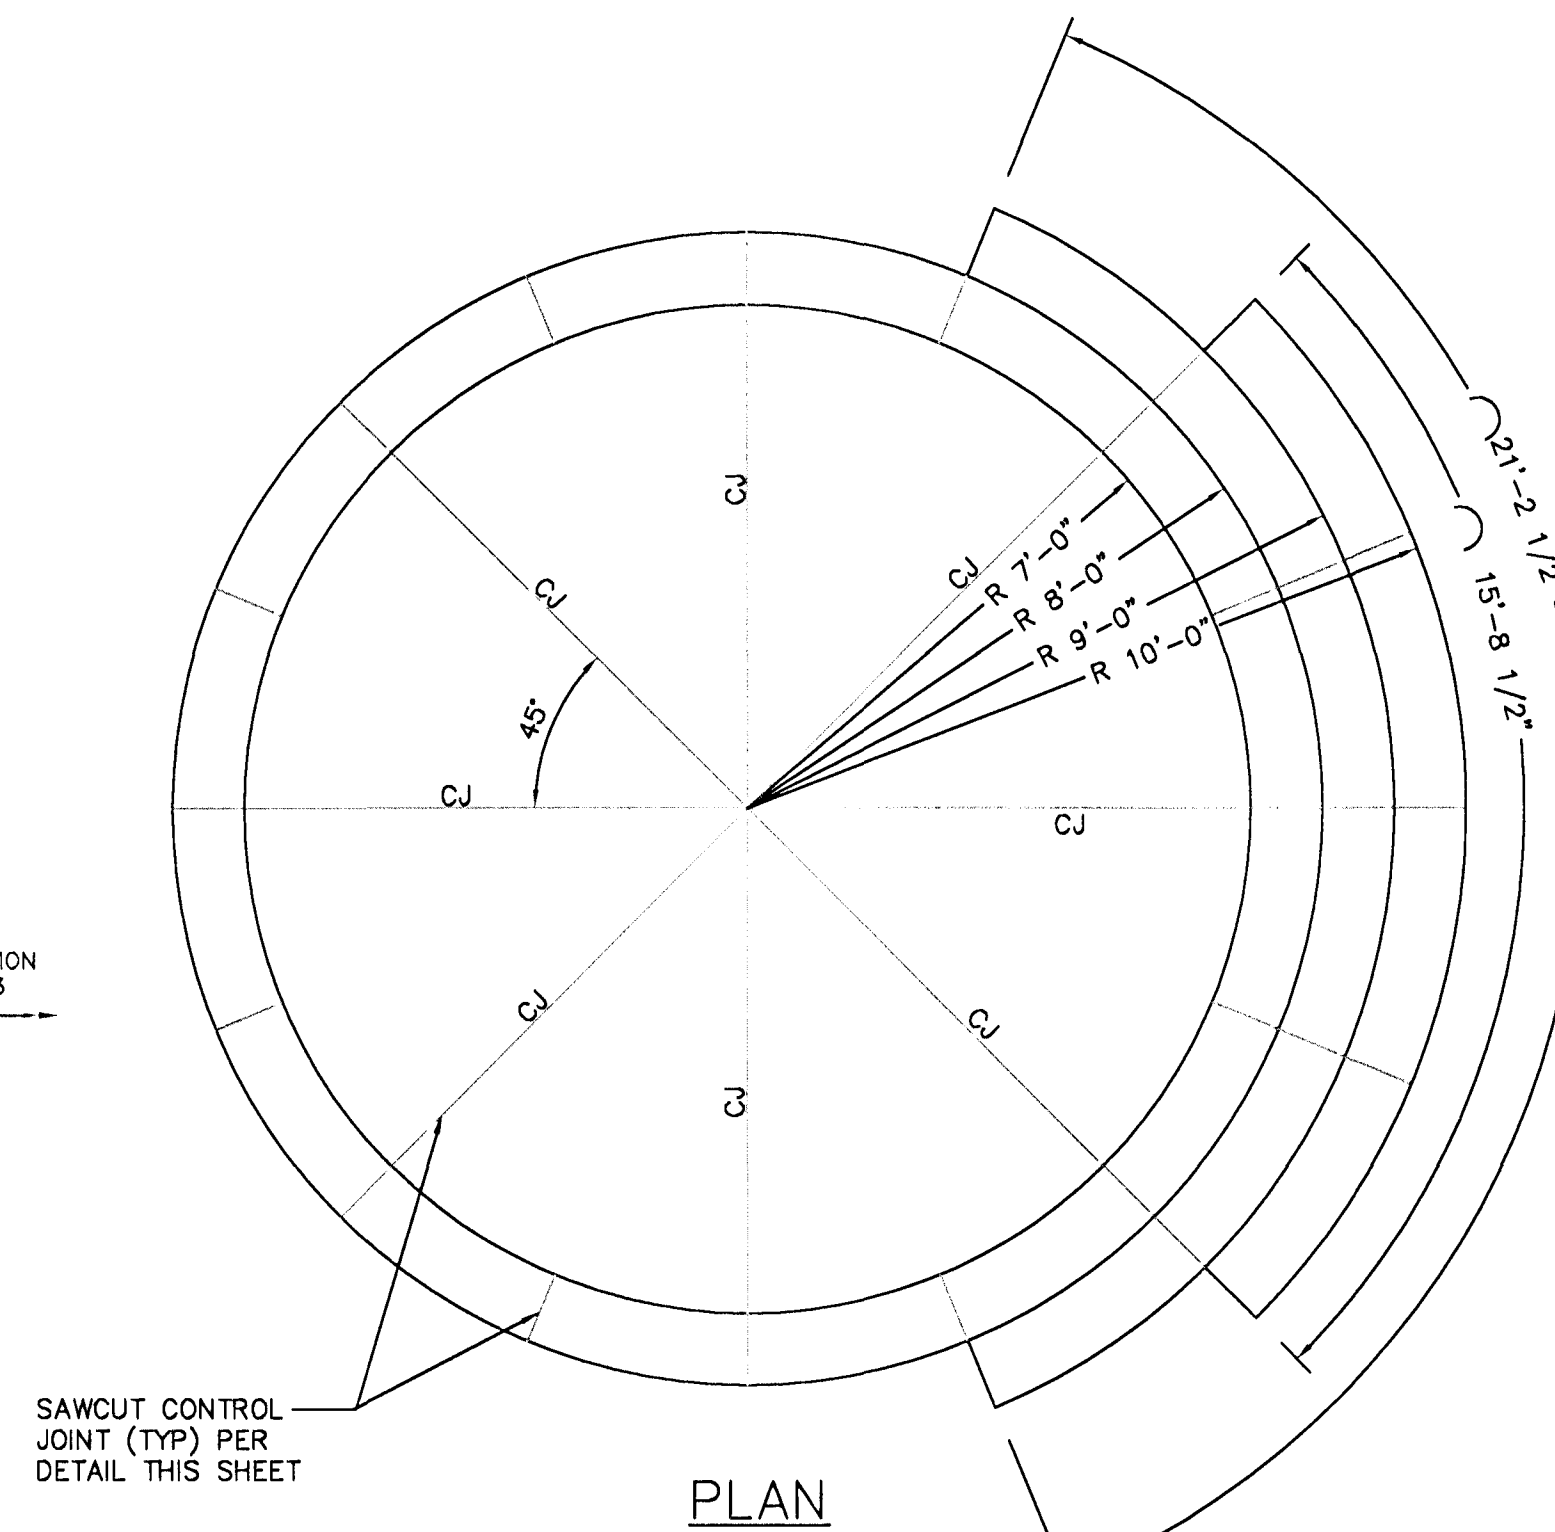
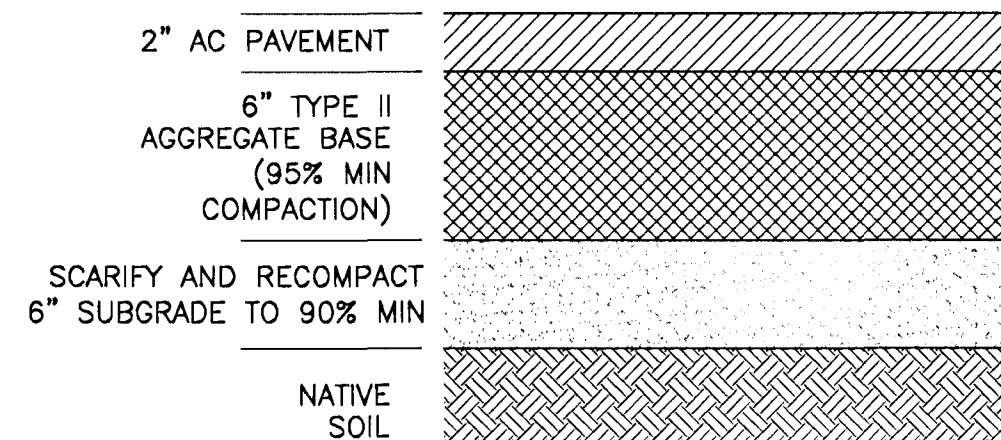
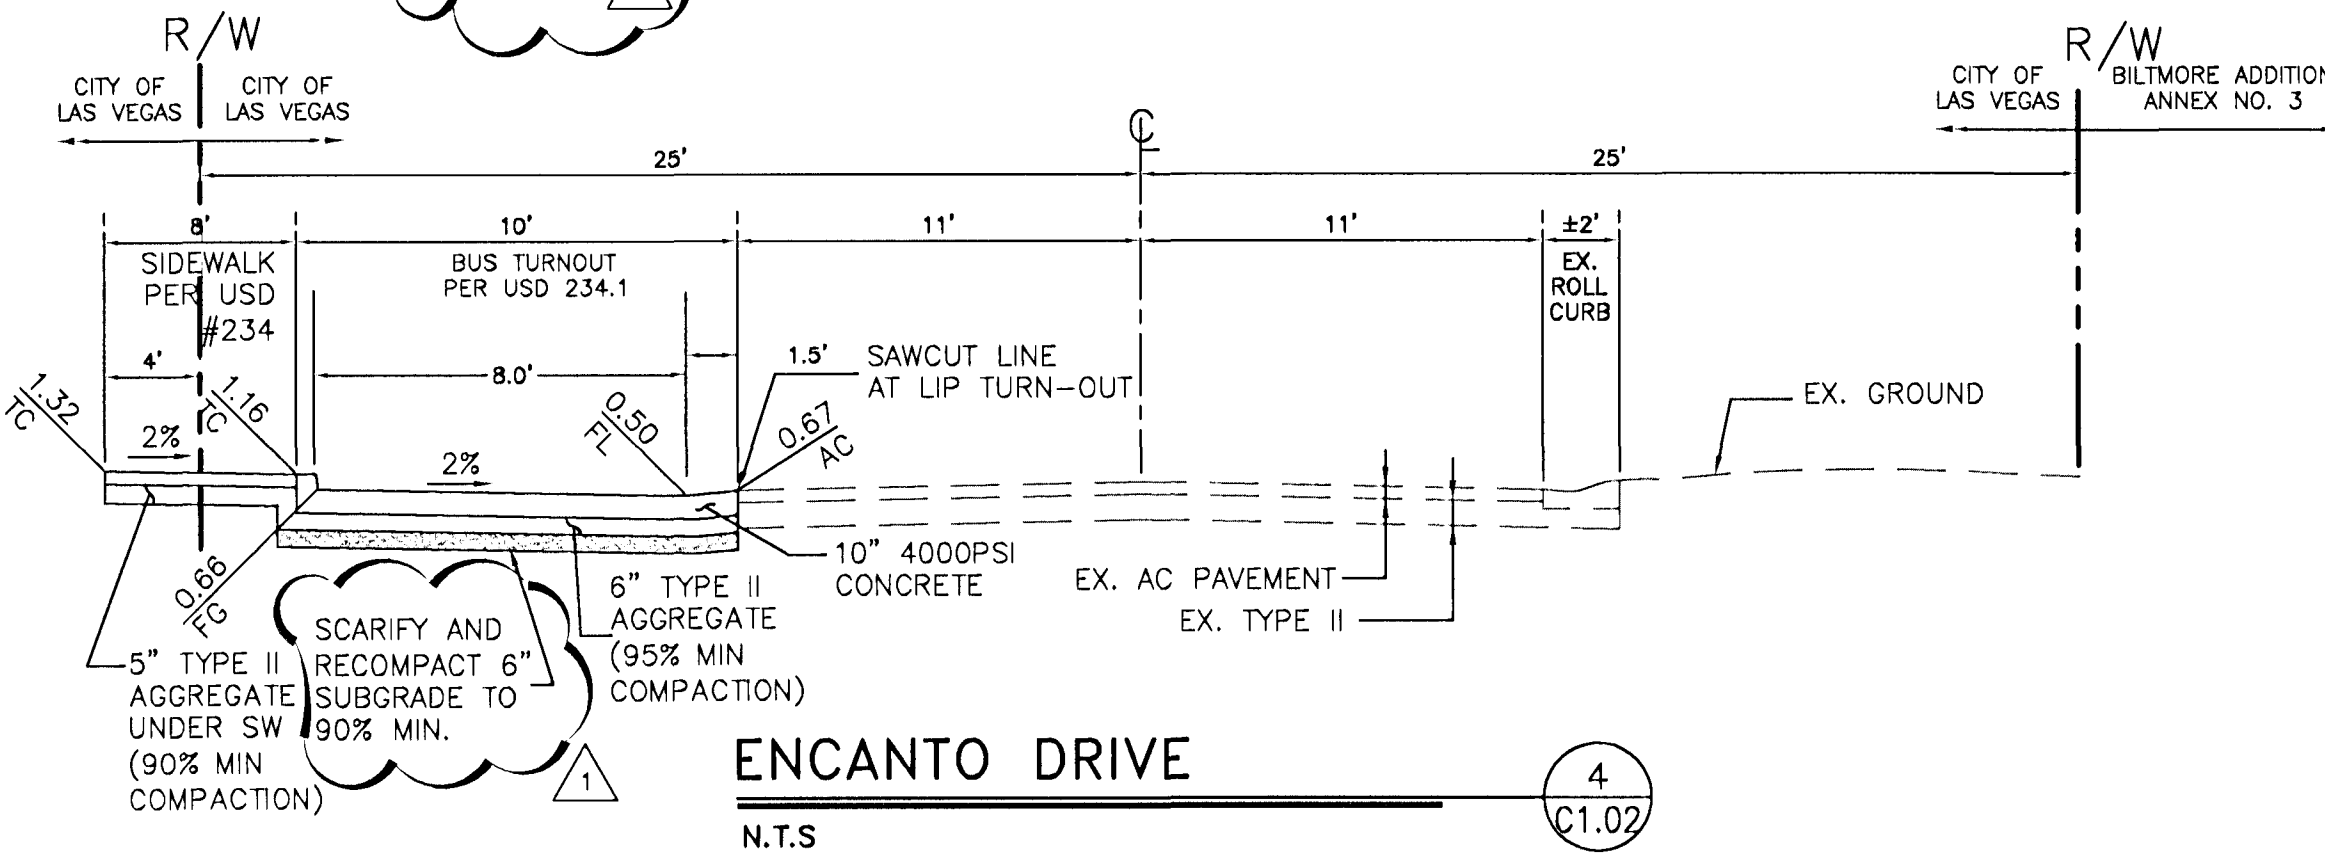
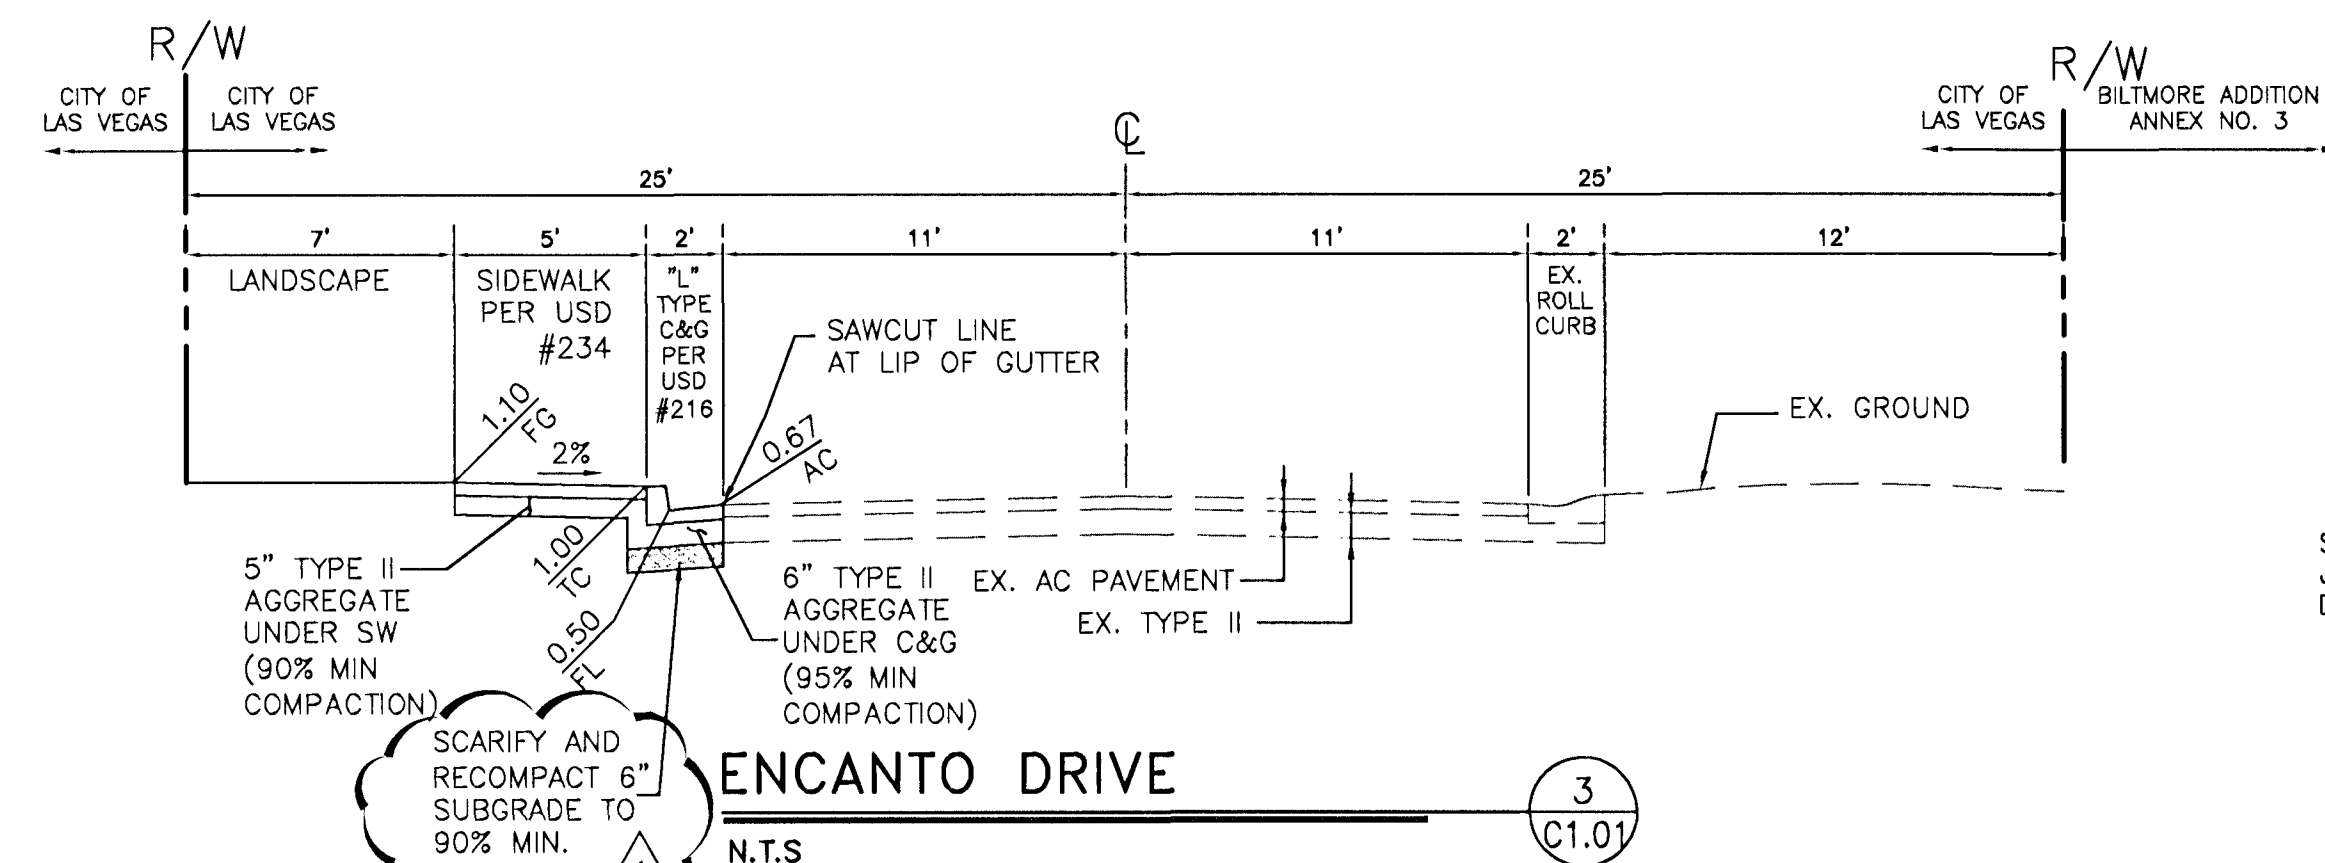
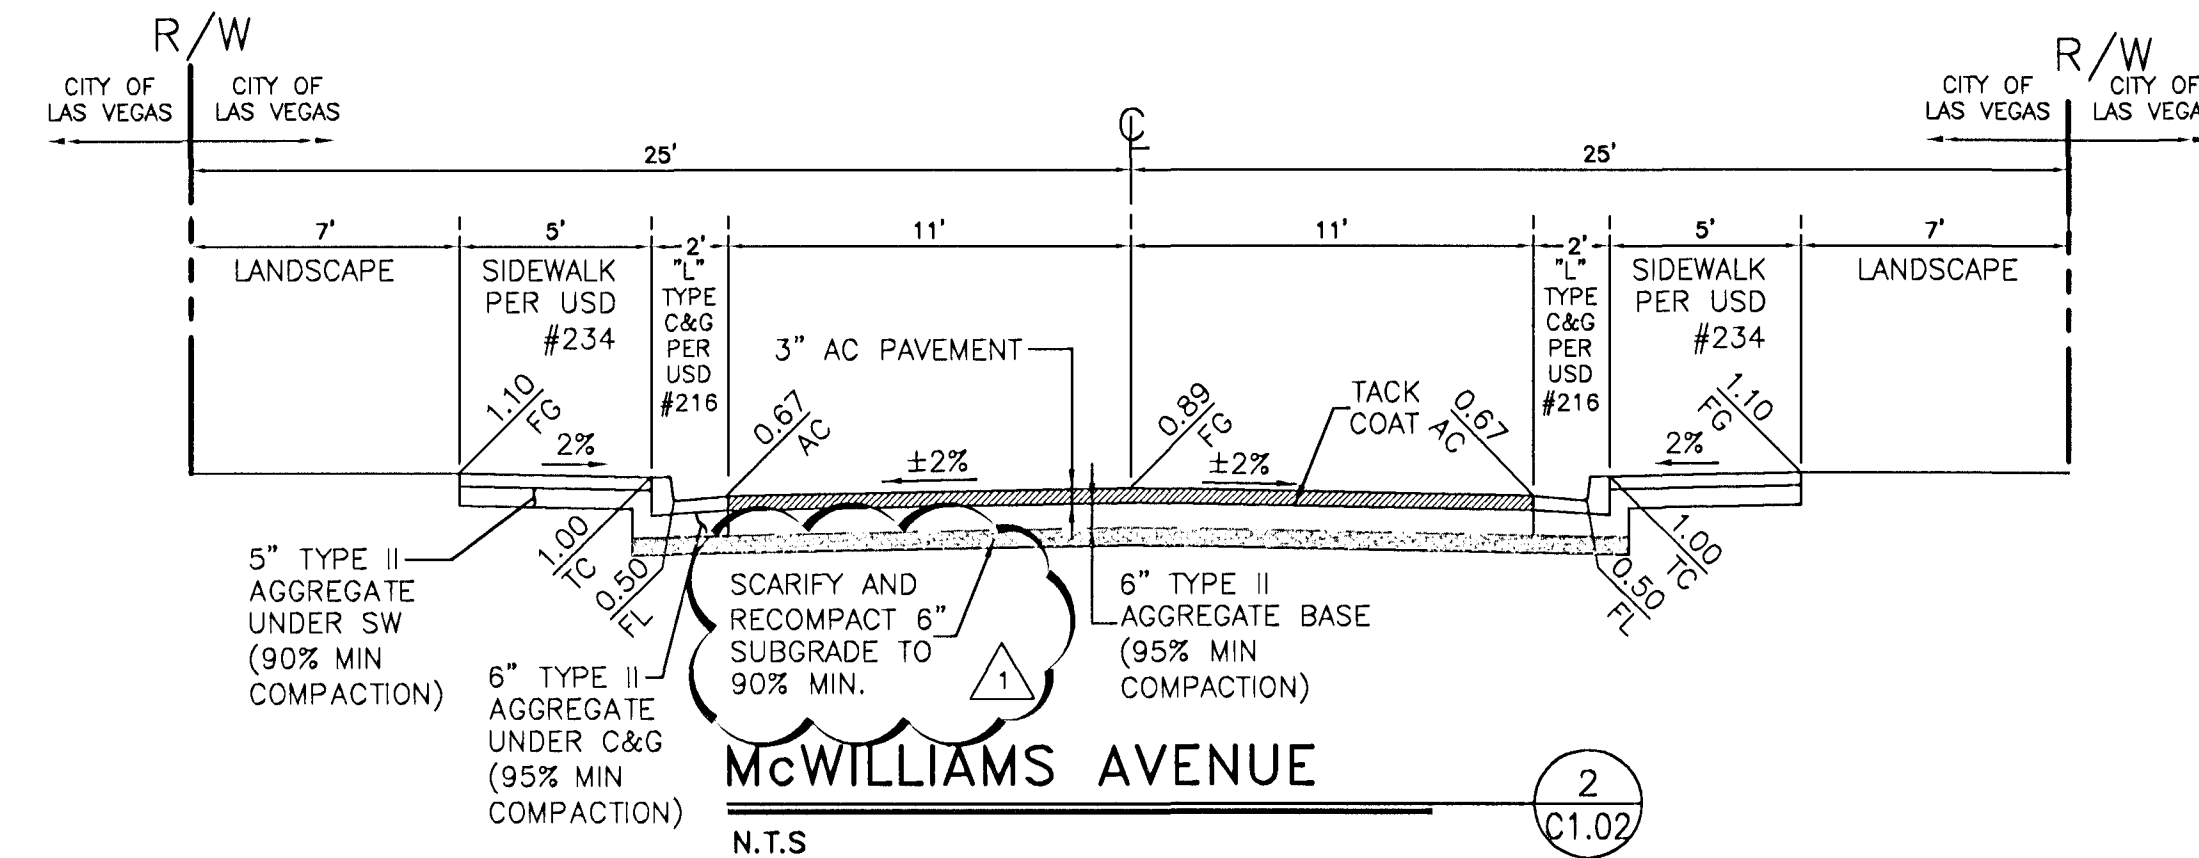
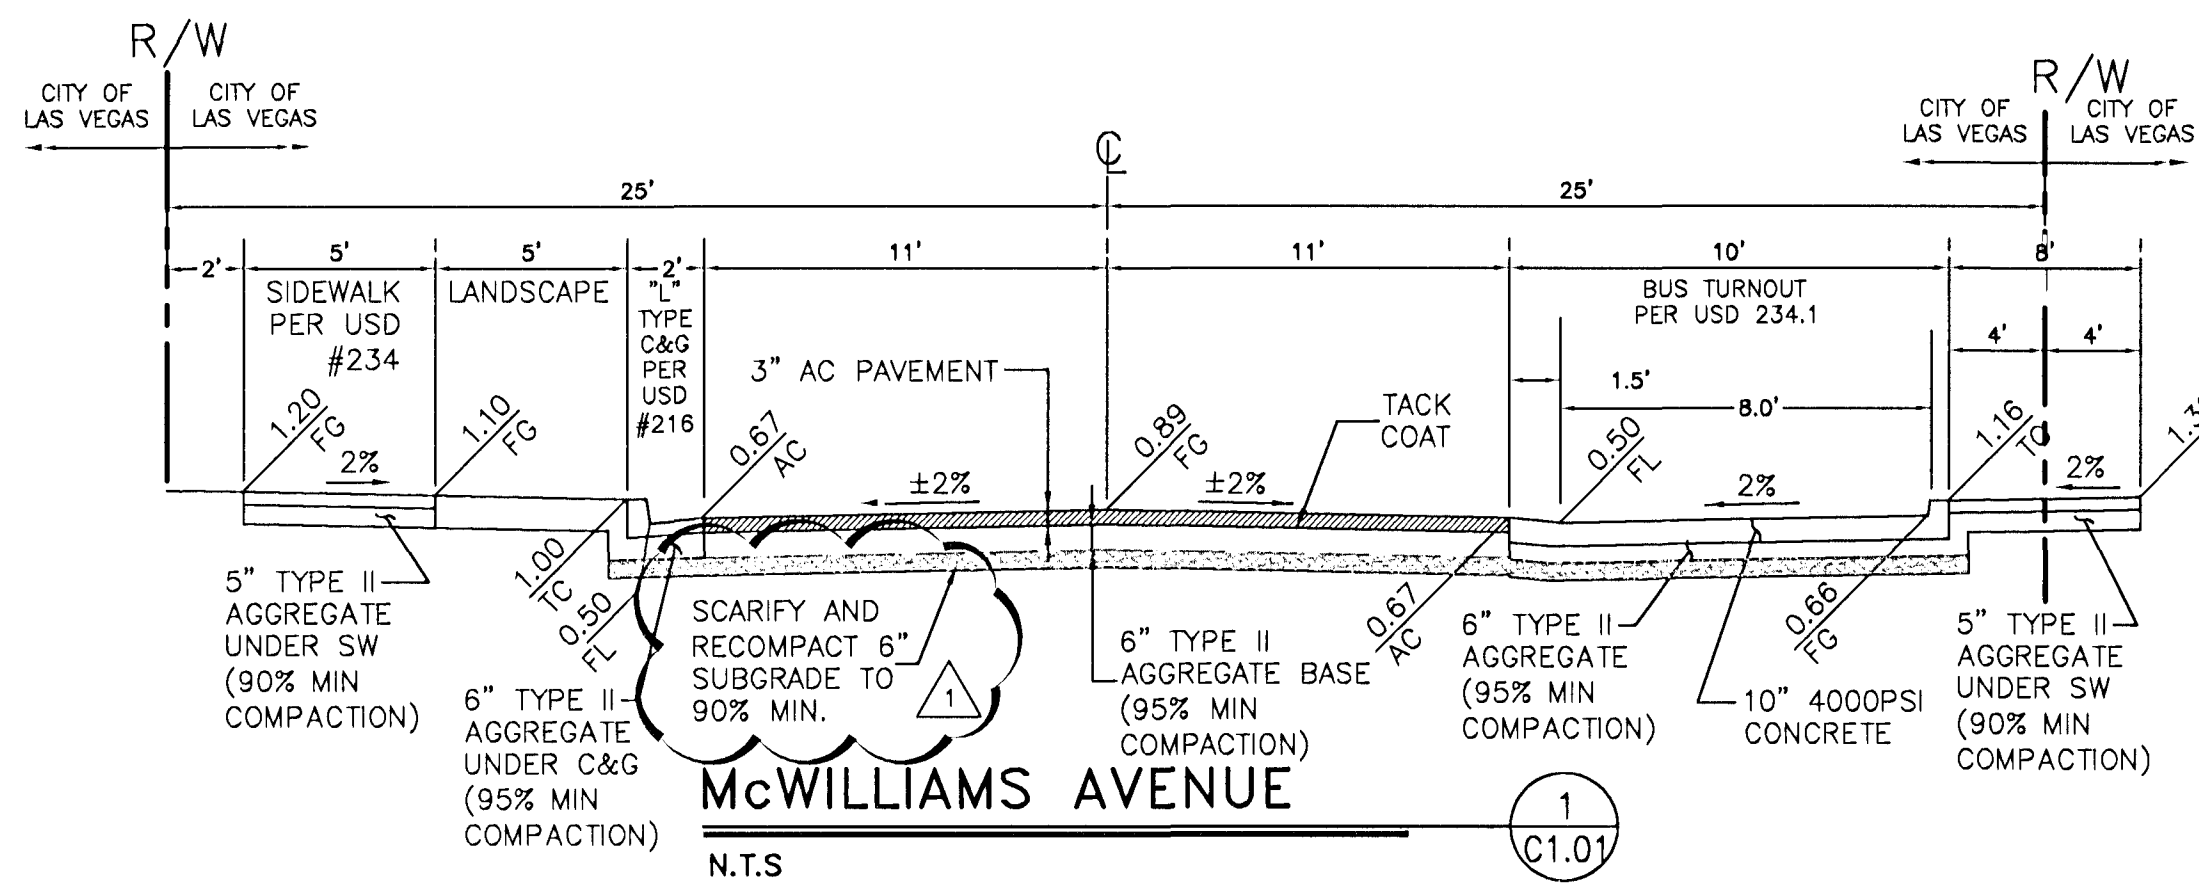
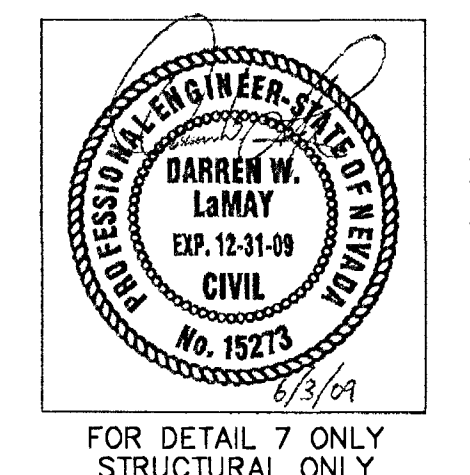
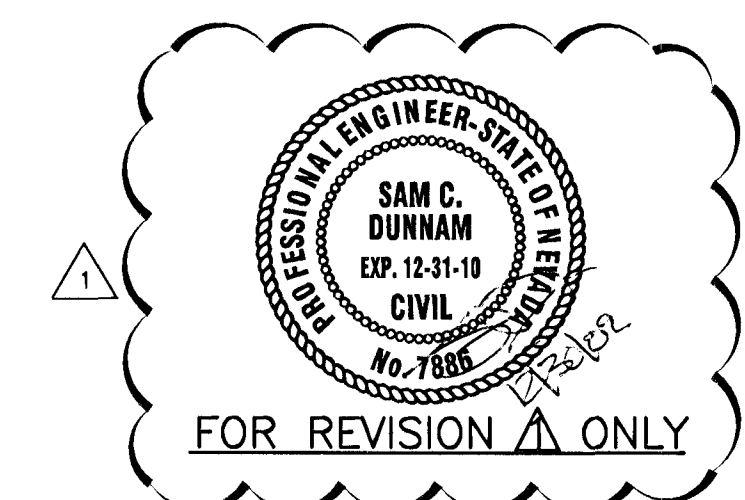
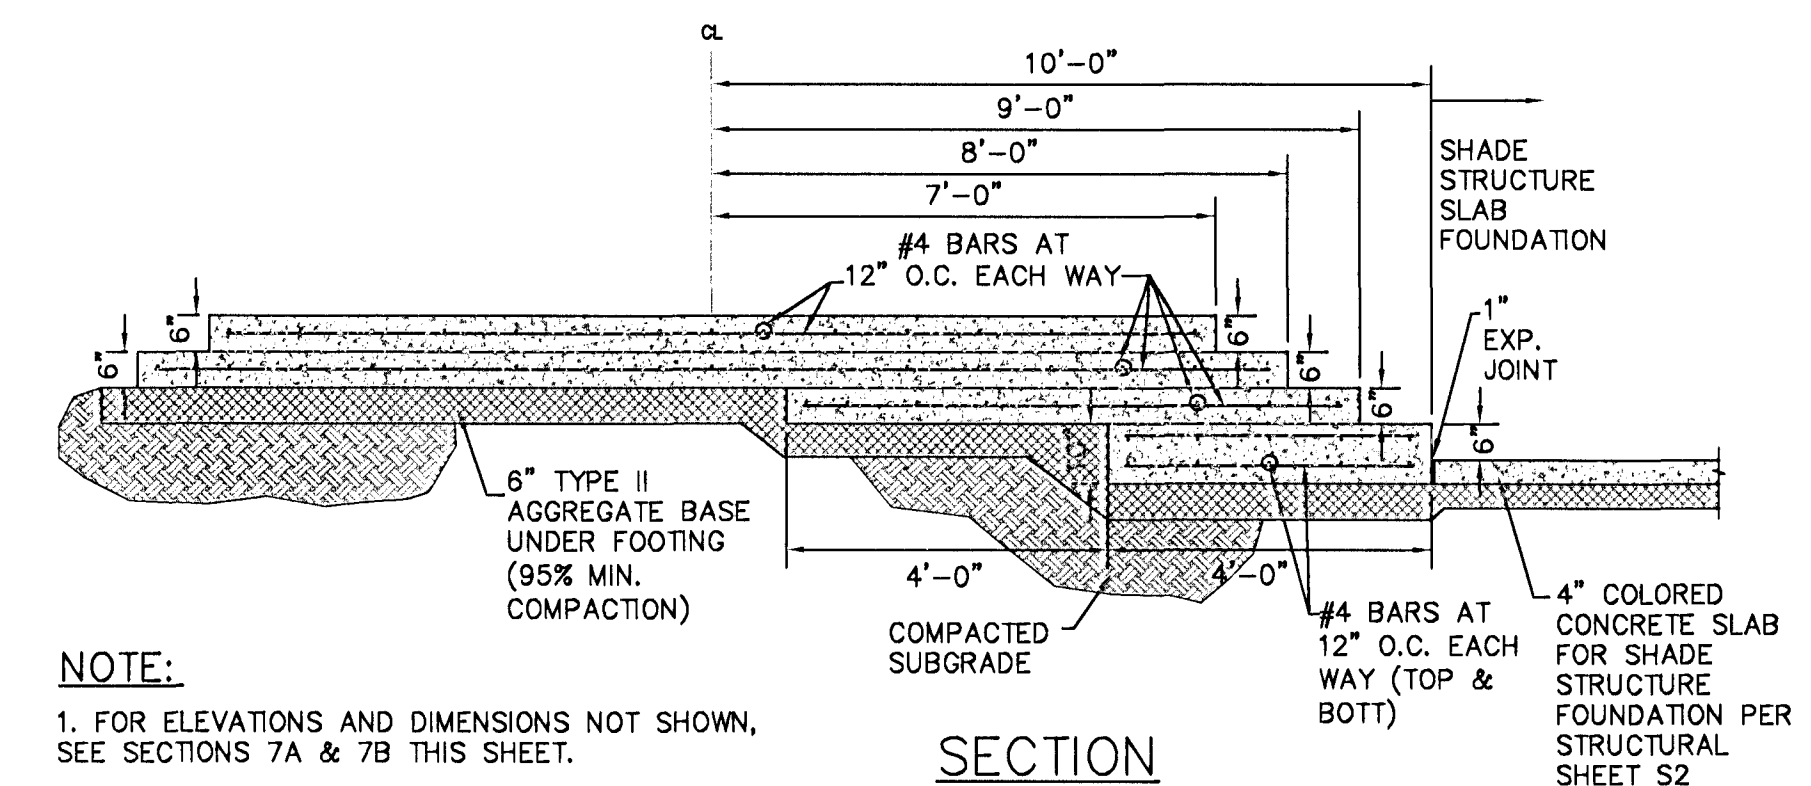
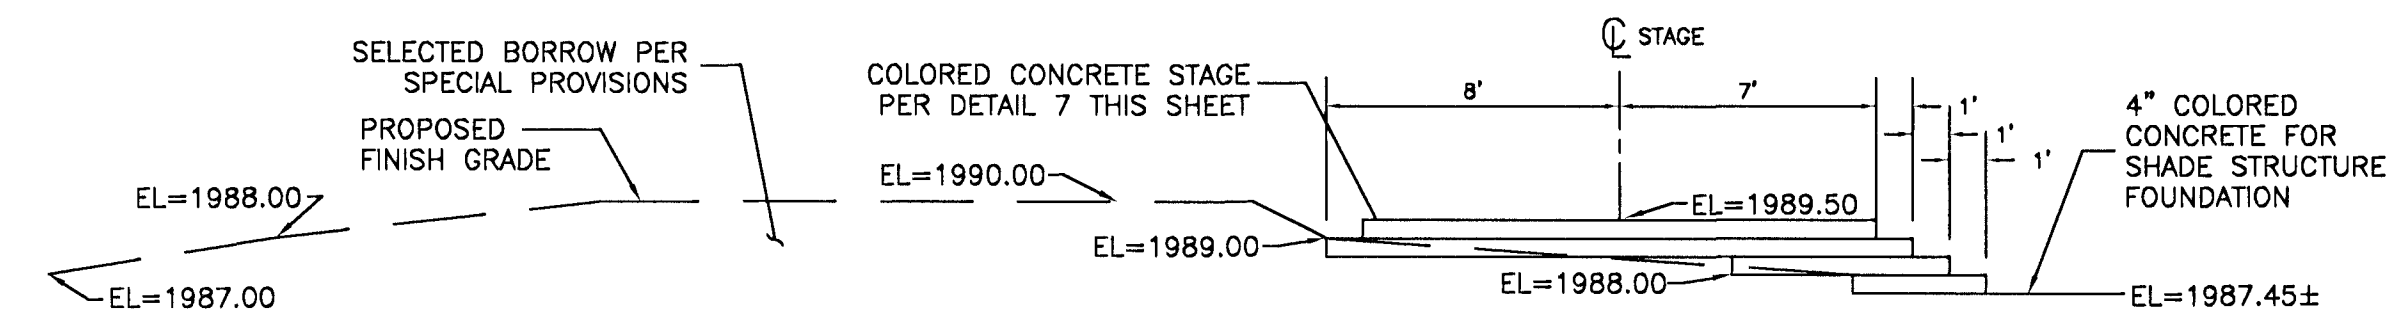
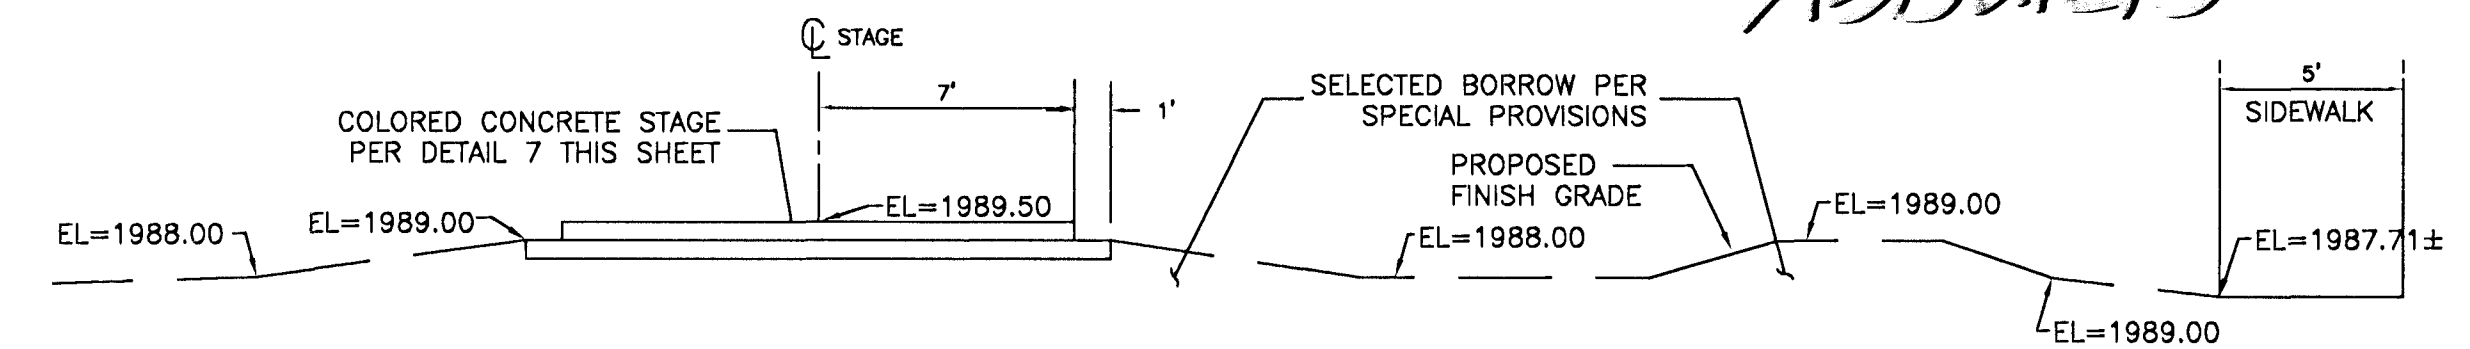


SAWCUT CONTROL JOINT

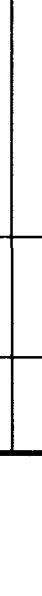

	DRAWN BY: <u>BM/R/BK/B/9AM</u> 5/4/09		TITLE: NEON BONEYARD PARK CITY OF LAS VEGAS	DEPARTMENT OF PUBLIC WORKS 400 EAST STEWART LAS VEGAS, NEVADA 89101 (702) 225-6276		REVISIONS
	DESIGNED BY: <u>BM/R/BK/B/9AM</u> 5/4/09					
	CHECKED BY: <u>WK/SCD</u> 5/4/09					
	PROJECT NO: <u>05099C</u> SCALE: <u>N.T.S.</u>					
SHEET: TYPICAL SECTIONS AND CONCRETE STAGE DETAILS			NO. DATE: <u>10/13/06</u> REVISED ROADWAY SECTIONS DESCRIPTION			