




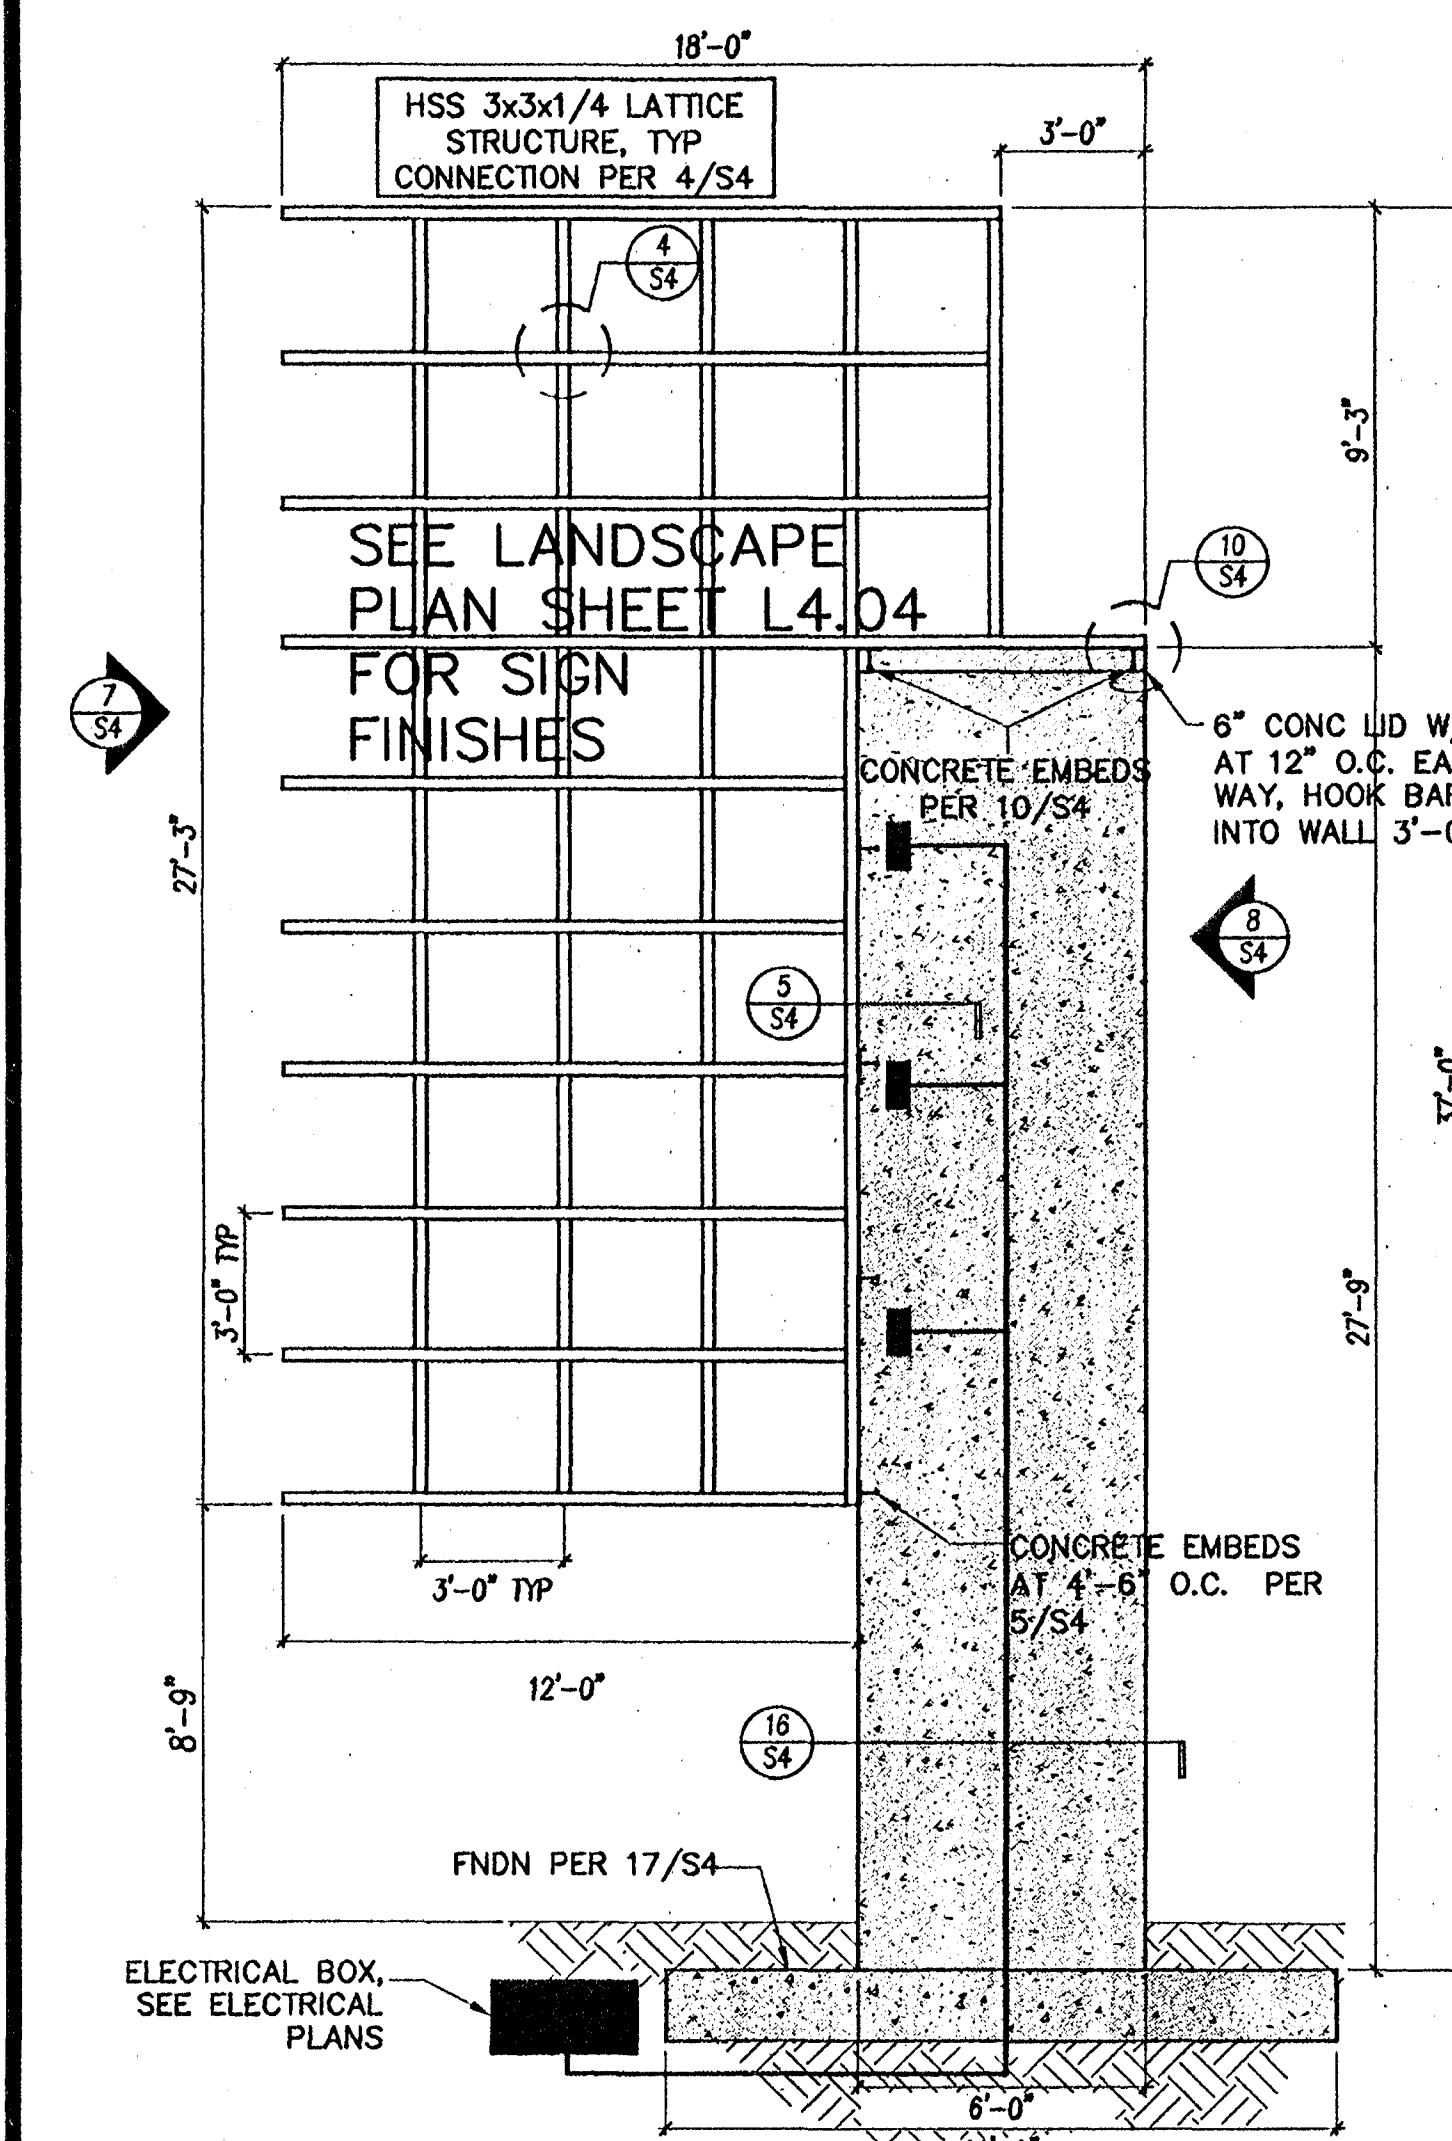


6 SIGN SIDE ELEVATION
SCALE 1/4" = 1'-0"

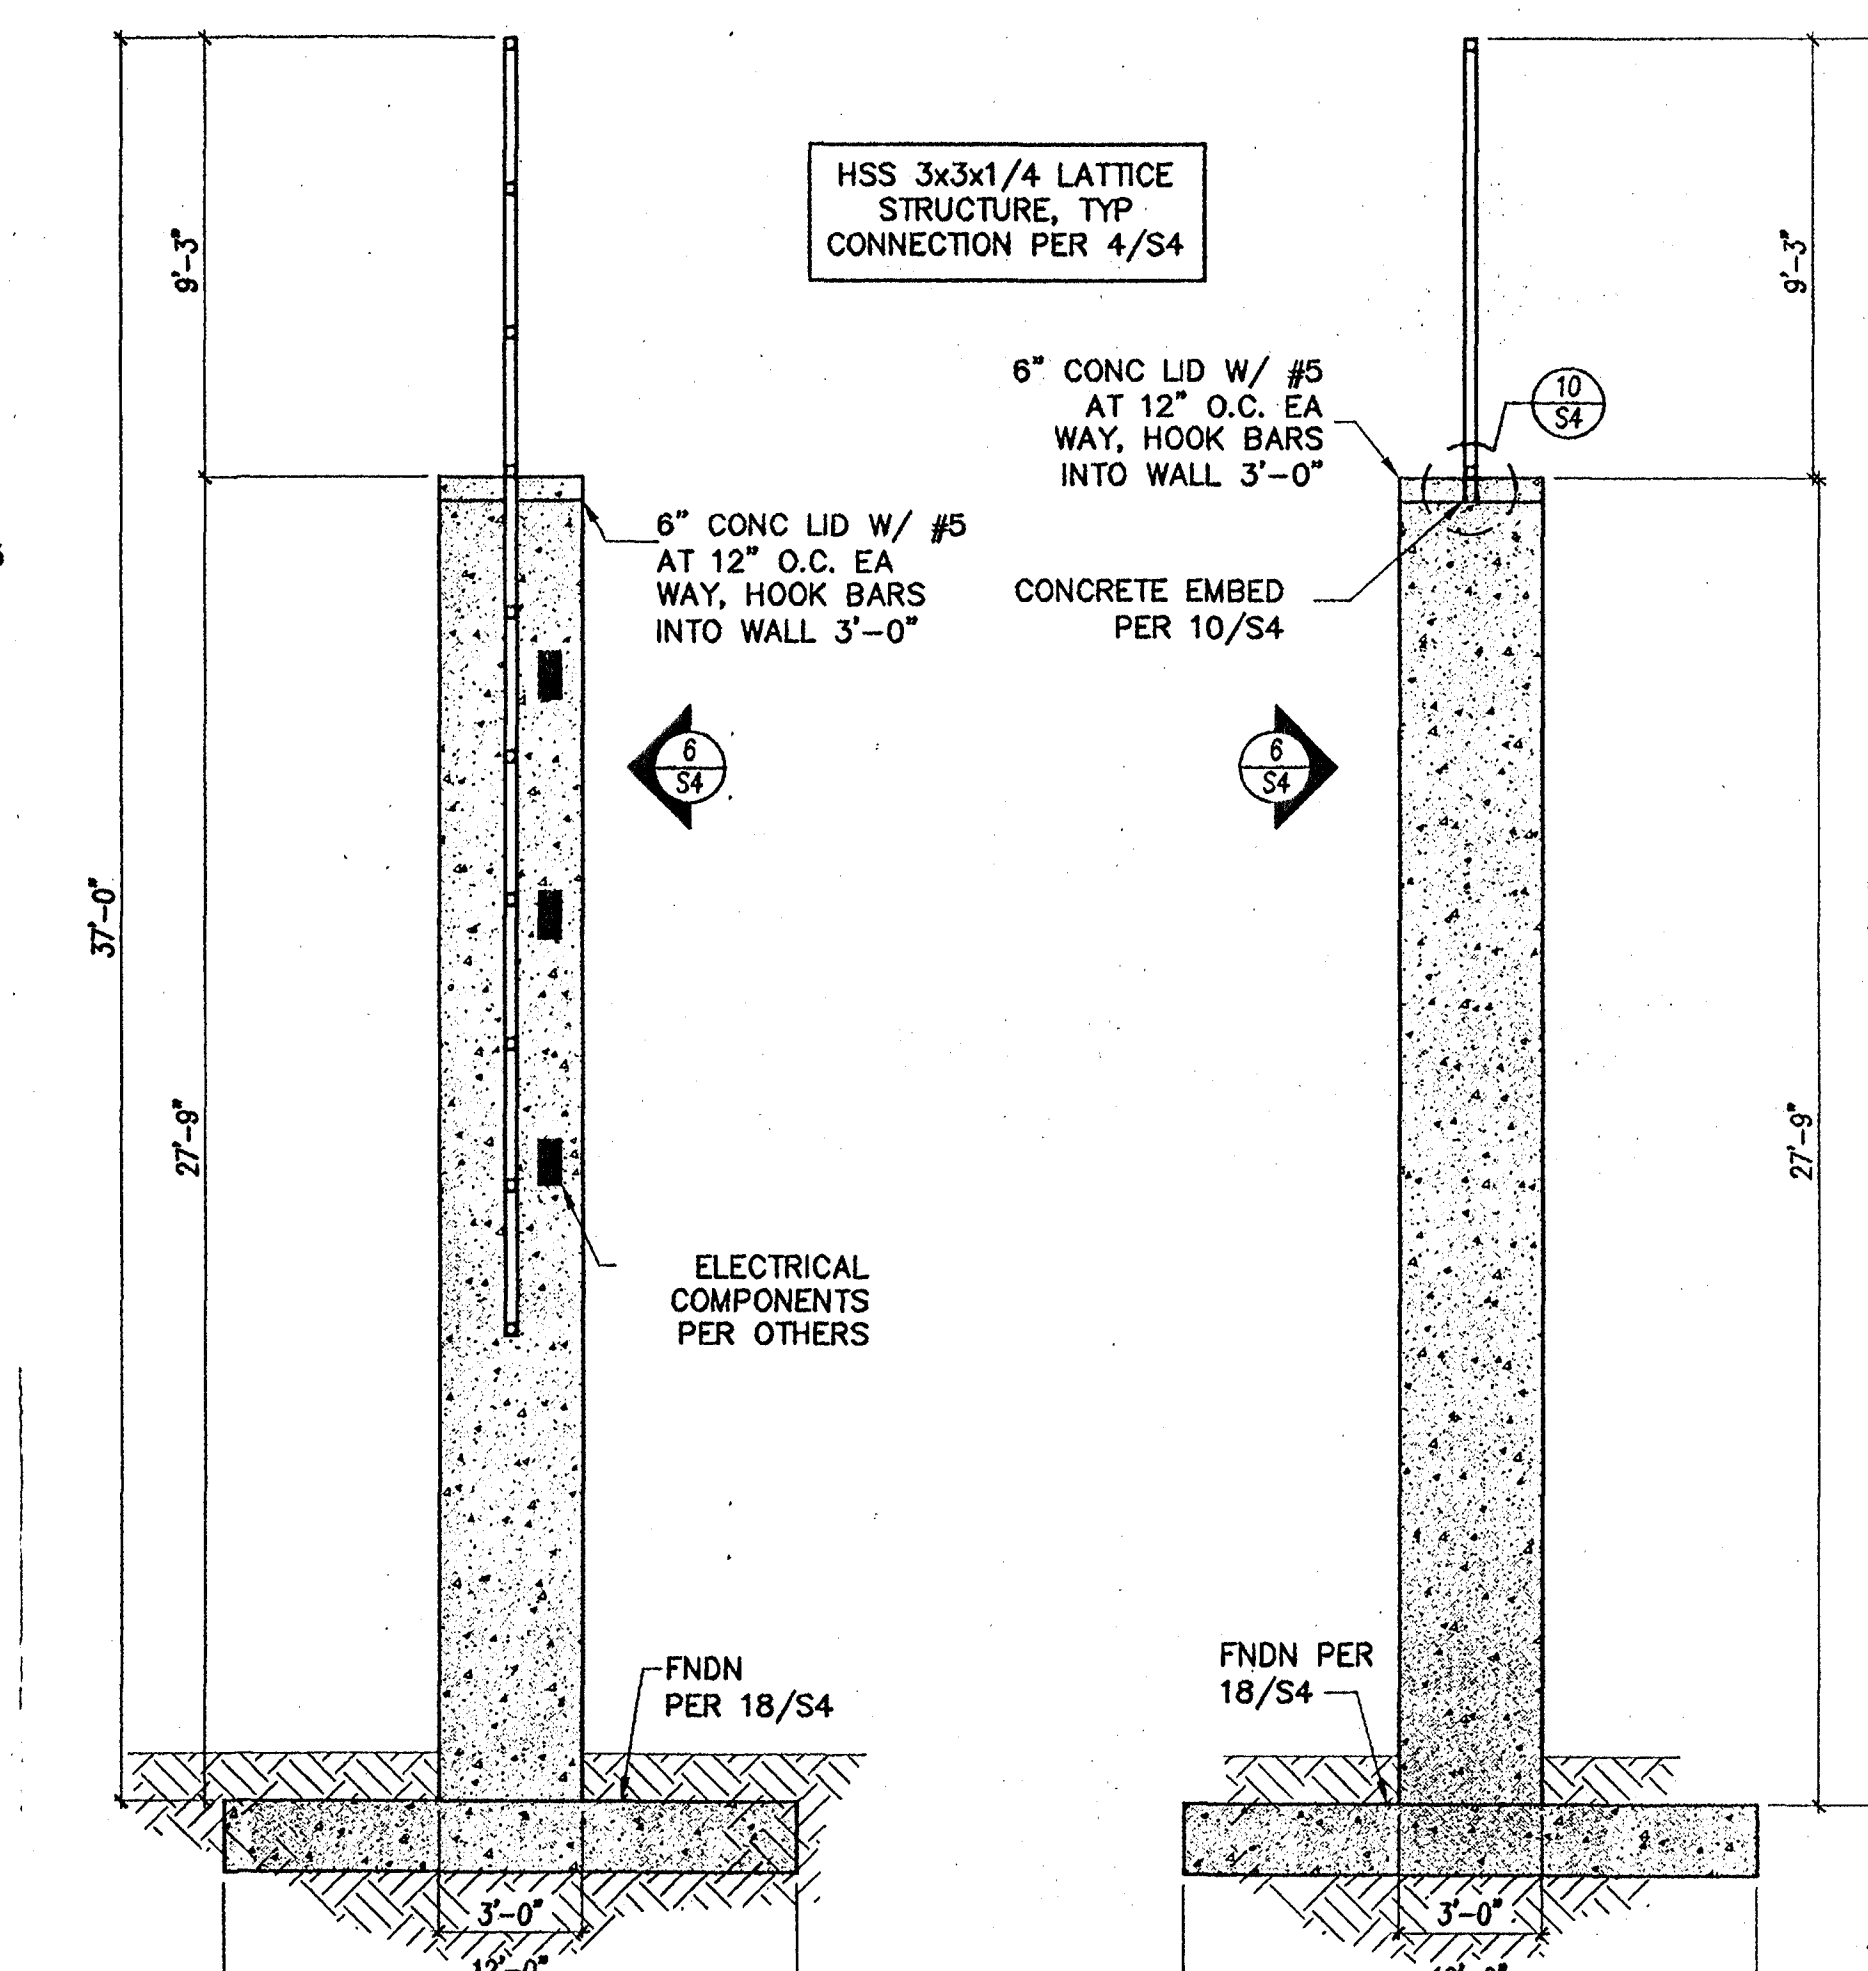


7 SIGN FRONT ELEVATION
SCALE 1/4" = 1'-0"

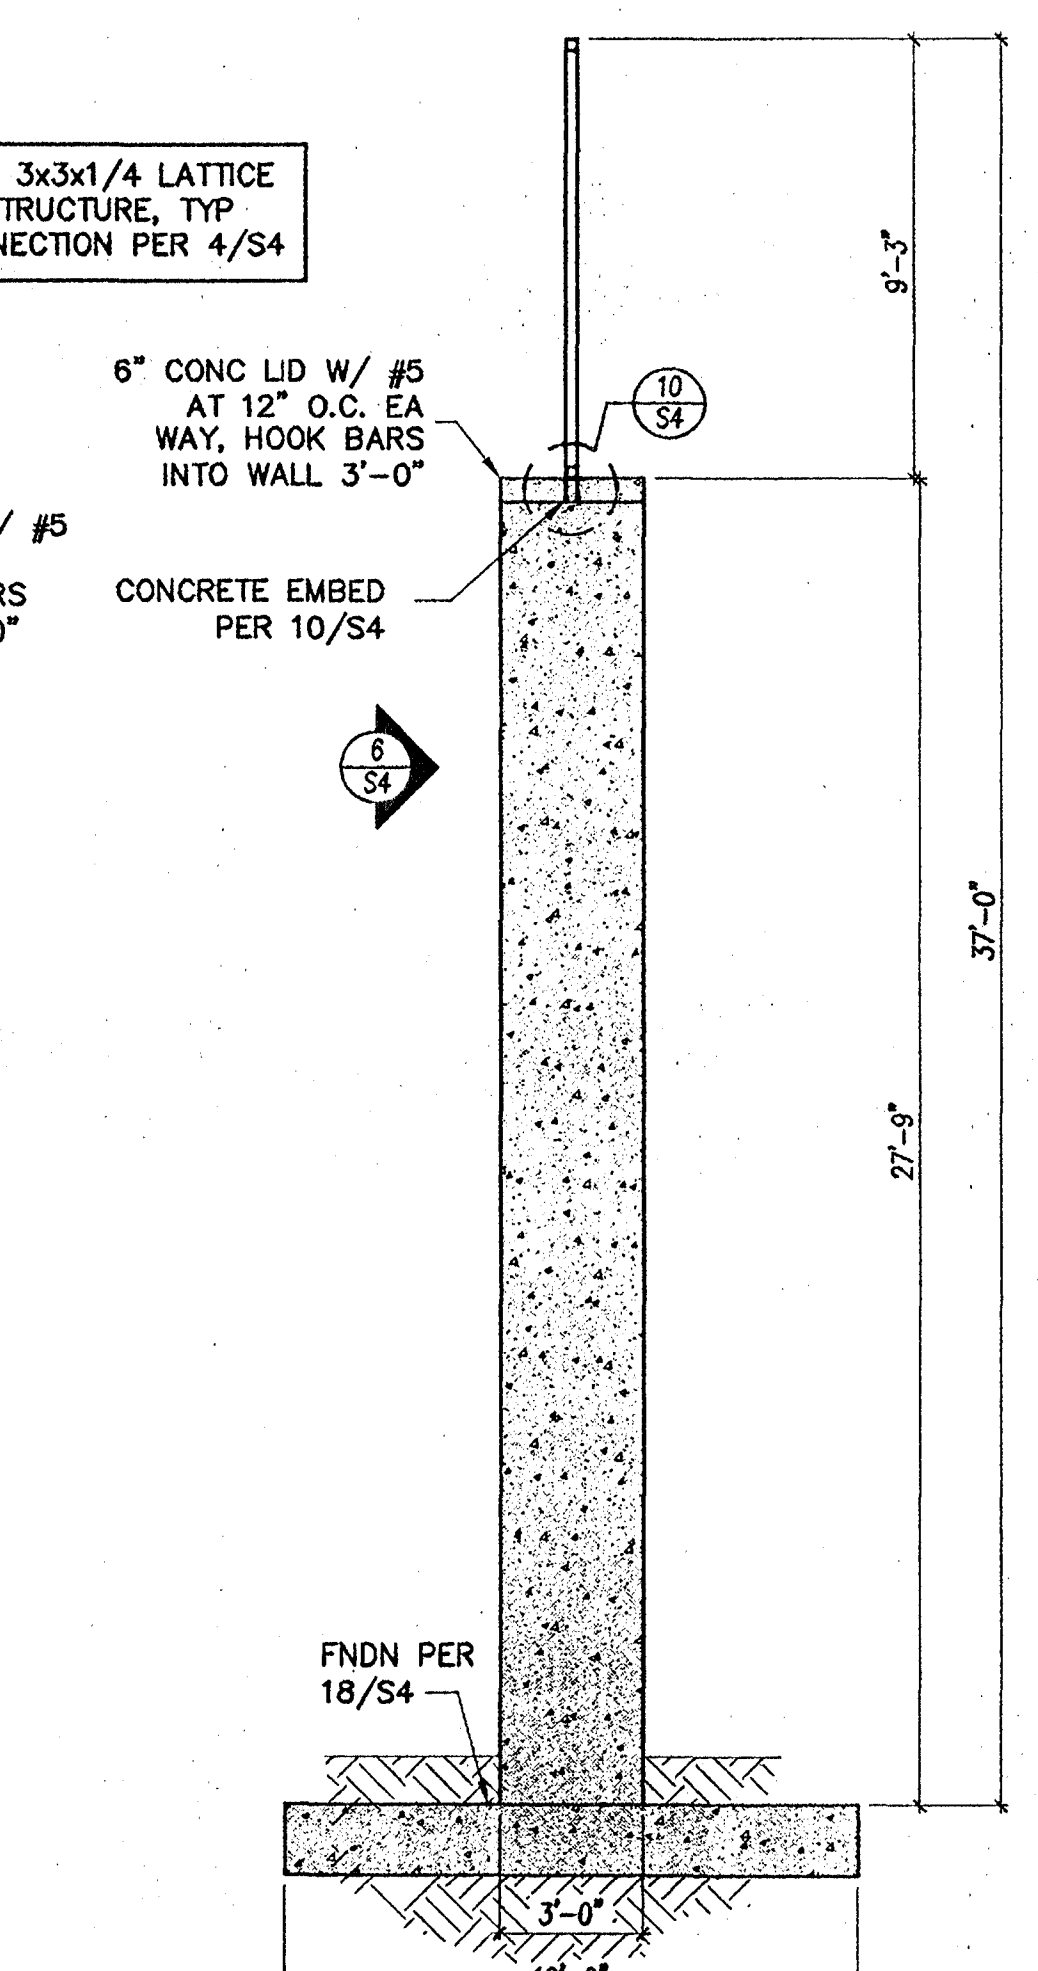


8 SIGN BACK ELEVATION
SCALE 1/4" = 1'-0"

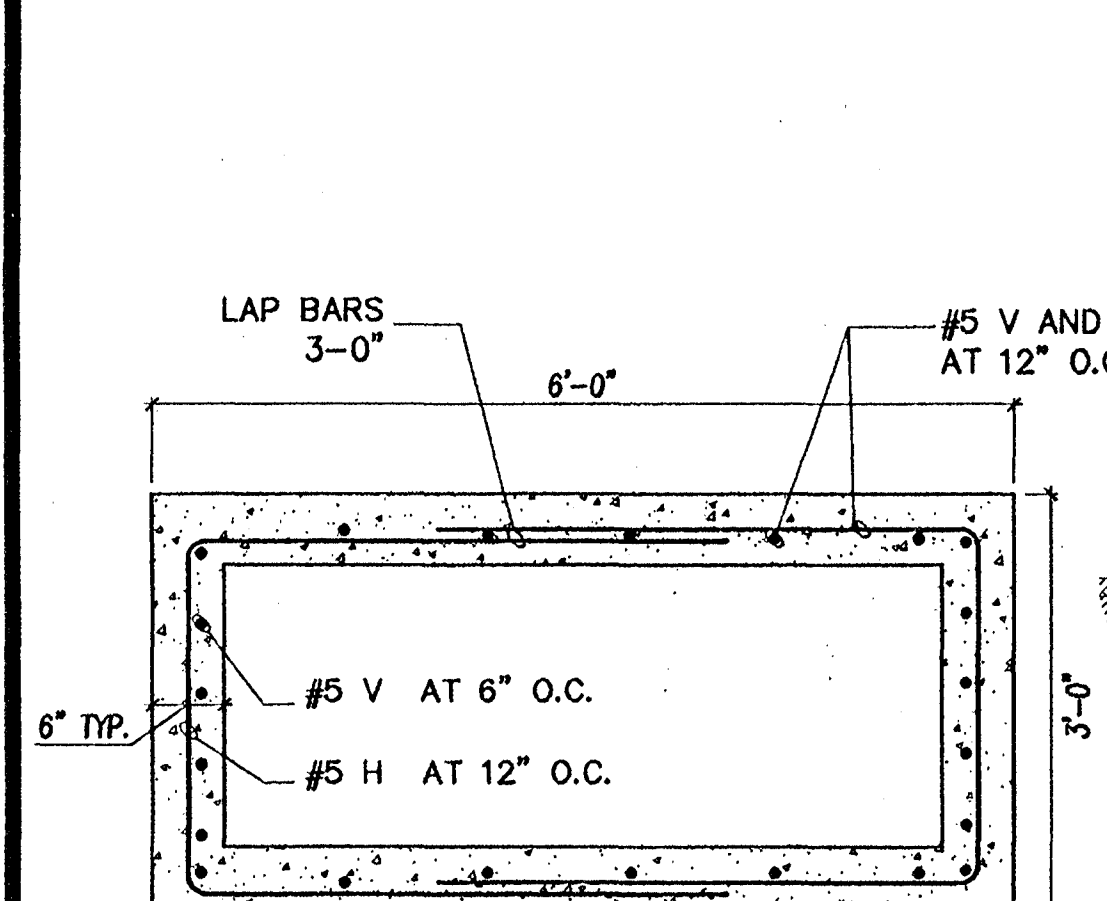


16 CONCRETE PYLON DETAIL
SCALE 3/4" = 1'-0"

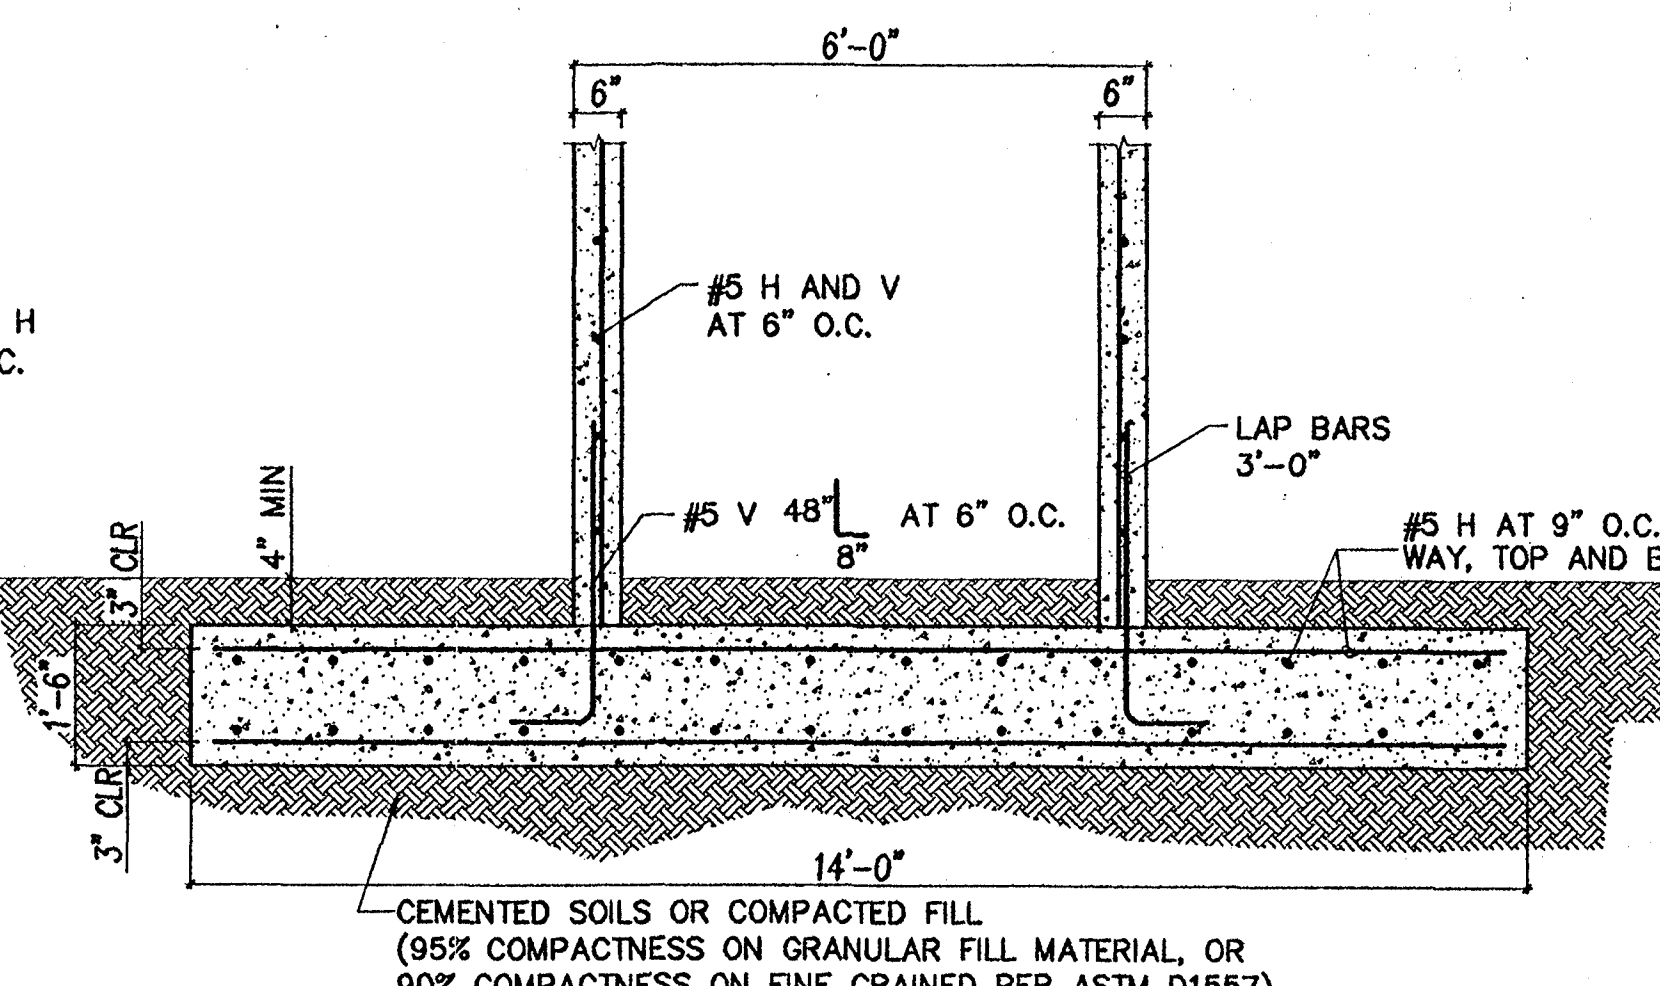


17 FOUNDATION DETAIL
SCALE 1/2" = 1'-0"

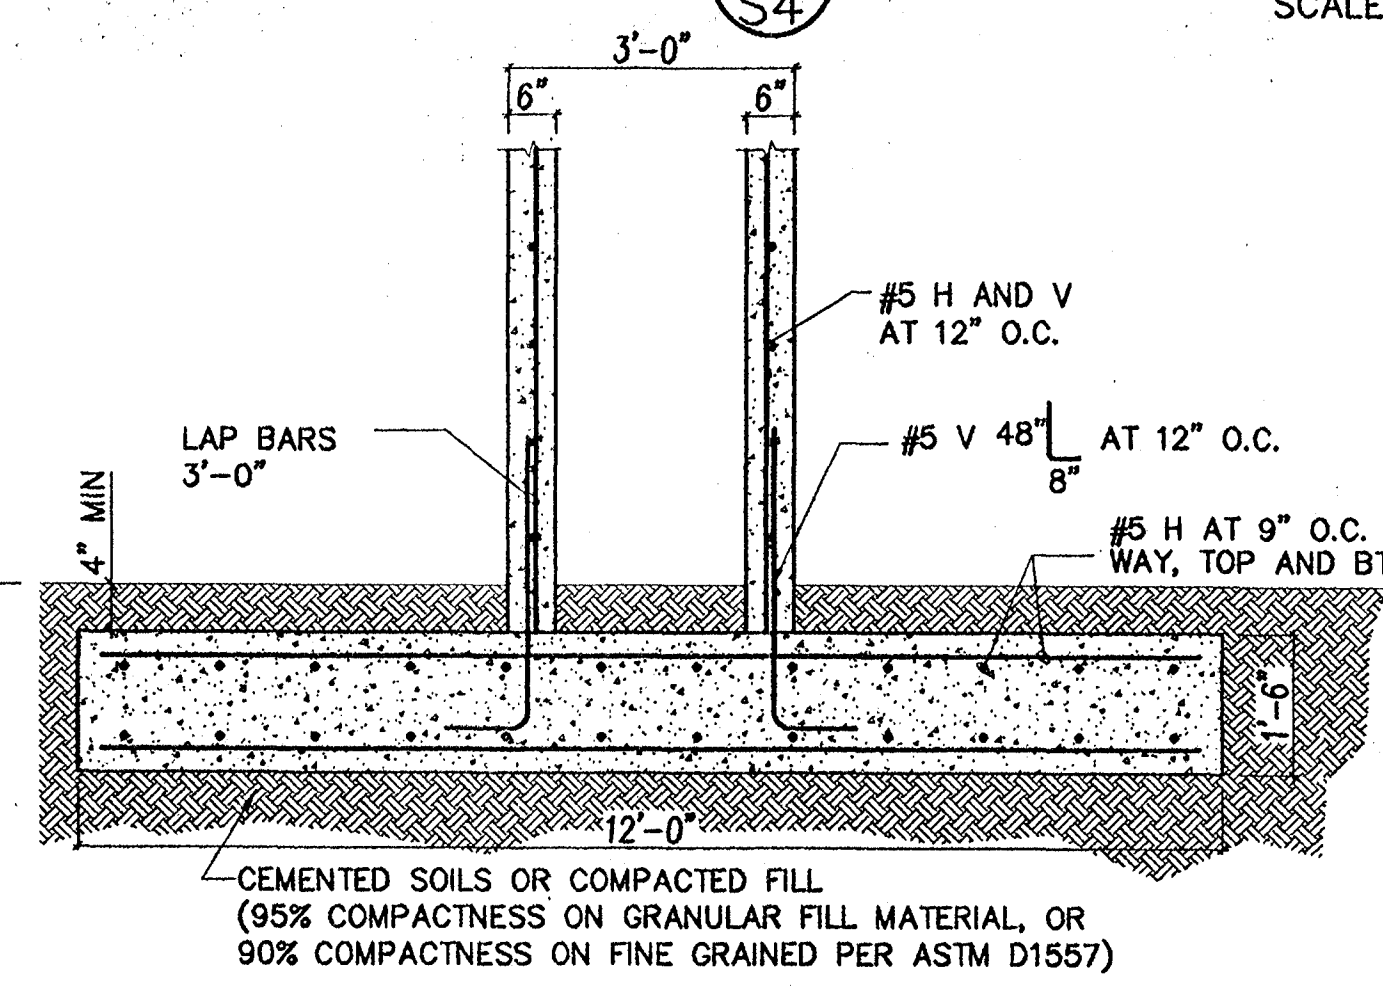


18 FOUNDATION DETAIL
SCALE 1/2" = 1'-0"

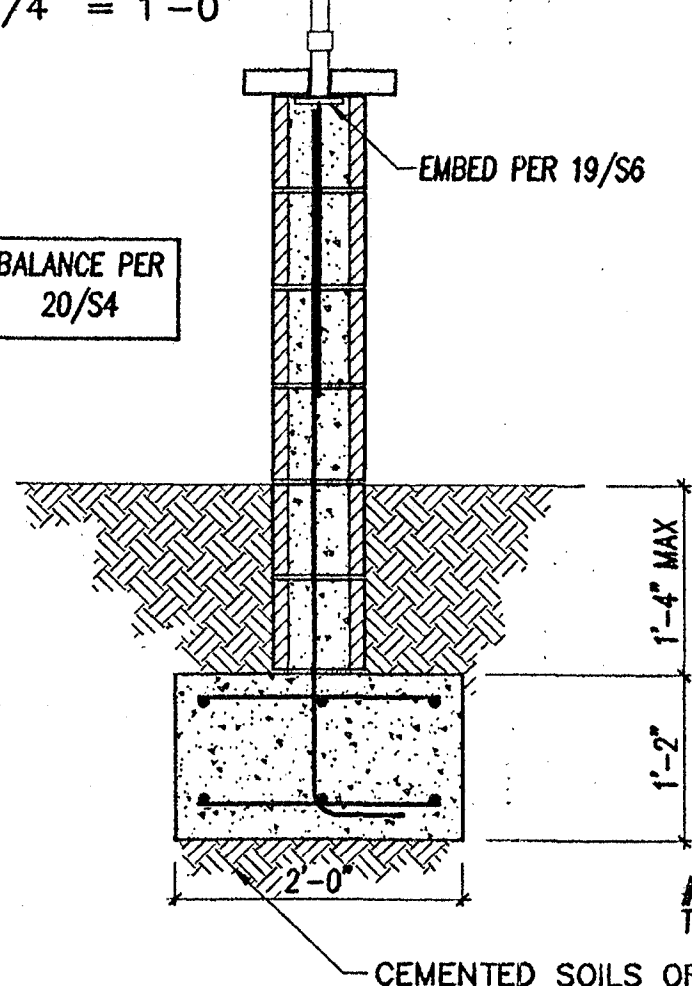


19 CMU WALL SECT
SCALE 3/4" = 1'-0"

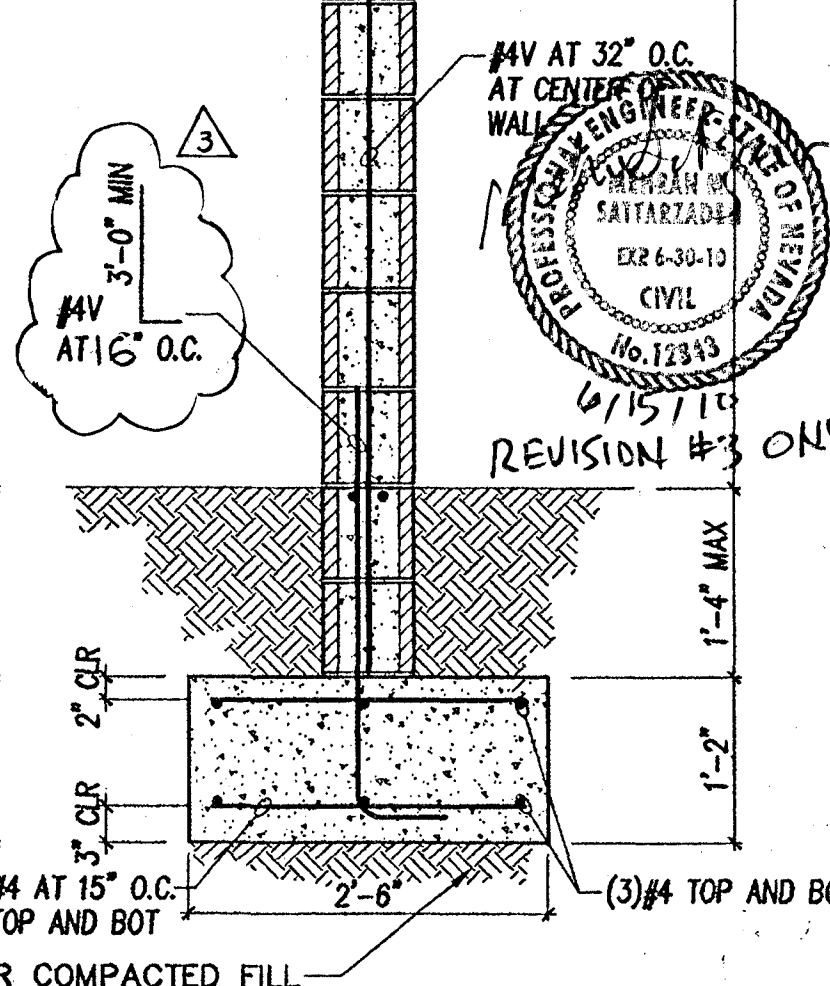


20 CMU WALL SECT
SCALE 3/4" = 1'-0"

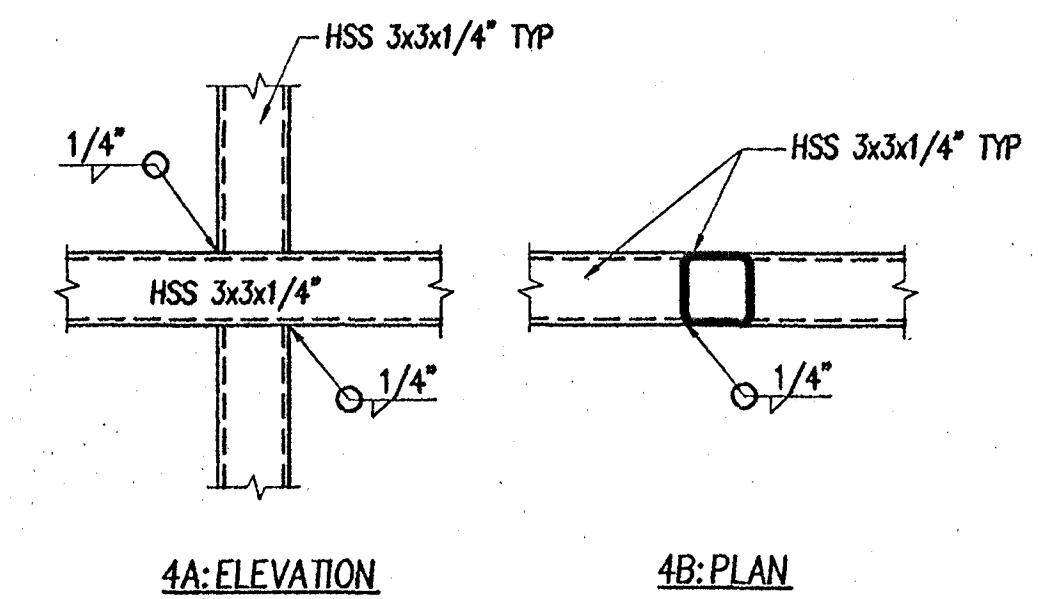


4A ELEVATION
4B PLAN
SCALE 1 1/2" = 1'-0"

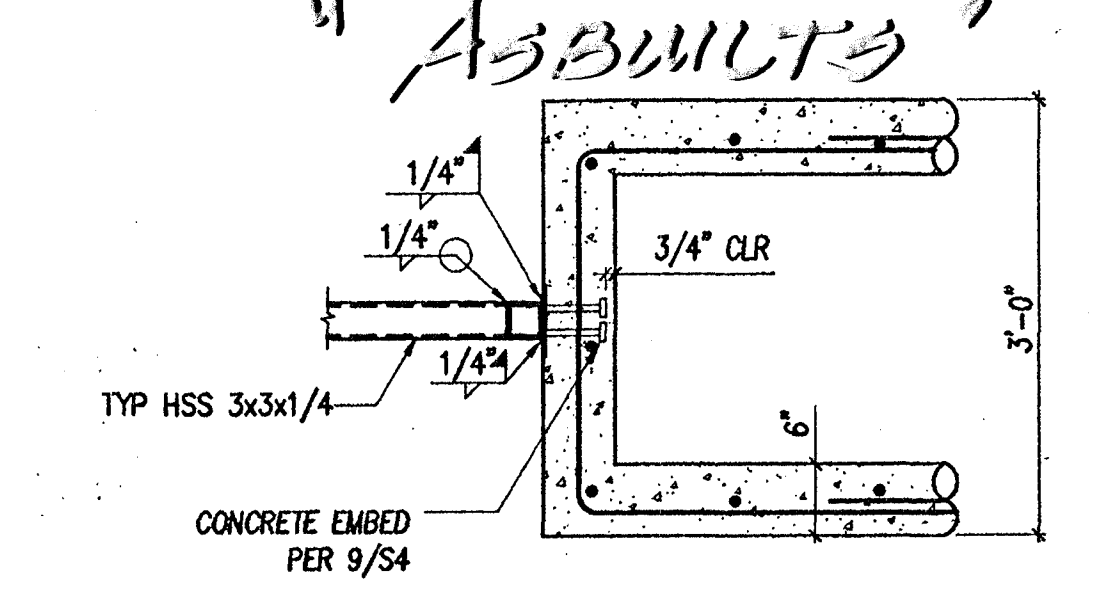


5 CONCRETE/TUBE DETAIL
SCALE 3/4" = 1'-0"

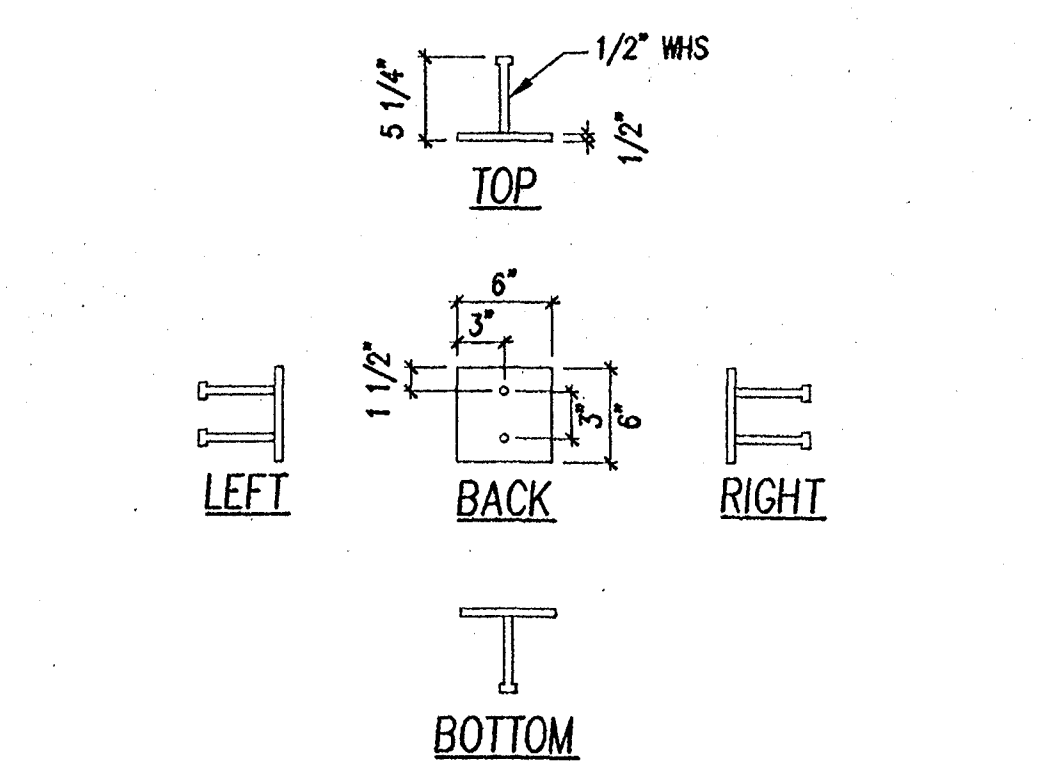


9 CONCRETE EMBEDS
SCALE 1" = 1'-0"

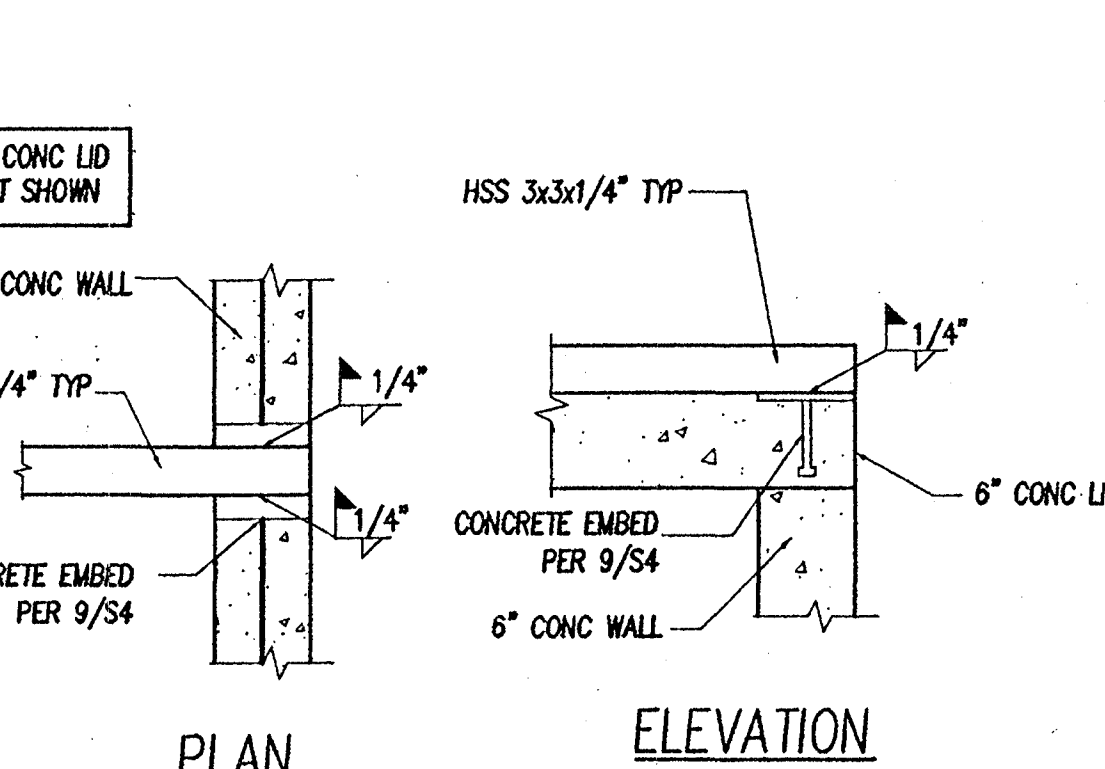

10 CONCRETE/TUBE DETAIL
SCALE 1" = 1'-0"

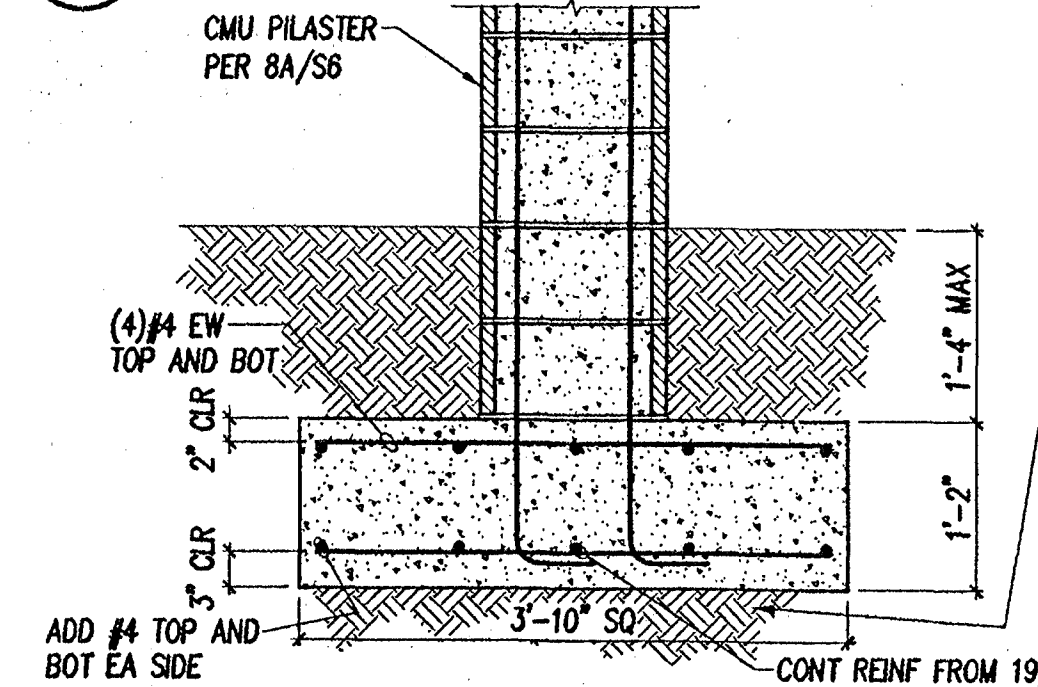

14 CMU PILASTER SECTION
SCALE 3/4" = 1'-0"

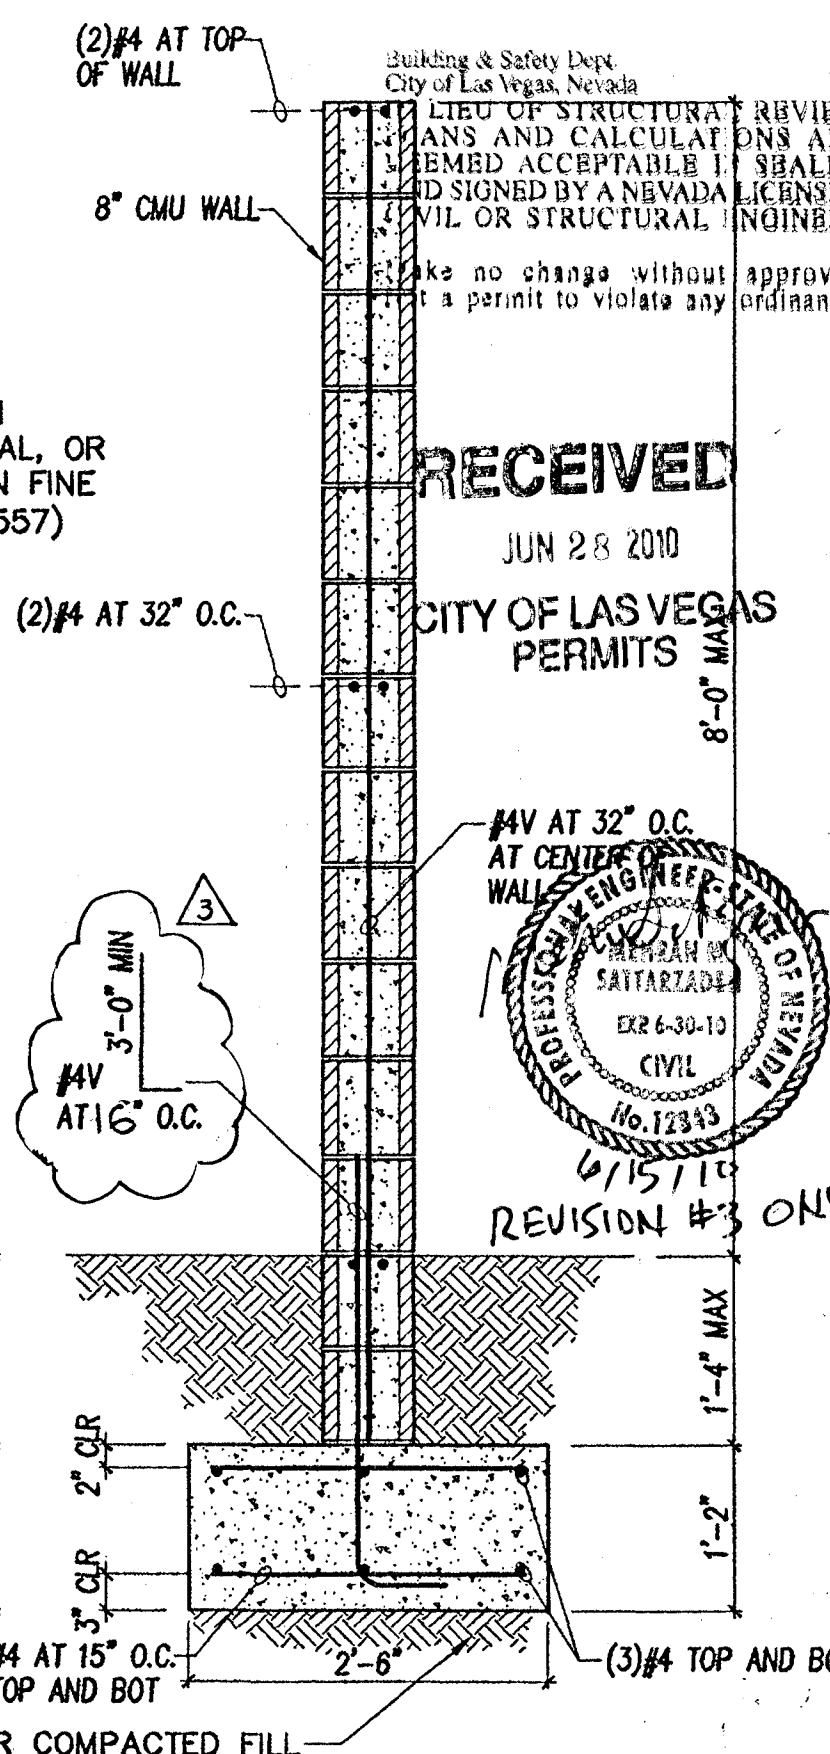

REVISIONS NO. DATE DESCRIPTION 1 6/15/10 DETAIL 20, DOWEL STAINING APP'D	
DEPARTMENT OF PUBLIC WORKS 400 EAST STEWART LAS VEGAS, NEVADA 89101 (702) 225-6276 poggemeyer design group, inc. 6000 Boulder Ranch #10 • Las Vegas, NV 89121 • p.poggemeyer@poggemeyer.com	
TITLE: NEON BONEYARD PARK CITY OF LAS VEGAS	SHEET: VERTICAL SIGN ELEVATION AND DETAILS
DRAWN BY: JG / MB DESIGNED BY: CM CHECKED BY: SA / ROB PROJECT NO: 06089 SCALE:	PROFESSIONAL ENGINEER-STATE OF NEVADA ROBERT D. BOURGAGES Exp: 12-31-10 CIVIL & STRUCTURAL No. 1194
Sheet S4 20 of 37 CLV DRAWING NO. 676-12	