




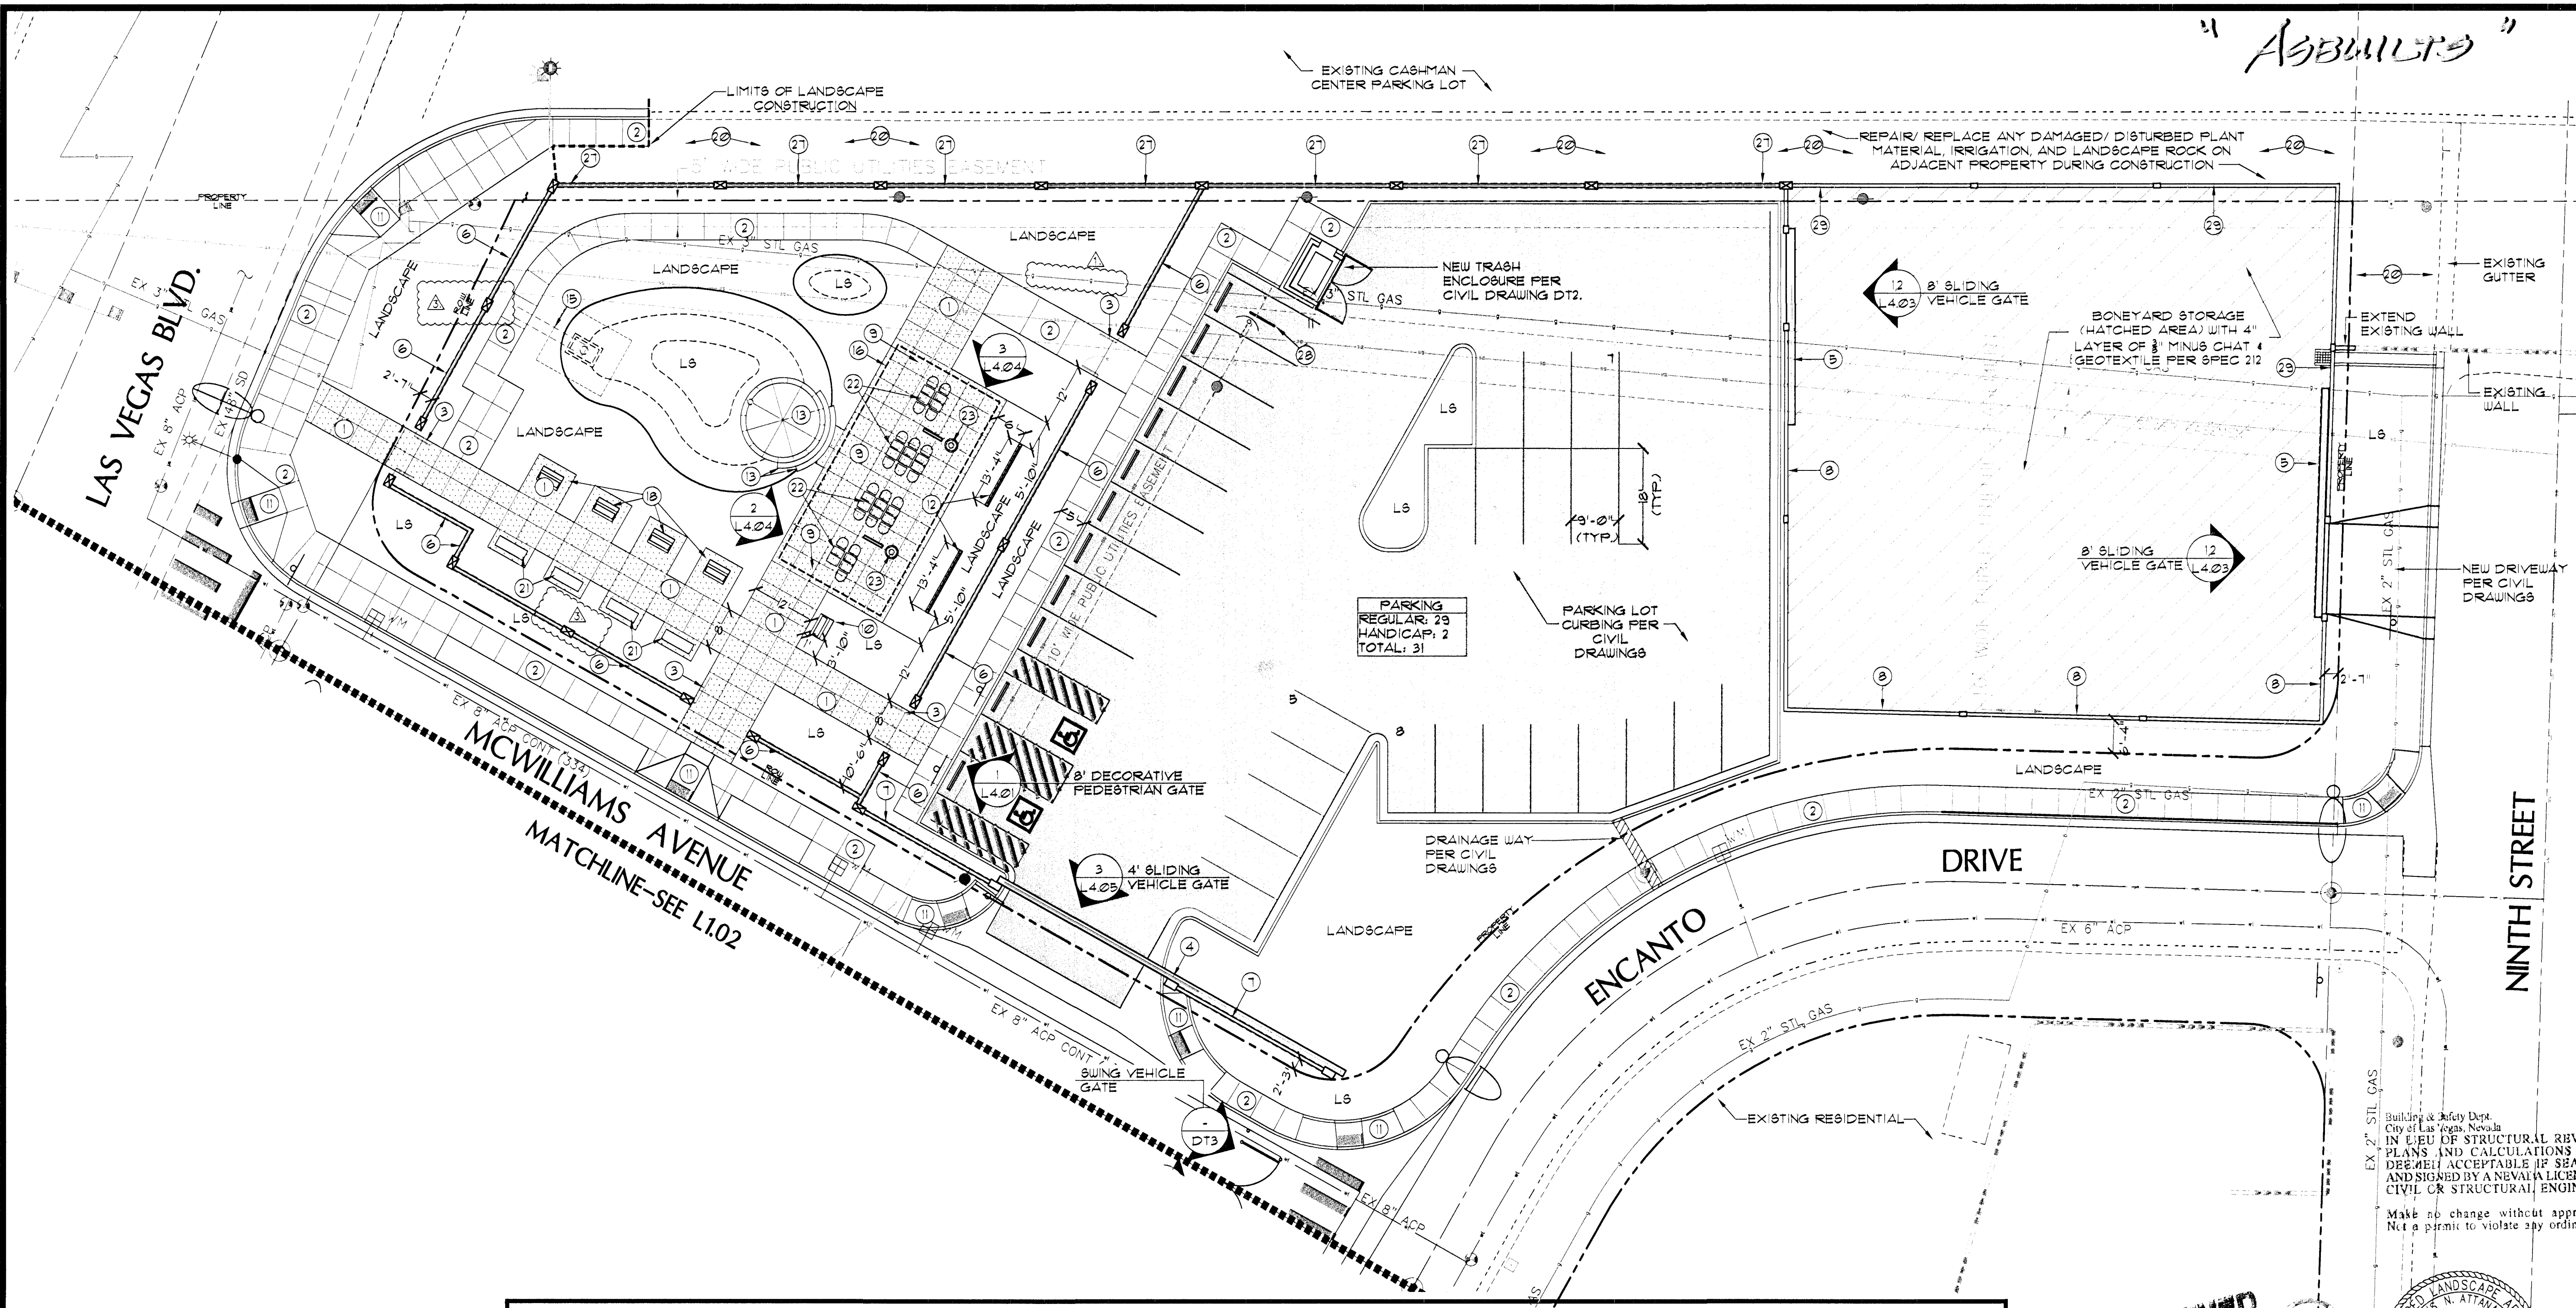


LANDSCAPE CONSTRUCTION LEGEND

1) COLORED CONCRETE SIDEWALK (COLOR HARDENER: BRICKFORD ANTIQUE ROSE 1020 OR EQUAL WITH ACID ETCH FINISH AND MATTE SEALER-SEE CIVIL DUGS FOR ADDITIONAL INFORMATION. PROVIDE A 3' SQ. MOCKUP FOR REVIEW AND APPROVAL.	20) RESTORE AND REPAIR CASHMAN LANDSCAPING, IRRIGATION AND ROCK FROM CONSTRUCTION ACTIVITIES
2) CONCRETE SIDEWALK SEE CIVIL DRAWINGS FOR ADDITIONAL INFORMATION	21) CONCRETE BENCH PER: QUICKCRETE MODEL: WAVE 321WAVE719 P31; SEALER: BOARDBUSTERS; AND ANCHOR BOLTS INSTALL PER PER RECOMMENDATIONS TOTAL QTY: 4
3) 8' DECORATIVE PEDESTRIAN GATE (SEE SHEET L4.01, DETAIL 13)	22) CONCRETE PAVING TABLE: QUICKCRETE MODEL: QUEL321 WELCOME TABLE COLOR: P3 TEXTURE: T1 WITH SEALER AND ANCHOR BOLTS INSTALL PER PER RECOMMENDATIONS TOTAL TABLES QTY: 10 TOTAL CHAIR QTY: 10
4) 4' SLIDING VEHICLE GATE (SEE SHEET L4.03, DETAIL 3.4)	23) STANDARD TRASH RECEPTACLE PER: QUICKCRETE MODEL: QR-MT2136U P31 SEALER: BLACK LID AND LINER
5) 8' SLIDING VEHICLE GATE (SEE SHEET L4.03, DETAIL 1, 2)	24) 4' PEDESTRIAN EGRESS GATE (SEE SHEET L4.03, DETAIL 2)
6) LOW CMU WALL & TUBULAR STEEL FENCE (SEE SHEET L4.01 DETAIL 1 & SHEET 86 DETAIL 7)	25) 8' PEDESTRIAN EGRESS GATE (SEE SHEET L4.03, DETAIL 1)
7) LOW CMU WALL (SEE SHEET L4.01, DETAIL 2)	26) NOT USED
8) 8' CMU WALL (SEE SHEET L4.01, DETAIL 3 & SHEET 84 DETAIL 20)	27) CMU RETAINING WALL & TUBULAR STEEL FENCE (SEE SHEET L4.01, DETAIL 1 & SHEET 84 DETAIL 1)
9) 4' COLORED CONCRETE SLAB (COLOR HARDENER: BRICKFORD ANTIQUE ROSE 1020 OR EQUAL WITH ACID ETCH FINISH AND MATTE SEALER (SEE SHEET 82 DETAIL 3 FOR INFORMATION)	28) BIKE RACK PER SPEC SECTION 212
10) CONCRETE MONUMENT AND PLAQUE (SEE SHEET T1 DETAILS 8.4-8.5 AND SPEC SECTION 502 FOR INFORMATION)	29) 8' CMU RETAINING WALL (SEE SHEET L4.01, DETAIL 4.5 & SHEET 86 DETAIL 9, 10)
11) HAND CAP RAMP PER CIVIL DRAWINGS	
12) DECORATIVE CMU SCREEN WALL (SEE SHEET L4.01, DETAIL 6, 7, 8 & SHEET 81 DETAIL 2)	
13) COLORED CONCRETE STAGE/STEPS (COLOR HARDENER: BRICKFORD BLUSH BEIGE 1015 FINISH: MED. BROOM SEALED) PROVIDE A 3' SQ. MOCKUP FOR REVIEW AND APPROVAL	
14) 6' HT PERMANENT CHAINLINK FENCE (SEE DETAILS 3.4 AND 5 ON SHEET L4.03)	
15) VERTICAL SIGN PYLON FOR VERTICAL LED SIGN INSTALLATION	
16) SHADE STRUCTURE (SEE SHEET L4.04, DETAIL 12.3)	
17) 6' HT CHAINLINK DOUBLE GATE (SEE SHEET L4.03 DETAIL 6)	
18) CONCRETE MONUMENT FOR INTERPRETIVE SIGNAGE (SEE SPEC SECTION 502 FOR INFORMATION)	
19) 6' CHAINLINK FENCE (SEE DETAIL 3.4, AND 5 ON SHEET L4.03)	

NOTES:
1. ALL WORK SHALL BE CONSTRUCTED IN ACCORDANCE WITH PROJECT DOCUMENTS AND SPECIFICATIONS.
2. WHEN OBVIOUS DISCREPANCIES EXIST BETWEEN THE DRAWINGS AND THE FIELD THE CONTRACTOR SHALL CONTACT THE LANDSCAPE ARCHITECT IMMEDIATELY FOR RESOLUTION OF SAID CONFLICT.
3. CONTRACTOR SHALL INSTALL ALL OVERGRADE CONCRETE SLABS IN ACCORDANCE WITH THE CIVIL ENGINEERING PLANS.
4. CONTRACTOR SHALL INSTALL ALL WALLS AND PILASTERS PER STRUCTURAL DUGS AND DETAILS.
5. CONTRACTOR SHALL COORDINATE ALL NECESSARY SLEEVES AND/OR CONDUIT FOR IRRIGATION DEVICES PRIOR TO HARDSCAPE CONSTRUCTION.

RECEIVED
JUN 28 2010
CITY OF LAS VEGAS
PERMITS

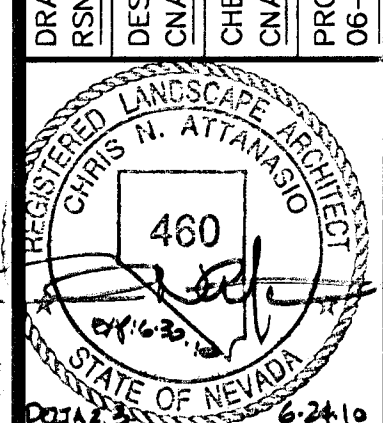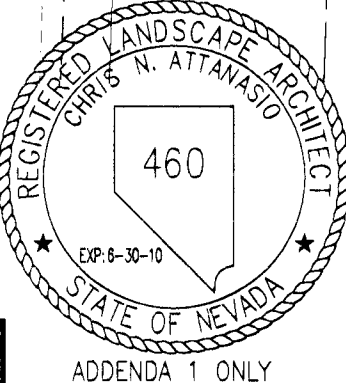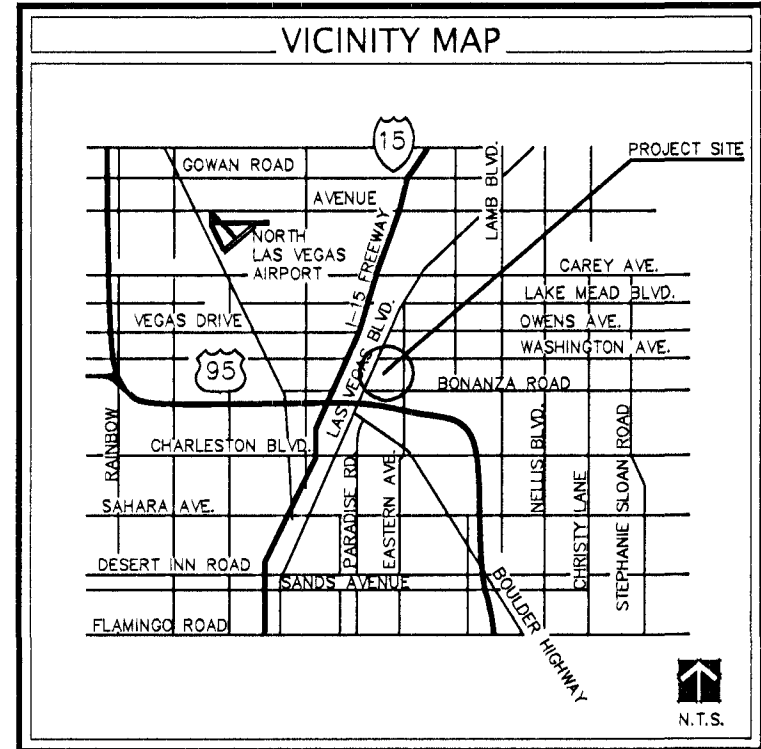

Sheet L1.01

25 of 37
CLV DRAWING NO. 676-12

DEPARTMENT OF PUBLIC WORKS
400 EAST STEWART
LAS VEGAS, NEVADA 89101
(702) 229-6276

poggemeyer
design group, inc.
6960 Sunset Road, #110 - Las Vegas, NV 89120 • P: 702.255.8275

TITLE: NEON BONEYARD PARK
CITY OF LAS VEGAS
SHEET: LANDSCAPE CONSTRUCTION PLAN

REVISIONS	ADDENDA #1	NO.	DATE:	DESCRIPTION
10-27-09	A			
06-23-10	A			REVISION #2 - NOTE REVISION & GATE ADDITION
06-24-10	A			REVISION #3 - PLASTER ADDITION