
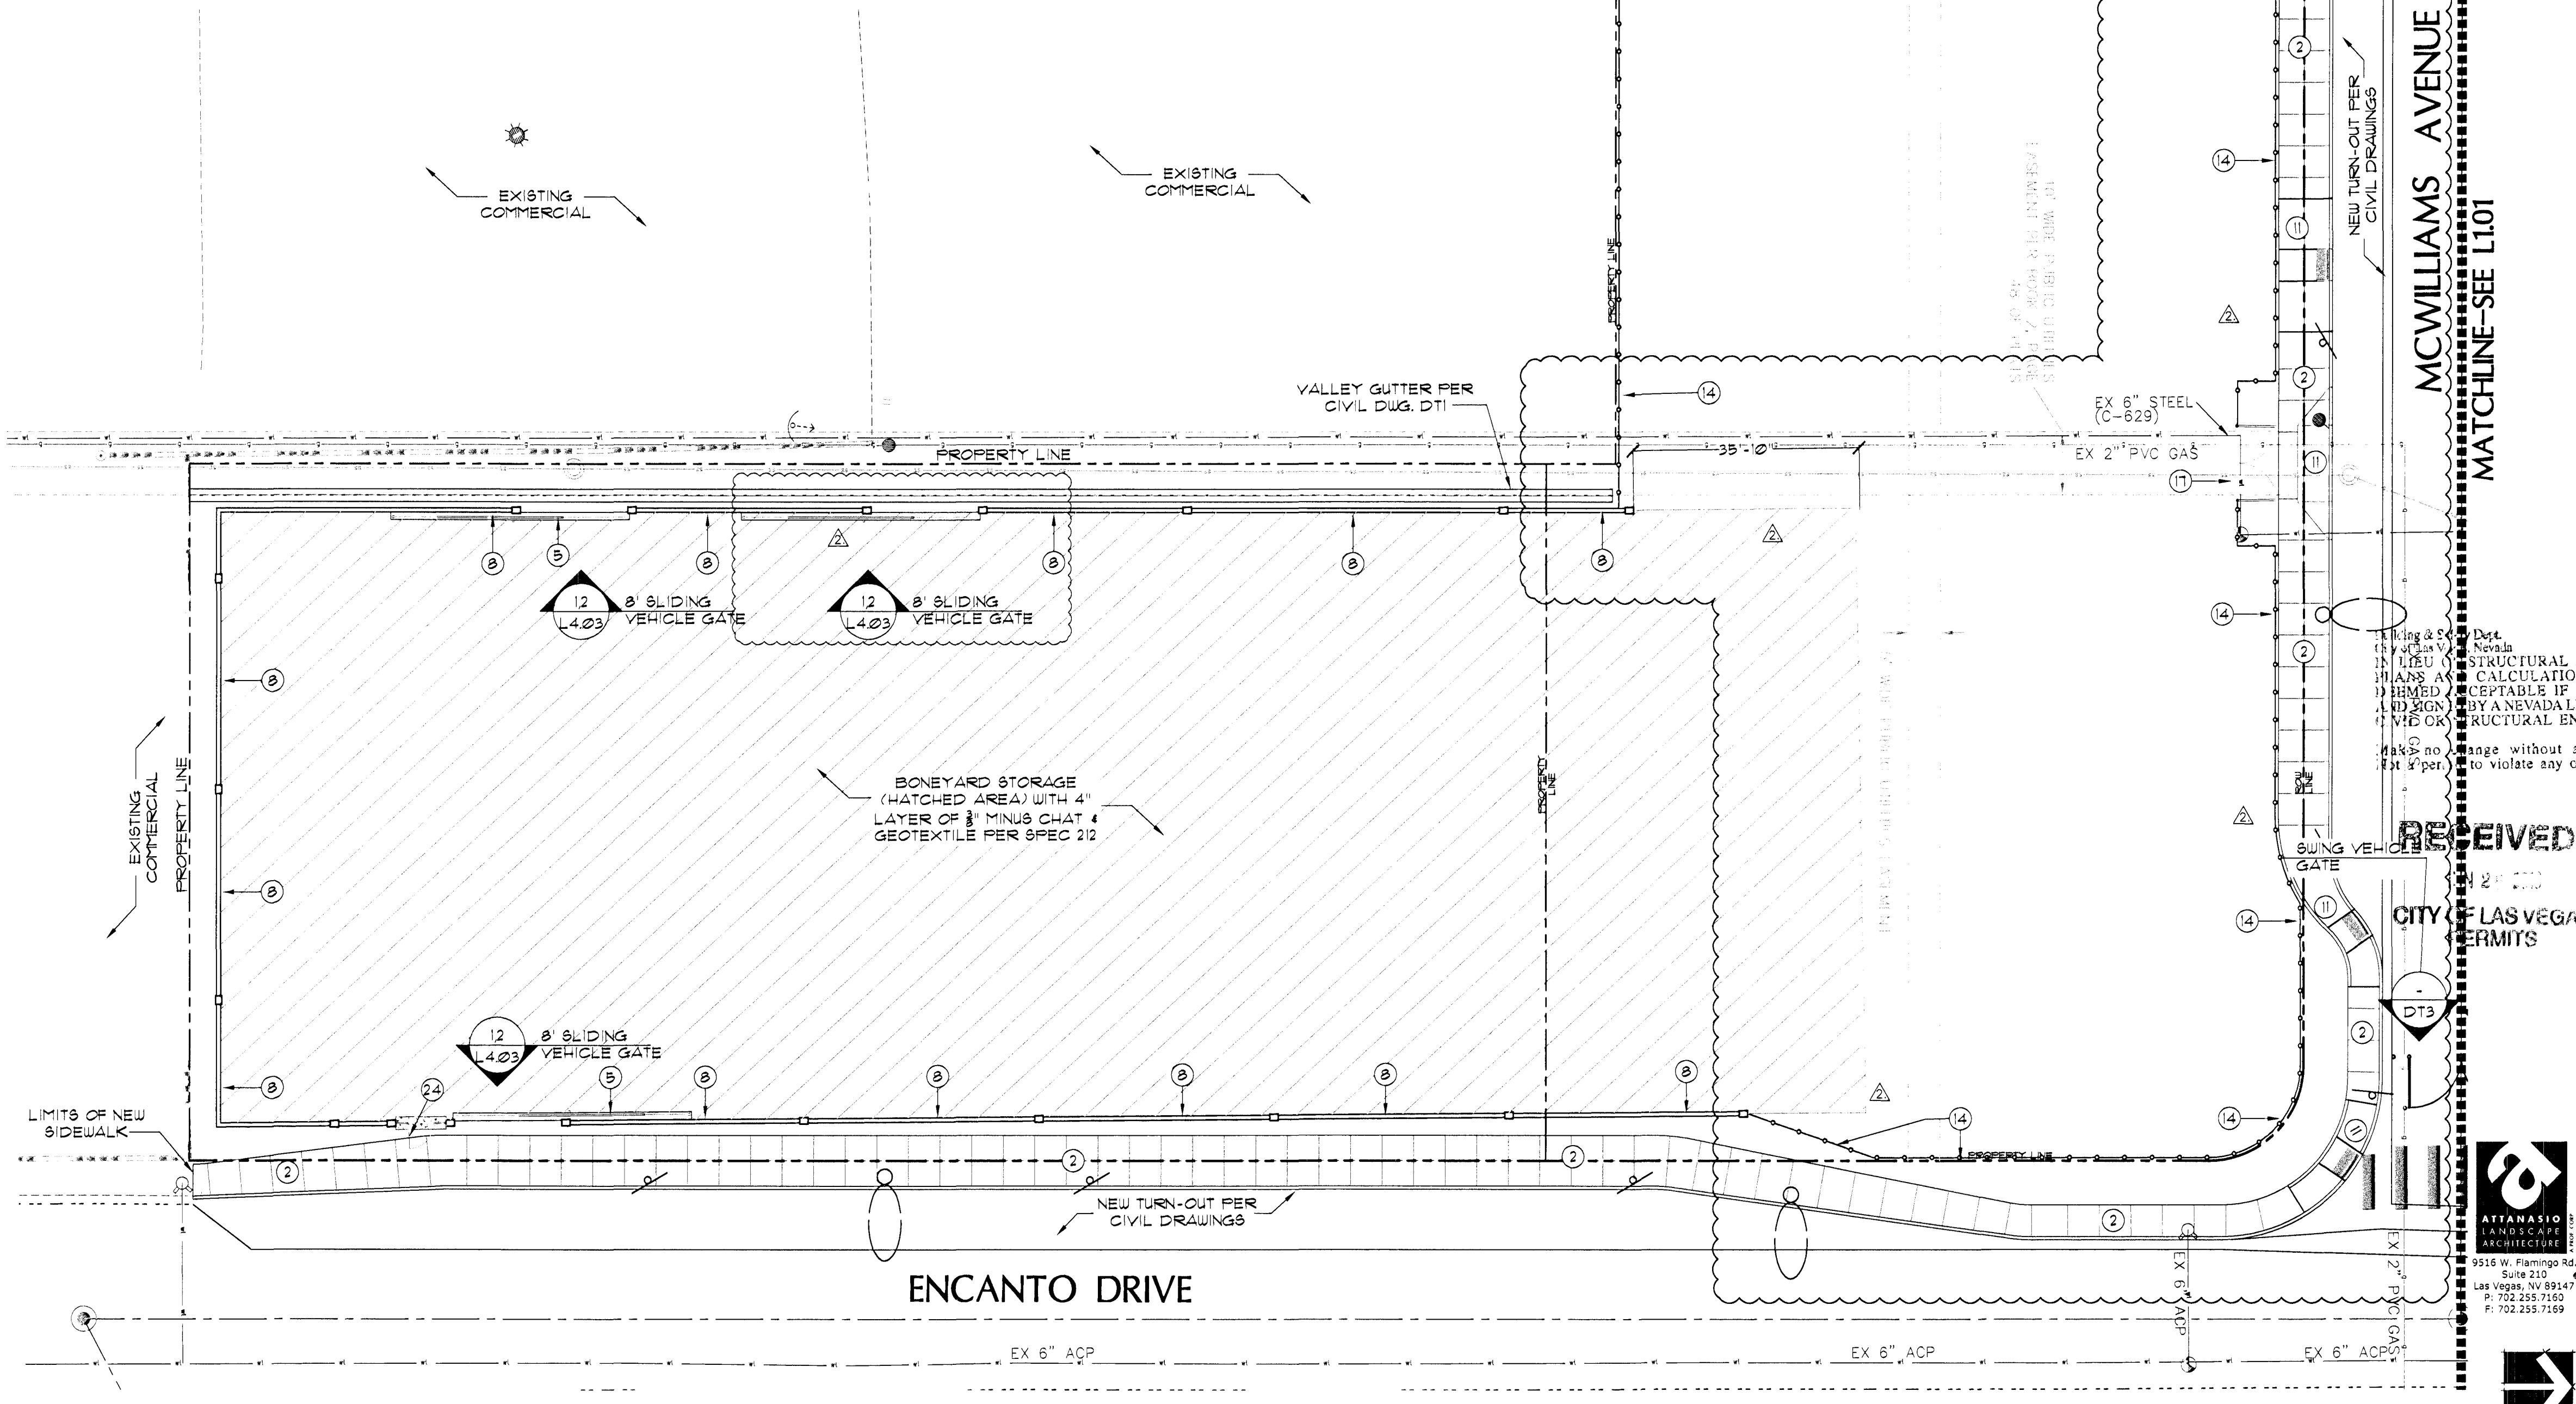


LANDSCAPE CONSTRUCTION LEGEND

1. COLORED CONCRETE SIDEWALK (COLOR HARDENER: BRICKFORM ANTIQUE ROSE 1020 OR EQUAL WITH ACID ETCH FINISH AND MATTE SEALER-SEE CIVIL DUGS FOR ADDITIONAL INFORMATION. PROVIDE A 3' SQ. MOCKUP FOR REVIEW AND APPROVAL.)	20. RESTORE AND REPAIR CASHMAN LANDSCAPING, IRRIGATION AND ROCK FROM CONSTRUCTION ACTIVITIES
2. CONCRETE SIDEWALK SEE CIVIL DRAWINGS FOR ADDITIONAL INFORMATION	21. CONCRETE BENCH PER: QUICKCRETE MODEL: WAVE 2214VETB P311 SEALER, BOARDBUSTERS, AND ANCHOR BOLTS INSTALL PER MFR. RECOMMENDATIONS TOTAL QTY: 4
3. 8' DECORATIVE PEDESTRIAN GATE (SEE SHEET L4.01, DETAIL 13)	22. CONCRETE FRONT TABLE: QUICKCRETE MODEL: QUEL511 BELCONTE TABLE COLOR: P3 TEXTURE: T1 WITH SEALER AND ANCHOR BOLTS INSTALL PER MFR. RECOMMENDATIONS TOTAL TABLES QTY: 10 TOTAL CHAIR QTY: 18
4. 4' SLIDING VEHICLE GATE (SEE SHEET L4.03, DETAIL 3.4)	23. STANDARD TRASH RECEPTACLE MFR: QUICKCRETE MODEL: QR-MT2136U P311 SEALER BLACK LID AND LINER
5. 8' SLIDING VEHICLE GATE (SEE SHEET L4.03, DETAIL 1, 2)	24. 4' PEDESTRIAN EGRESS GATE (SEE SHEET L4.03, DETAIL 2)
6. LOW CMU WALL 4' TUBULAR STEEL FENCE (SEE SHEET L4.01 DETAIL 1 4 SHEET 56 DETAIL 1)	25. 8' PEDESTRIAN EGRESS GATE (SEE SHEET L4.03, DETAIL 1)
7. LOW CMU WALL (SEE SHEET L4.02, DETAIL 2)	26. NOT USED
8. 8' CMU WALL (SEE SHEET L4.02, DETAIL 3 4 SHEET 54 DETAIL 20)	27. CMU RETAINING WALL 4' TUBULAR STEEL FENCE (SEE SHEET L4.01, DETAIL 1 4 SHEET L4.02 DETAIL 1)
9. COLORED CONCRETE SLAB (COLOR HARDENER: BRICKFORM ANTIQUE ROSE 1020 OR EQUAL WITH ACID ETCH FINISH AND MATTE SEALER (SEE SHEET 52 DETAIL 2 FOR INFORMATION))	28. BIKE RACK PER SPEC SECTION 212
10. CONCRETE MONUMENT AND PLAQUE (SEE SHEET TY) DETAILS 3.4-3.5 AND SPEC SECTION 502 FOR INFORMATION)	29. 8' CMU RETAINING WALL (SEE SHEET L4.02, DETAIL 4.5 4 SHEET 56 DETAIL 3, 10)
11. HANDICAP RAMP PER CIVIL DRAWINGS	
12. DECORATIVE CMU SCREEN WALL (SEE SHEET L4.02, DETAIL 6, 7, 8 4 SHEET 51 DETAIL 2)	
13. COLORED CONCRETE STAGE/STEPS (COLOR HARDENER: BRICKFORM BLUSH BEIGE 1015 FINISH: MED. BROOM SEALED) PROVIDE A 3' SQ. MOCKUP FOR REVIEW AND APPROVAL.	
14. 6' HT PERMANENT CHAINLINK FENCE (SEE DETAILS 3.4 AND 5 ON SHEET L4.03)	
15. VERTICAL SIGN PYLON FOR VERTICAL LED SIGN INSTALLATION	
16. SHADE STRUCTURE (SEE SHEET L4.04, DETAIL 123)	
17. 6' HT CHAINLINK DOUBLE GATE (SEE SHEET L4.03 DETAIL 6)	
18. CONCRETE MONUMENT FOR INTERPRETIVE SIGNAGE (SEE SPEC SECTION 502 FOR INFORMATION)	
19. 6' CHAINLINK FENCE (SEE DETAIL 3.4, AND 5 ON SHEET L4.03)	

NOTES:
 1. ALL WORK SHALL BE CONSTRUCTED IN ACCORDANCE WITH PROJECT DOCUMENTS AND SPECIFICATIONS.
 2. WHEN OBVIOUS DISCREPANCIES EXIST BETWEEN THE DRAWINGS AND THE FIELD THE CONTRACTOR SHALL CONTACT THE LANDSCAPE ARCHITECT IMMEDIATELY FOR RESOLUTION OF SAID CONFLICT.
 3. CONTRACTOR SHALL INSTALL ALL ON-GRADE CONCRETE SLABS IN ACCORDANCE WITH THE CIVIL ENGINEERING PLANS.
 4. CONTRACTOR SHALL INSTALL ALL WALLS AND PILASTERS PER STRUCTURAL DUGS AND DETAILS.
 5. CONTRACTOR SHALL COORDINATE ALL NECESSARY SLEEVES AND/OR CONDUIT FOR IRRIGATION DEVICES PRIOR TO HARDSCAPE CONSTRUCTION.

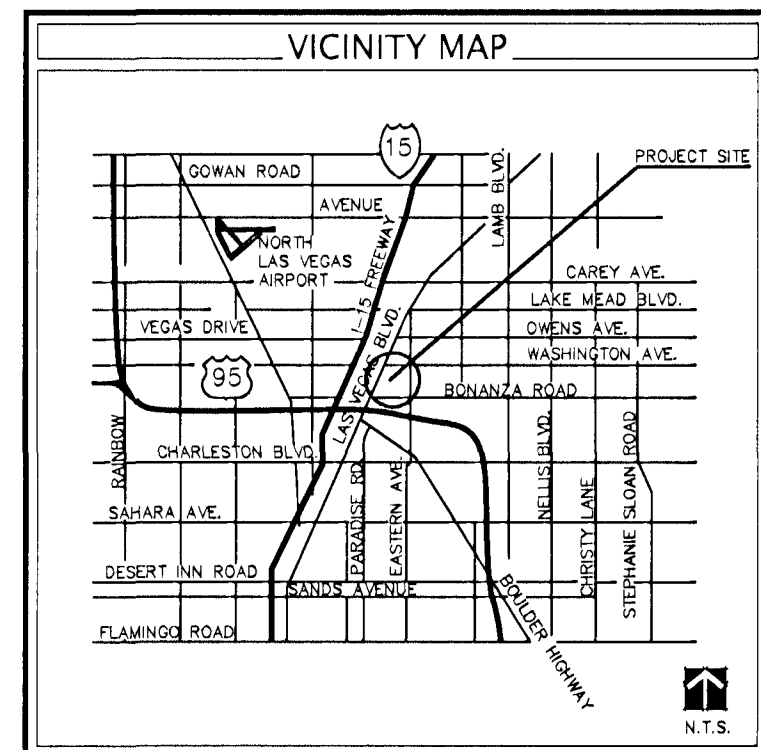

LAS VEGAS BLVD.

MCWILLIAMS AVENUE
MATCHLINE-SEE L1.01

RECEIVED

CITY OF LAS VEGAS
PERMITS



DEPARTMENT OF PUBLIC WORKS 400 EAST STEWART LAS VEGAS, NEVADA 89101 (702) 229-6276		poggemeyer design group, inc. 6960 Sunrise Ranch #110 - Las Vegas, NV 89128 • P: 702.255.8100 • F: 702.255.8375	
TITLE: NEON BONEYARD PARK CITY OF LAS VEGAS		SHEET: LANDSCAPE CONSTRUCTION PLAN	
DRAWN BY: RSN, SM/KC	DESIGNED BY: CNA	CHECKED BY: CNA	SCALE: 06'-01/45
PROJECT NO: 06-0145		SHEET L1.02 26 of 37 CLV DRAWING NO. 676-12	