



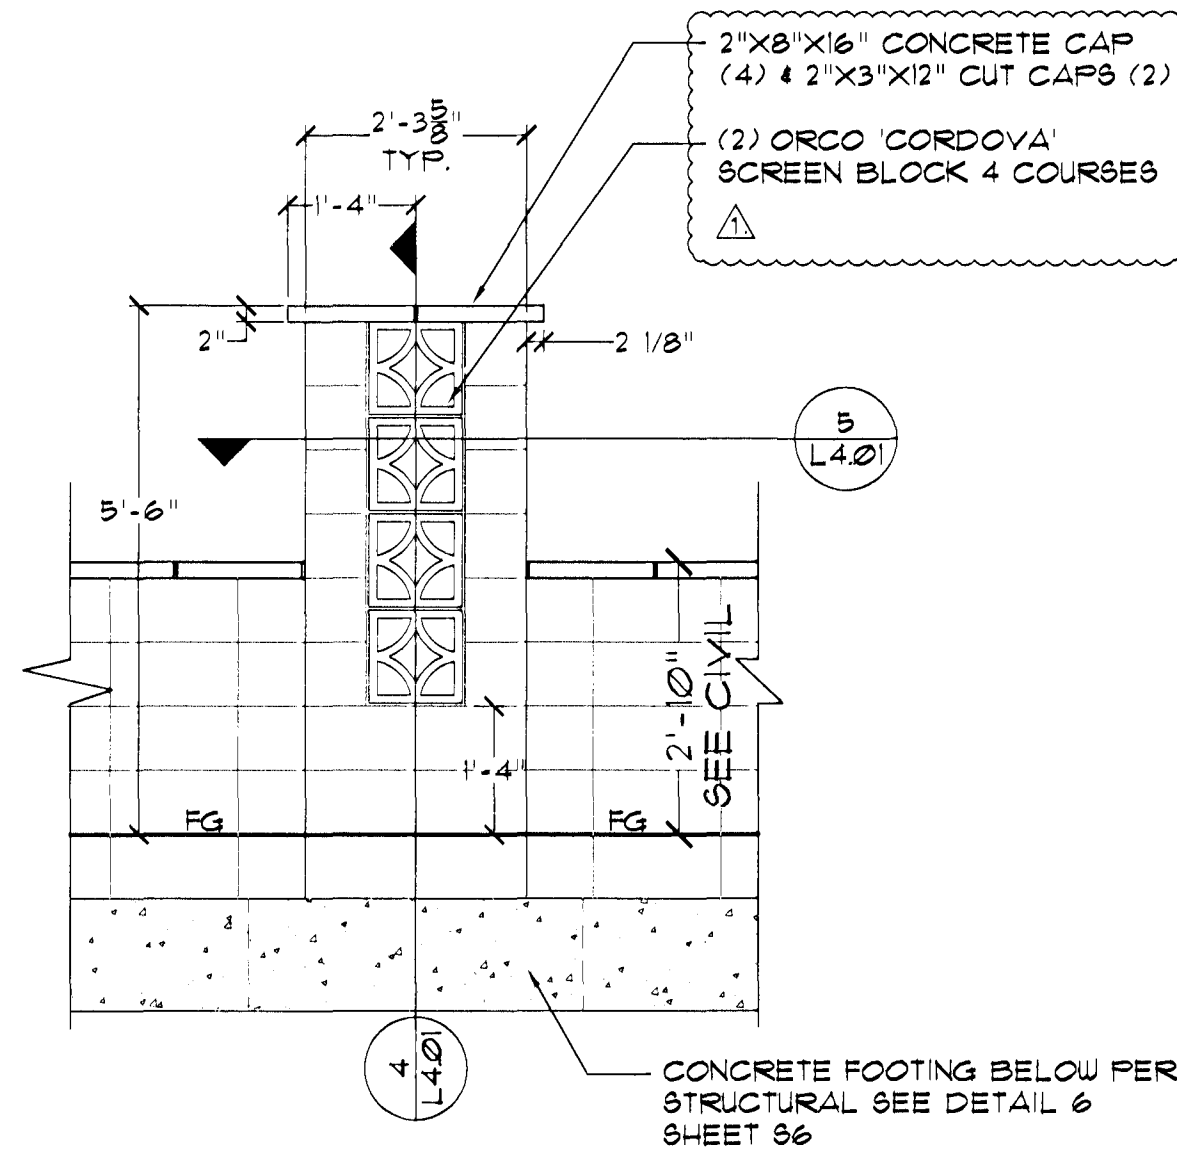


3 LOW PILASTER TYPICAL ELEVATION
SCALE: 1/2"=1'-0"

SHOP DRAWING REQUIRED FOR ALL HSS ELEMENTS


TUBE STEEL/CMU NOTES:
1. ALL WELDS SHALL BE GRIND SMOOTH AND REMOVE ALL BURRS.
2. CONTRACTOR SHALL PROVIDE COMPLETE ENGINEERED SHOP DRAWINGS WITH DETAILS AND STEEL SPECS.
3. ALL FENCING HSS AND MESH SHALL BE PAINTED PER SPEC SECTION 614. COLOR: VISTA SPANISH BROWN 66.
4. CONTRACTOR SHALL PAINT ALL CMU BLOCK WITH PAINT PER SECTION 614. COLOR SHALL BE VISTA SAVANA OAKS 8468.

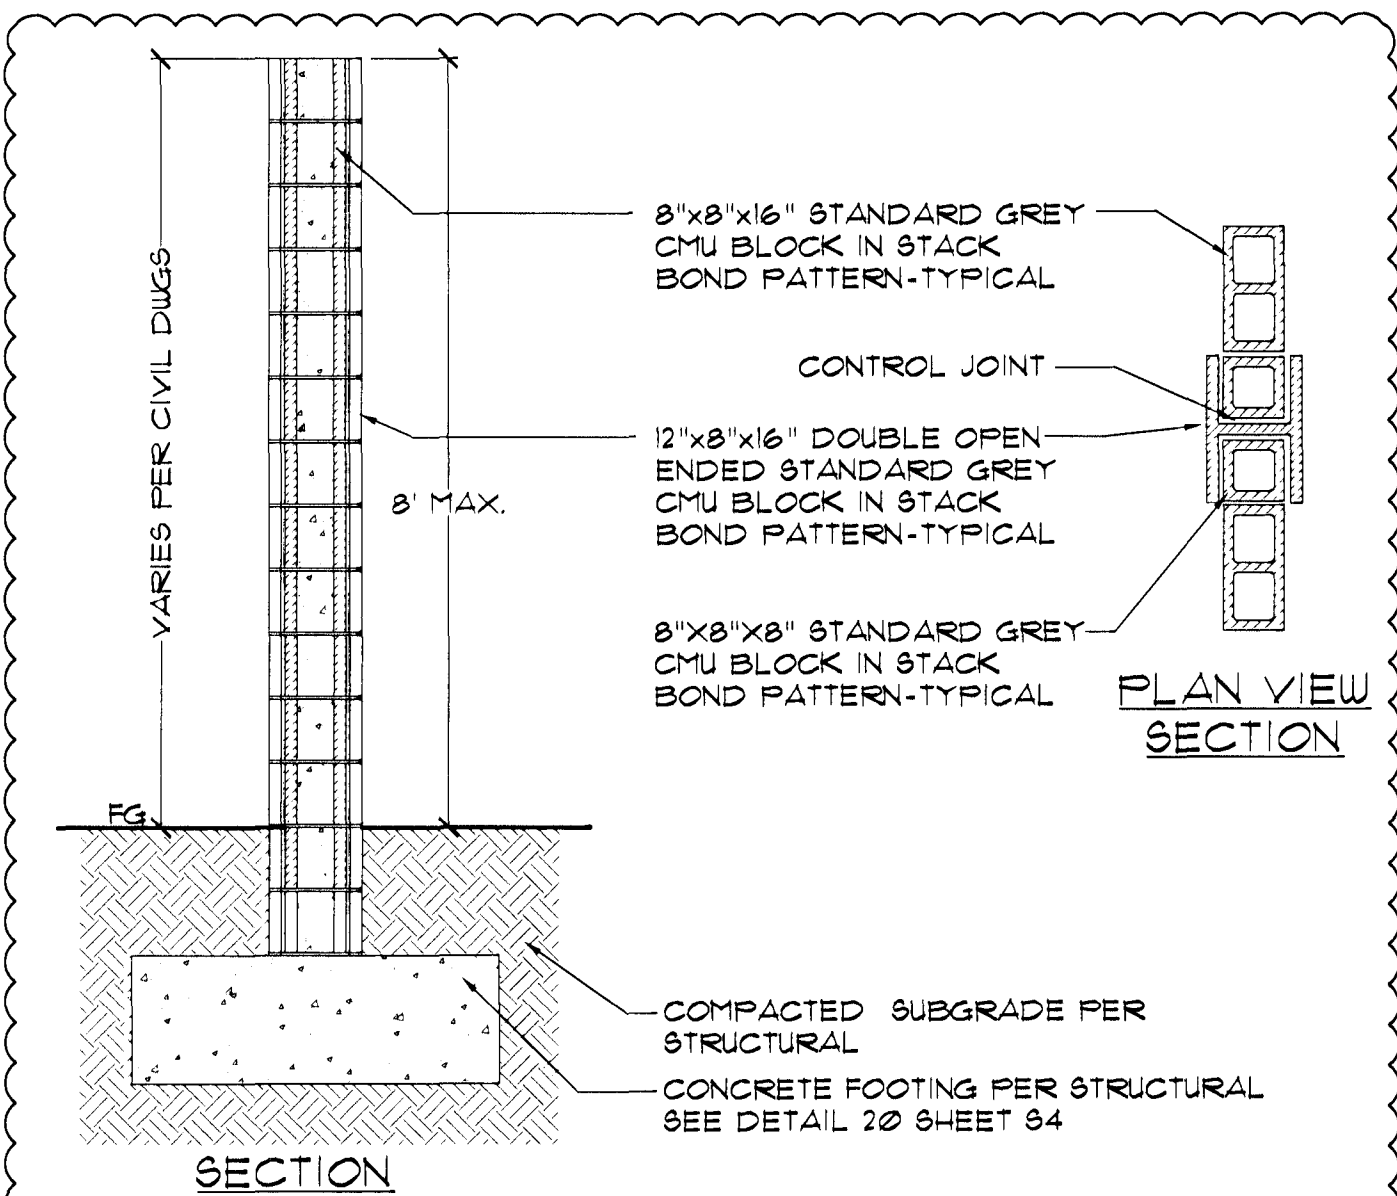


9 CMU WALL SECTION
SCALE: 1/2"=1'-0"

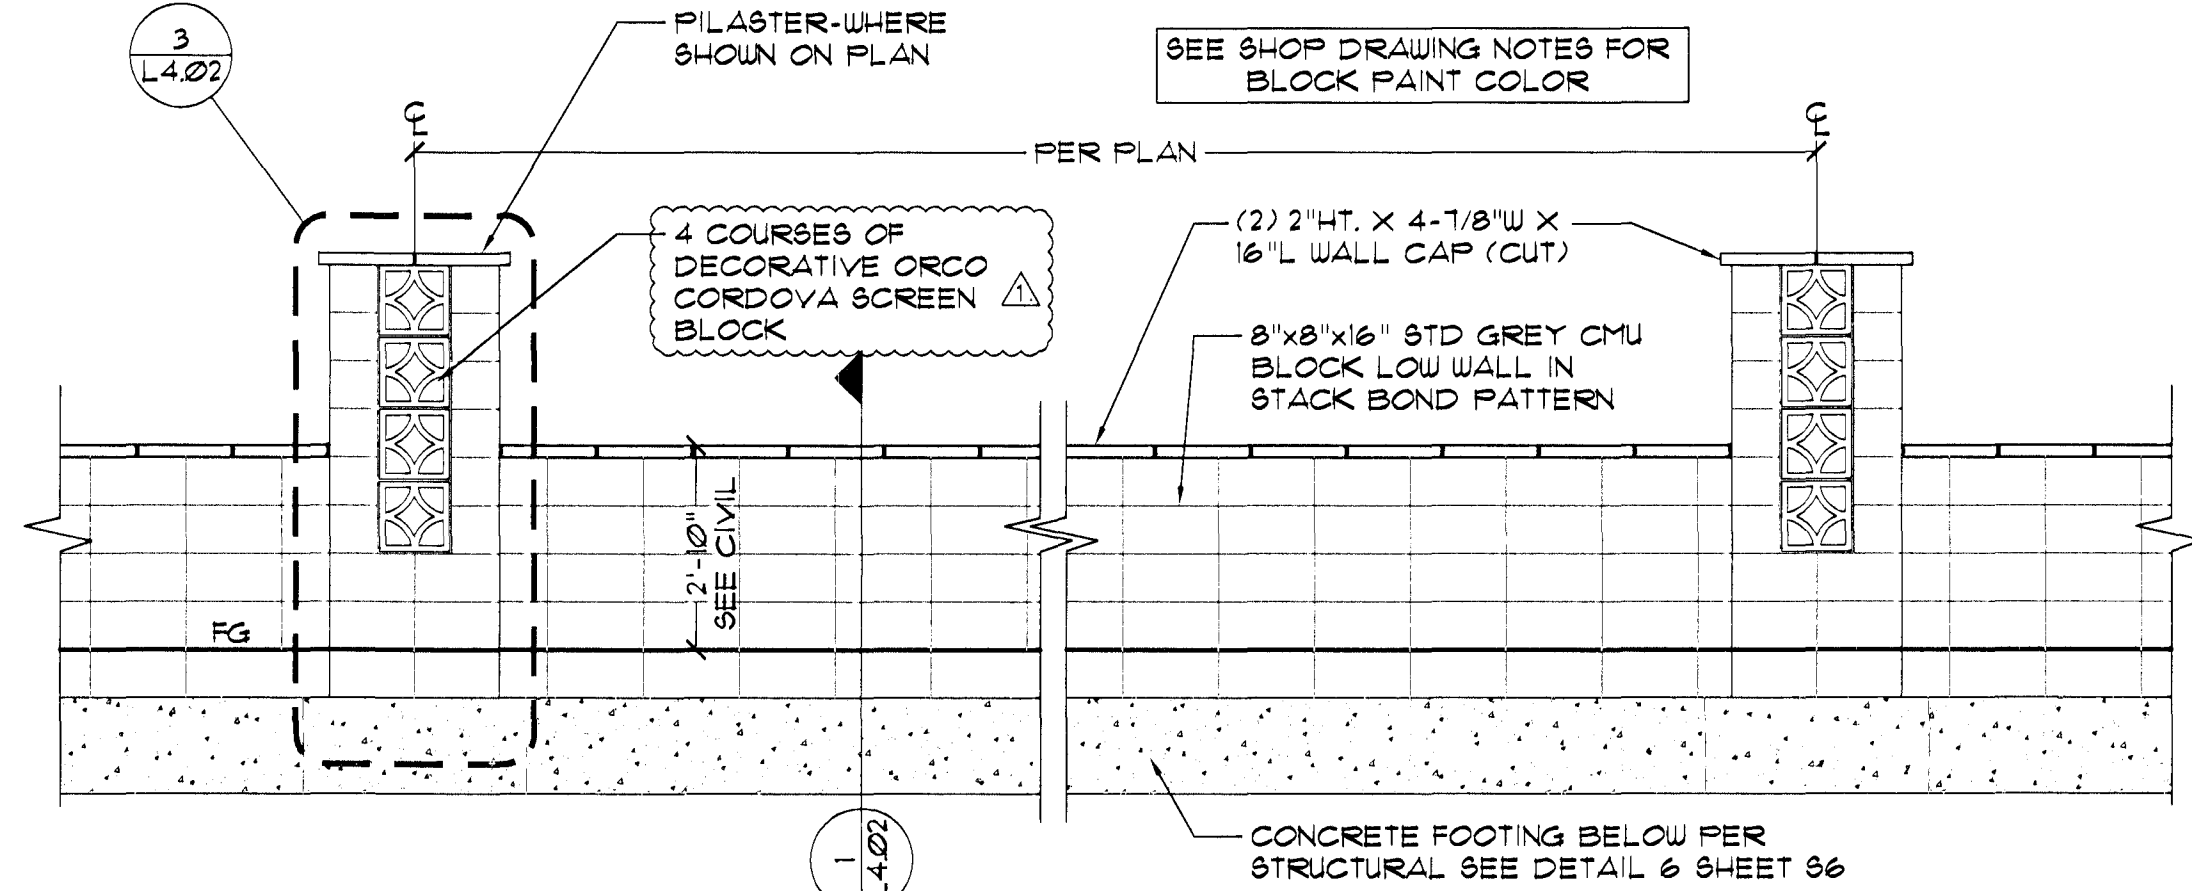


2 LOW CMU WALL TYPICAL ELEVATION
SCALE: 3/8"=1'-0"

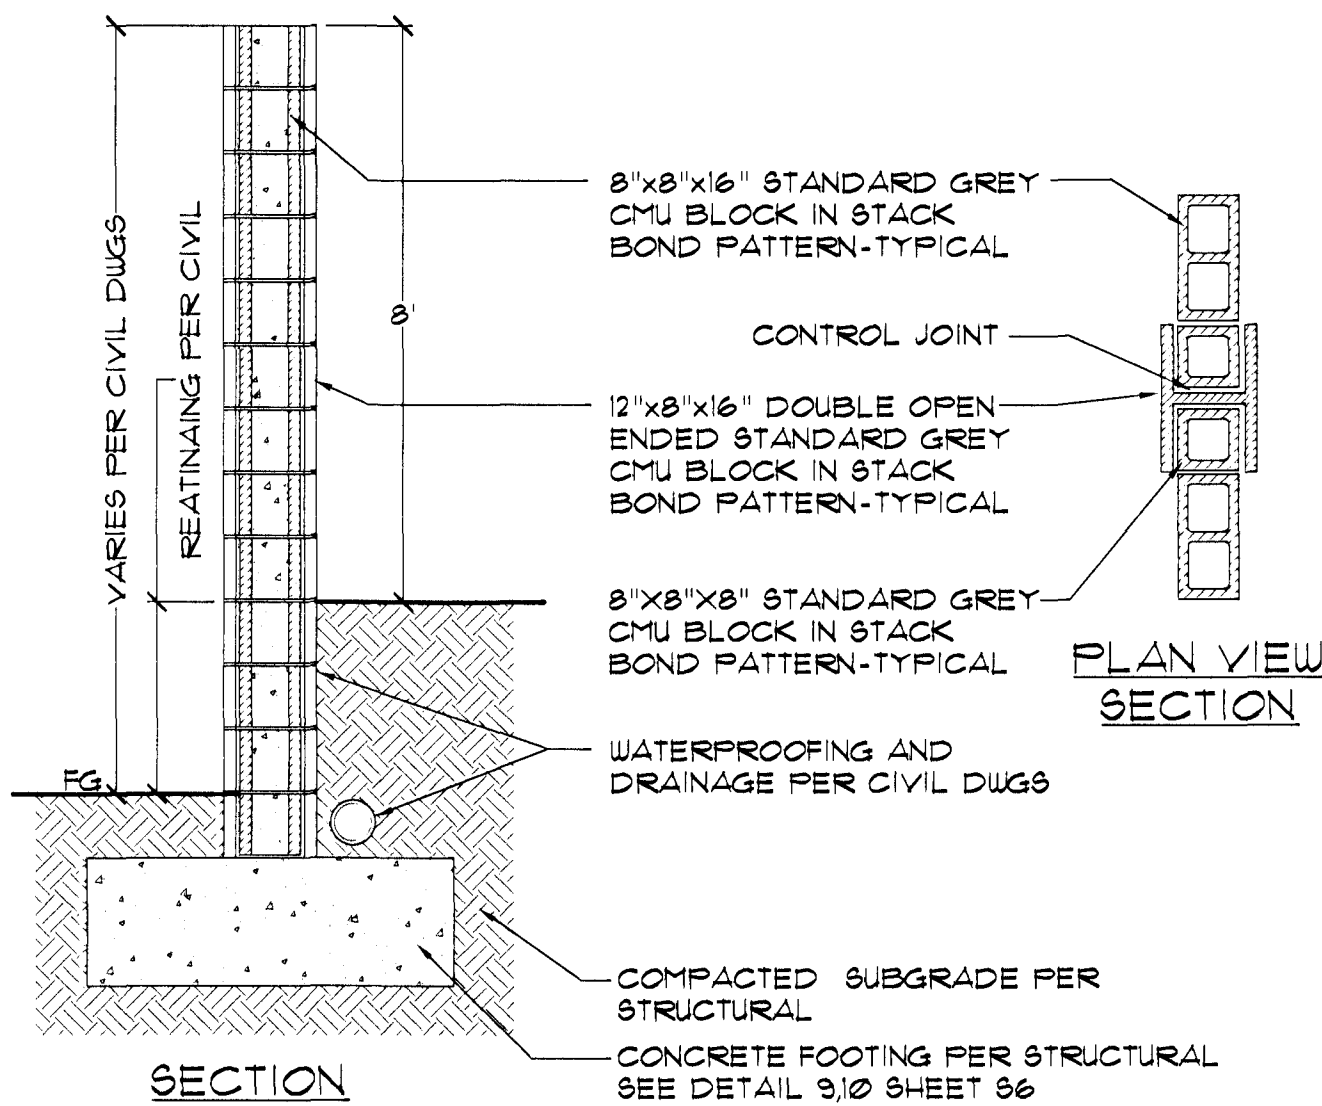


5 8' HEIGHT CMU BLOCK WALL TYPICAL SECTION
SCALE: 1/2"=1'-0"

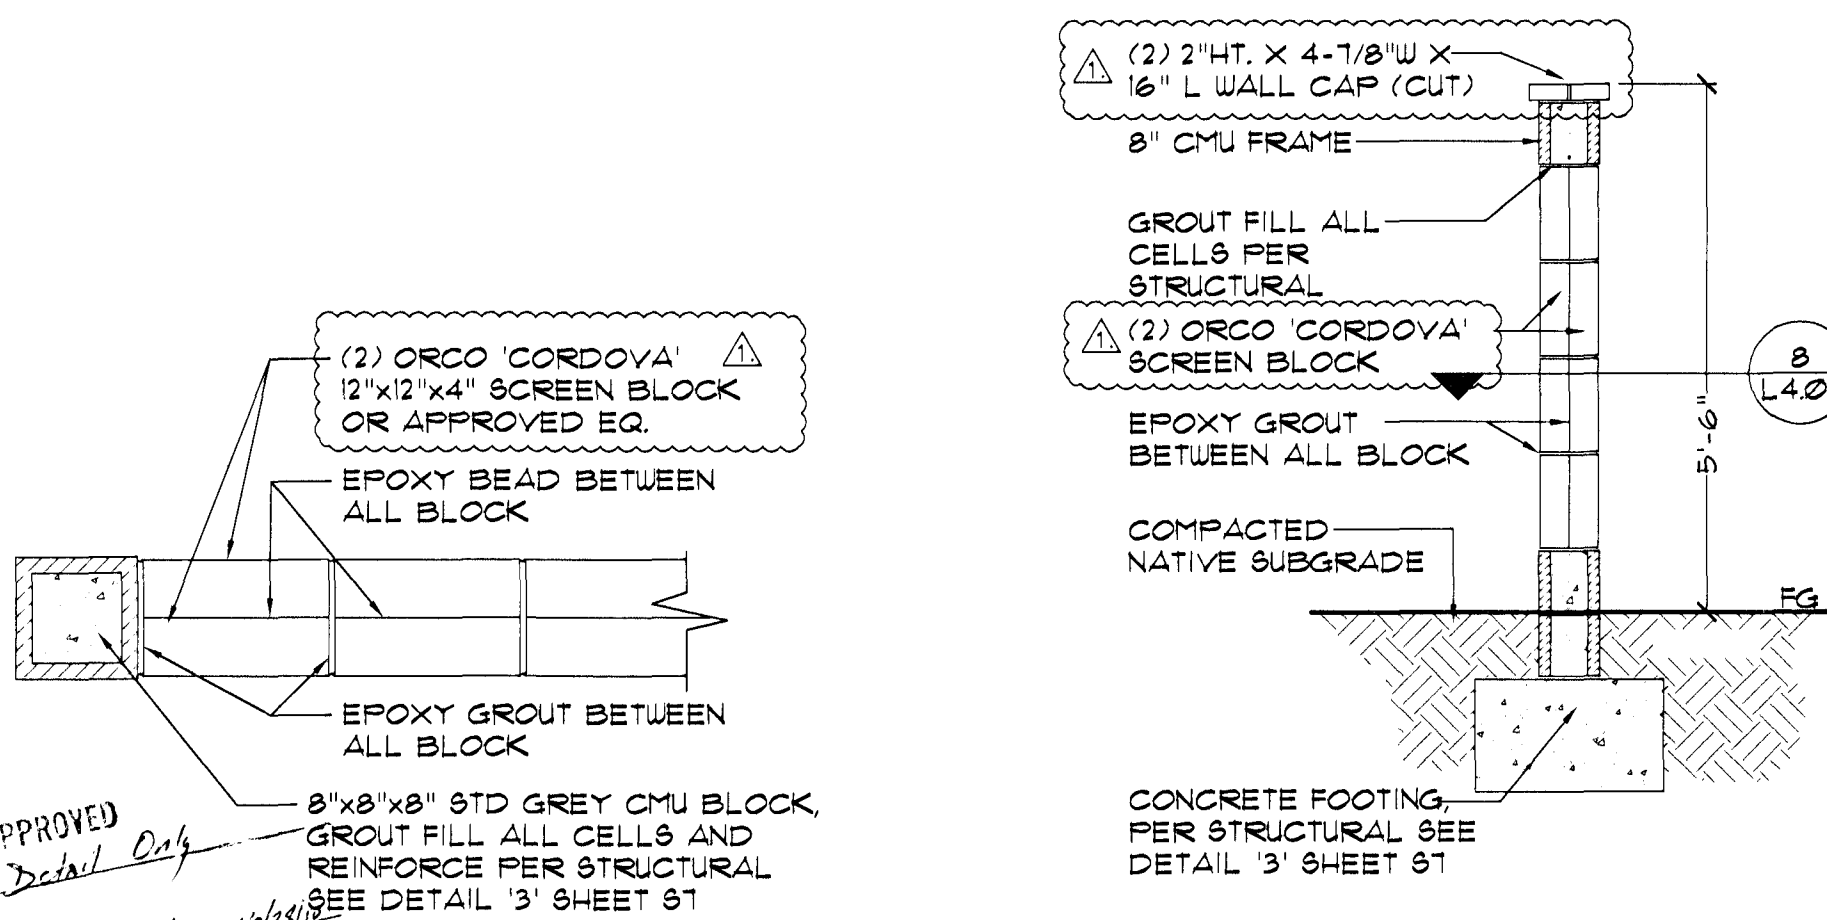


8 SCREEN WALL TYP. SECTION
SCALE: 1"=1'-0"

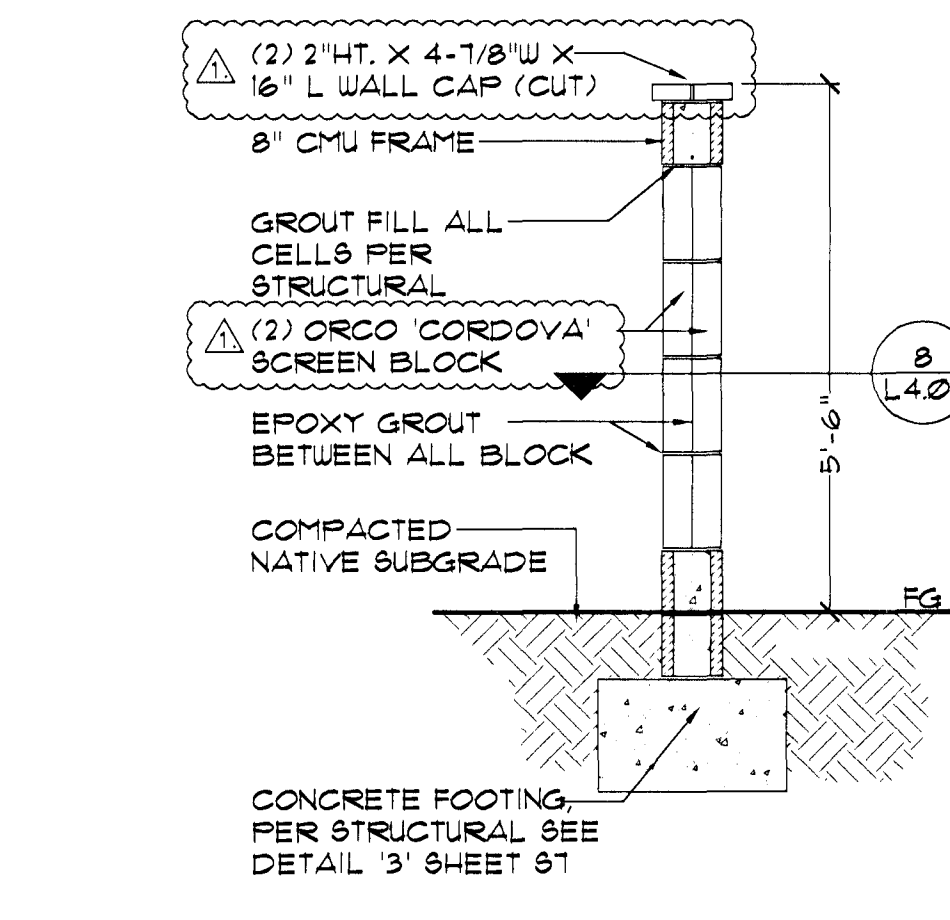


7 SCREEN WALL TYP. SECTION
SCALE: 1/2"=1'-0"

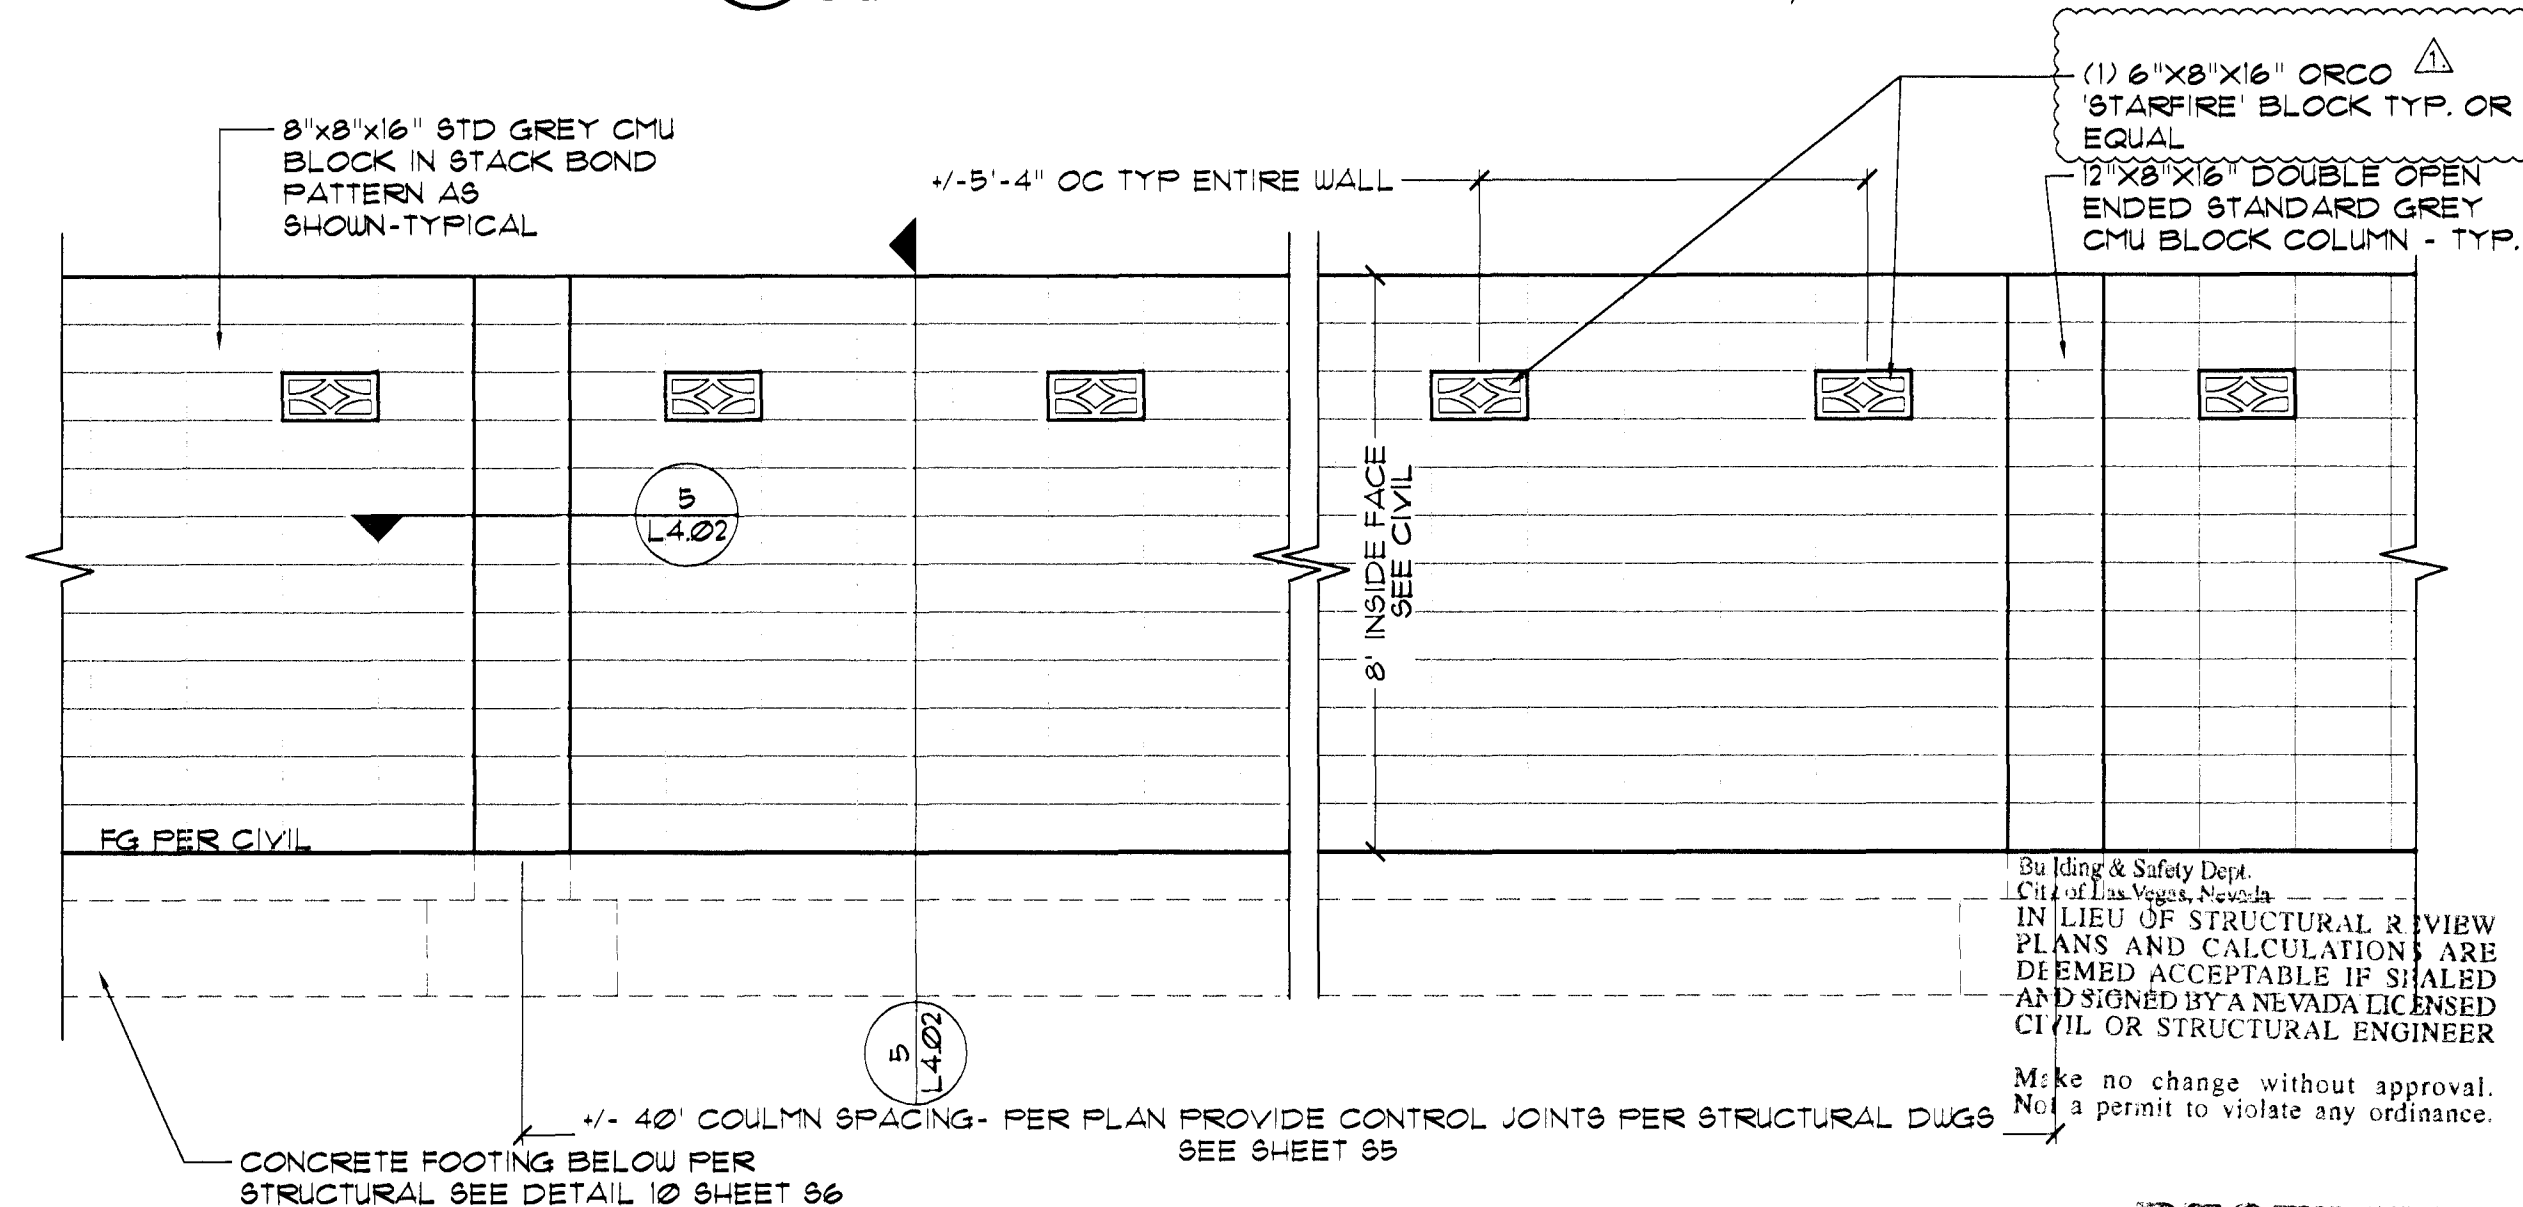

4 8' HEIGHT CMU BLOCK WALL TYPICAL ELEVATION
SCALE: 3/8"=1'-0"


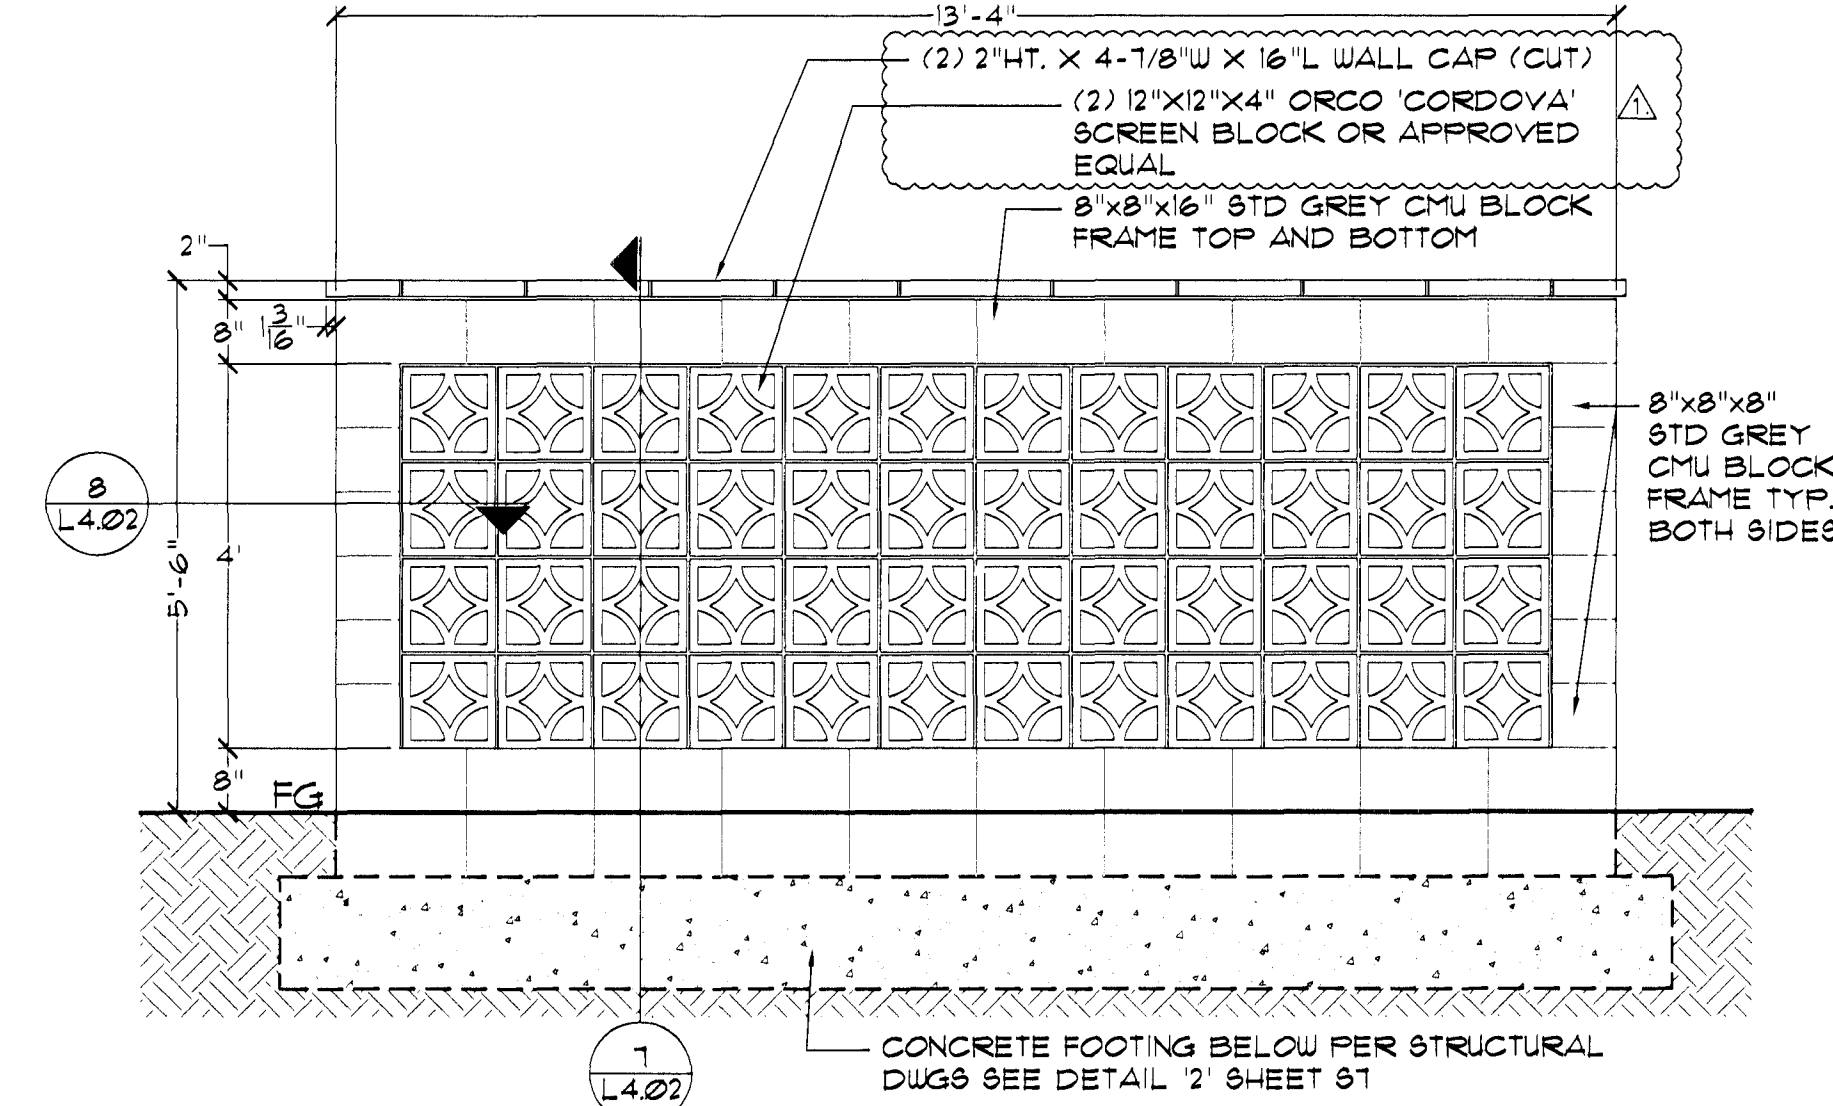


6 SCREEN WALL TYPICAL ELEVATION
SCALE: 1/2"=1'-0"

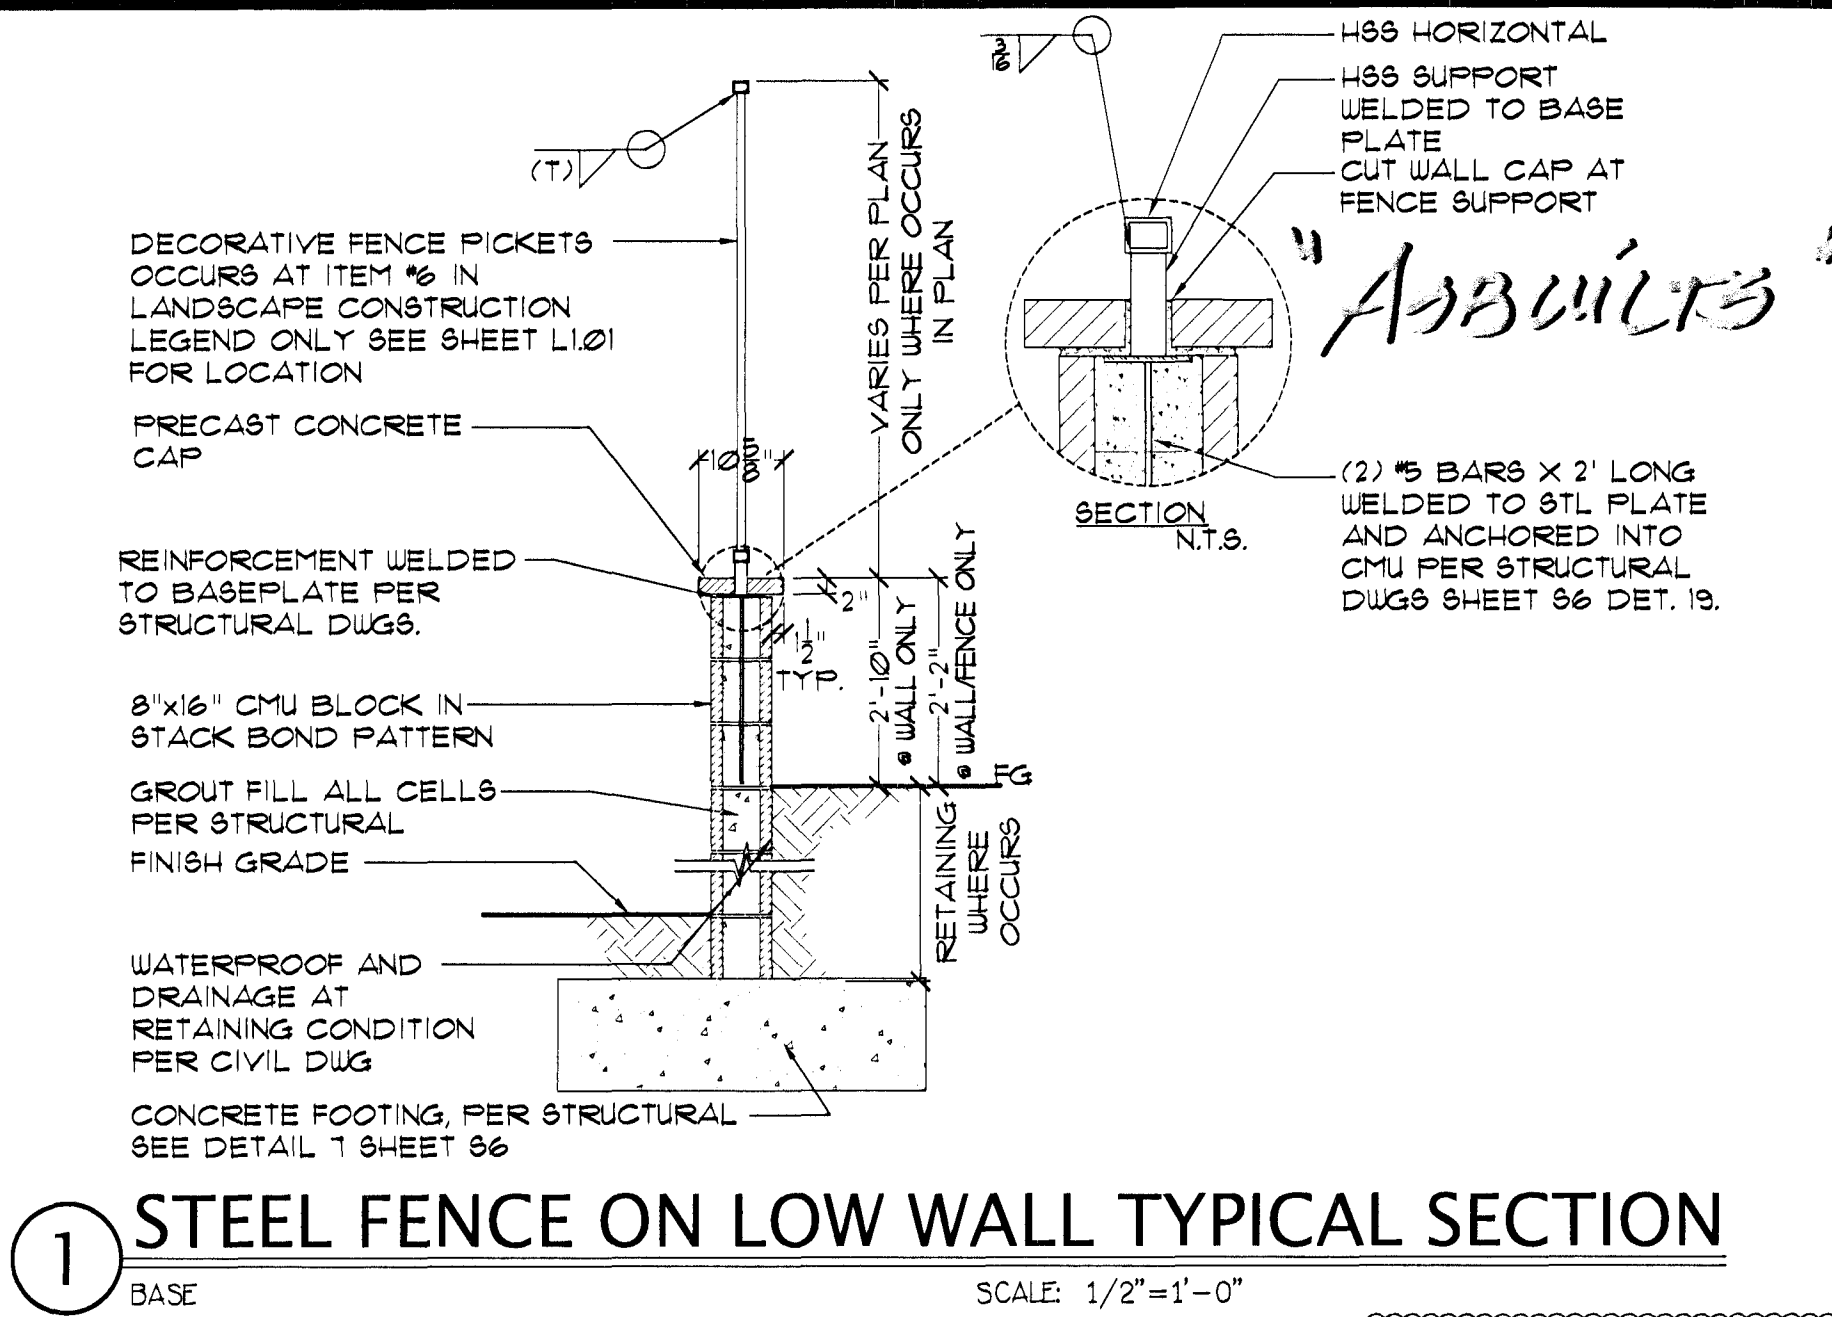

1 STEEL FENCE ON LOW WALL TYPICAL SECTION
SCALE: 1/2"=1'-0"

RECEIVED
JUN 2 2010
CITY OF LAS VEGAS PERMITS

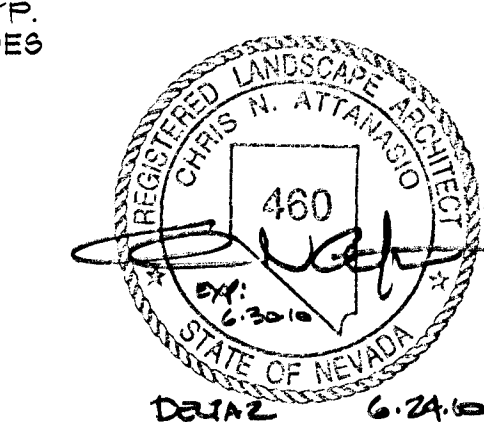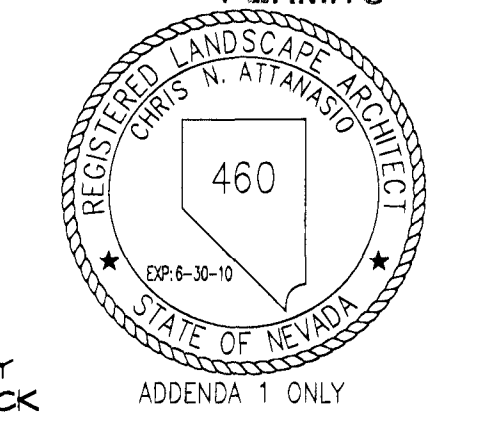

DEPARTMENT OF PUBLIC WORKS 400 EAST STEWART LAS VEGAS, NEVADA 89101 (702) 229-6276															
NEON BONEYARD PARK CITY OF LAS VEGAS															
LANDSCAPE SITE DETAILS															
DRAWN BY: RSN,SM,KC DESIGNED BY: CNA, RB CHECKED BY: CNA, RB PROJECT NO: 06-0145		SHEET: L4.02 SCALE: 30 of 37 CLV DRAWING NO. 676-12													
REVISIONS <table border="1"> <thead> <tr> <th>NO.</th> <th>DATE</th> <th>DESCRIPTION</th> <th>APP'D</th> </tr> </thead> <tbody> <tr> <td>1</td> <td>10-27-09</td> <td>ADDENDA #1</td> <td></td> </tr> <tr> <td>2</td> <td>06-23-10</td> <td>GENERAL REVISION ADDED DETAIL</td> <td></td> </tr> </tbody> </table>		NO.	DATE	DESCRIPTION	APP'D	1	10-27-09	ADDENDA #1		2	06-23-10	GENERAL REVISION ADDED DETAIL		Sheet L4.02 30 of 37 CLV DRAWING NO. 676-12	
NO.	DATE	DESCRIPTION	APP'D												
1	10-27-09	ADDENDA #1													
2	06-23-10	GENERAL REVISION ADDED DETAIL													

poggemeyer
design group, inc.
6860 Smoke Ranch #10 • Las Vegas, NV 89128 • P: 702.255.0100 • F: 702.255.0379