

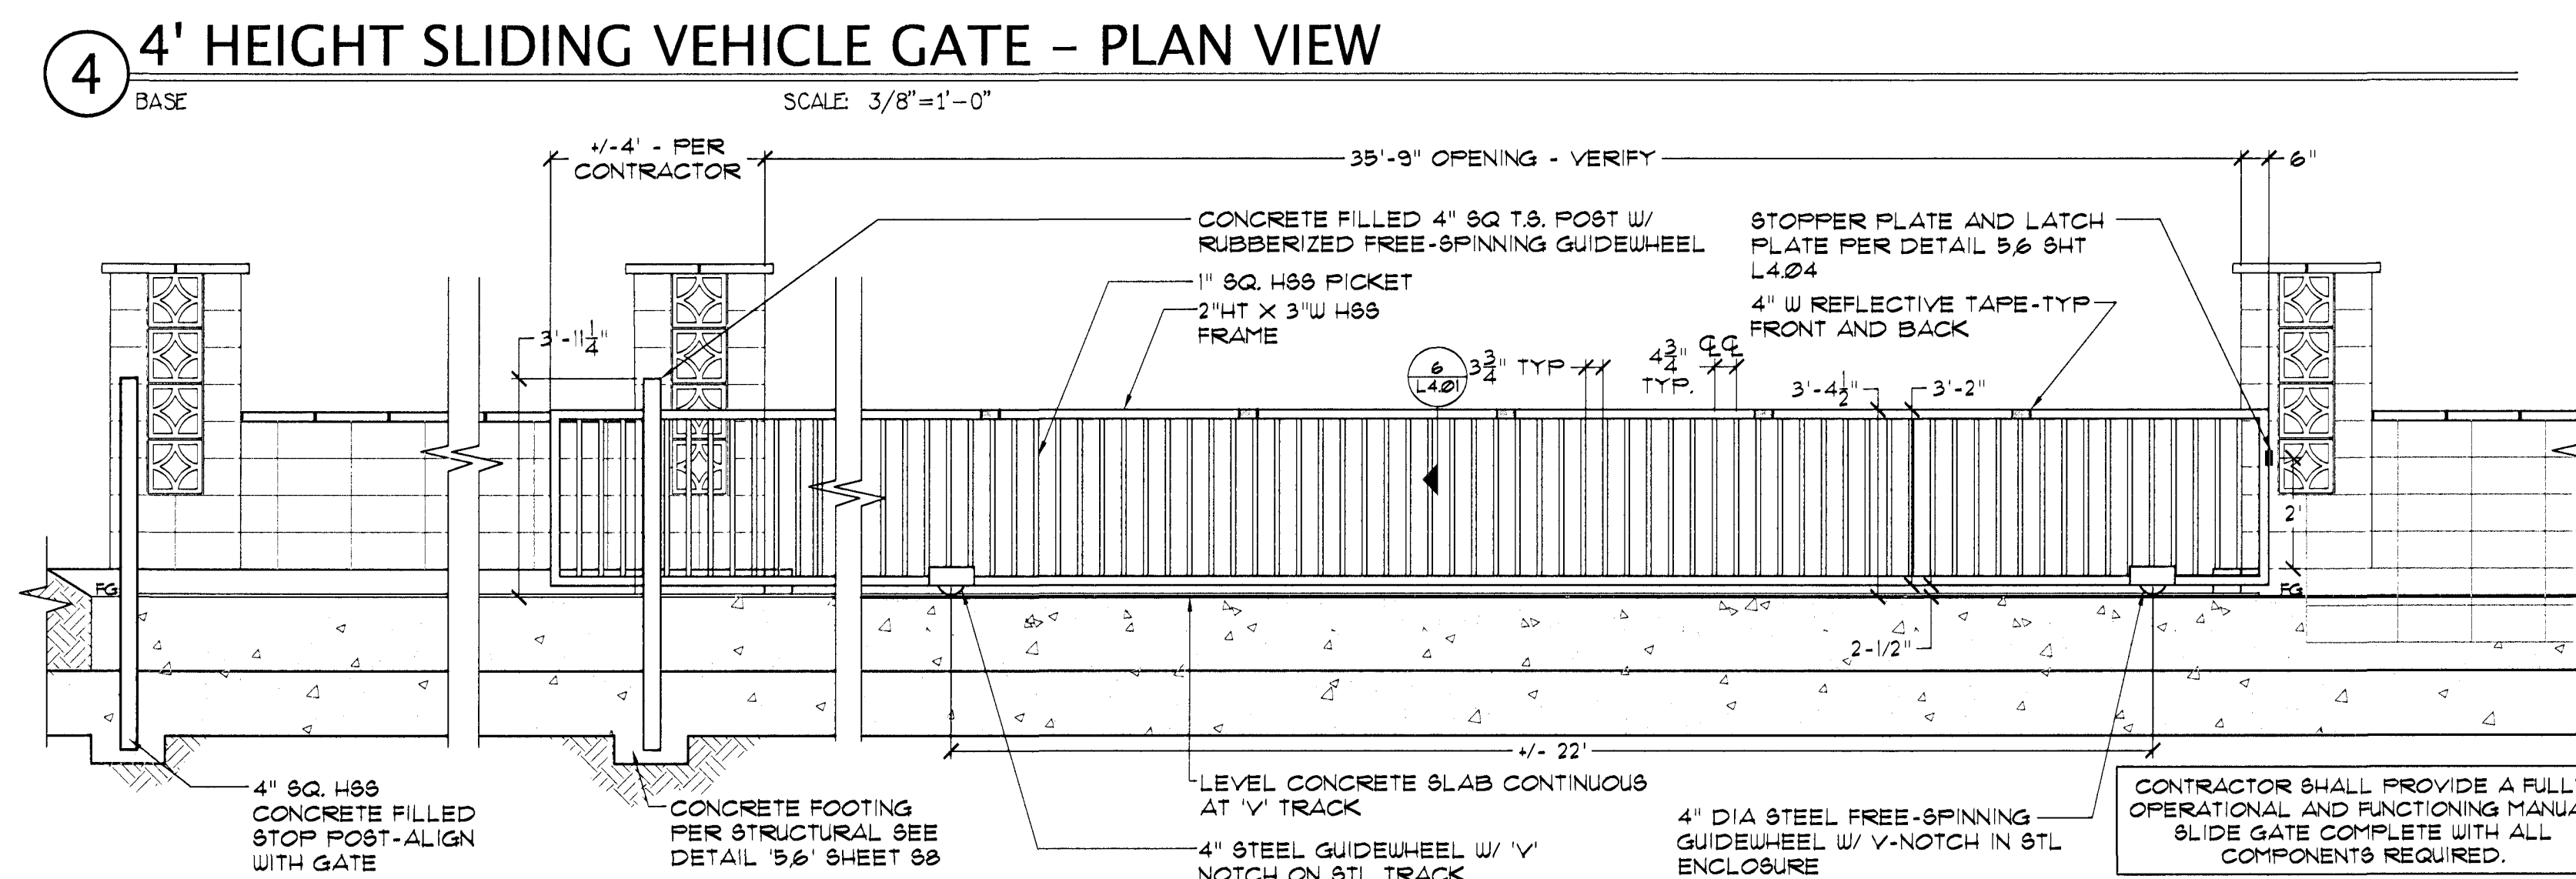
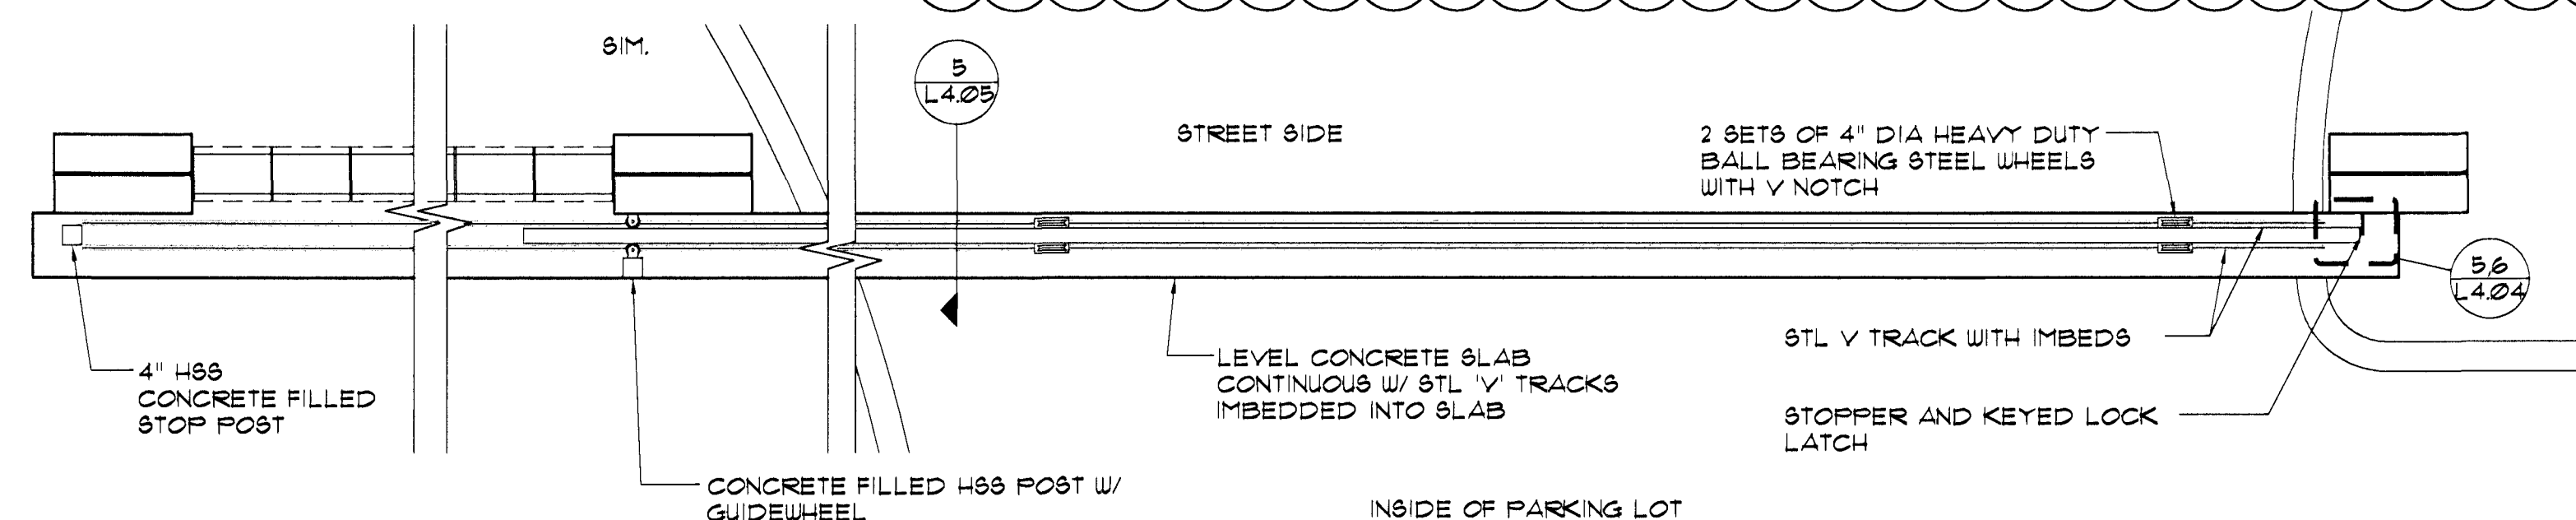
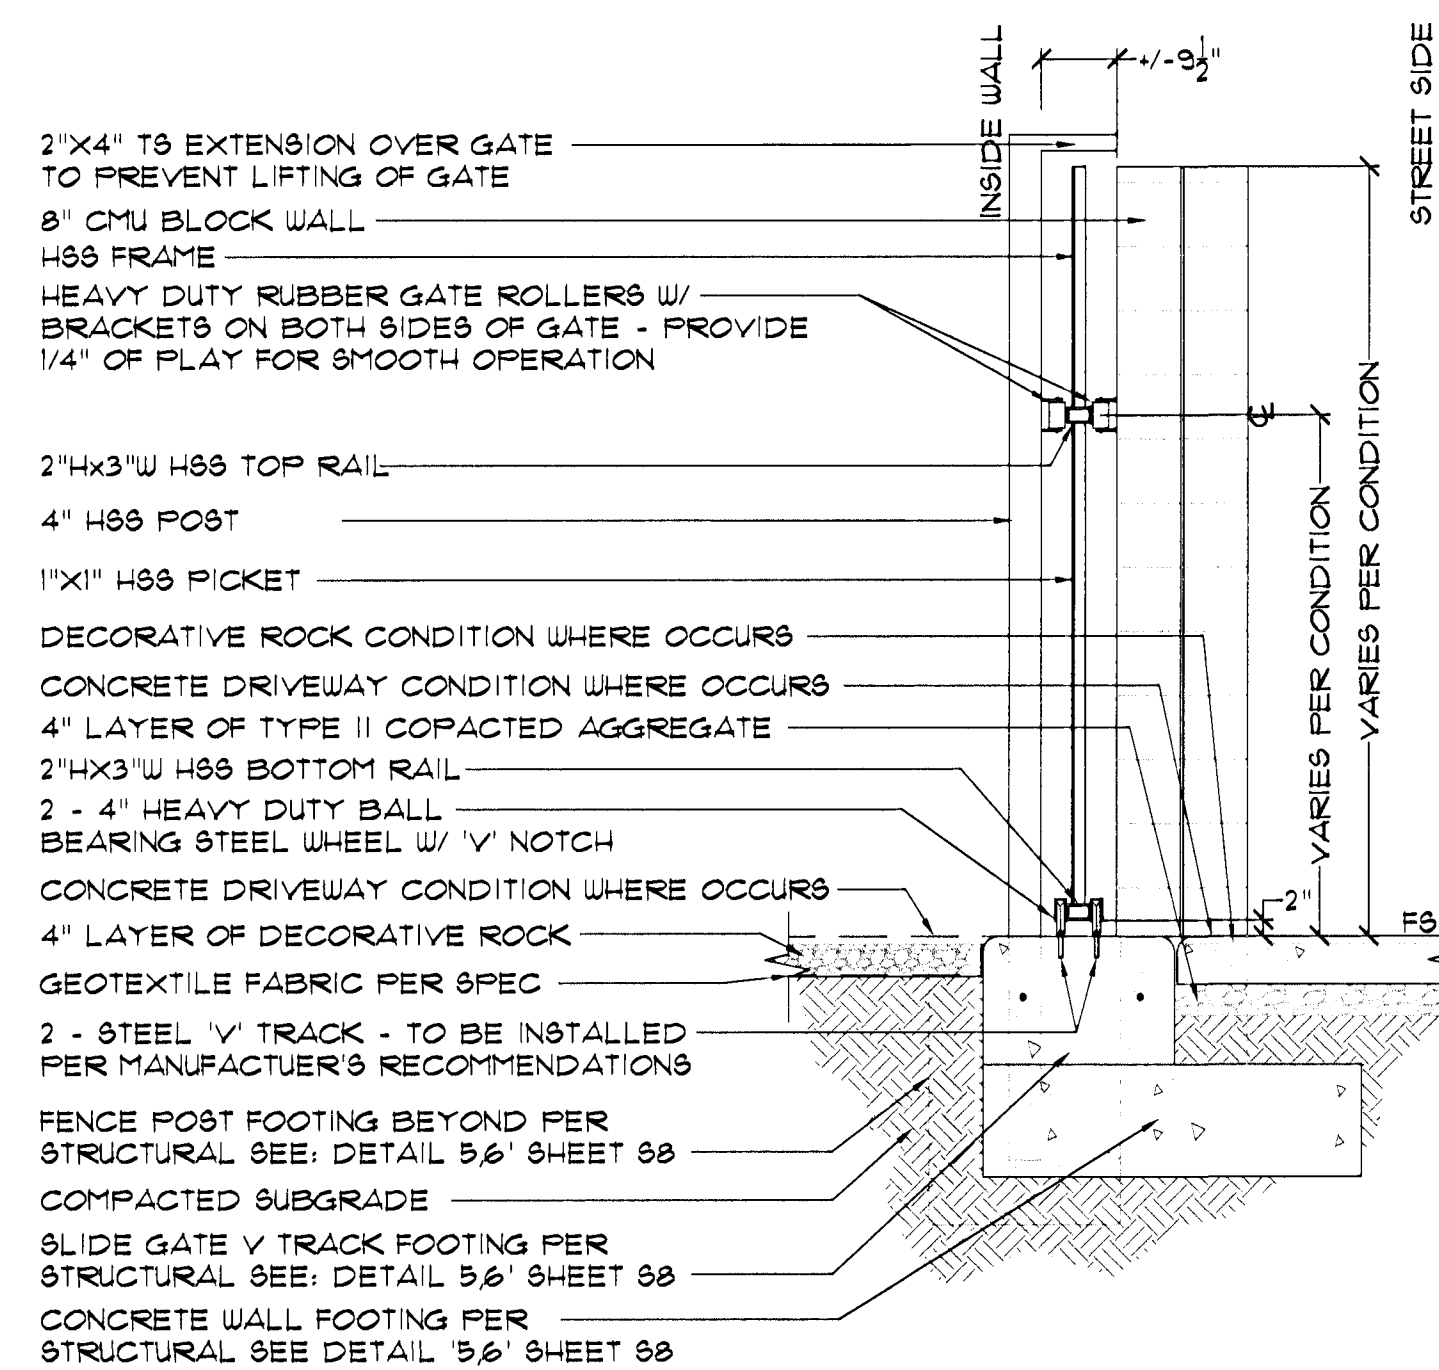
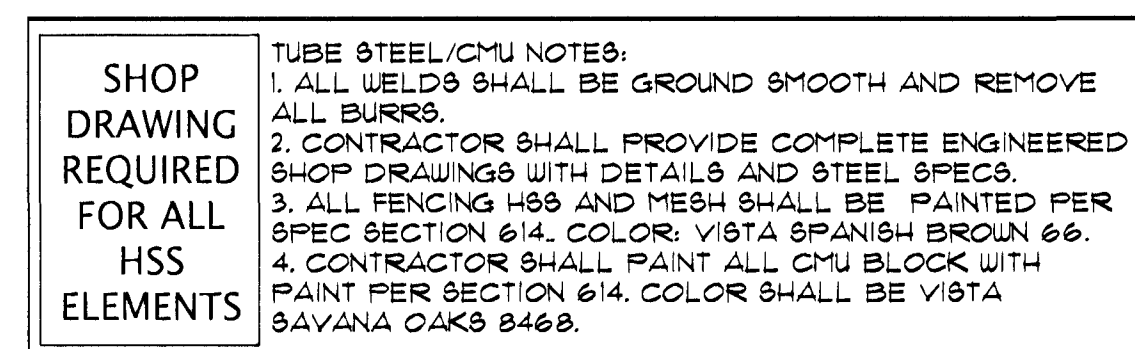
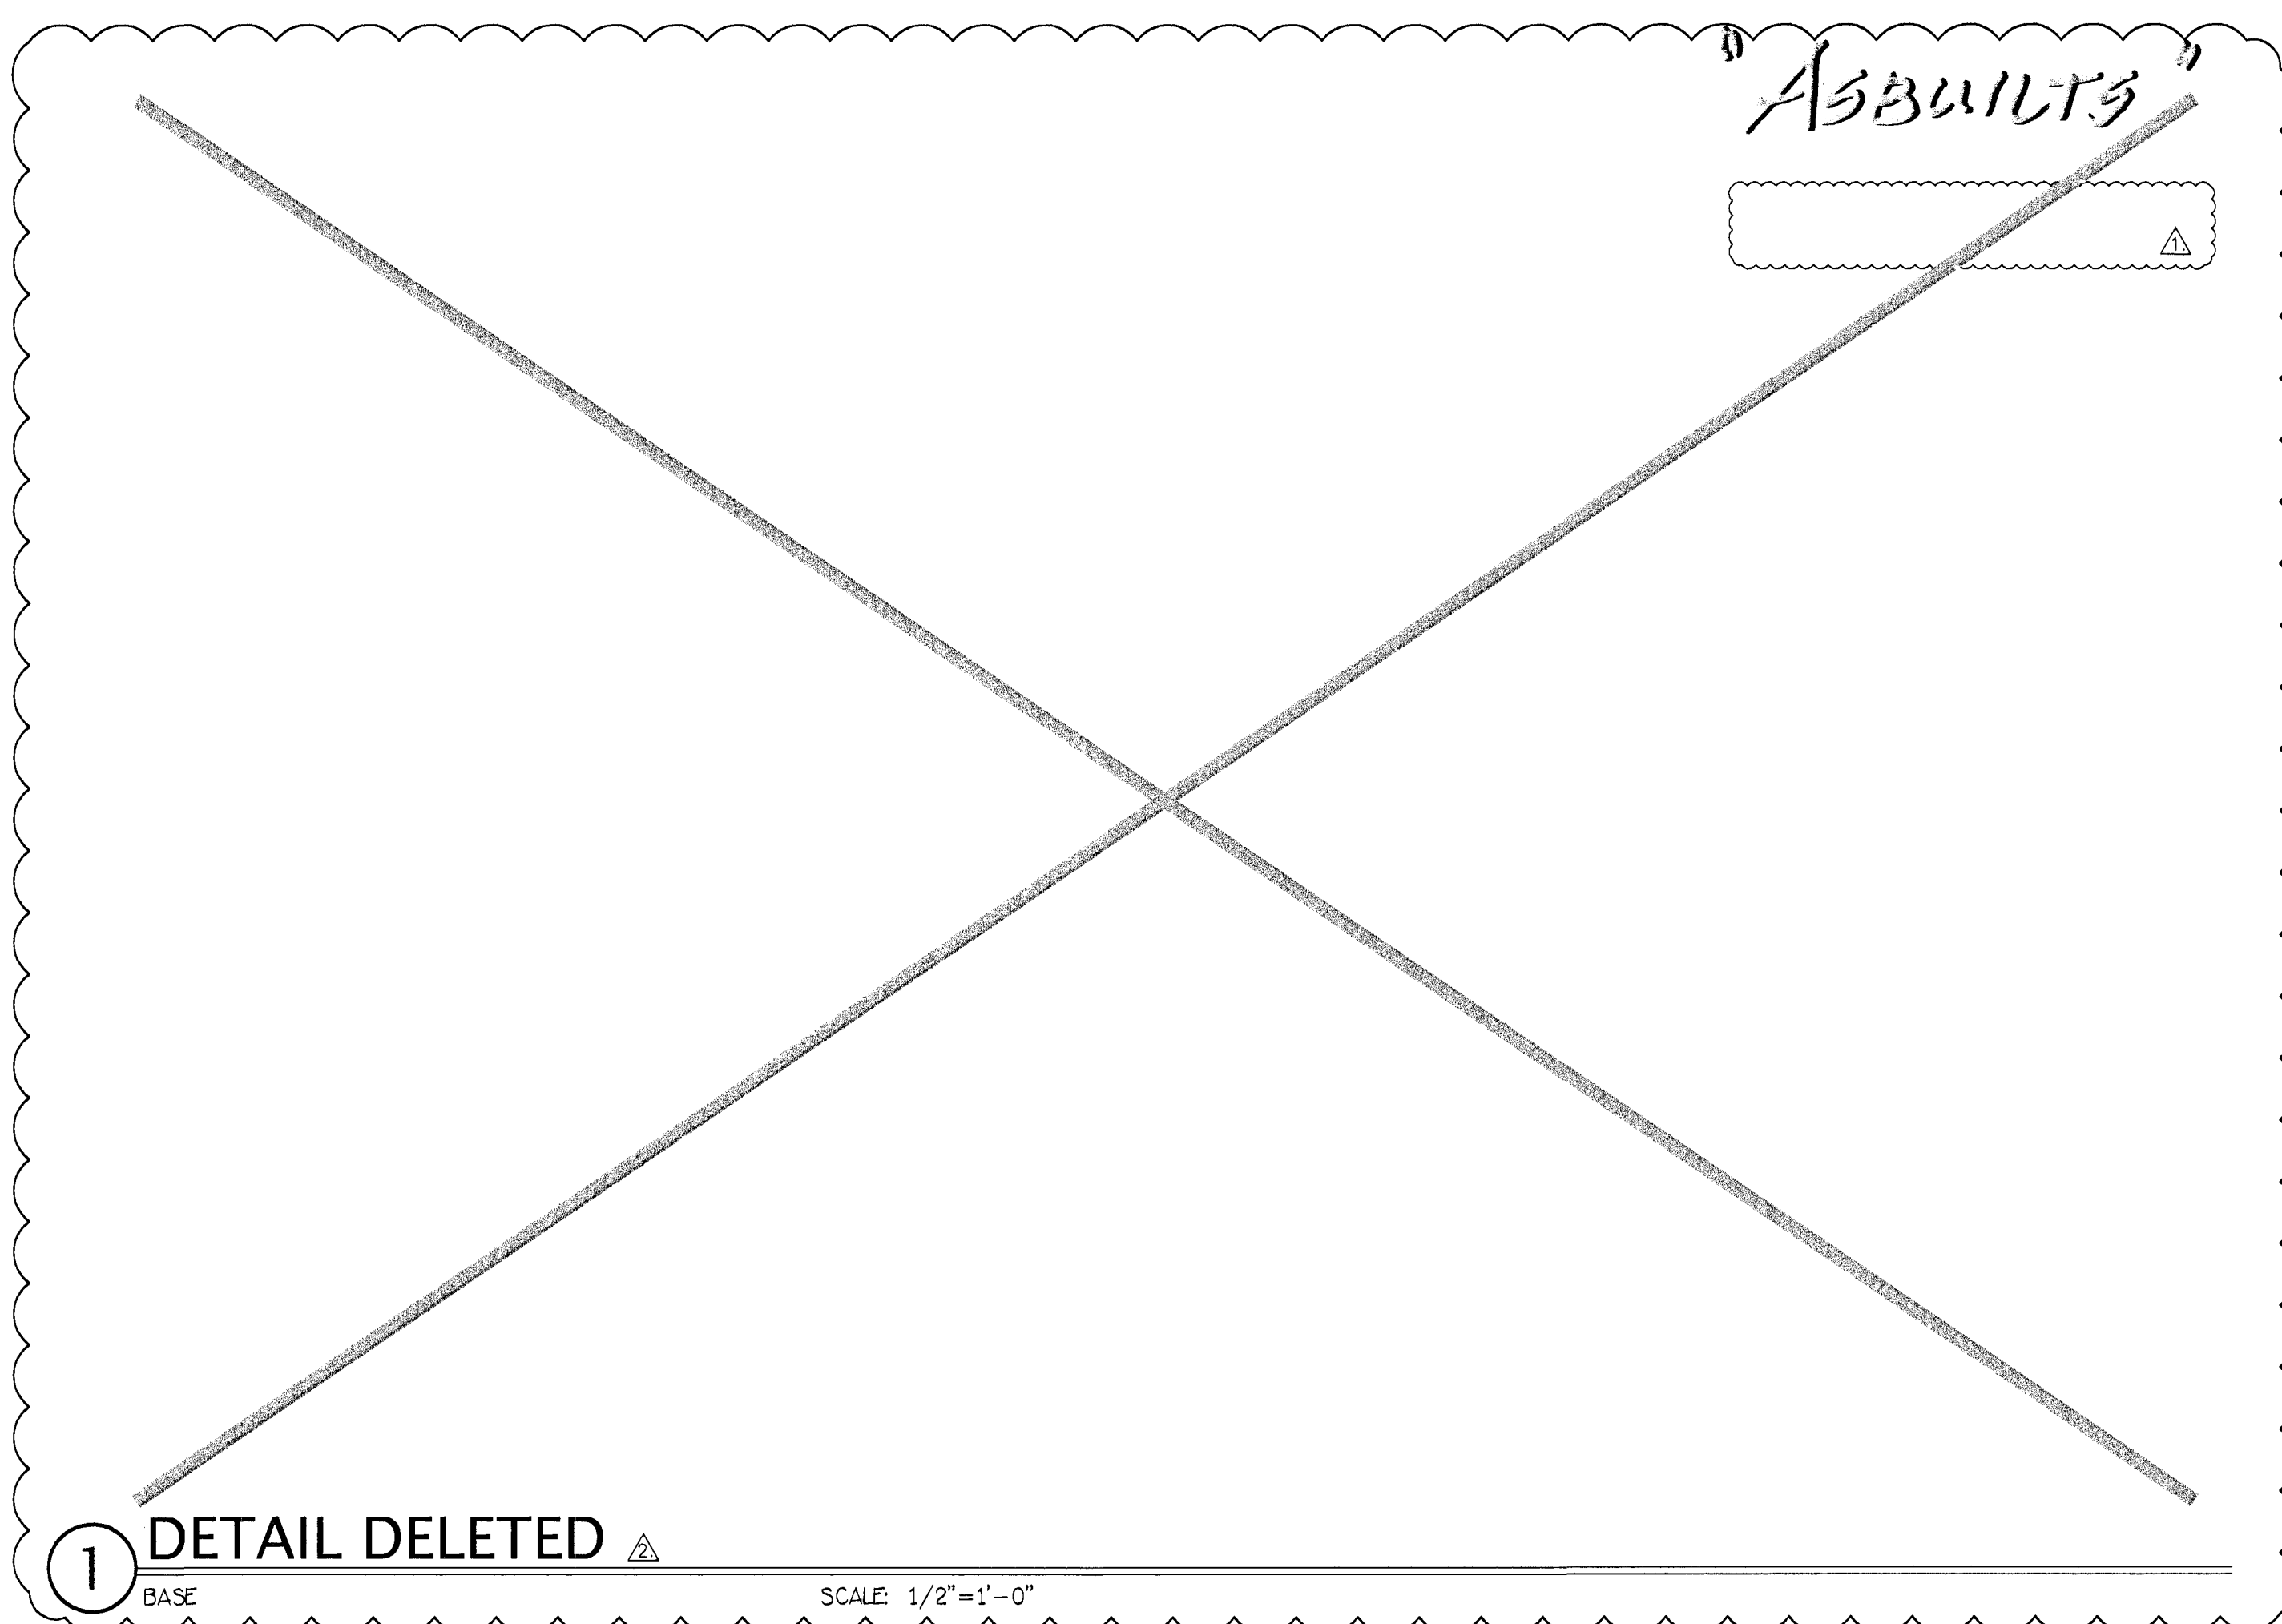
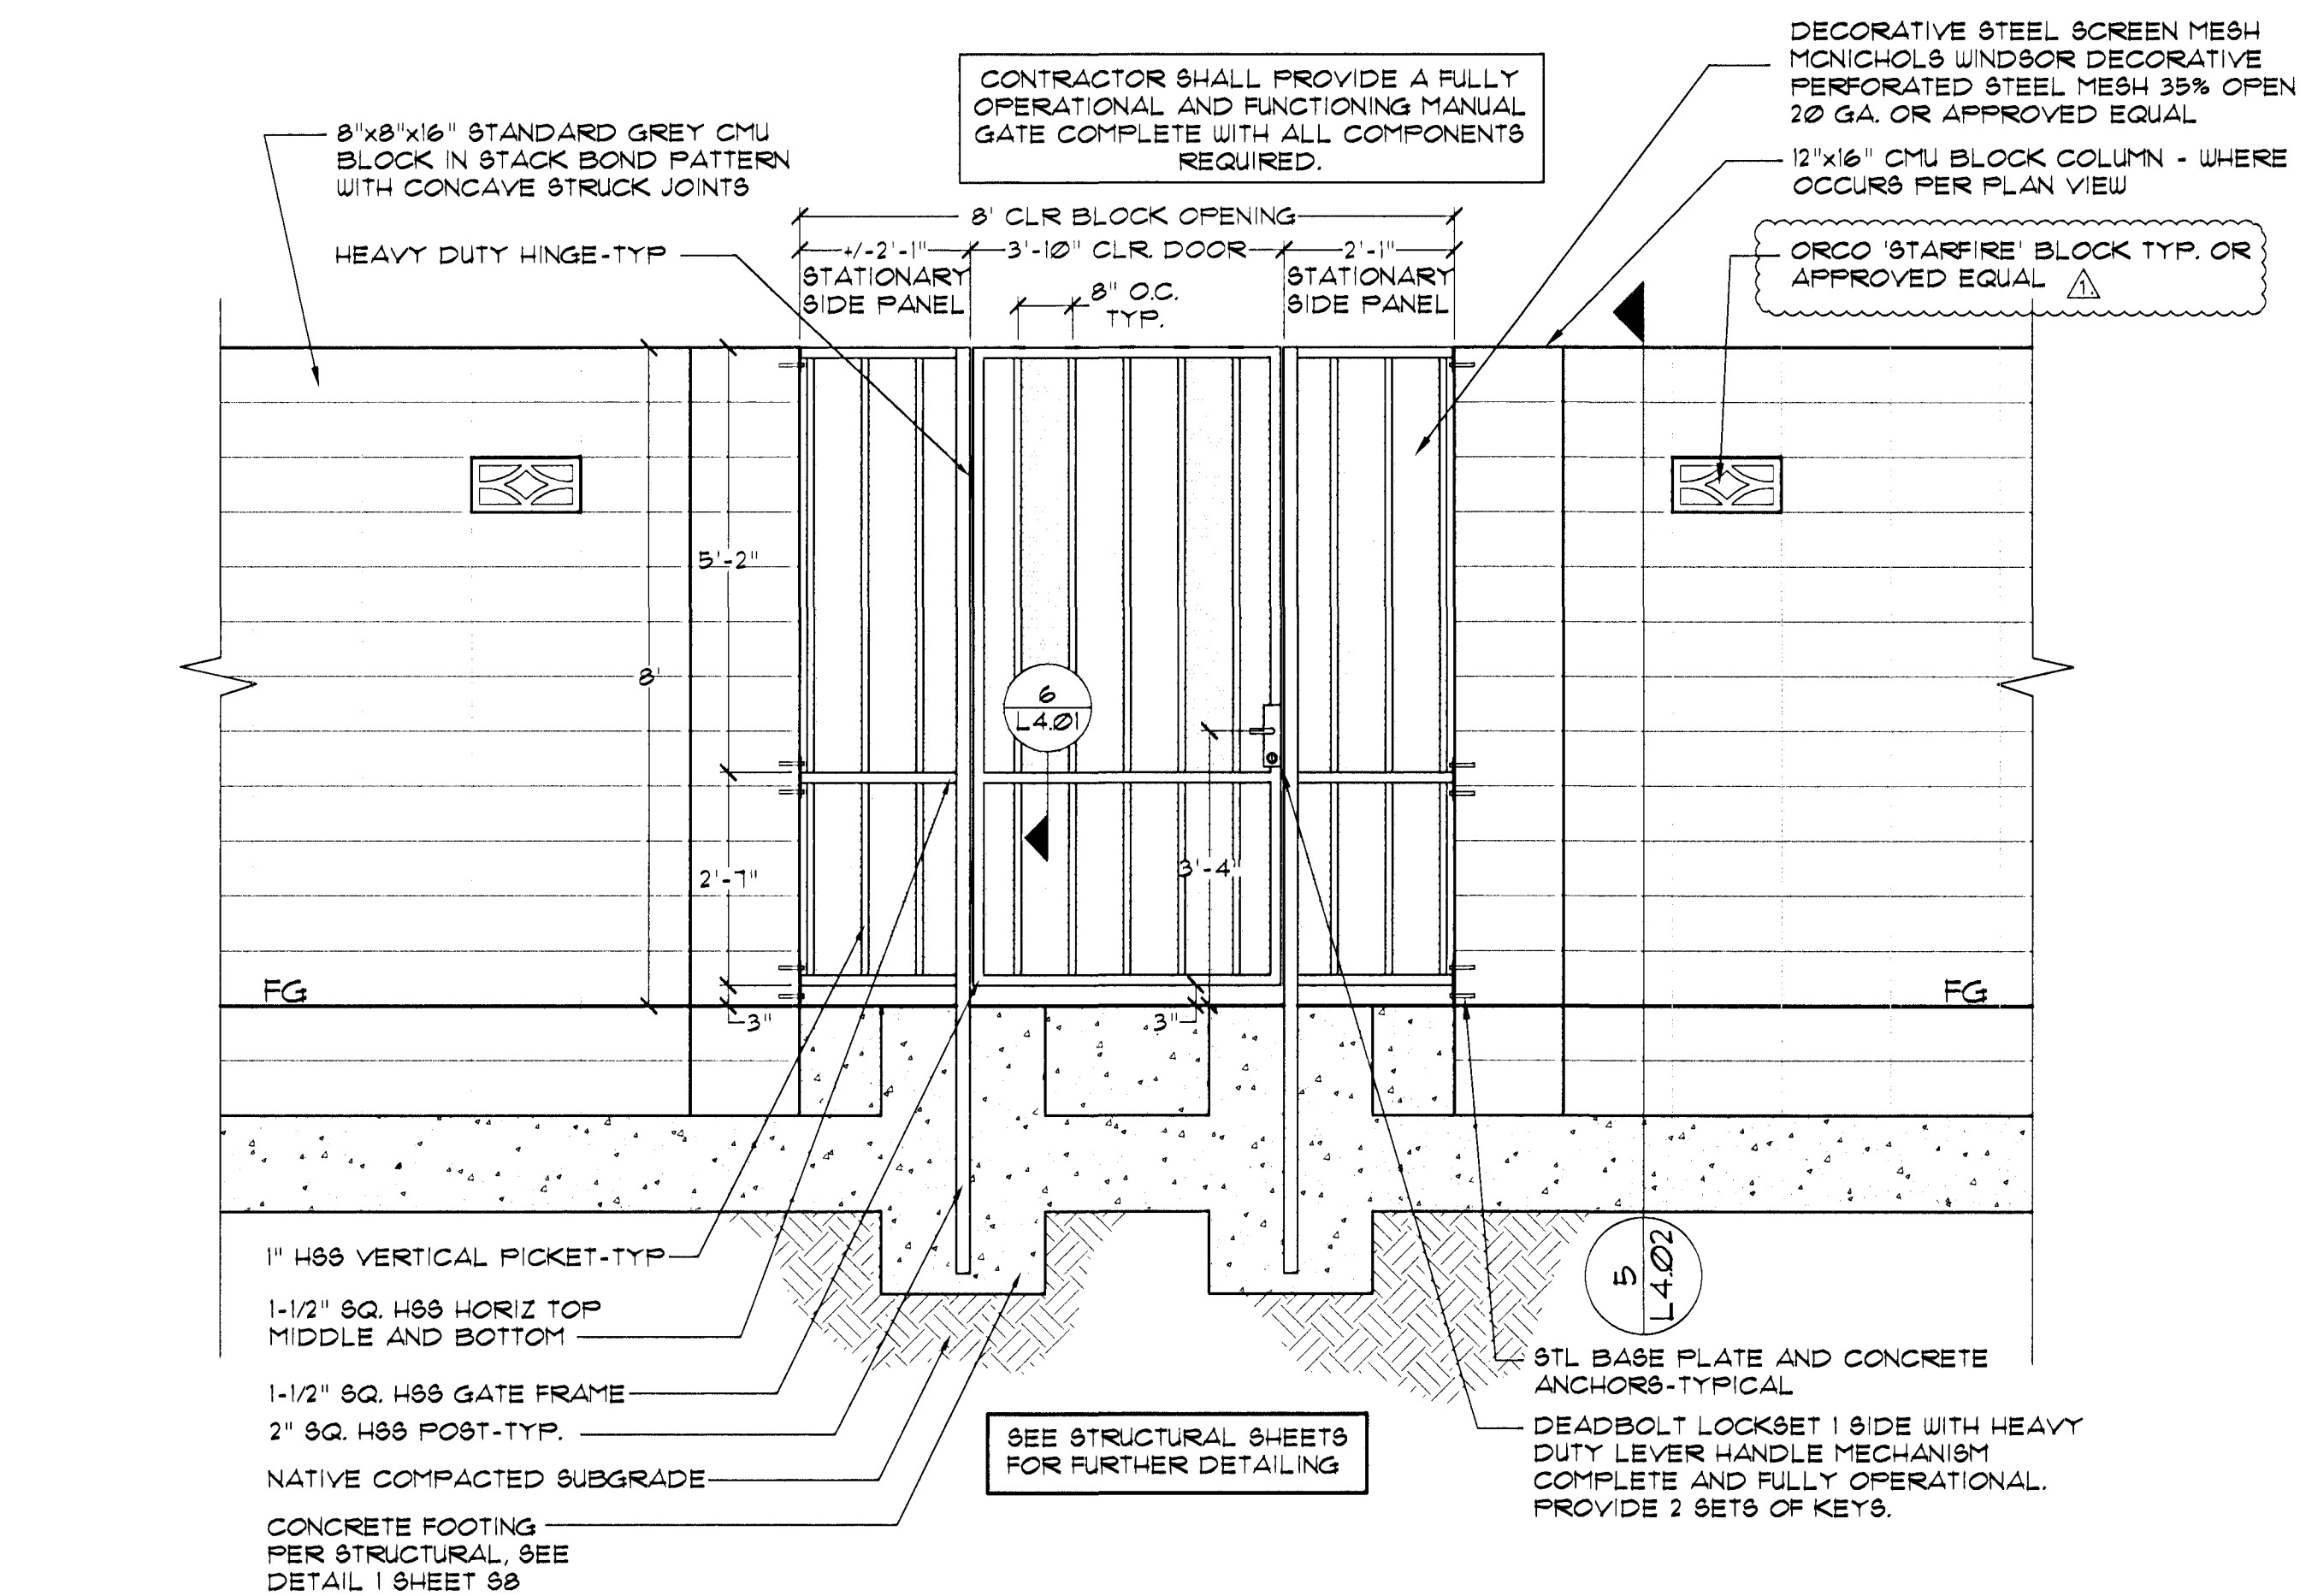


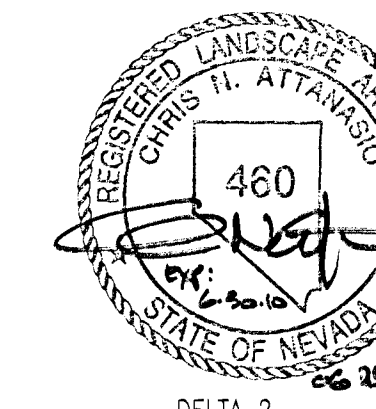

Building & Safety Dept.
City of Las Vegas, Nevada
IN LIEU OF STRUCTURAL REVIEW
PLANS AND CALCULATIONS ARE
DEEMED ACCEPTABLE IF SEALED
AND SIGNED BY A NEVADA LICENSED
CIVIL OR STRUCTURAL ENGINEER

Make no change without approval.
Violate any ordinance.

RECEIVED
JUN 28 2003
CITY OF LAS VEGAS
PERMITS

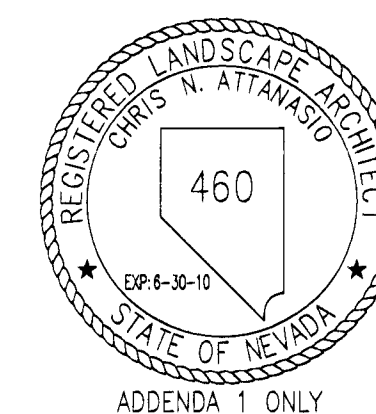

9518 W. Flamingo Rd.
Suite 210
Las Vegas, NV 89147
P: 702.255.7160
F: 702.255.7169

REVISIONS	
<u>1</u>	10-27-09 ADDENDA #1
<u>2</u>	06-23-10 GENERAL REVISION - DETAIL DELETED
NO.	DATE: DESCRIPTION APP'D

DEPARTMENT OF PUBLIC WORKS
400 EAST STEWART
LAS VEGAS, NEVADA 89101
(702) 290-6276



(702) 223-0270


poggemeyer
design group, inc.



TITLE: **NEON BONEYARD PARK**
CITY OF LAS VEGAS

LANDSCAPE SITE DETAILS

DRAWN BY: RSN,SM,KC	DESIGNED BY: CNA	CHECKED BY: CNA	PROJECT NO: 06-0145	SCALE:
------------------------	---------------------	--------------------	------------------------	--------

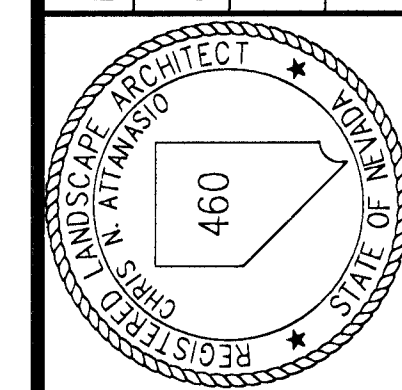

Sheet **L4.05**
33 of 37
CLV DRAWING NO.
676-12