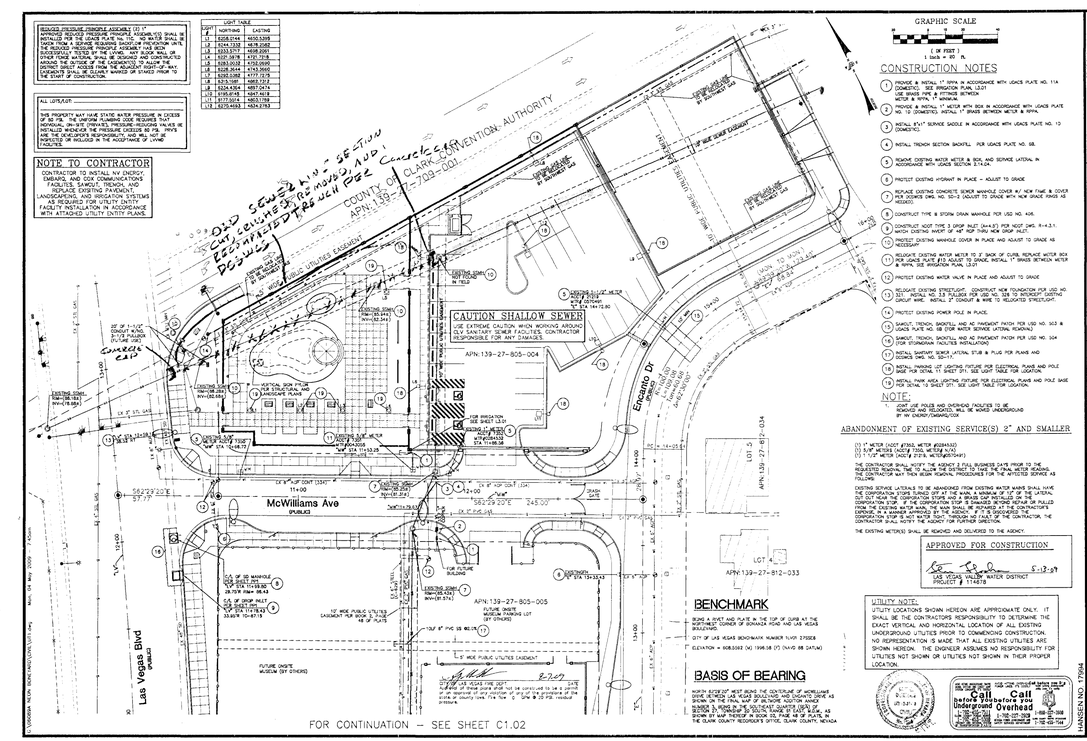

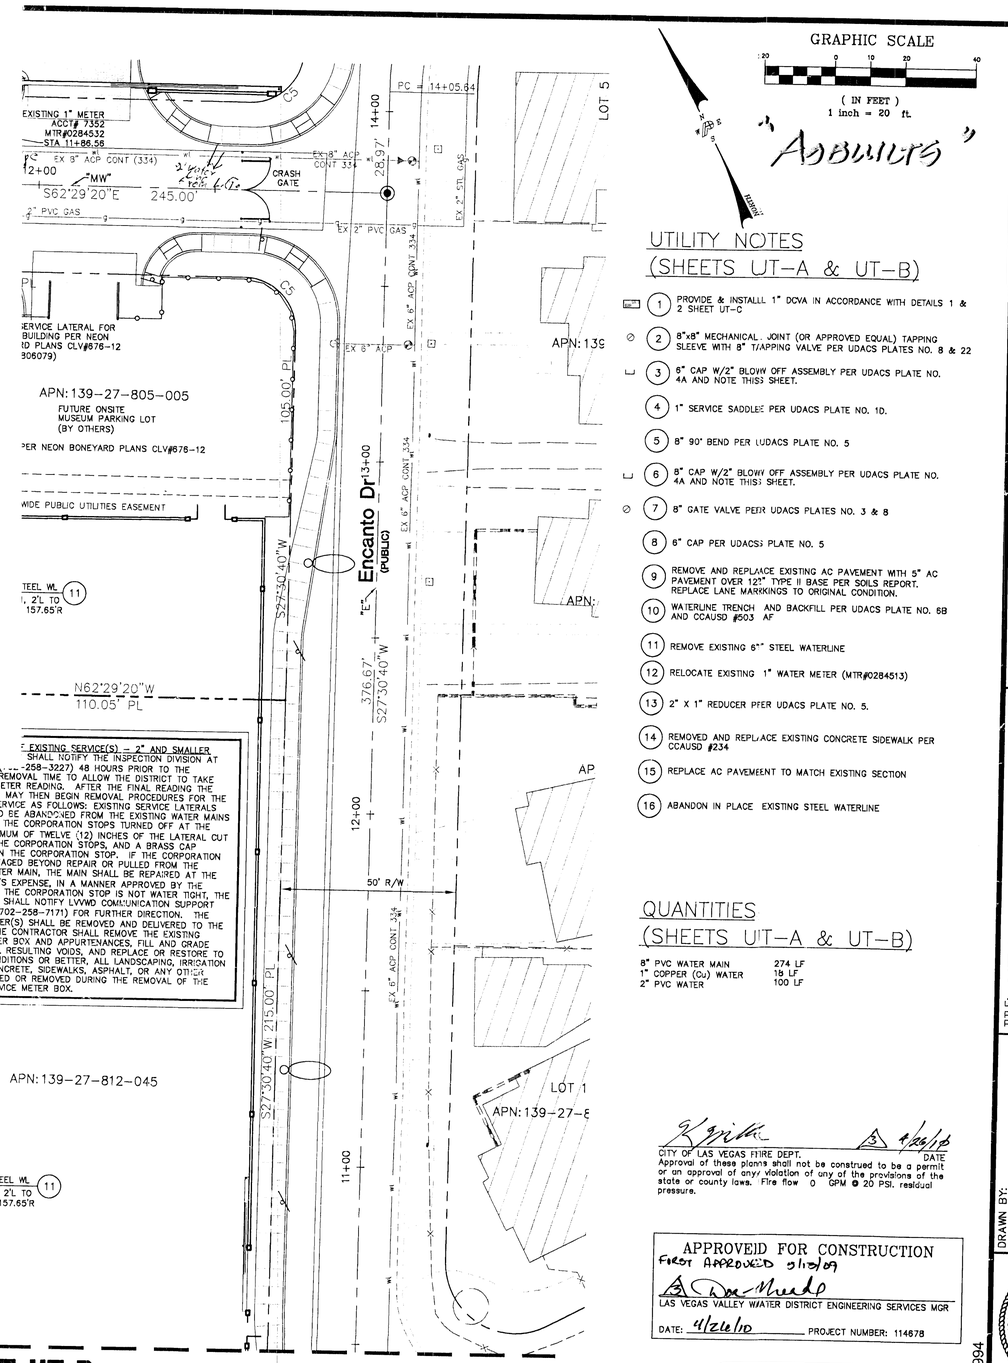

UTILITY NOTES (SHEETS UT-A & UT-B)

1. PROVIDE & INSTALL 1" DCVA IN ACCORDANCE WITH DETAILS 1 & 2 SHEET UT-C
2. 8"x8" MECHANICAL JOINT (OR APPROVED EQUAL) TAPPING SLEEVE WITH 8" TAPPING VALVE PER UDACS PLATES NO. 8 & 22
3. 8" CAP W/2" BLOW OFF ASSEMBLY PER UDACS PLATE NO. 4A AND NOTE THIS SHEET.
4. 1" SERVICE SADDLES PER UDACS PLATE NO. 1D.
5. 8" 90° BEND PER UDACS PLATE NO. 5
6. 8" CAP W/2" BLOW OFF ASSEMBLY PER UDACS PLATE NO. 4A AND NOTE THIS SHEET.
7. 8" GATE VALVE PER UDACS PLATES NO. 3 & 8
8. 6" CAP PER UDACS PLATE NO. 5
9. REMOVE AND REPLACE EXISTING AC PAVEMENT WITH 5" AC PAVEMENT OVER 12" TYPE II BASE PER SOILS REPORT. REPLACE LANE MARKINGS TO ORIGINAL CONDITION.
10. WATERLINE TRENCH AND BACKFILL PER UDACS PLATE NO. 6B AND CCAUSD #503 AF
11. REMOVE EXISTING 6"" STEEL WATERLINE
12. RELOCATE EXISTING 1" WATER METER (MTR#0284513)
13. 2" X 1" REDUCER PER UDACS PLATE NO. 5.
14. REMOVED AND REPLACE EXISTING CONCRETE SIDEWALK PER CCAUSD #234
15. REPLACE AC PAVEMENT TO MATCH EXISTING SECTION
16. ABANDON IN PLACE EXISTING STEEL WATERLINE

QUANTITIES (SHEETS UT-A & UT-B)

8" PVC WATER MAIN	274 LF
1" COPPER (Cu) WATER	18 LF
2" PVC WATER	100 LF

CITY OF LAS VEGAS FIRE DEPT. — DATE
Approval of these plans shall not be construed to be a permit or an approval of any violation of any of the provisions of the state or county laws. Fire flow 0 GPM @ 20 PSI. residual pressure.

APPROVED FOR CONSTRUCTION
FIRST APPROVED 3/12/09
LAS VEGAS VALLEY WATER DISTRICT ENGINEERING SERVICES MGR
DATE: 4/26/10 PROJECT NUMBER: 114678

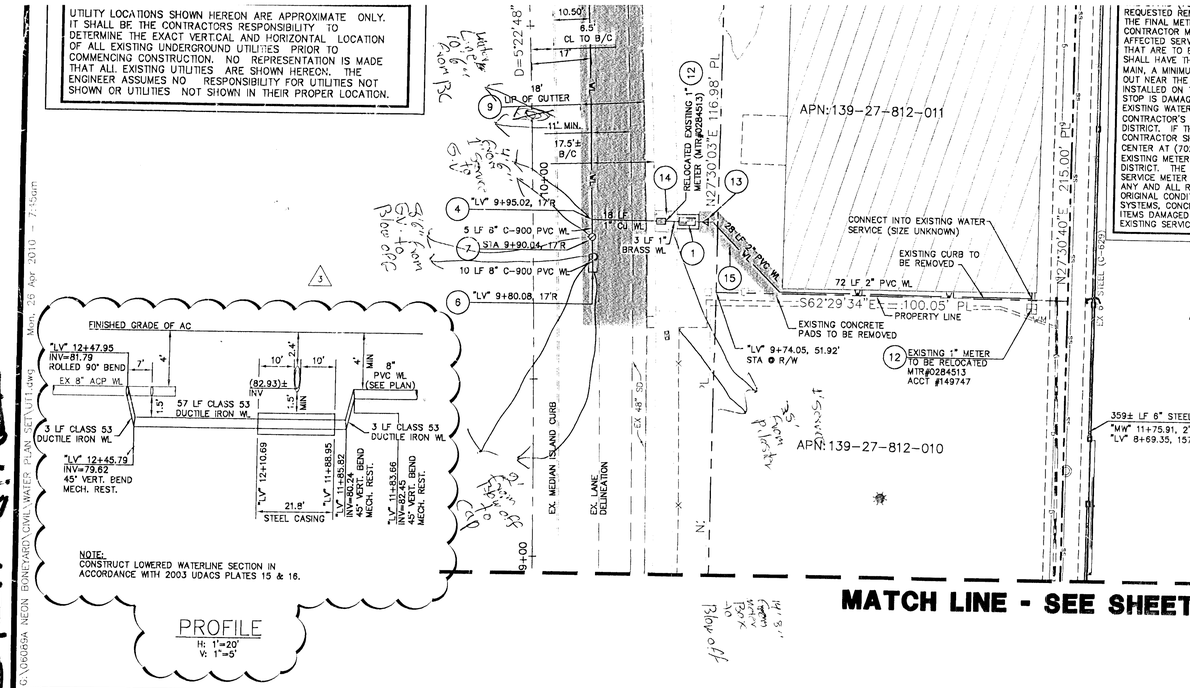

DRAWN BY: CLM	DATE: 3/01/10
DESIGNED BY: CLM/SCD	DATE: 3/01/10
CHECKED BY: SCD	DATE: 3/01/10
PROJECT NO: 060089C	SCALE: 1"=20'

REVISIONS

NO.	DATE	DESCRIPTION	APP'D
2	3/10/10	ADDED SHEETS UT-A THRU UT-C	
3	4/22/10	ADDED WATERLINE PROFILE	

DEPARTMENT OF PUBLIC WORKS
400 EAST STEWART
LAS VEGAS, NEVADA 89101
(702) 229-6276

poggemeyer design group, inc.
6960 Smoke Ranch #110 - Las Vegas, NV 89128 - (t) 702.255.6100 - (f) 702.255.6375

TITLE: NEON BONEYARD PARK CITY OF LAS VEGAS

SHEET: UTILITY PLAN - NORTH

SAM C. DUNNAM EXP. 12-31-10 CIVIL No. 7896

HANSEN NO. 17994

Sheet UT-A 37A of 37

CLV DRAWING NO. 676-12

ASBUILTS THE SAME LOWER

AS BUILT