
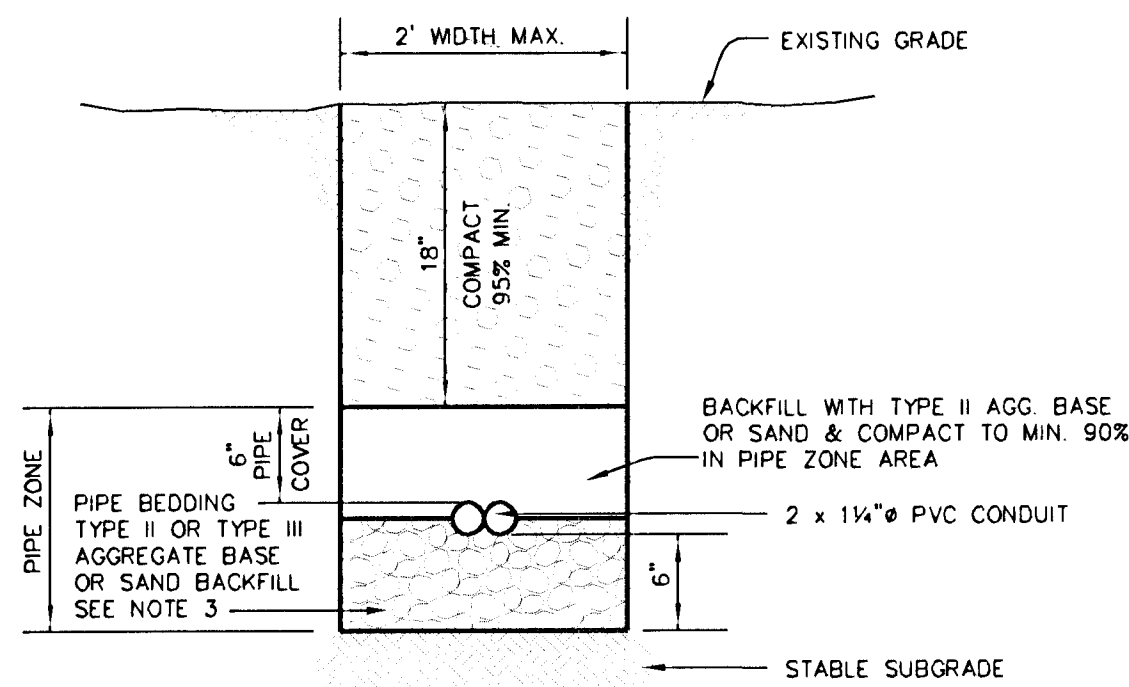


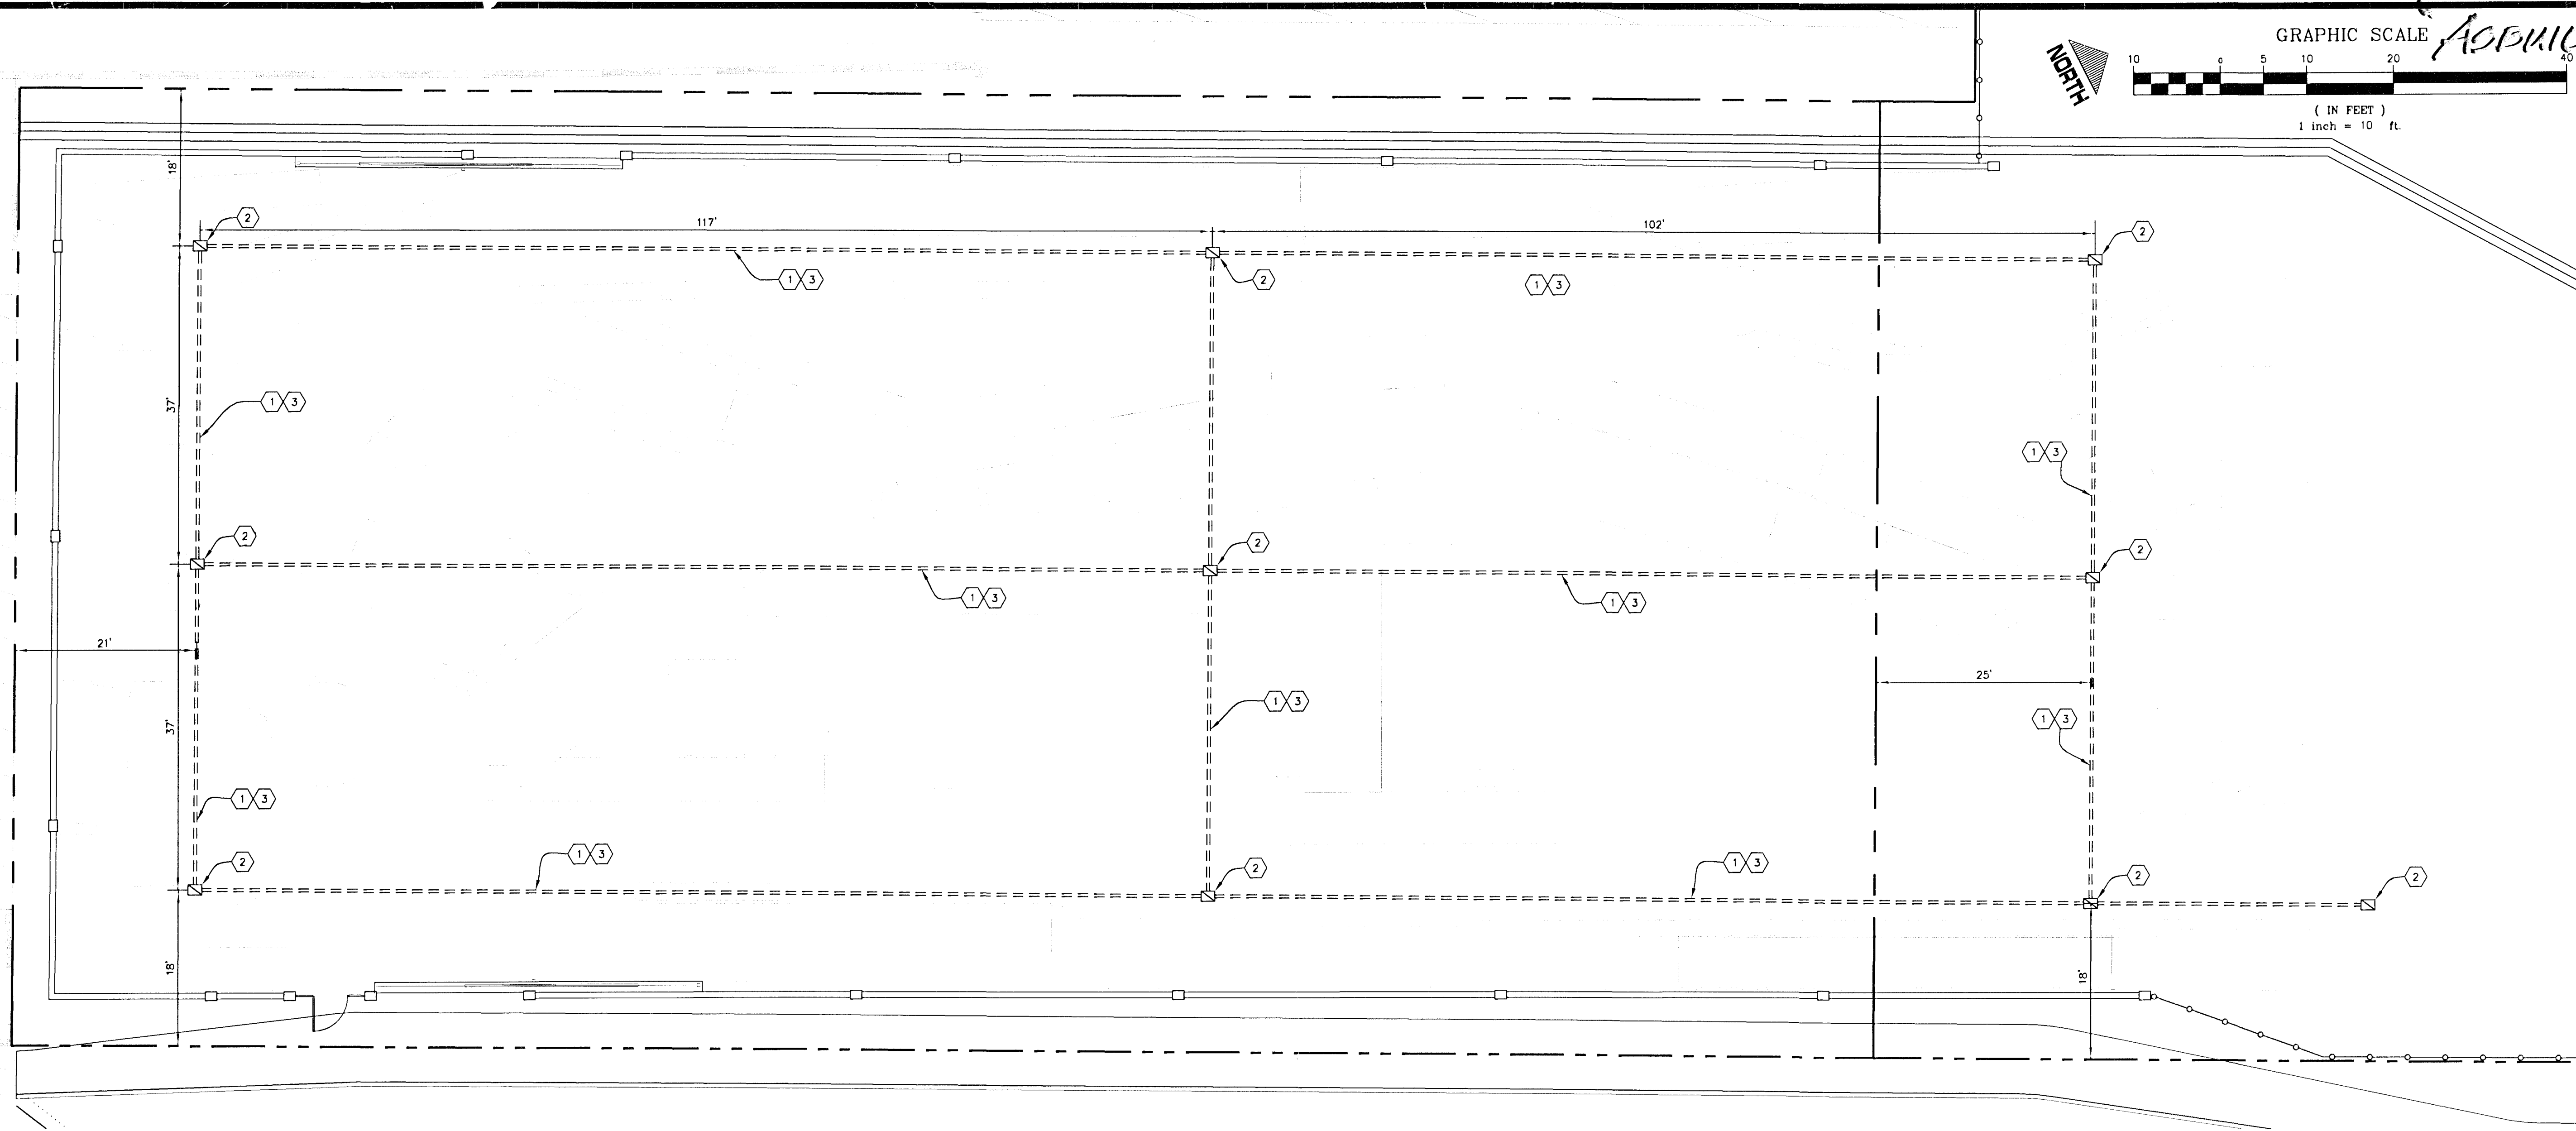


- NOTES:
1. NO STONES OR LUMPS GREATER THAN 3" PERMITTED IN TRENCH 2' OR LESS IN WIDTH.
 2. TRENCH WIDTH, BEDDING, SUBGRADE AND PIPE ZONE REQUIREMENTS FOR UTILITY INSTALLATIONS SHALL CONFORM TO THE CITY OF LAS VEGAS REQUIREMENTS.
 3. CRUSHED ROCK MAY BE USED FOR PIPE BEDDING ONLY IF MATERIAL USE HAS BEEN SPECIFICALLY APPROVED BY THE CITY OF LAS VEGAS.
 4. INSTALLATION AND SPECIFICATION REQUIREMENT REFERENCES INCLUDING CONTRACTOR TESTING & FILL LIFTS PER SECTION 208-TRENCH EXCAVATION AND BACKFILL & SECTION 302-AGGREGATE BASE COURSES - USDCCA

TRENCH DETAIL

CONSTRUCTION NOTES


- 1 TRENCH AND BACKFILL PER TRENCHING DETAIL HEREON
- 2 INSTALL NO. 3/4 PULL BOX PER USDCCA DWG. NO. 326
- 3 INSTALL 2 - 1 1/4" PVC CONDUIT WITH 1 - #8 CONDUCTOR IN EACH IN TRENCH

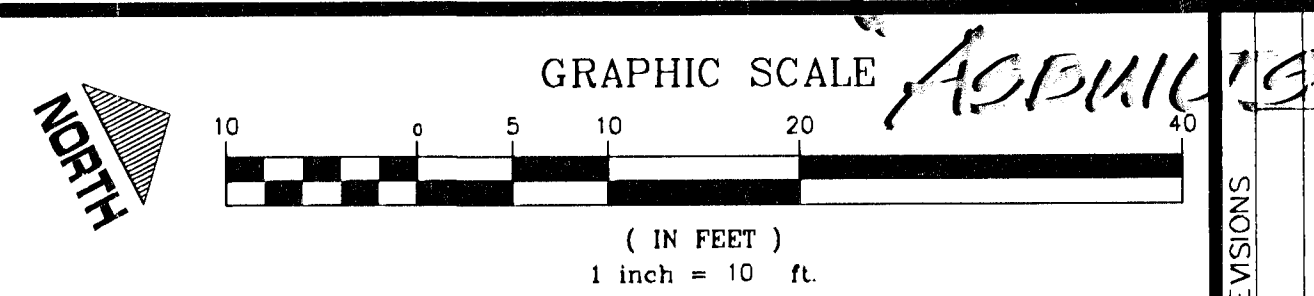

DEPARTMENT OF PUBLIC WORKS ENGINEERING DESIGN SECTION

CITY ENGINEER: CHERI L. EDELMAN, P.E.
PROGRAM MANAGER:
DESIGNED BY: pff
DRAWN BY: pff
CHECKED BY: st

DATE: 03/09/2010

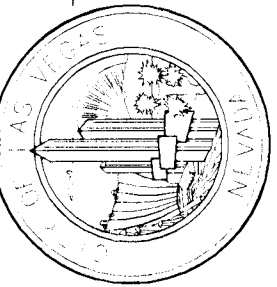


NEON BONEYARD CURATORIAL PLAN

SOUTH YARD CONDUIT PLAN

TITLE:

SHEET:

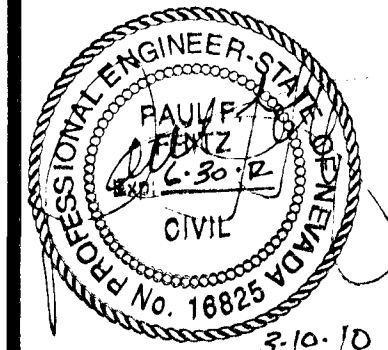

Sheet
C-1.01
1 of 1
DRAWING NO.
C-1.01

JOB

RECEIVED
CITY OF LAS VEGAS
3-10-10