
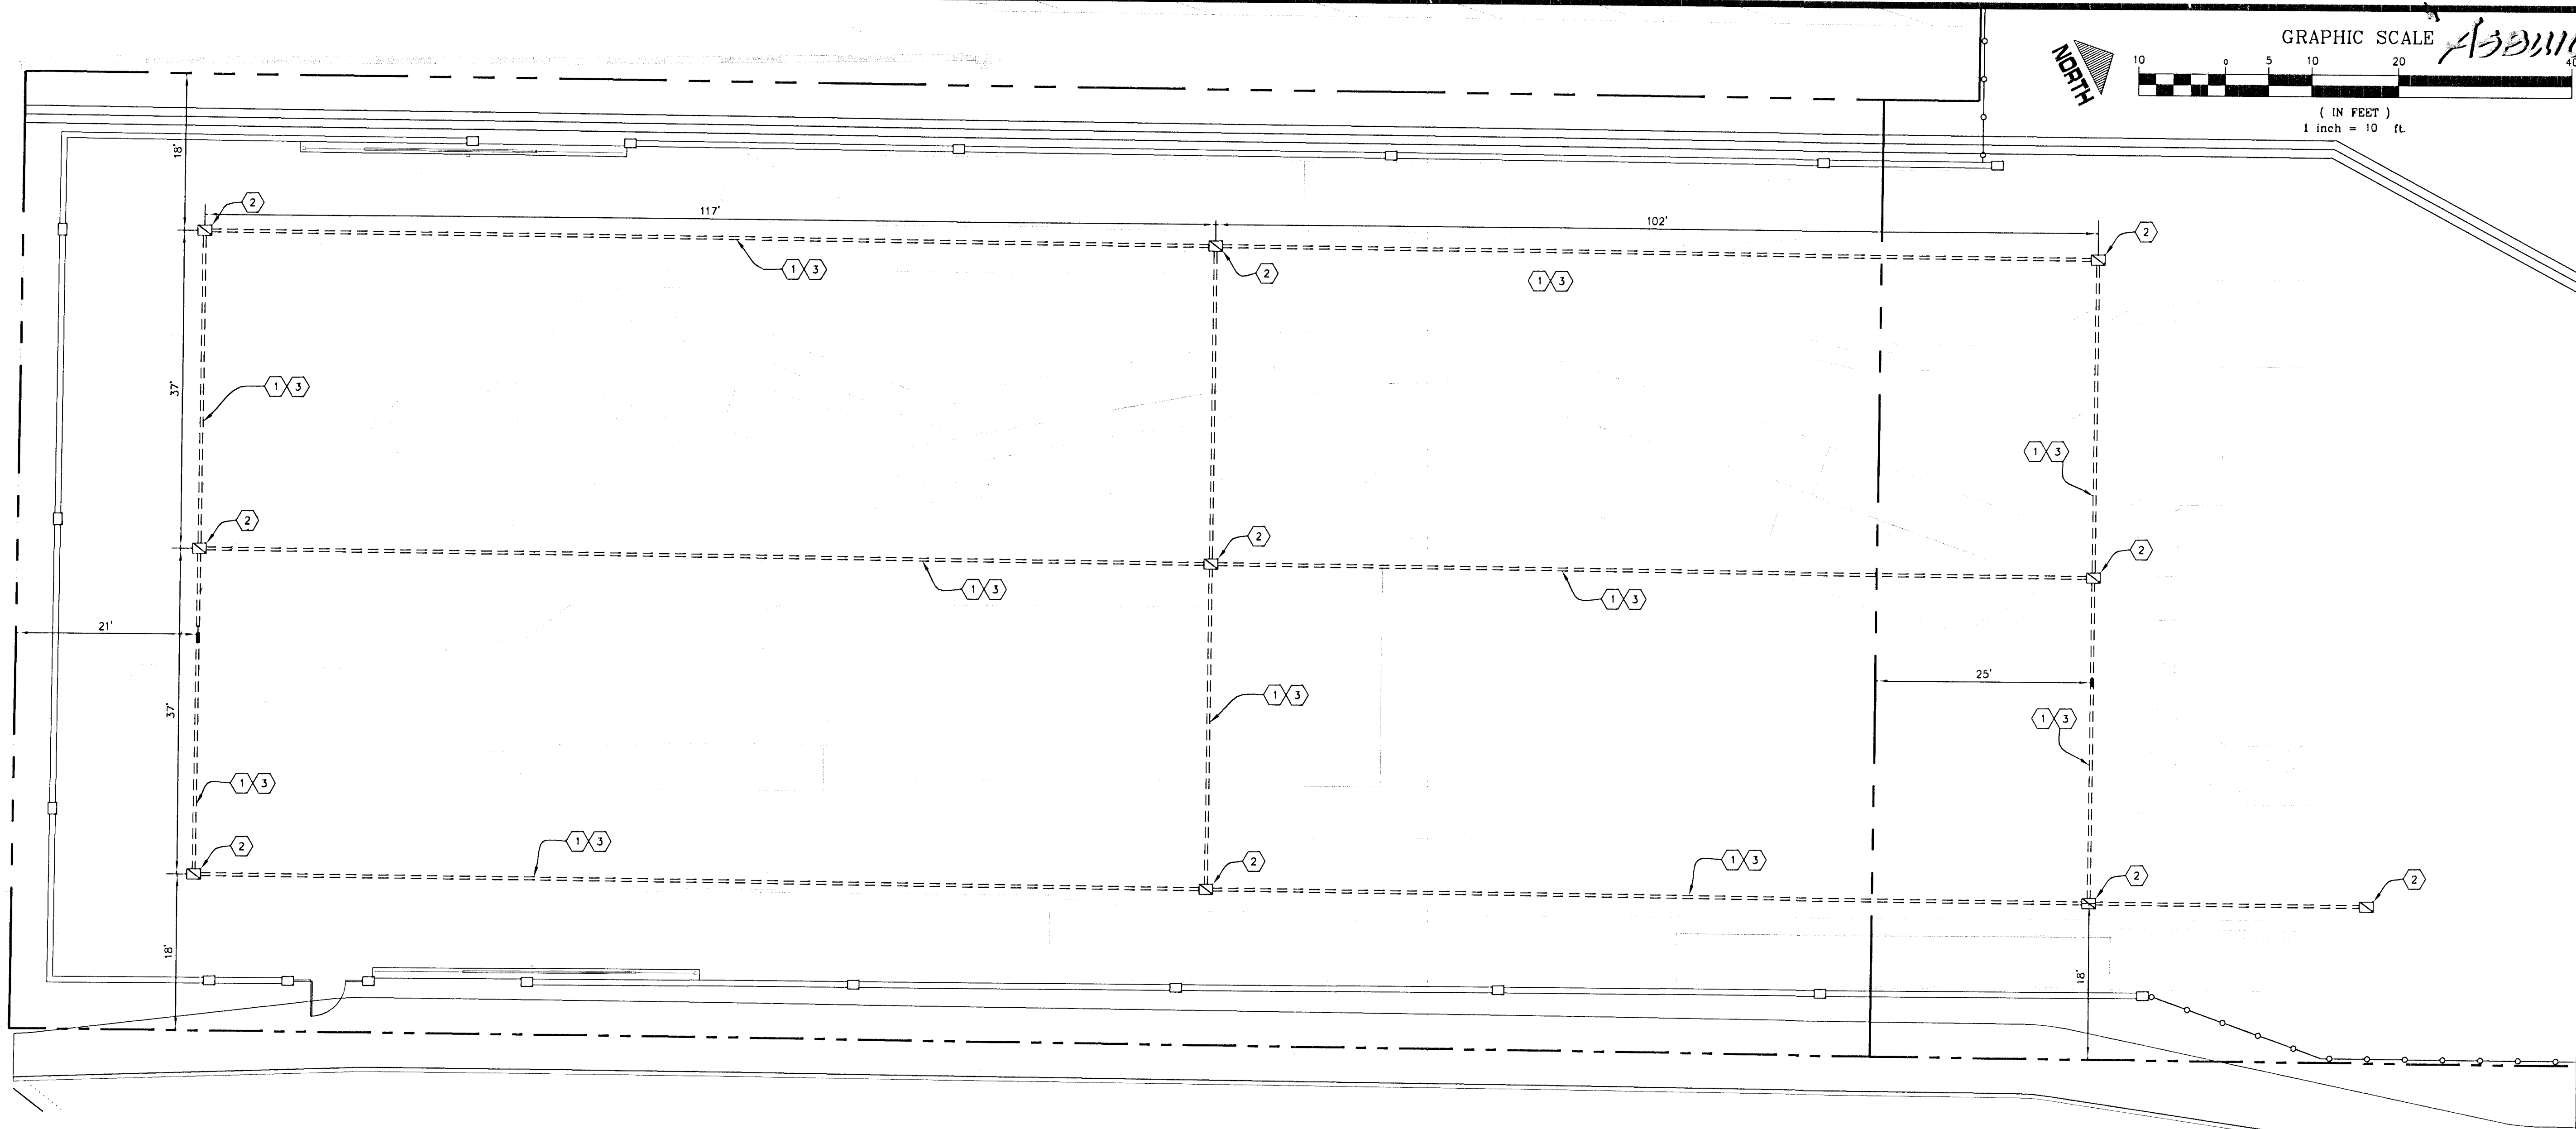


NO.	DATE	DESCRIPTION	APP'D

DEPARTMENT OF PUBLIC WORKS
ENGINEERING DESIGN SECTION

CITY ENGINEER: CHERI L. EDELMAN, P.E.
PROGRAM MANAGER:
DESIGNED BY: pif
DRAWN BY: pif
CHECKED BY: st
DATE: 03/09/2010

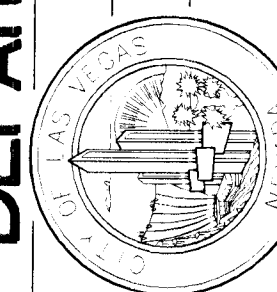


TITLE: NEON BONEYARD CURATORAL PLAN

SHEET: SOUTH YARD CONDUIT PLAN

RECEIVED
JUN 20 2010 15 26 11
34944-C-10
CITY OF LAS VEGAS

PROFESSIONAL ENGINEER
PAUL P. EDELMAN
No. 18825
CIVIL
3-10-10

Sheet
C-1.01
1 of 1
DRAWING NO.
C-1.01

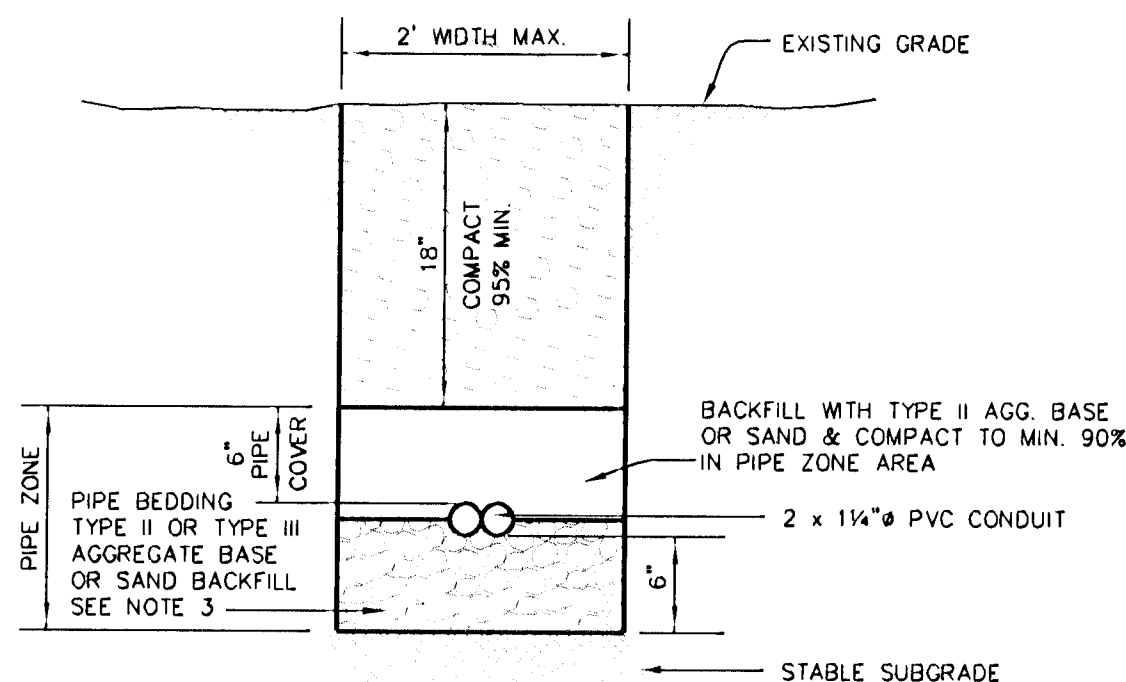

CONSTRUCTION NOTES

- (1) TRENCH AND BACKFILL PER TRENCHING DETAIL HEREON
- (2) INSTALL NO. 3/4 PULL BOX PER USDOCCA DWG. NO. 326
- (3) INSTALL 2 - 1 1/4" PVC CONDUIT WITH 1 - #8 CONDUCTOR IN EACH IN TRENCH

NOTES:

1. NO STONES OR LUMPS GREATER THAN 3" PERMITTED IN TRENCH 2' OR LESS IN WIDTH.
2. TRENCH WIDTH, BEDDING, SUBGRADE AND PIPE ZONE REQUIREMENTS FOR UTILITY INSTALLATIONS SHALL CONFORM TO THE CITY OF LAS VEGAS REQUIREMENTS.
3. CRUSHED ROCK MAY BE USED FOR PIPE BEDDING ONLY IF MATERIAL USE HAS BEEN SPECIFICALLY APPROVED BY THE CITY OF LAS VEGAS.
4. INSTALLATION AND SPECIFICATION REQUIREMENT REFERENCES INCLUDING CONTRACTOR TESTING & FILL LIFTS PER SECTION 208-TRENCH EXCAVATION AND BACKFILL & SECTION 302-AGGREGATE BASE COURSES - USDOCCA

TRENCH DETAIL

3493

2013128