



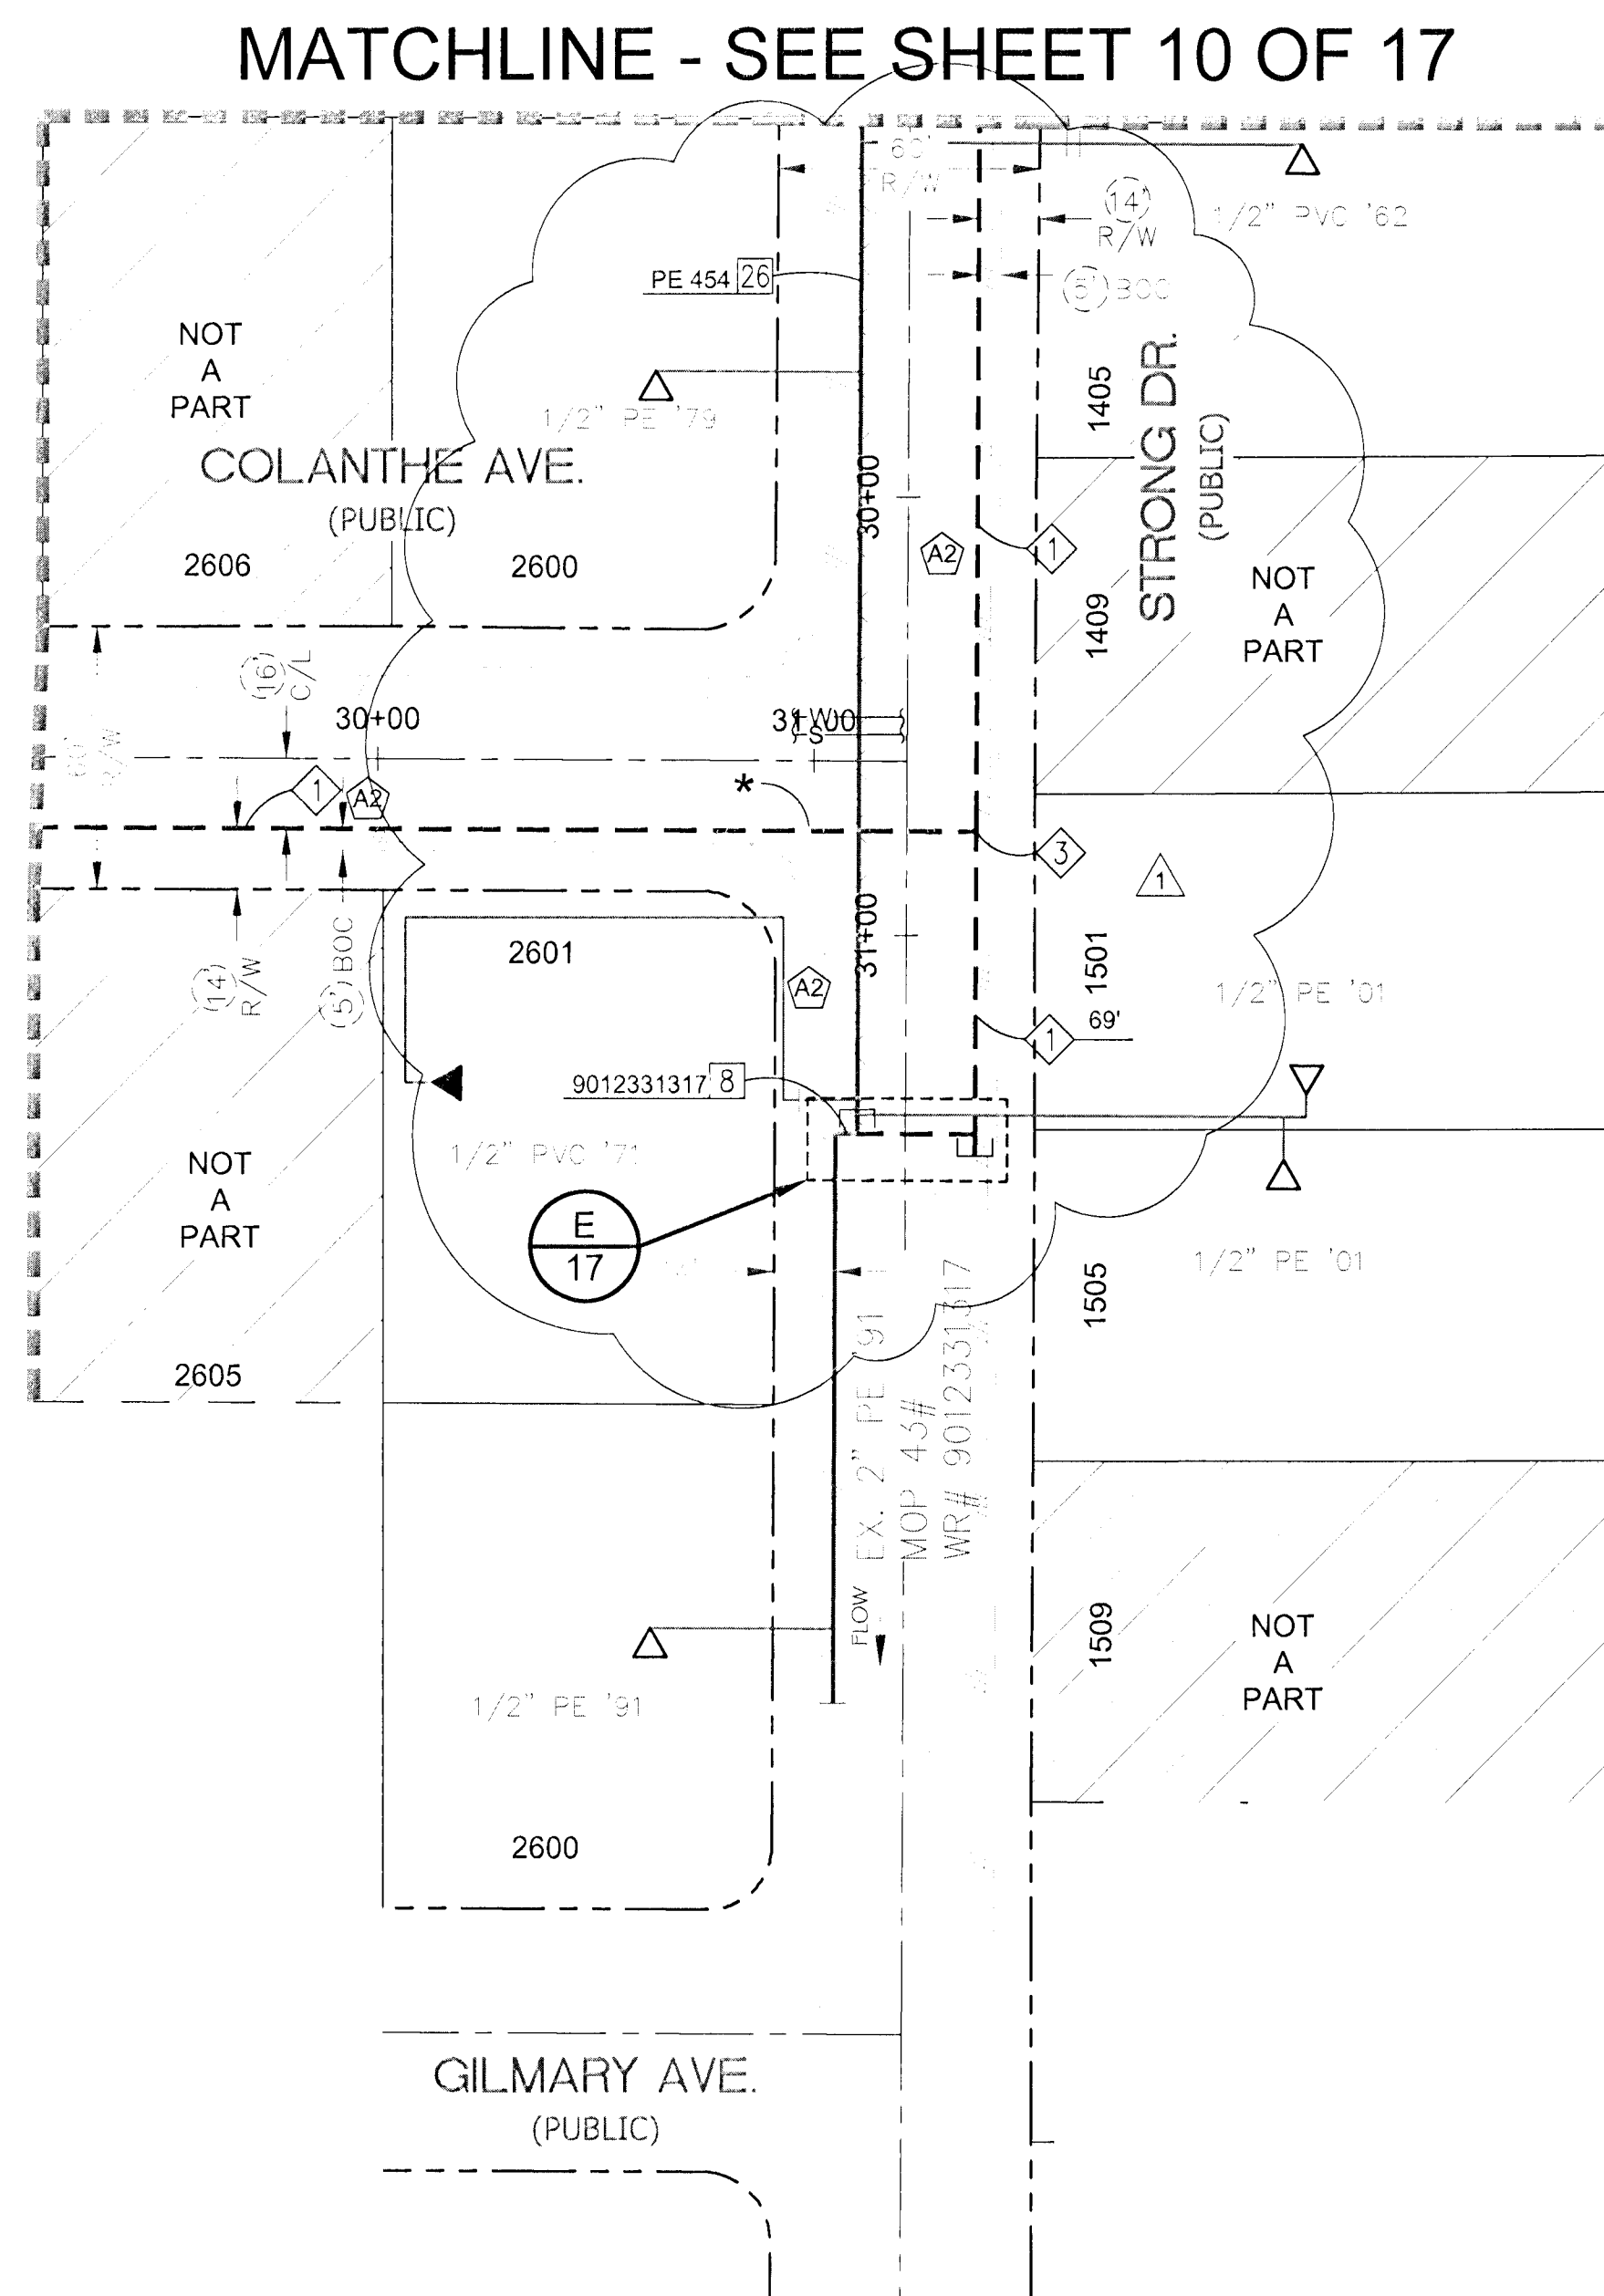

PROPOSED FACILITIES:

- 1 PROPOSED 2" PE MAIN
- 3 PROPOSED 2" PE TEE #140-3074

ABANDONED FACILITIES:


- 8 ABANDON EX. 2" PE '91 MOP 43#
- 26 ABANDON EX. 2" PVC '62 MOP 43#

NOTE

ALL CONSTRUCTION AND MATERIALS SHALL BE IN ACCORDANCE WITH THE "UNIFORM STANDARD SPECIFICATIONS FOR PUBLIC WORKS CONSTRUCTION OFF-SITE IMPROVEMENTS, CLARK COUNTY AREA NEVADA", LATEST ISSUE; THE "UNIFORM STANDARD DRAWINGS FOR PUBLIC WORKS CONSTRUCTION CLARK COUNTY AREA NEVADA", LATEST ISSUE; AND OTHER APPLICABLE APPROVED STANDARDS ISSUED BY THE CONTROLLING AGENCY; ALL LOCAL CITY CODES AND ORDINANCES APPLICABLE."


NOTE

* PROPOSED GAS MAIN TO BE BORED UNDER
EXISTING CROSS GUTTER

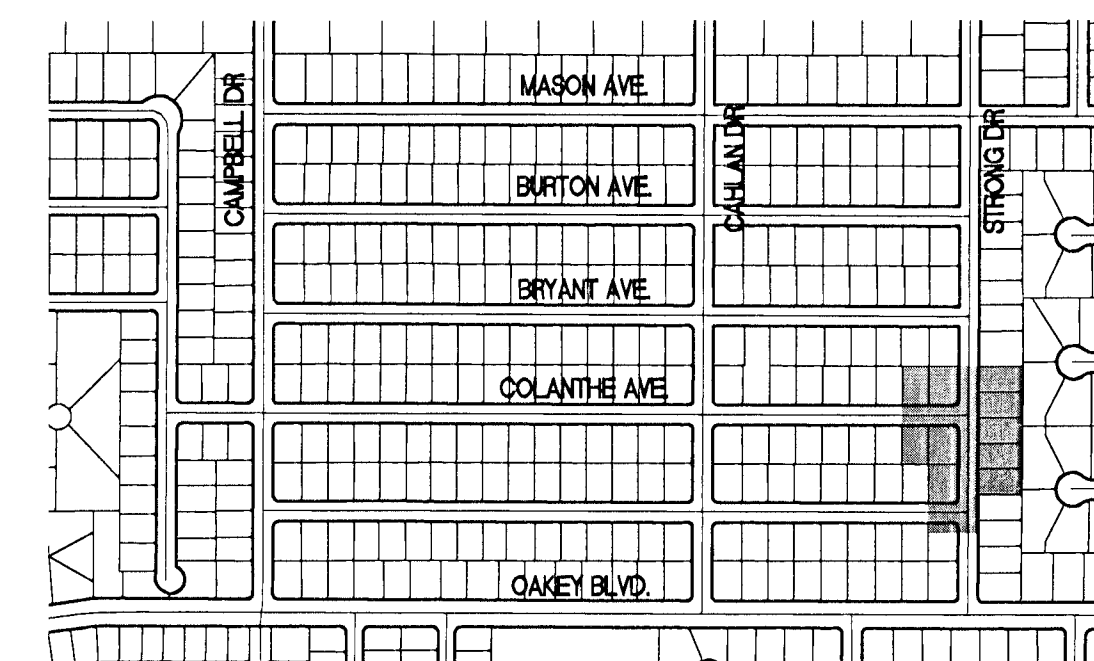

VICINITY MAP
N.T.S.

LEGEND:

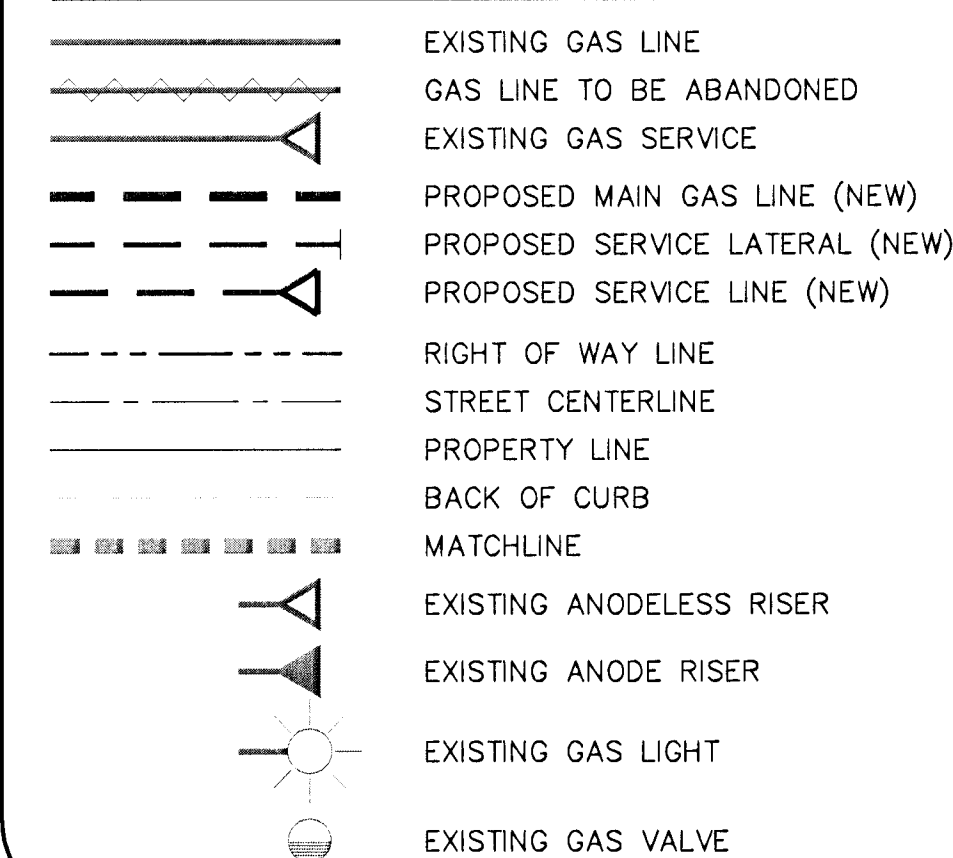

RTC NOTES:

PAVEMENT REPAIR SHALL CONFORM TO RTC:

- | | |
|----|-------|
| A1 | 500.3 |
| A2 | 500.4 |
| A3 | 500.5 |

PNV5909-GAS

1.	Moved Gas Lines per CLV & Field Comments	PDD	3/21/13	RK	4-9-13
2.					
3.					
4.					
No.	Description	By	Date	Appvd.	
REVISIONS					
SOUTHWEST GAS CORPORATION					
Tax Codes	Unit No.	Unit Type	Instl Proposed	Retired Completed	
PROPERTY UNITS					

A5-BUILT DRAWING-PRESSURE TEST DATA
TEST MEDIUM TEST METHOD
☐ AIR ☐ GAUGE
☐ NITROGEN ☐ CHART
☐ WATER ☐
☐ SOAP PRESS REG SWM

N.M. DURATION _____
_____ START END

PRESS REG SWM _____

TEST PRES. (PSIG) _____
TIME _____
DATE _____
PERFORMED BY _____

VISUAL INSPECTION CERTIFICATION

I HAVE VISUALLY INSPECTED ALL HEATED FUSIONS, SOLVENT CEMENT MECHANICAL JOINTS, AND WELDS THAT I HAVE PERFORMED

NAME _____ DATE _____

INSPECTOR _____
FOREMAN _____
REVISED BY _____

A5-BUILTS ACCEPTED BY _____ DATE _____
POSTED BY _____ DATE _____
POSTING QCD BY _____ DATE _____

CONSTRUCTION

CITY OF LAS VEGAS
TAX CODE 02-0200

ISOLATION AREA

95

W.R. NO. 1581531

LOCATION T21S R61E S05 M.D.M.
ATLAS #/TITLE # xG18y512 xG18y510 xG15y512 xG15y510

ENGINEER/TECHNICIAN PATRICK DENISON PHONE 365-

ACCOUNT REP. _____ PHONE _____

PROJECT CONTACT SHEET NO. 14 OF 17 SCALE: 1"=40' DATE 12/24/12

DWN. BY SEI CTKD. BY APPVD. BY TITLE _____

SI-CLV-McNEIL ESTATES SOUTH