


# MONUMENT TIE MAP OF MADISON COLONY AT PROVIDENCE UNIT 2

AS SHOWN BY MAP THEREOF ON FILE IN THE CLARK COUNTY RECORDER'S OFFICE IN BOOK 141, PAGE 34 OF PLATS.  
SITUATE IN THE NORTH HALF (N 1/2) OF THE NORTHEAST QUARTER (NE 1/4) OF SECTION 13, TOWNSHIP 19 SOUTH,  
RANGE 59 EAST, M.D.M., CITY OF LAS VEGAS, CLARK COUNTY, NEVADA.



| LINE TABLE |             |        |
|------------|-------------|--------|
| LINE       | BEARING     | LENGTH |
| L1         | N02°01'08"W | 21.00  |
| L2         | N02°01'08"W | 21.00  |

| CURVE TABLE |           |        |        |         |
|-------------|-----------|--------|--------|---------|
| CURVE       | DELTA     | RADIUS | LENGTH | TANGENT |
| C1          | 14°50'06" | 300.00 | 77.68  | 39.06   |
| C2          | 14°50'06" | 300.00 | 77.68  | 39.06   |
| C3          | 6°31'52"  | 300.00 | 34.20  | 17.12   |
| C4          | 8°18'14"  | 300.00 | 43.48  | 21.78   |
| C5          | 5°49'35"  | 300.00 | 30.51  | 15.27   |
| C6          | 9°00'32"  | 300.00 | 47.17  | 23.63   |
| C7          | 14°50'06" | 300.00 | 77.68  | 39.06   |
| C8          | 14°28'56" | 300.00 | 75.83  | 38.12   |
| C9          | 14°28'56" | 300.00 | 75.83  | 38.12   |

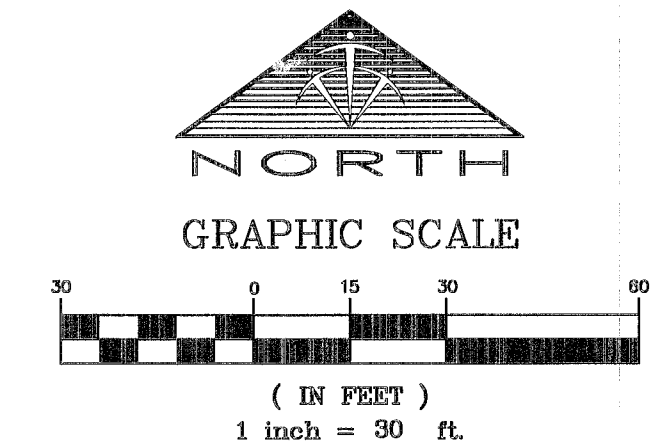


## LEGEND

- SUBDIVISION BOUNDARY LINE
- SECTION LINE
- ALIQUOT PART LINE
- ASSESSOR'S PARCEL LINE
- LOT LINE
- RIGHT-OF-WAY LINE/LIMITS OF PRIVATE STREET
- STREET CENTERLINE
- FOUND MONUMENTATION AS DESCRIBED
- SET TYPE III MONUMENT  
STAMPED "PLS 17449"
- SET TYPE IV-A REFERENCE MONUMENT  
STAMPED "PLS 17449"
- 1 LOT NUMBER
- (1) BLOCK NUMBER
- (R) RADIAL BEARING
- APN ASSESSOR'S PARCEL NUMBER
- C.E. COMMON ELEMENT

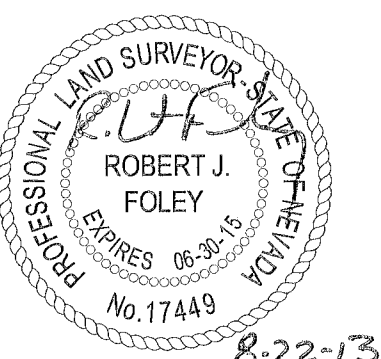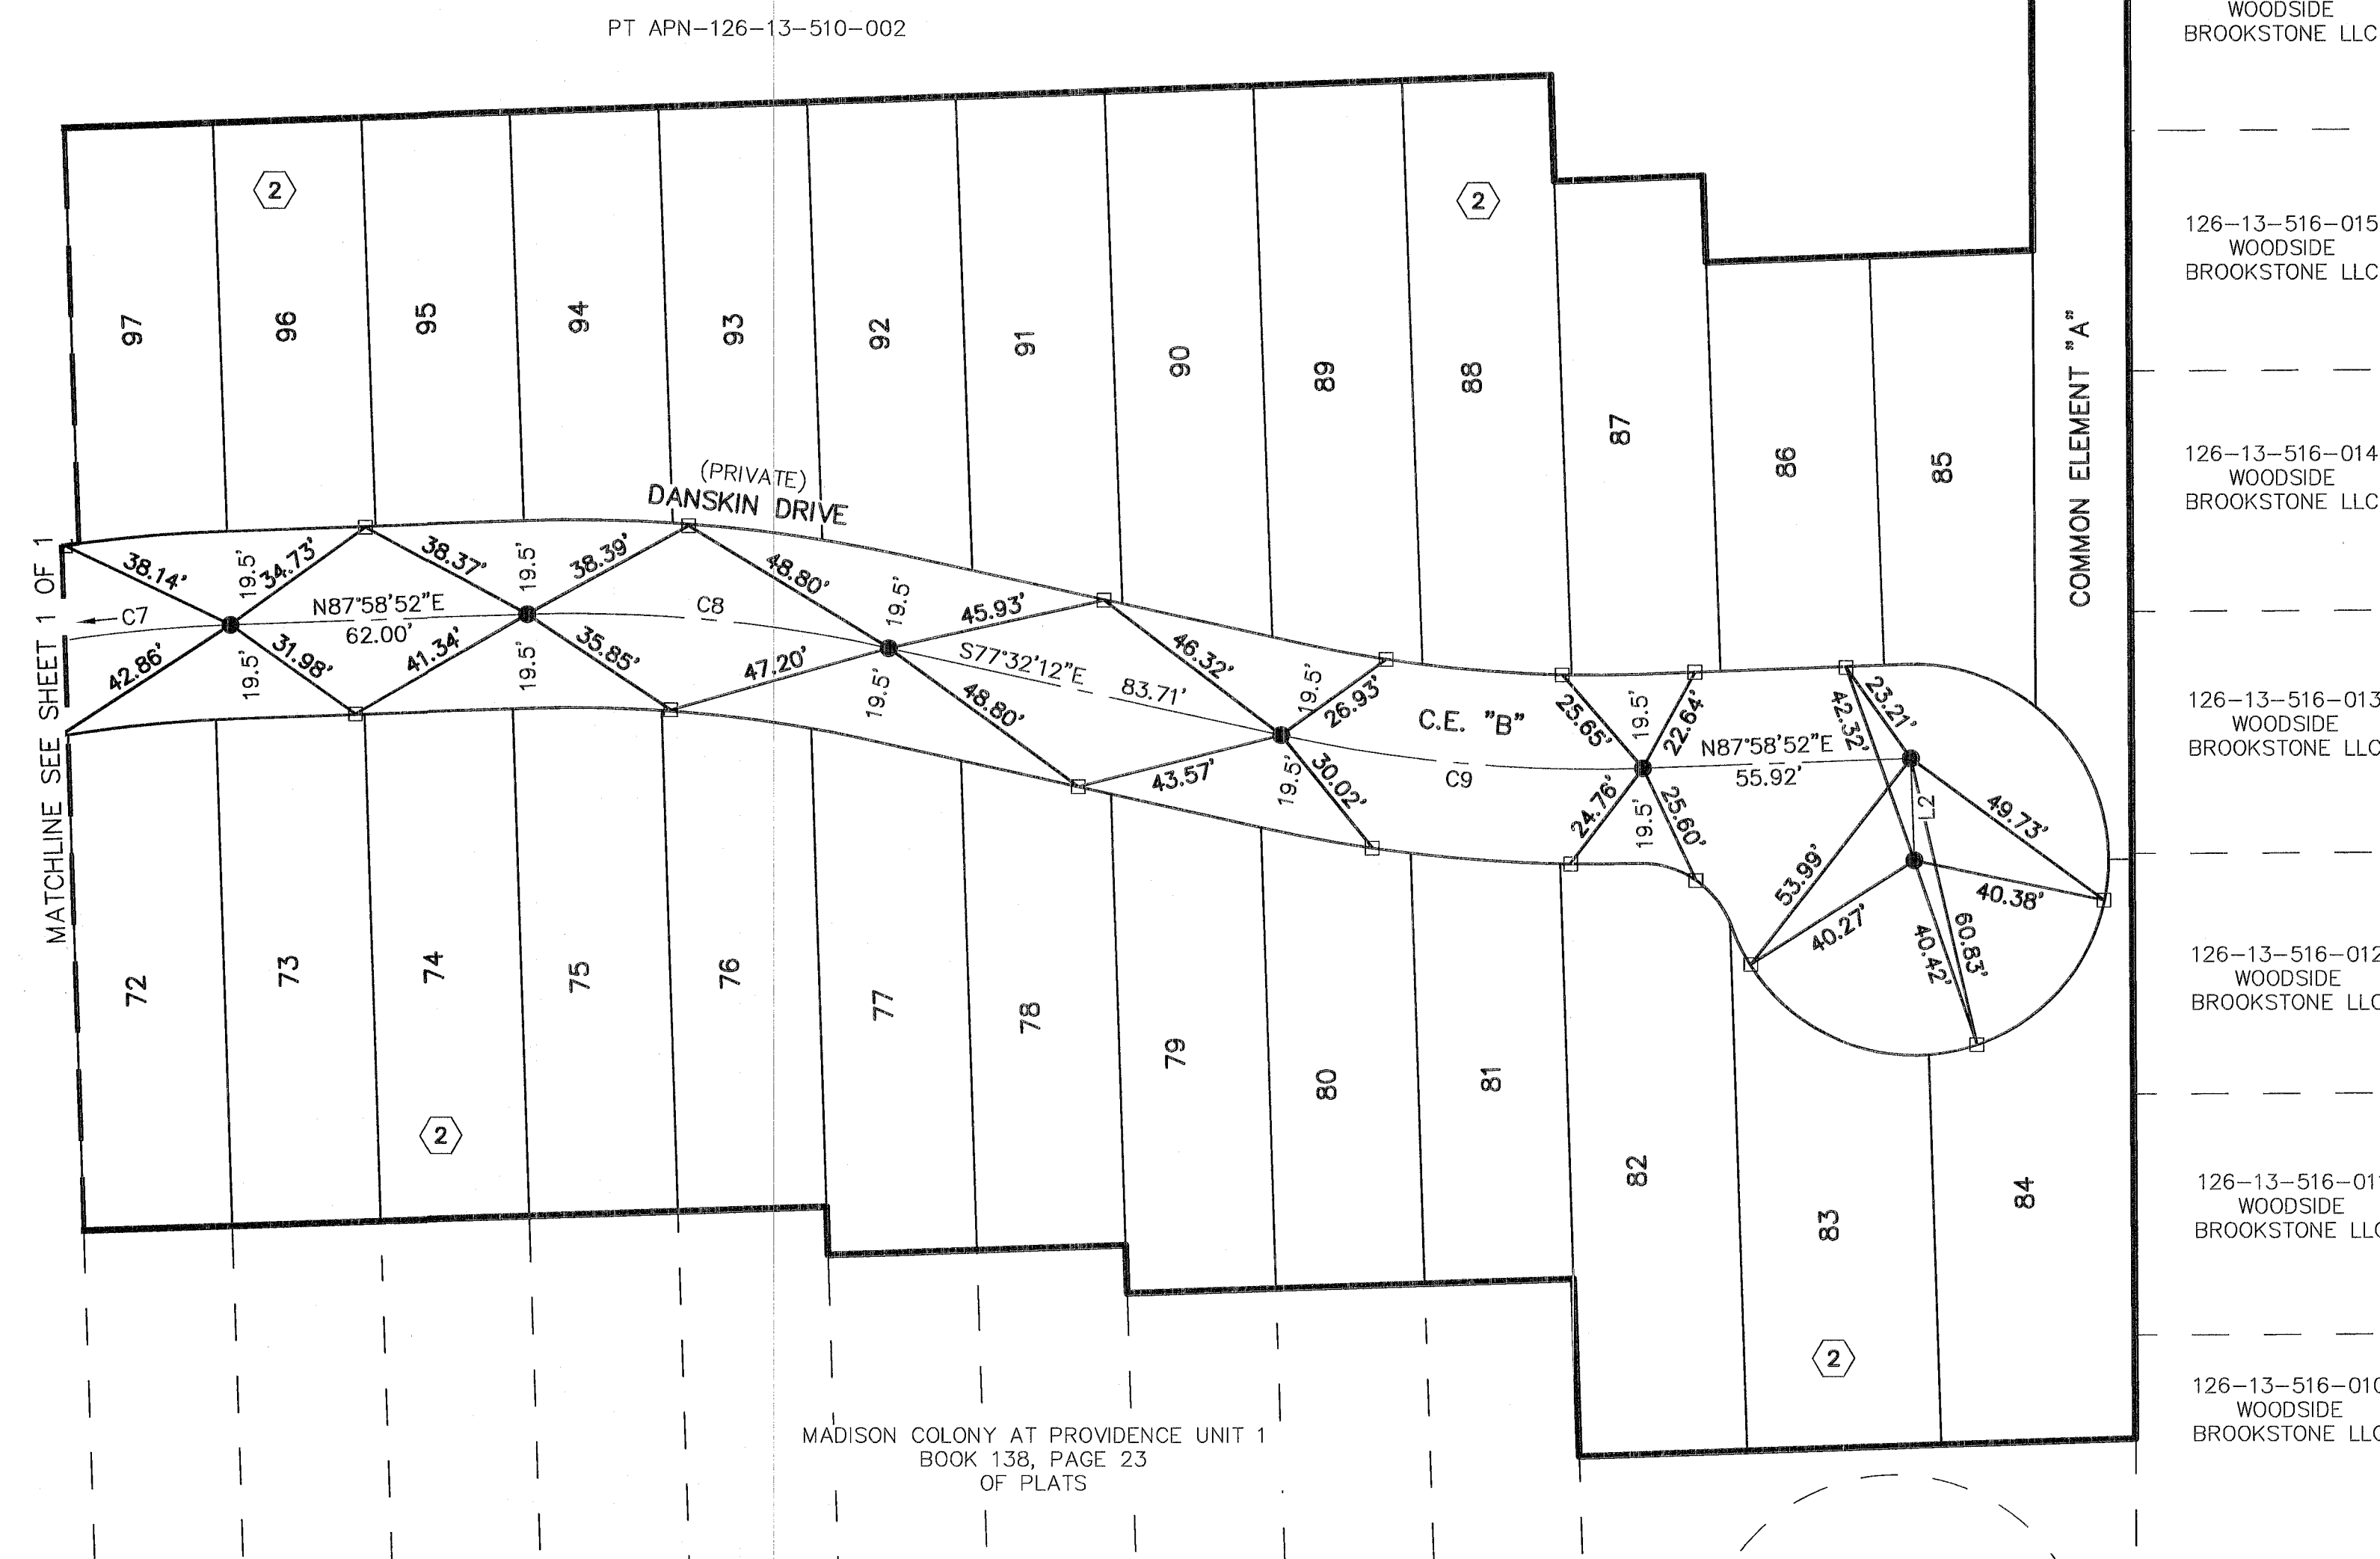

8-22-13

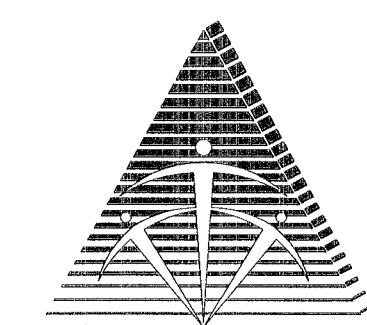

## TRI-CORE SURVEYING, LLC

LAND SURVEYING • CONSTRUCTION STAKING  
MAPPING & LAND DEVELOPMENT SERVICES  
BOUNDARY & TOPOGRAPHIC SURVEYS  
6761 WEST CHARLESTON BLVD.  
LAS VEGAS, NEVADA 89146  
TEL. (702) 821-1554 FAX (702) 870-4378

FMP-22262

BOOK 141, PAGE 34 OF PLATS SHEET 2 OF 2

2866  
JOB# 01007.0003