

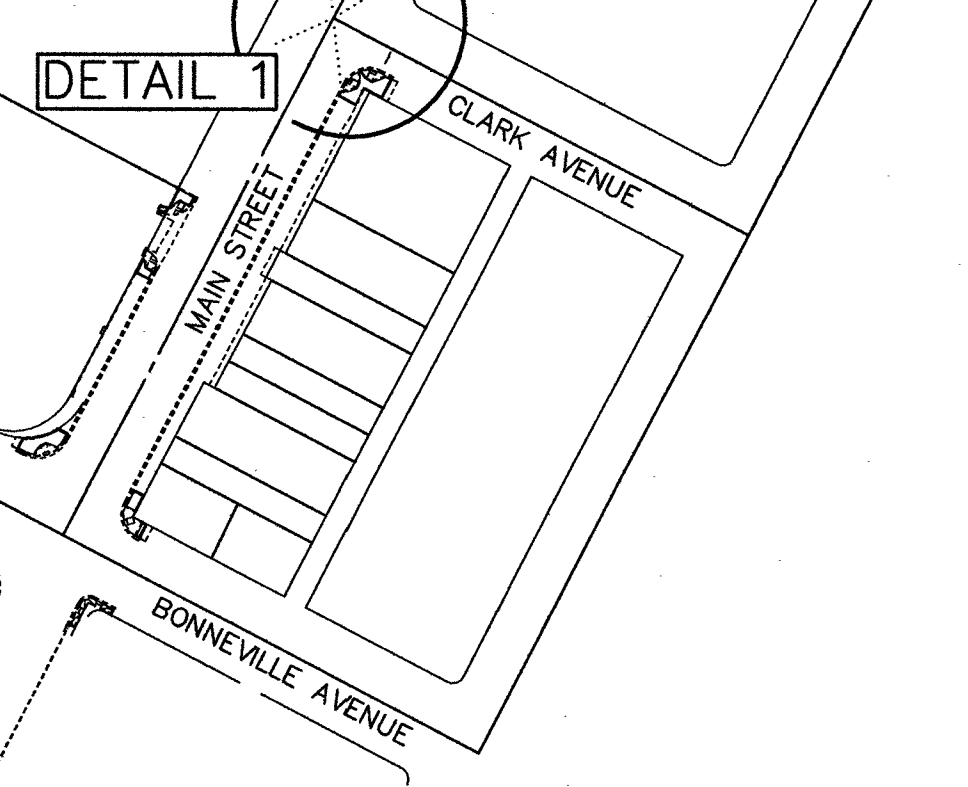
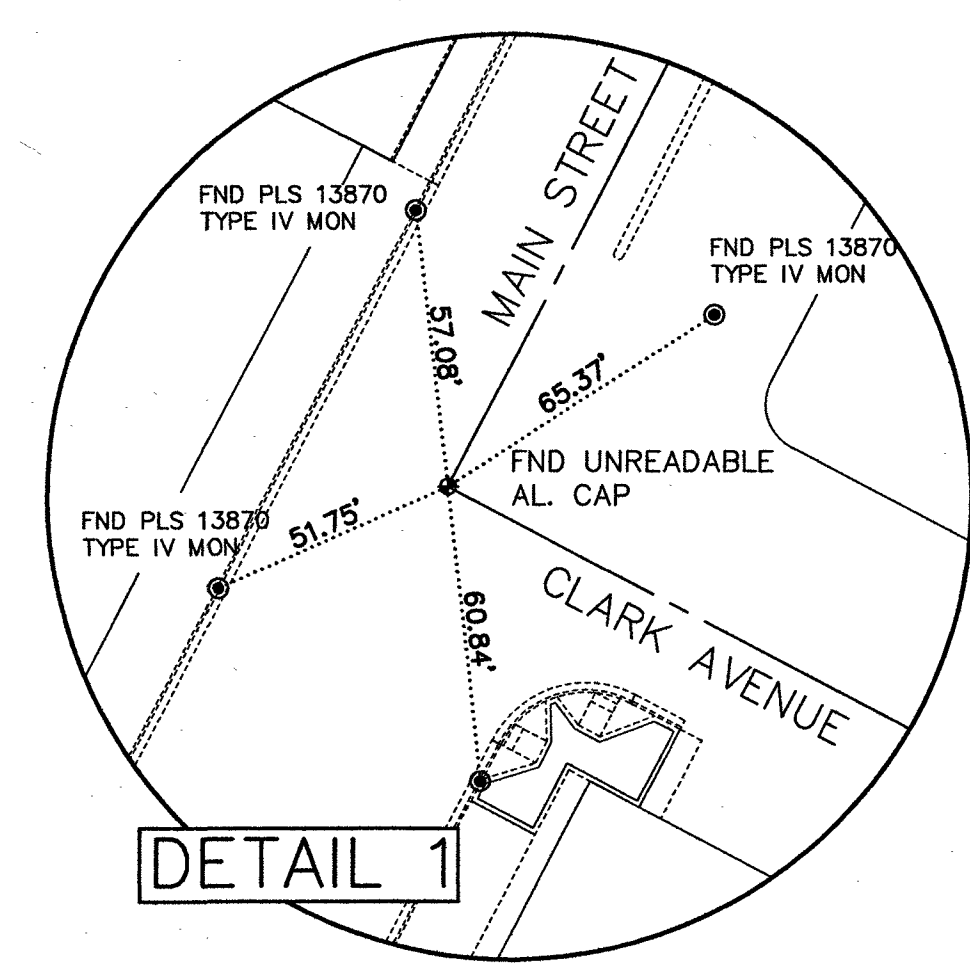
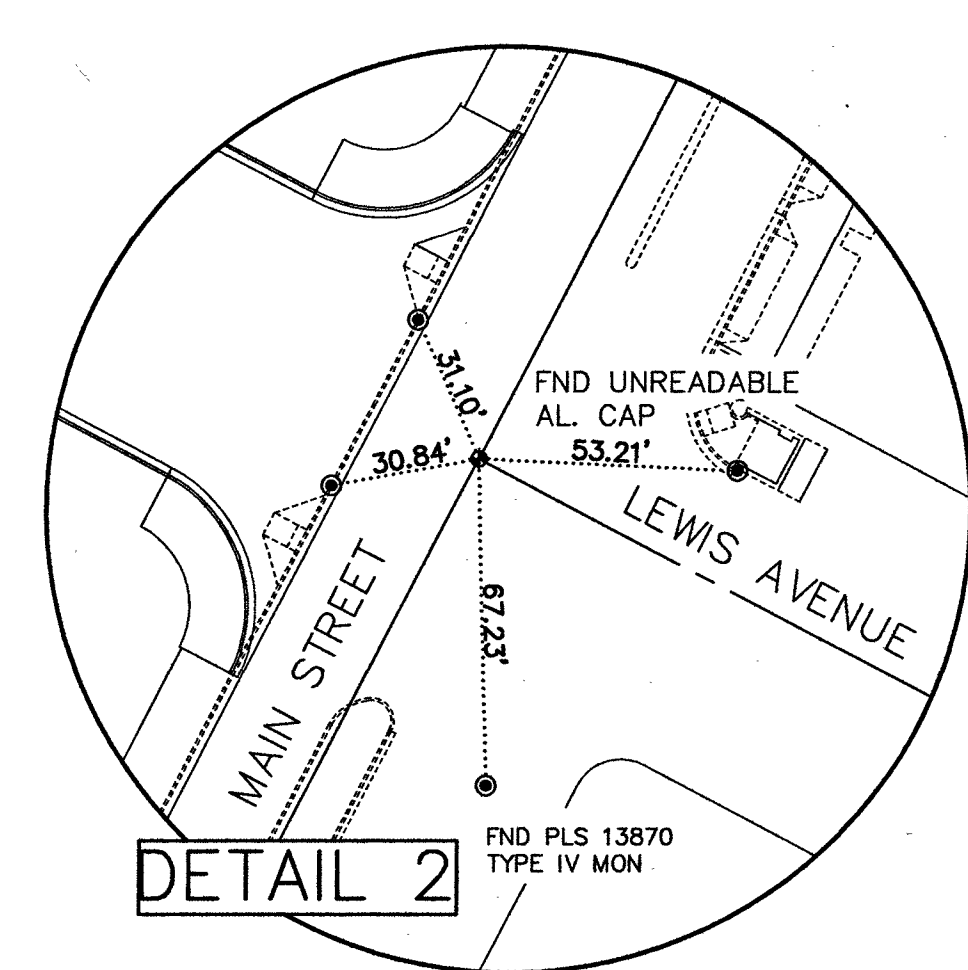
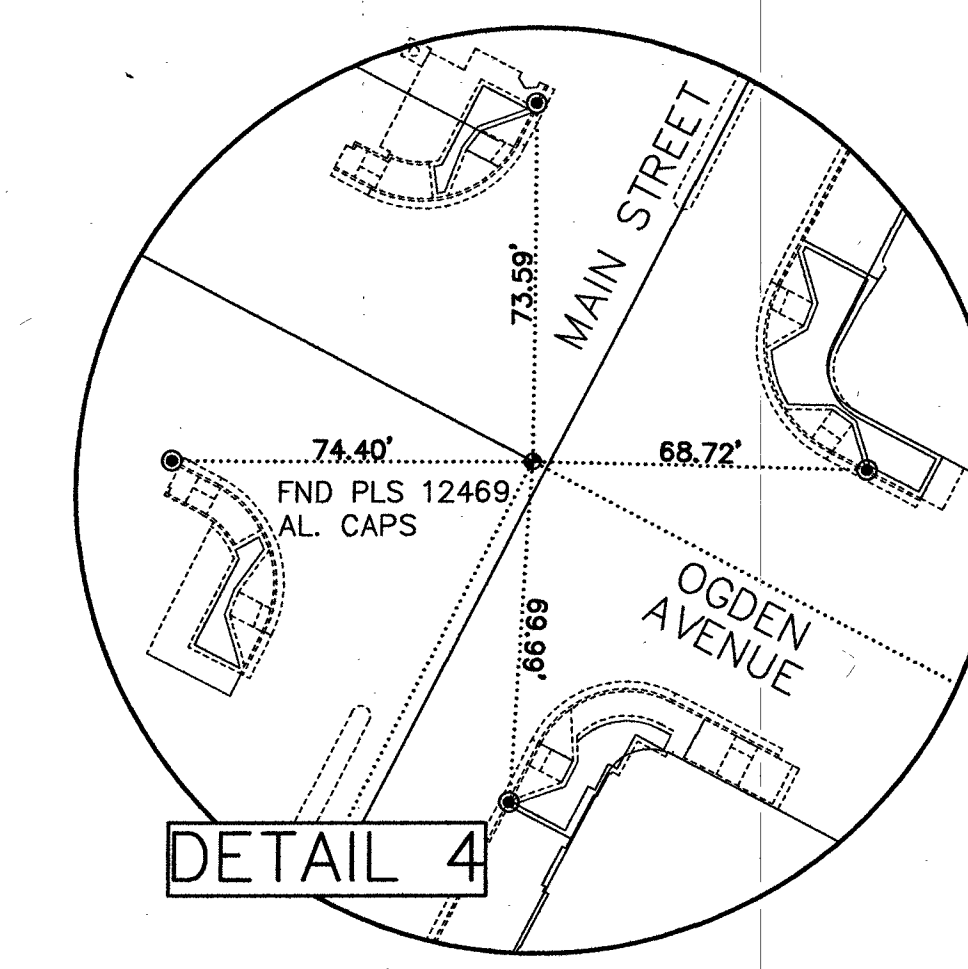
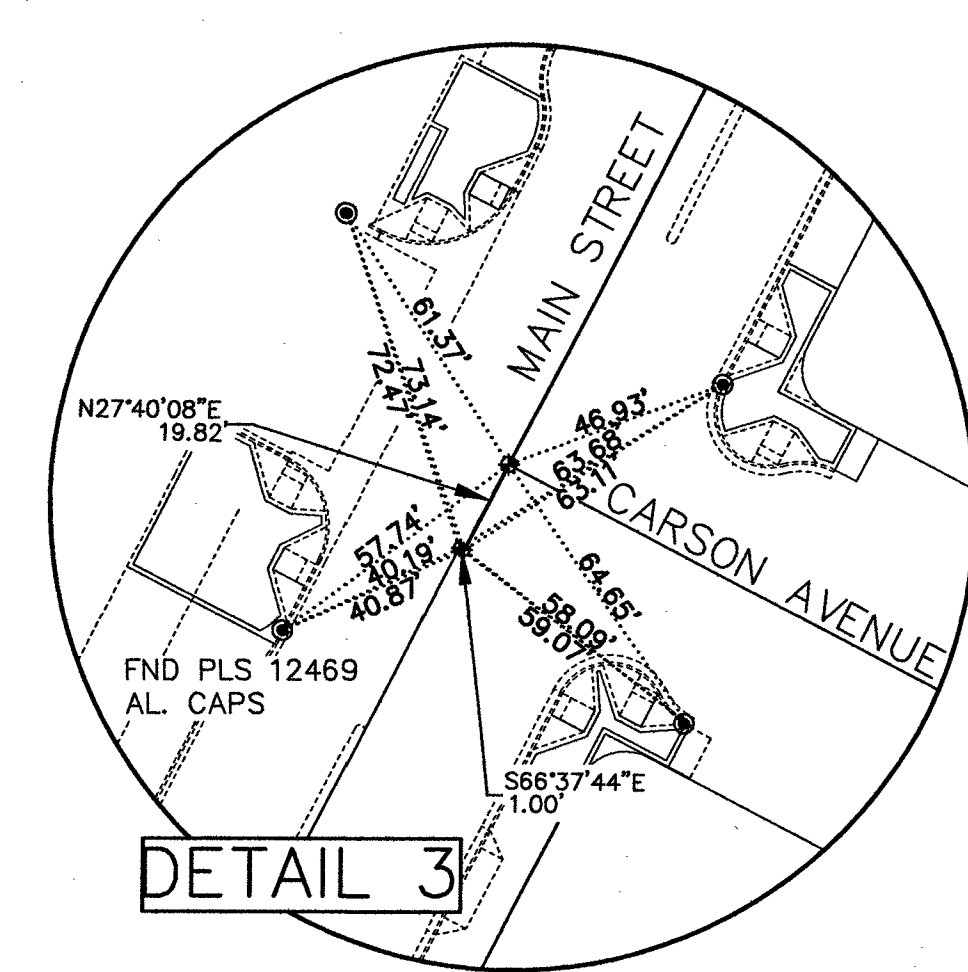
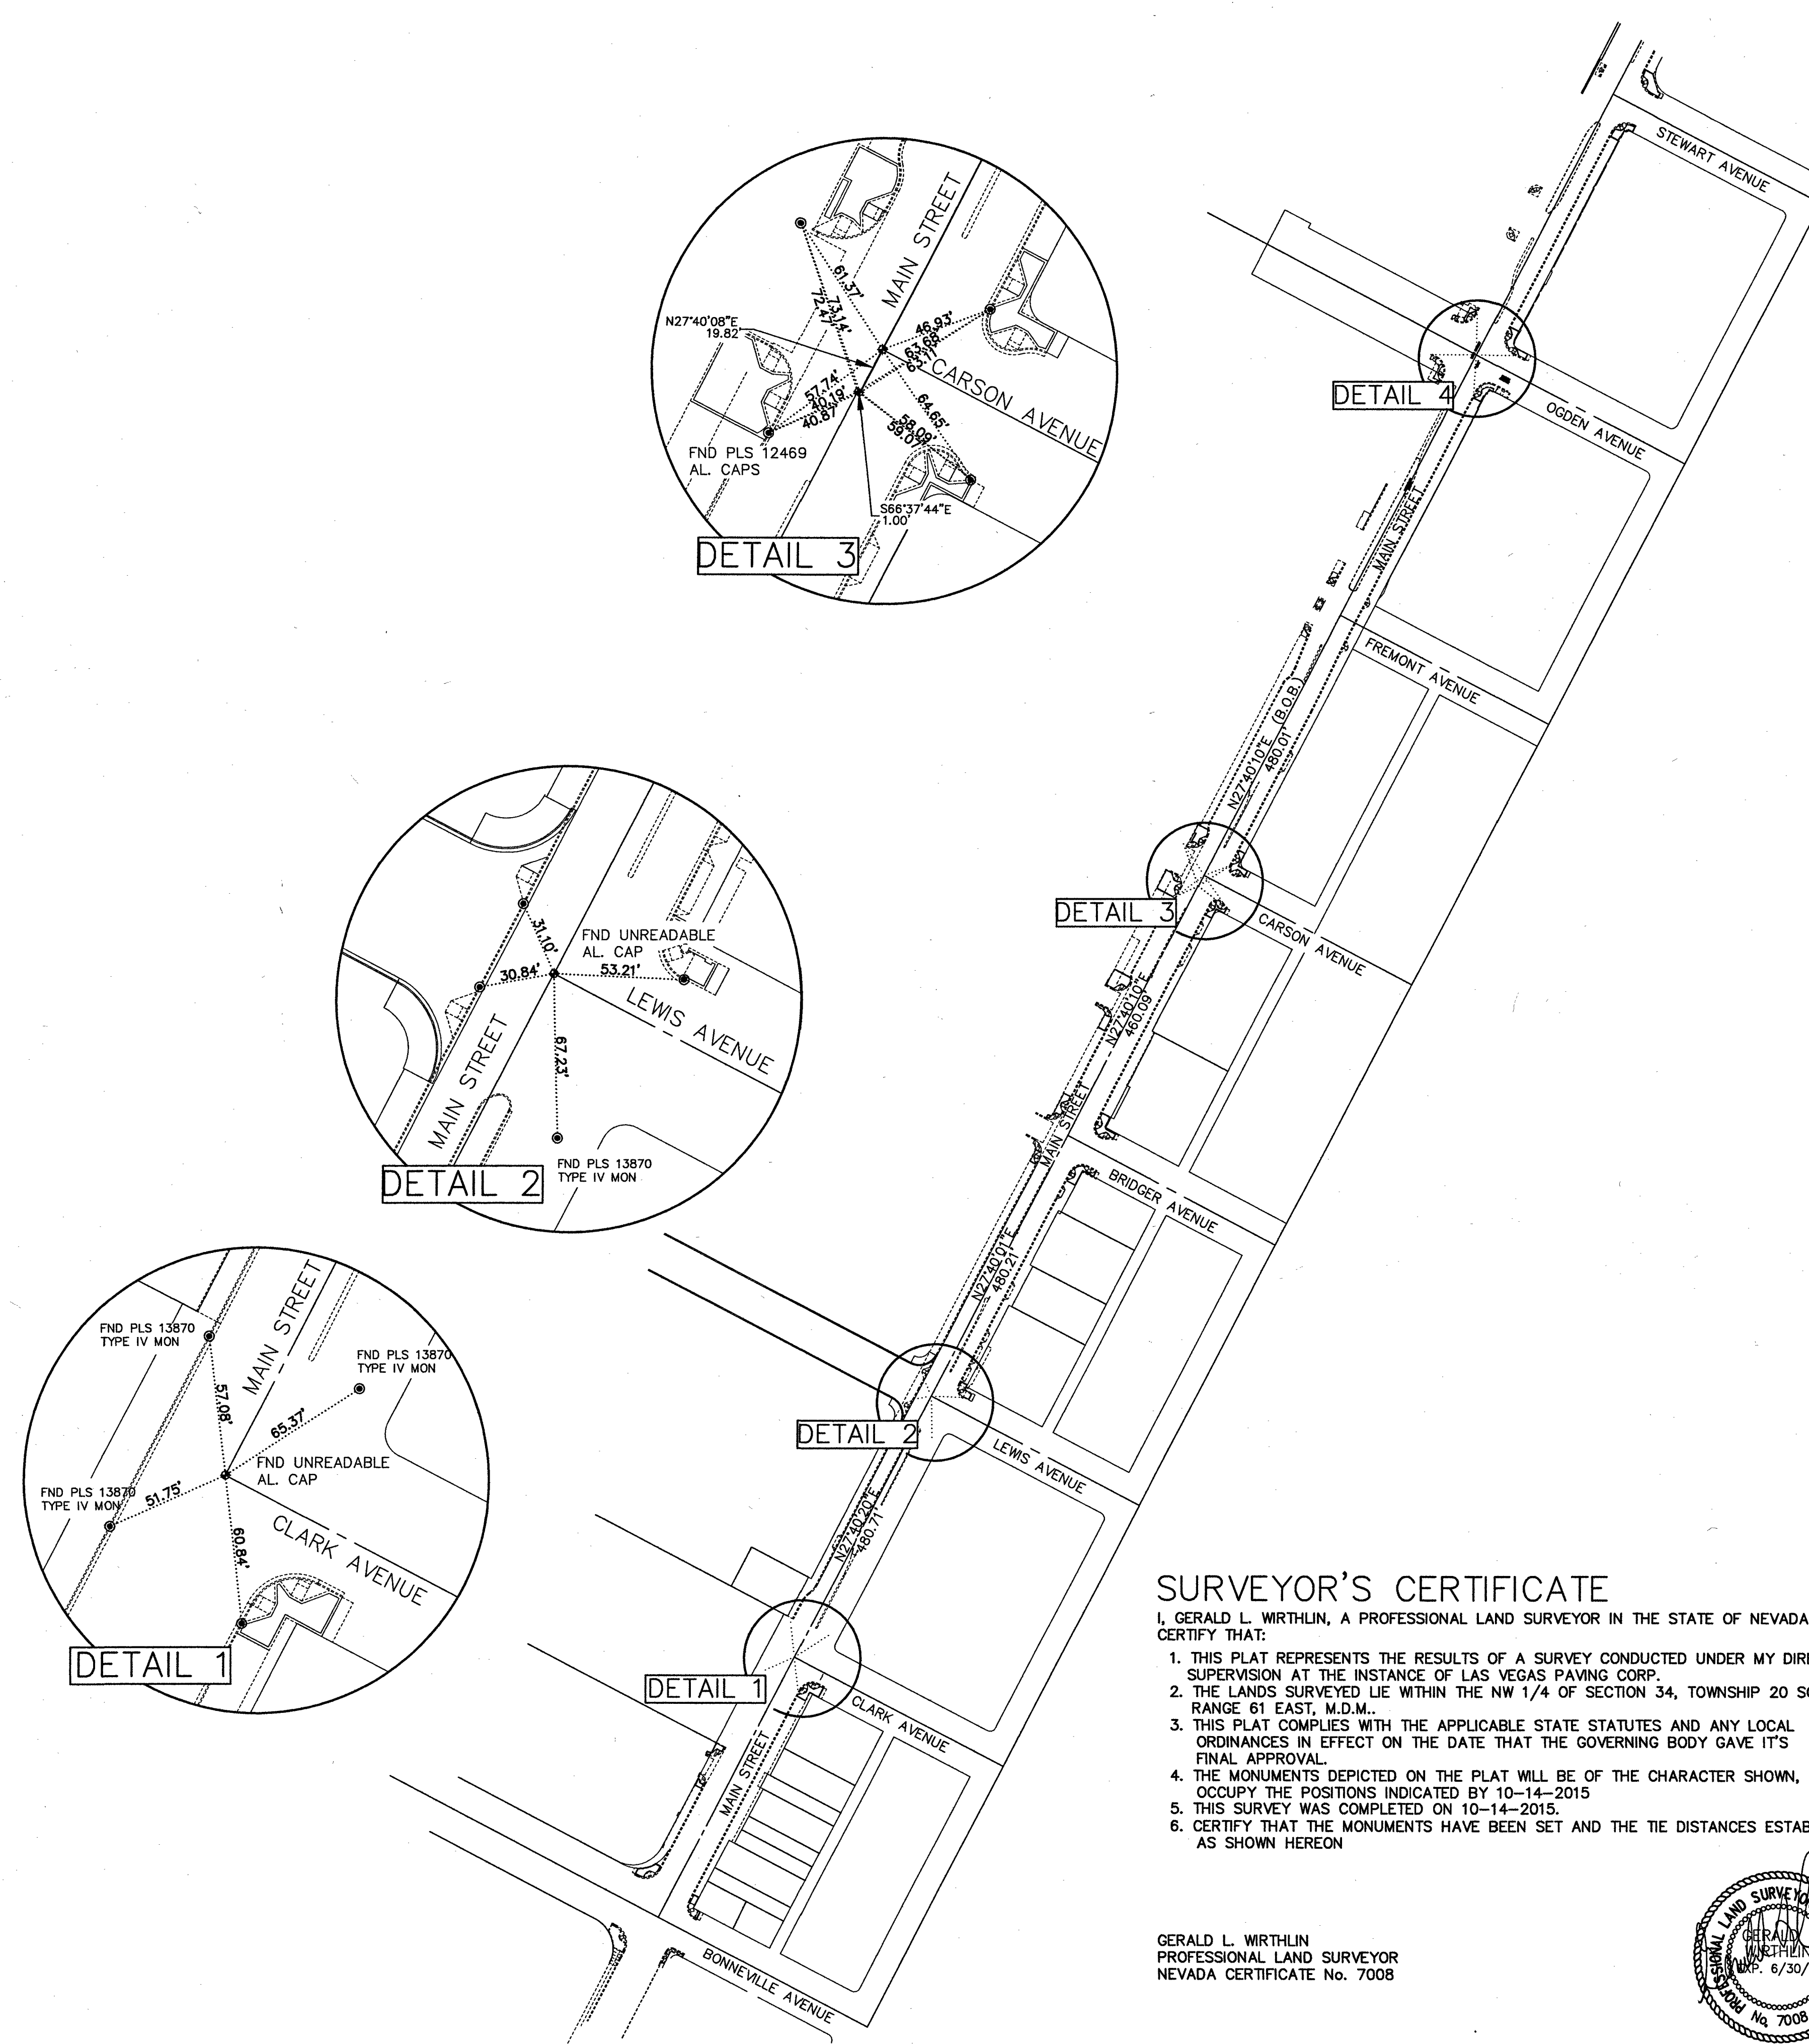


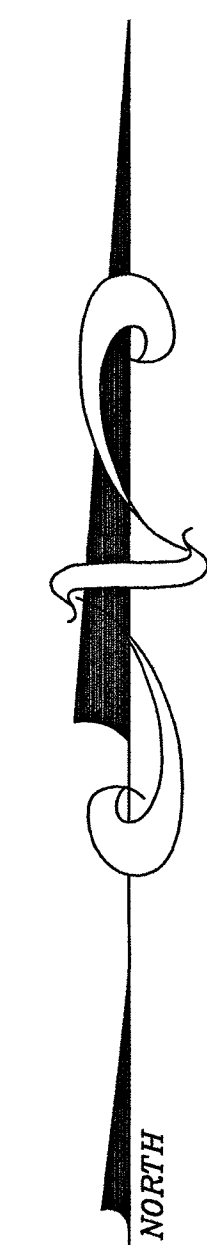


BASIS OF BEARINGS
THE BASIS OF BEARINGS FOR THIS SURVEY IS THE CENTERLINE OF MAIN STREET BETWEEN CARSON AVE. and OGDEN AVE. AS SHOWN IN FILE 184, PAGE 25 OF RECORDED SURVEYS, OFFICIAL RECORDS, CLARK COUNTY, NEVADA. SAID LINE BEARS N27°40'10\"/>

- LEGEND**
- ◆ SET TYPE III MON., PLS 7008 (DESCRIPTION SHOWN IN SCHEDULE REFLECTS MONUMENT FOUND PRIOR TO CONSTRUCTION)
 - SET PLS 7008 TYPE IV MON. or AS NOTED
 - CENTERLINE
 - - - - - TIE DISTANCE
 - - - - - CURB LINE

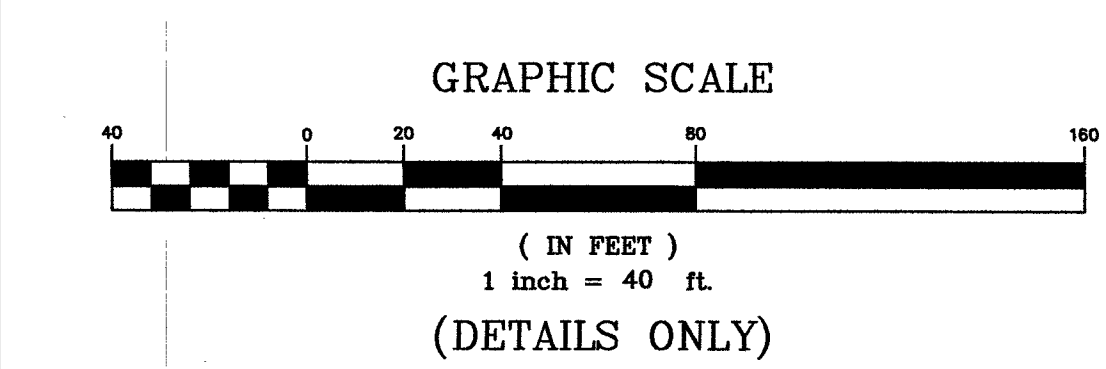

SURVEYOR'S CERTIFICATE
I, GERALD L. WIRTHLIN, A PROFESSIONAL LAND SURVEYOR IN THE STATE OF NEVADA, DO HEREBY CERTIFY THAT:
1. THIS PLAT REPRESENTS THE RESULTS OF A SURVEY CONDUCTED UNDER MY DIRECT SUPERVISION AT THE INSTANCE OF LAS VEGAS PAVING CORP.
2. THE LANDS SURVEYED LIE WITHIN THE NW 1/4 OF SECTION 34, TOWNSHIP 20 SOUTH, RANGE 61 EAST, M.D.M.
3. THIS PLAT COMPLIES WITH THE APPLICABLE STATE STATUTES AND ANY LOCAL ORDINANCES IN EFFECT ON THE DATE THAT THE GOVERNING BODY GAVE IT'S FINAL APPROVAL.
4. THE MONUMENTS DEPICTED ON THE PLAT WILL BE OF THE CHARACTER SHOWN, OCCUPY THE POSITIONS INDICATED BY 10-14-2015
5. THIS SURVEY WAS COMPLETED ON 10-14-2015.
6. CERTIFY THAT THE MONUMENTS HAVE BEEN SET AND THE TIE DISTANCES ESTABLISHED AS SHOWN HEREON

GERALD L. WIRTHLIN
PROFESSIONAL LAND SURVEYOR
NEVADA CERTIFICATE No. 7008

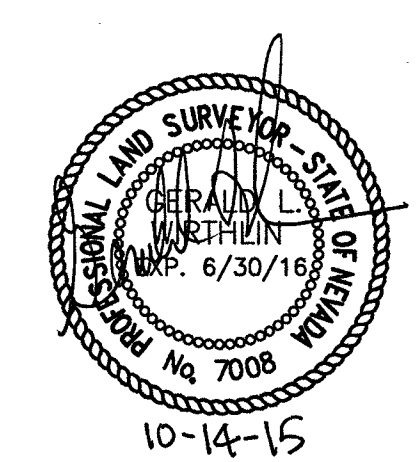

RECORDER'S NOTE
ANY SUBSEQUENT CHANGES TO THIS MAP SHOULD BE EXAMINED AND MAY BE DETERMINED BY REFERENCE TO THE COUNTY RECORDER'S CUMULATIVE MAP INDEX. N.R.S. 278.5695

RECORD OF SURVEY for MONUMENT PERPETUATION, lying within THE NW 1/4 OF SEC. 34, TOWNSHIP 20 SOUTH, RANGE 61 EAST, M.D.M. CLARK COUNTY, NEVADA		No. _____ FILED AT THE REQUEST OF: LAS VEGAS PAVING CORP. DATE: _____ AT _____ M. FILE: _____ PAGE: _____ OF SURVEYS OFFICIAL RECORDS BOOK No. _____ CLARK COUNTY, NEVADA RECORDS DEBBIE CONWAY, RECORDER FEE: _____ DEPUTY
LAS VEGAS PAVING CORPORATION		
LAS VEGAS PAVING CORP. GERALD "CROCKETT" WIRTHLIN PLS #7008	(702) 649-0009 OFFICE (702) 353-4363 MOBILE	

154970