
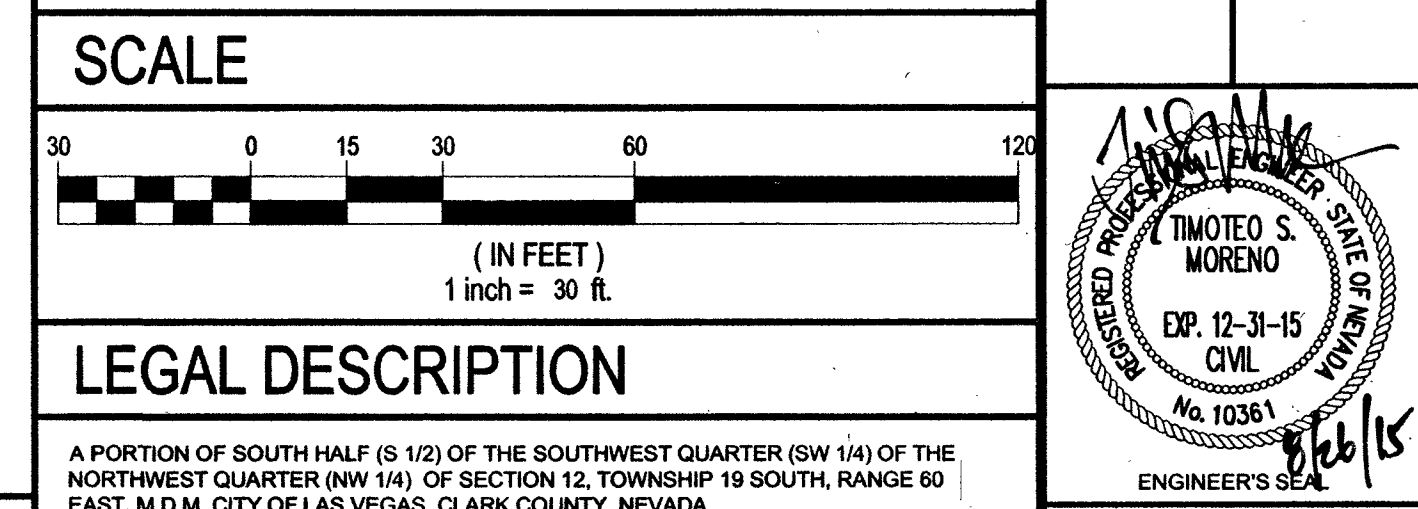
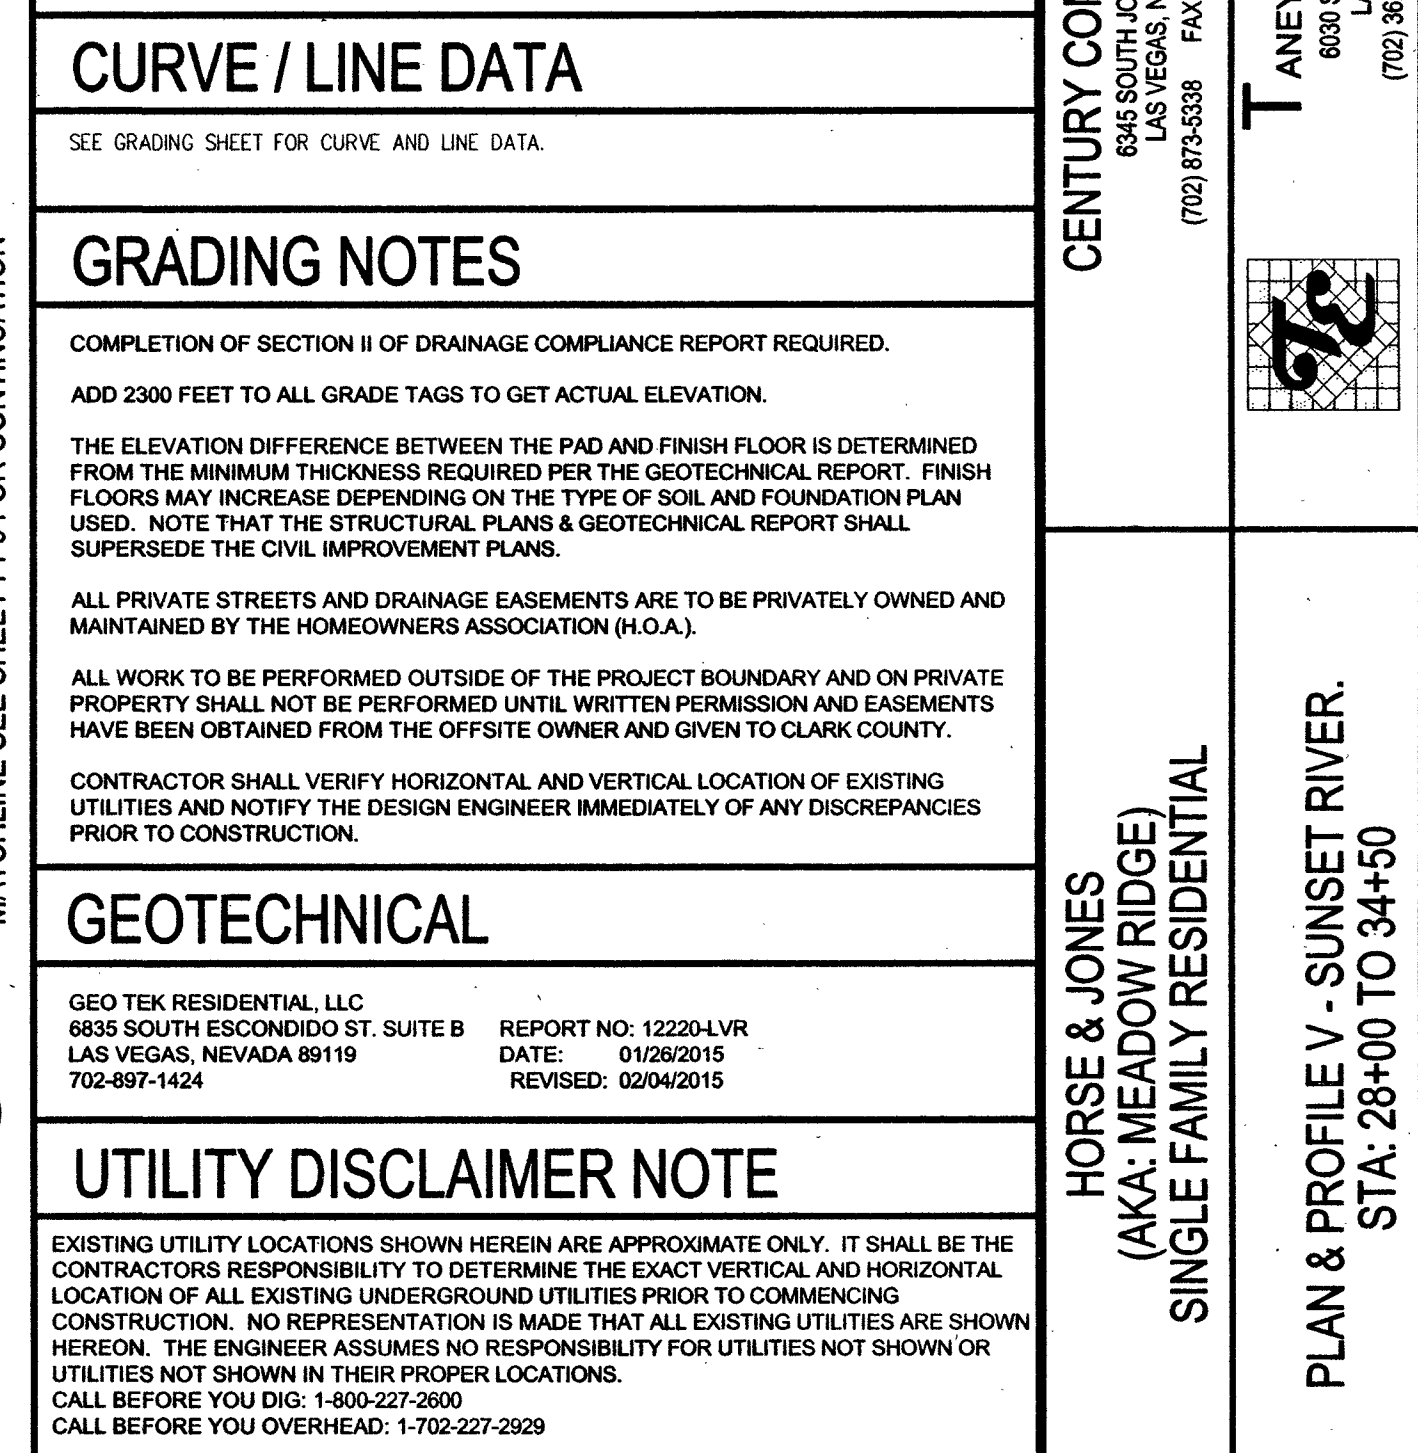
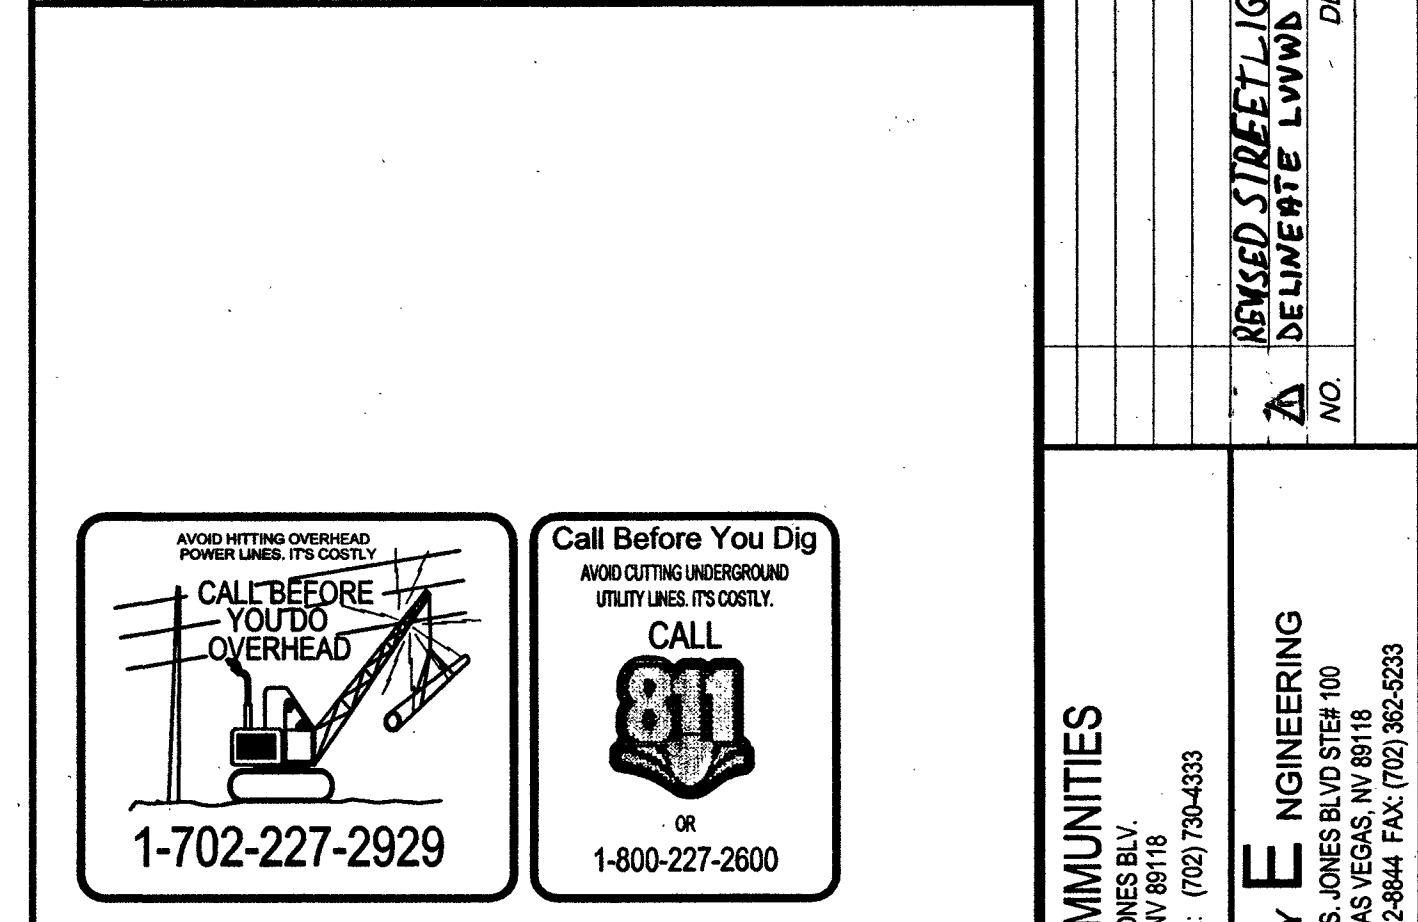


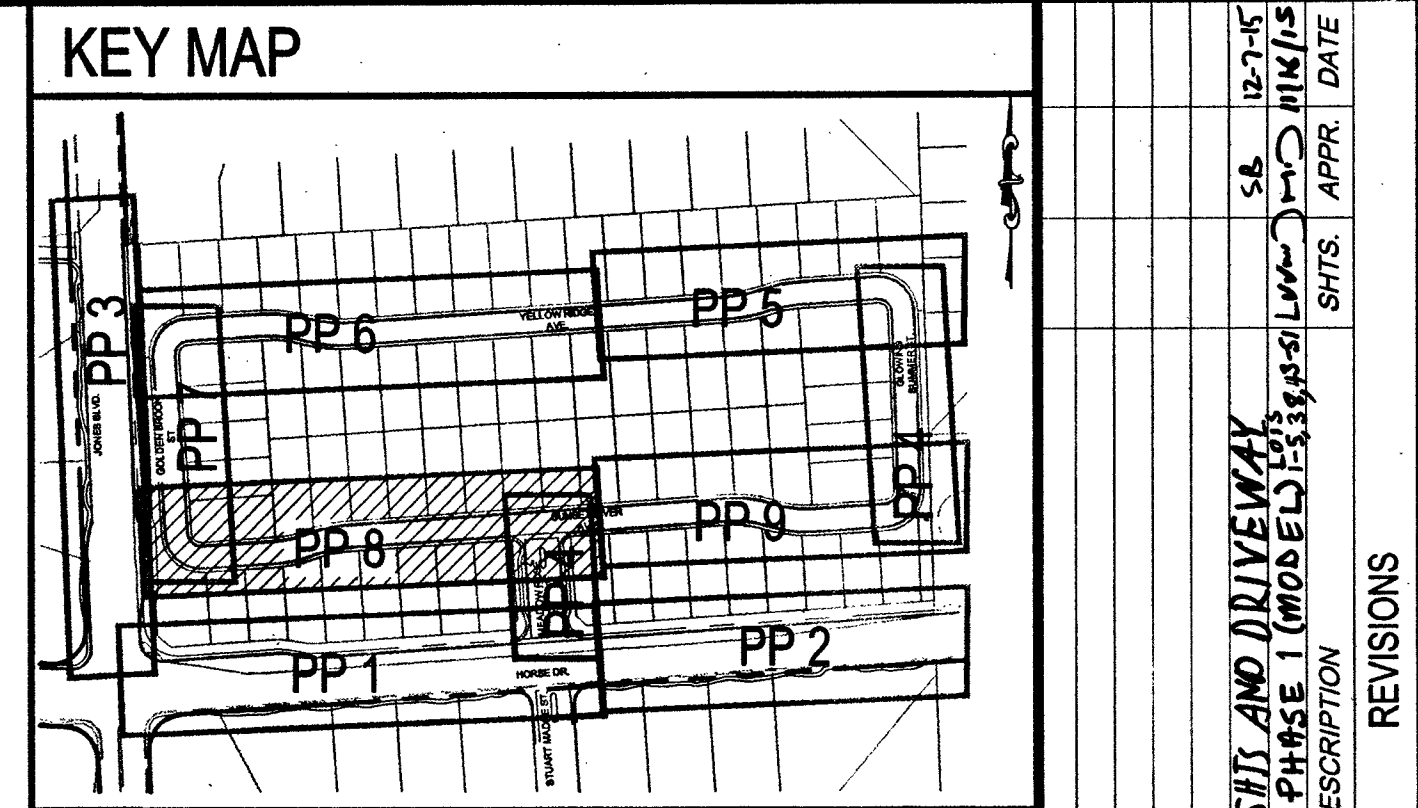

BASIS OF BEARINGS NORTH 01°47'03" WEST, BEING THE WEST LINE OF THE SOUTHEAST QUARTER (SE 1/4) OF THE NORTHWEST QUATER (NW 1/4) OF SECTION 12, TOWNSHIP 19 SOUTH, RANGE 80 EAST, M.D.M., AS SHOWN ON THAT CERTAIN MAP ON FILE IN THE OFFICE OF THE COUNTY RECORDER, CLARK COUNTY, NEVADA, IN FILE 93 OF PARCEL MAPS, AT PAGE 69. BENCHMARK CLV BM #: SLV901274 RIVET AND PLATE IN TOP OF CURB SOUTH EAST CORNER OF HORSE DR. & JONES BLVD. 722.588m/2370.69FT (NAVD 88 DATUM)	DATE: 8/24/2015
	SCALE: 1"=30'
	JOB NO: CYC-14-003
	DESIGNED BY: CA
	CHECKED BY: TSM
	SHEET NAME: PP8
	SHEET: 15 OF 25 10745030
	HW: 59831

APPROVED FOR CONSTRUCTION

- | | | | |
|----|---|----|---|
| 1 | 2.5" AC PAVEMENT OVER 7.0" TYPE II (PER GEOTECHNICAL REPORT) | 16 | INSTALL WROUGHT IRON GATE PER DETAIL "M" - SHEET GD 1 |
| 2 | INSTALL "A" TYPE CURB (USD #219) | 17 | INSTALL RIP RAP (D50 = 8" TO THICK) |
| 3 | INSTALL 24" TYPE CUREB & GUTTER (USD #216) | 18 | 2" RAISED CONCRETE PER DETAIL "N" - SHEET GD 1 |
| 4 | SIDEWALK RAMP USING AR300 OR TRUNCATED DORIES OR EQUIVALENT (USD #235 CASE I)
A=8.00', B=8.00' | 19 | INSTALL CONCRETE PER SECTION "J" - SHEET GD 1 |
| 5 | NOT USED | 20 | INSTALL FLUME PER DETAIL "O" - SHEET GD 1 |
| 6 | INSTALL 6" WIDE CROSS GUTTER (USD #226) | 21 | SAW CUT AND REMOVE EXISTING AC PAVEMENT TO INSTALL STORM DRAIN LINE. (UDACS PLT. 17) (SAW CUT & REPAIRMENT ARE TO BE DETERMINED INSPECTOR). |
| 7 | 4.5" AC PAVEMENT OVER 4.0" TYPE II OVER 9.0" TYPE I (PER GEOTECHNICAL REPORT) | 22 | INSTALL GATE (DESIGN BY OTHERS) |
| 8 | 6.5" AC PAVEMENT OVER 4.0" TYPE II OVER 13.5" TYPE I (PER GEOTECHNICAL REPORT) | 23 | INSTALL RESIDENTIAL DRIVEWAY (UDACS PLT. 223) |
| 9 | 4" THICK CONCRETE SIDEWALK (USD #234) | 24 | INSTALL PAVERS (DESIGN BY OTHERS) |
| 10 | SAWCUT AND REMOVE EXISTING AC PAVEMENT | 25 | WROUGHT IRON FENCE (DESIGN BY OTHERS) |
| 11 | INSTALL BUS TURN-OUT (USD #231) | | NOTE: |
| 12 | INSTALL SIDEWALK UNDERDRAIN (USD #236) | | ALL NEW STORM DRAIN DROP INLETS SHALL BE |
| 13 | EX. SIDEWALK RAMP (PROTECT IN PLACE) | | CONSTRUCTED PER THE NEWLY ADOPTED UTILITY |
| 14 | CONNECT PROPOSED 18" SD TO EX. STORM DRAIN MANHOLE | | DRAWING NUMBER 421 (STORM QUALITY MANAGEMENT |
| 15 | INSTALL TYPE "CM" DROP INLET (USD #421 & 422) AND DETAIL "L" - SHEET GD 1 | | STAMP & SIGN DETAIL). |