


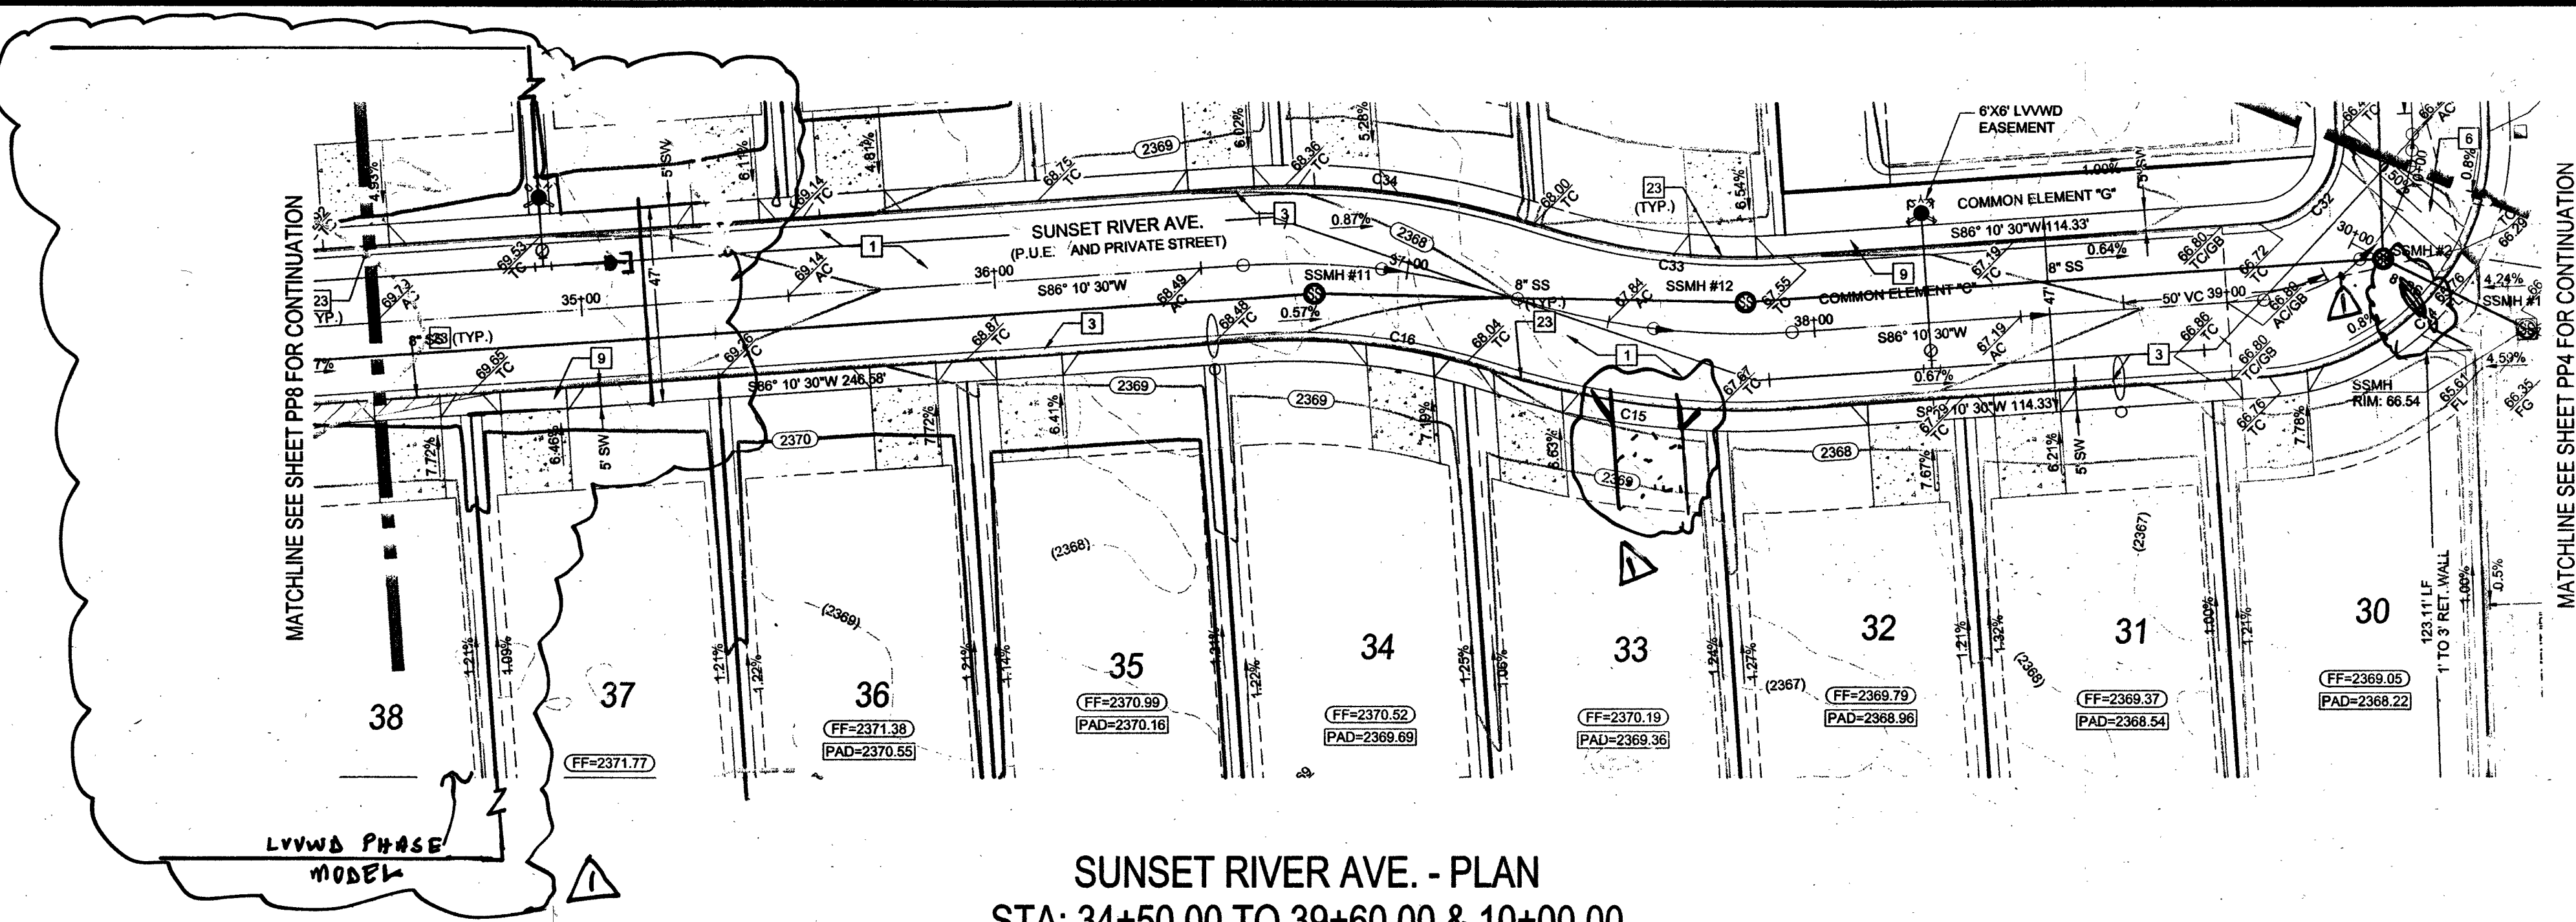


SUNSET RIVER AVE. - PLAN
STA: 34+50.00 TO 39+60.00 & 10+00.00

HIGH POINT ELEV: 2370.02
HIGH POINT STA: 34+05.65
PVI STA: 34+00.00
PVI ELEV: 2370.12
AD: 1.68%
K: 29.77
50.00' VC

MATCHLINE SEE SHEET PP8 FOR CONTINUATION

MATCHLINE SEE SHEET PP4 FOR CONTINUATION

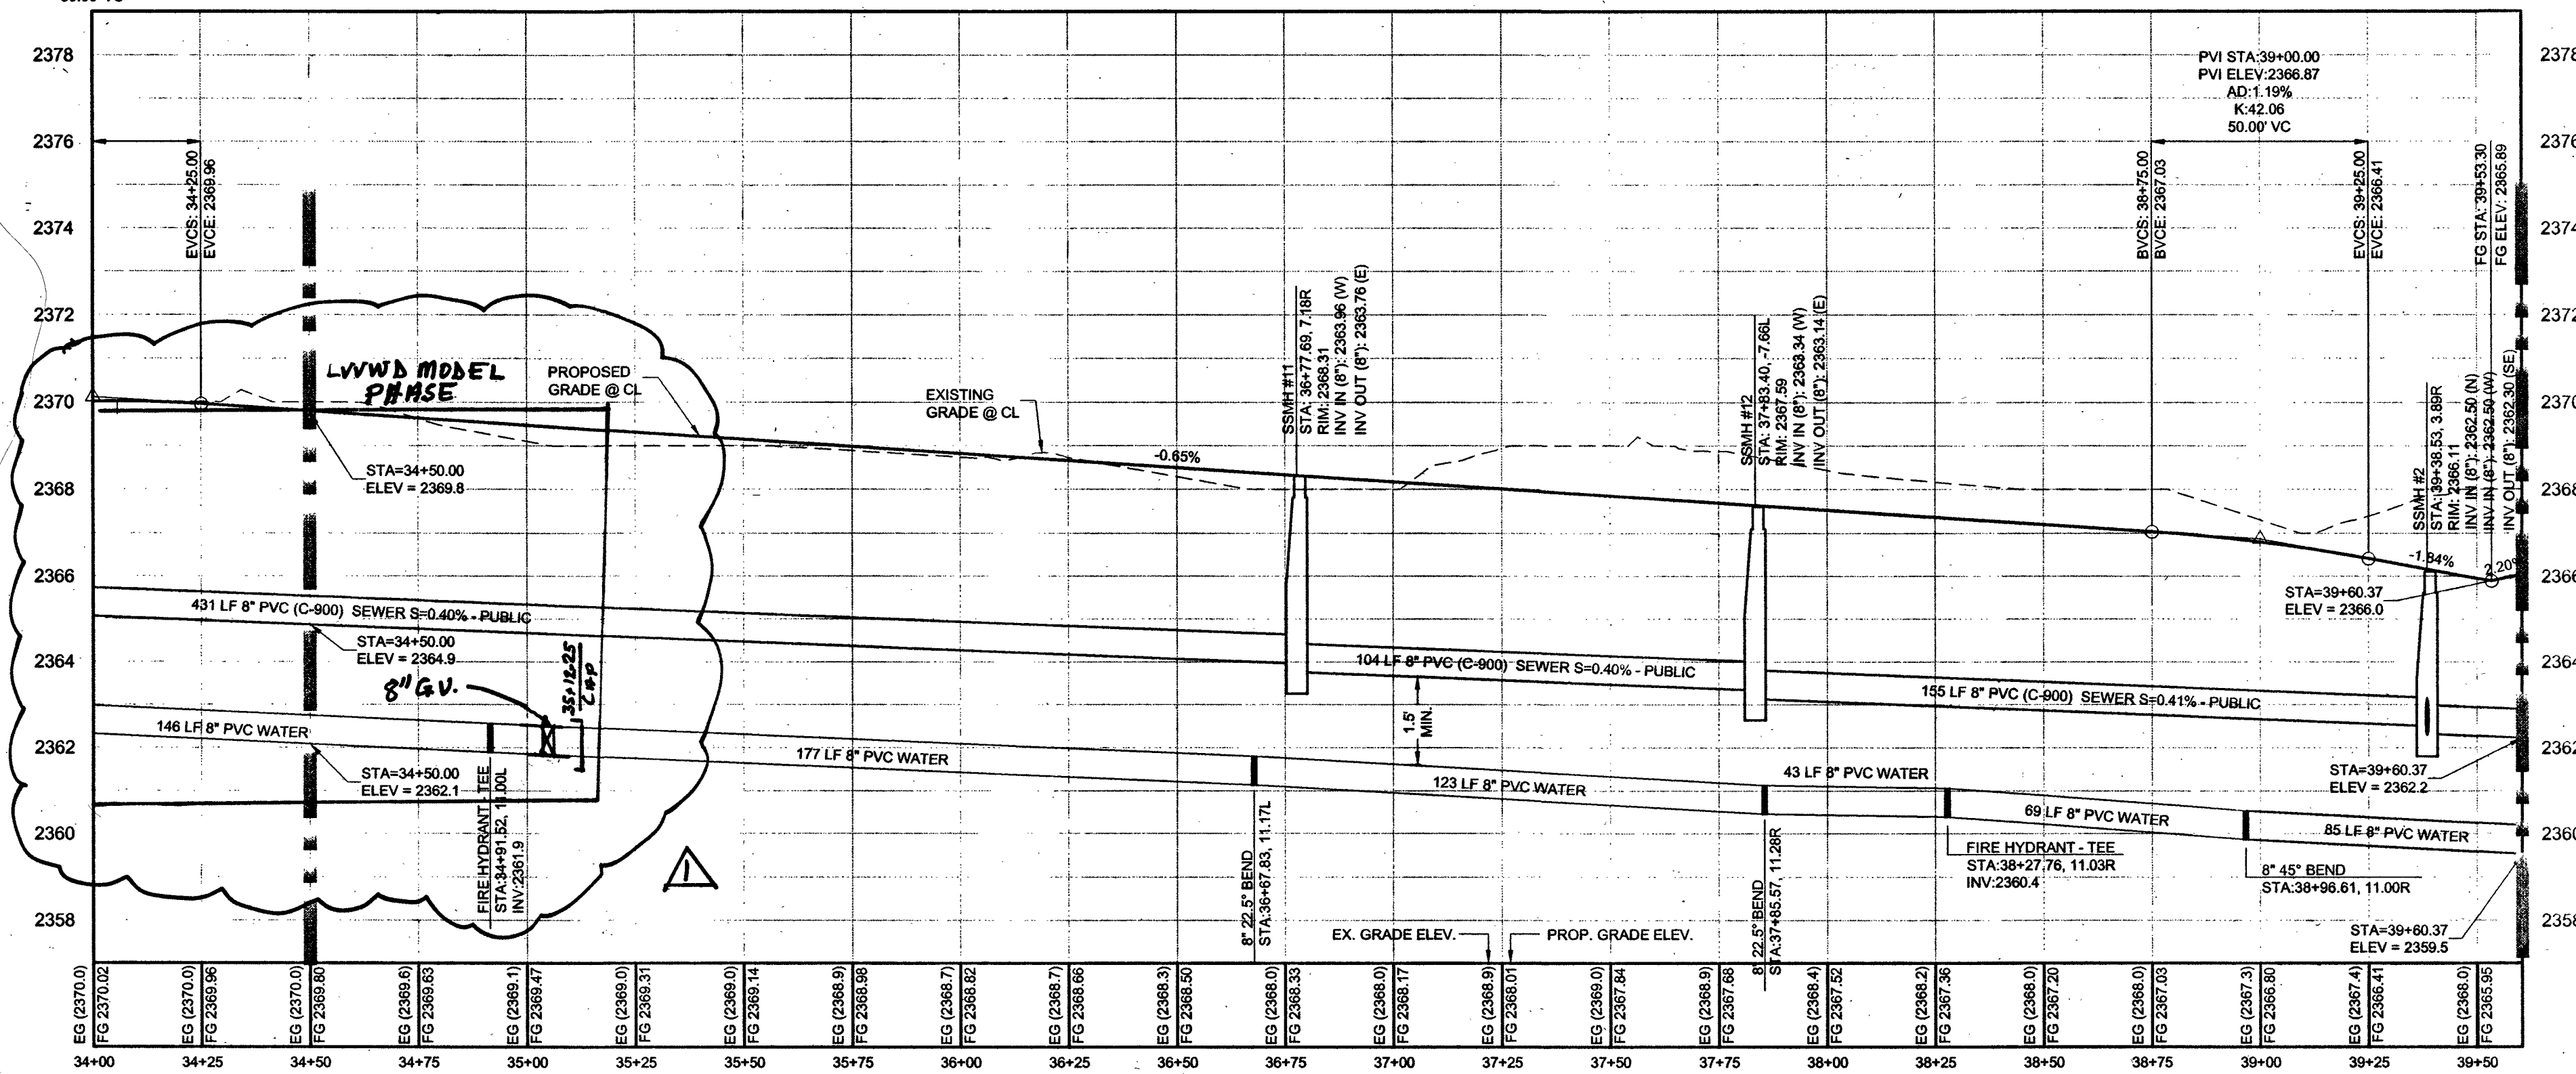

SUNSET RIVER AVE. - PROFILE
STA: 34+50.00 TO 39+60.00 & 10+00.00
SCALE: 1"=30' HORIZ., 1"=3' VERT.

MINIMUM 24" COVER PER UDACS SEC. 2.08.04
GRADING MUST BE COMPLETED PRIOR TO
WATERLINE INSTALLATION (typ)

APPROVED FOR CONSTRUCTION


Disbarrier
LAS VEGAS VALLEY WATER DISTRICT ENGINEERING SERVICES MANAGER
PROJECT NO.: 123786 DATE: 9/19/15

CONSTRUCTION NOTES

1. 2.5" AC PAVEMENT OVER 7.0" TYPE II (PER GEOTECHNICAL REPORT)
2. INSTALL "A" TYPE CURB (USD #219)
3. INSTALL 24" L-TYPE CURB & GUTTER (USD #218)
4. SIDEWALK RAMP USING ARMOR TILE TRUNCATED DOMES OR EQUIVALENT (USD #235 CASE I)
A=8.00', B=8.00'
5. NOT USED
6. INSTALL 8" WIDE CROSS GUTTER (USD #238)
7. 4.5" AC PAVEMENT OVER 4.0" TYPE II OVER 9.0" TYPE I (PER GEOTECHNICAL REPORT)
8. 5.5" AC PAVEMENT OVER 4.0" TYPE II OVER 13.5" TYPE I (PER GEOTECHNICAL REPORT)
9. 4" THICK CONCRETE SIDEWALK (USD #234)
10. SAWCUT AND REMOVE EXISTING AC PAVEMENT
11. INSTALL BUS TURN-OUT (USD #424.1)
12. INSTALL SIDEWALK UNDERDRAIN (USD #236)
13. EX. SIDEWALK RAMP (PROTECT IN PLACE)
14. CONNECT PROPOSED 18" SD TO EX. STORM DRAIN MANHOLE
15. INSTALL TYPE "CM" DROP INLET (USD #421 & 422) AND DETAIL "L" - SHEET GD 1.
16. INSTALL WROUGHT IRON GATE PER DETAIL "M" - SHEET GD 1
17. INSTALL RIP RAP (D50 = 8", 16" THICK)
18. 2" RAISED CONCRETE PER DETAIL "N" - SHEET GD 1
19. INSTALL CONCRETE PER SECTION "P" - SHEET GD 1
20. INSTALL FLUME PER DETAIL "O" - SHEET GD 1
21. SAW CUT AND REMOVE EXISTING AC PAVEMENT TO INSTALL STORM DRAIN LINE (UDACS PLOT 17) (SAW CUT & REPAVEMENT ARE TO BE DETERMINED INSPECTOR)
22. INSTALL GATE (DESIGN BY OTHERS)
23. INSTALL RESIDENTIAL DRIVEWAY (UDACS PLOT 223)
24. INSTALL PAVERS (DESIGN BY OTHERS)
25. WROUGHT IRON FENCE (DESIGN BY OTHERS)

NOTE:
ALL NEW STORM DRAIN DROP INLETS SHALL BE
CONSTRUCTED PER THE NEWLY ADAPTED UDCCA
DRAWING NUMBER 421 (STORM QUALITY MANAGEMENT
STAMP & SIGN DETAIL).

KEY MAP

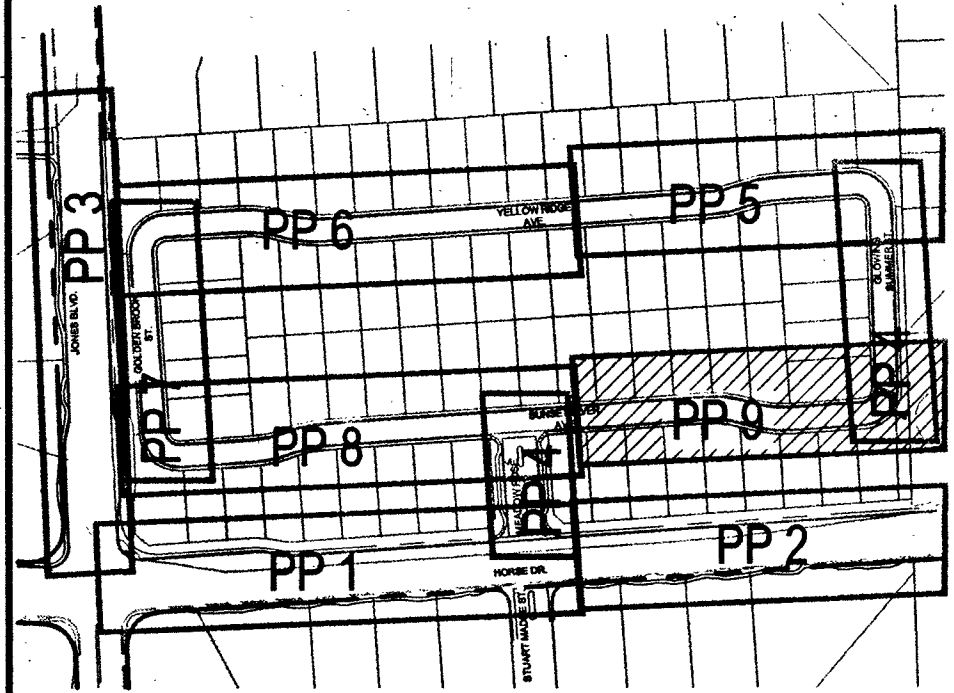

CURVE / LINE DATA

SEE GRADING SHEET FOR CURVE AND LINE DATA.

GRADING NOTES

COMPLETION OF SECTION II OF DRAINAGE COMPLIANCE REPORT REQUIRED.
ADD 2300 FEET TO ALL GRADE TAGS TO GET ACTUAL ELEVATION.

THE ELEVATION DIFFERENCE BETWEEN THE PAD AND FINISH FLOOR IS DETERMINED FROM THE MINIMUM THICKNESS REQUIRED PER THE GEOTECHNICAL REPORT. FINISH FLOORS MAY INCREASE DEPENDING ON THE TYPE OF SOIL AND FOUNDATION PLAN USED. NOTE THAT THE STRUCTURAL PLANS & GEOTECHNICAL REPORT SHALL SUPERSEDE THE CIVIL IMPROVEMENT PLANS.

ALL PRIVATE STREETS AND DRAINAGE EASEMENTS ARE TO BE PRIVATELY OWNED AND MAINTAINED BY THE HOMEOWNERS ASSOCIATION (H.O.A.).

ALL WORK TO BE PERFORMED OUTSIDE OF THE PROJECT BOUNDARY AND ON PRIVATE PROPERTY SHALL NOT BE PERFORMED UNTIL WRITTEN PERMISSION AND EASEMENTS HAVE BEEN OBTAINED FROM THE OFFSITE OWNER AND GIVEN TO CLARK COUNTY.

CONTRACTOR SHALL VERIFY HORIZONTAL AND VERTICAL LOCATION OF EXISTING UTILITIES AND NOTIFY THE DESIGN ENGINEER IMMEDIATELY OF ANY DISCREPANCIES PRIOR TO CONSTRUCTION.

GEOTECHNICAL


GEO TEK RESIDENTIAL, LLC
8835 SOUTH ESCONDIDO ST. SUITE B
LAS VEGAS, NEVADA 89119
702-897-1424

REPORT NO: 12220-LVR
DATE: 01/28/2015
REVISED: 02/04/2015

UTILITY DISCLAIMER NOTE

EXISTING UTILITY LOCATIONS SHOWN HEREIN ARE APPROXIMATE ONLY. IT SHALL BE THE CONTRACTORS RESPONSIBILITY TO DETERMINE THE EXACT VERTICAL AND HORIZONTAL LOCATION OF ALL EXISTING UNDERGROUND UTILITIES PRIOR TO COMMENCING CONSTRUCTION. NO REPRESENTATION IS MADE THAT ALL EXISTING UTILITIES ARE SHOWN HEREON. THE ENGINEER ASSUMES NO RESPONSIBILITY FOR UTILITIES NOT SHOWN OR UTILITIES NOT SHOWN IN THEIR PROPER LOCATIONS.
CALL BEFORE YOU DIG: 1-800-227-2600
CALL BEFORE YOU OVERHEAD: 1-702-227-2929

SCALE

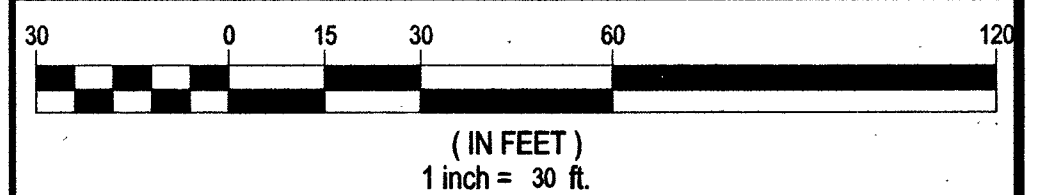

LEGAL DESCRIPTION

A PORTION OF SOUTH HALF (S 1/2) OF THE SOUTHWEST QUARTER (SW 1/4) OF THE NORTHWEST QUARTER (NW 1/4) OF SECTION 12, TOWNSHIP 19 SOUTH, RANGE 60 EAST, M.D.M. CITY OF LAS VEGAS, CLARK COUNTY, NEVADA.

BASIS OF BEARINGS

NORTH 01°47'03" WEST, BEING THE WEST LINE OF THE SOUTHEAST QUARTER (SE 1/4) OF THE NORTHWEST QUARTER (NW 1/4) OF SECTION 12, TOWNSHIP 19 SOUTH, RANGE 60 EAST, M.D.M., AS SHOWN ON THAT CERTAIN MAP ON FILE IN THE OFFICE OF THE COUNTY RECORDER, CLARK COUNTY, NEVADA, IN FILE 93 OF PARCEL MAPS, AT PAGE 69.

BENCHMARK

CLV BM #: 6LV9012W4
RIVET AND PLATE IN TOP OF CURB SOUTH EAST CORNER OF
HORSE DR. & JONES BLVD.
722.588m/2370.69ft (NAVD 88 DATUM)

CENTURY COMMUNITIES 8835 SOUTH ESCONDIDO ST. SUITE B LAS VEGAS, NV 89119 (702) 875-5338 FAX: (702) 730-4333		T ANEY ENGINEERING 6000 S. JONES BLVD. STE 100 LAS VEGAS, NV 89118 (702) 362-8844 FAX: (702) 362-5233	
HORSE & JONES (AKA: MEADOW RIDGE) SINGLE FAMILY RESIDENTIAL		PLAN & PROFILE VI - SUNSET RIVER. STA: 34+50 TO 39+60	
DATE: 8/24/2015		SCALE: 1"=30'	
JOB NO: CYC-14-003		DESIGNED BY: CA	
CHECKED BY: TSM		SHEET NAME: PP9	
SHEET: 16 OF 25		107 Y 5030	
H#		50831	