


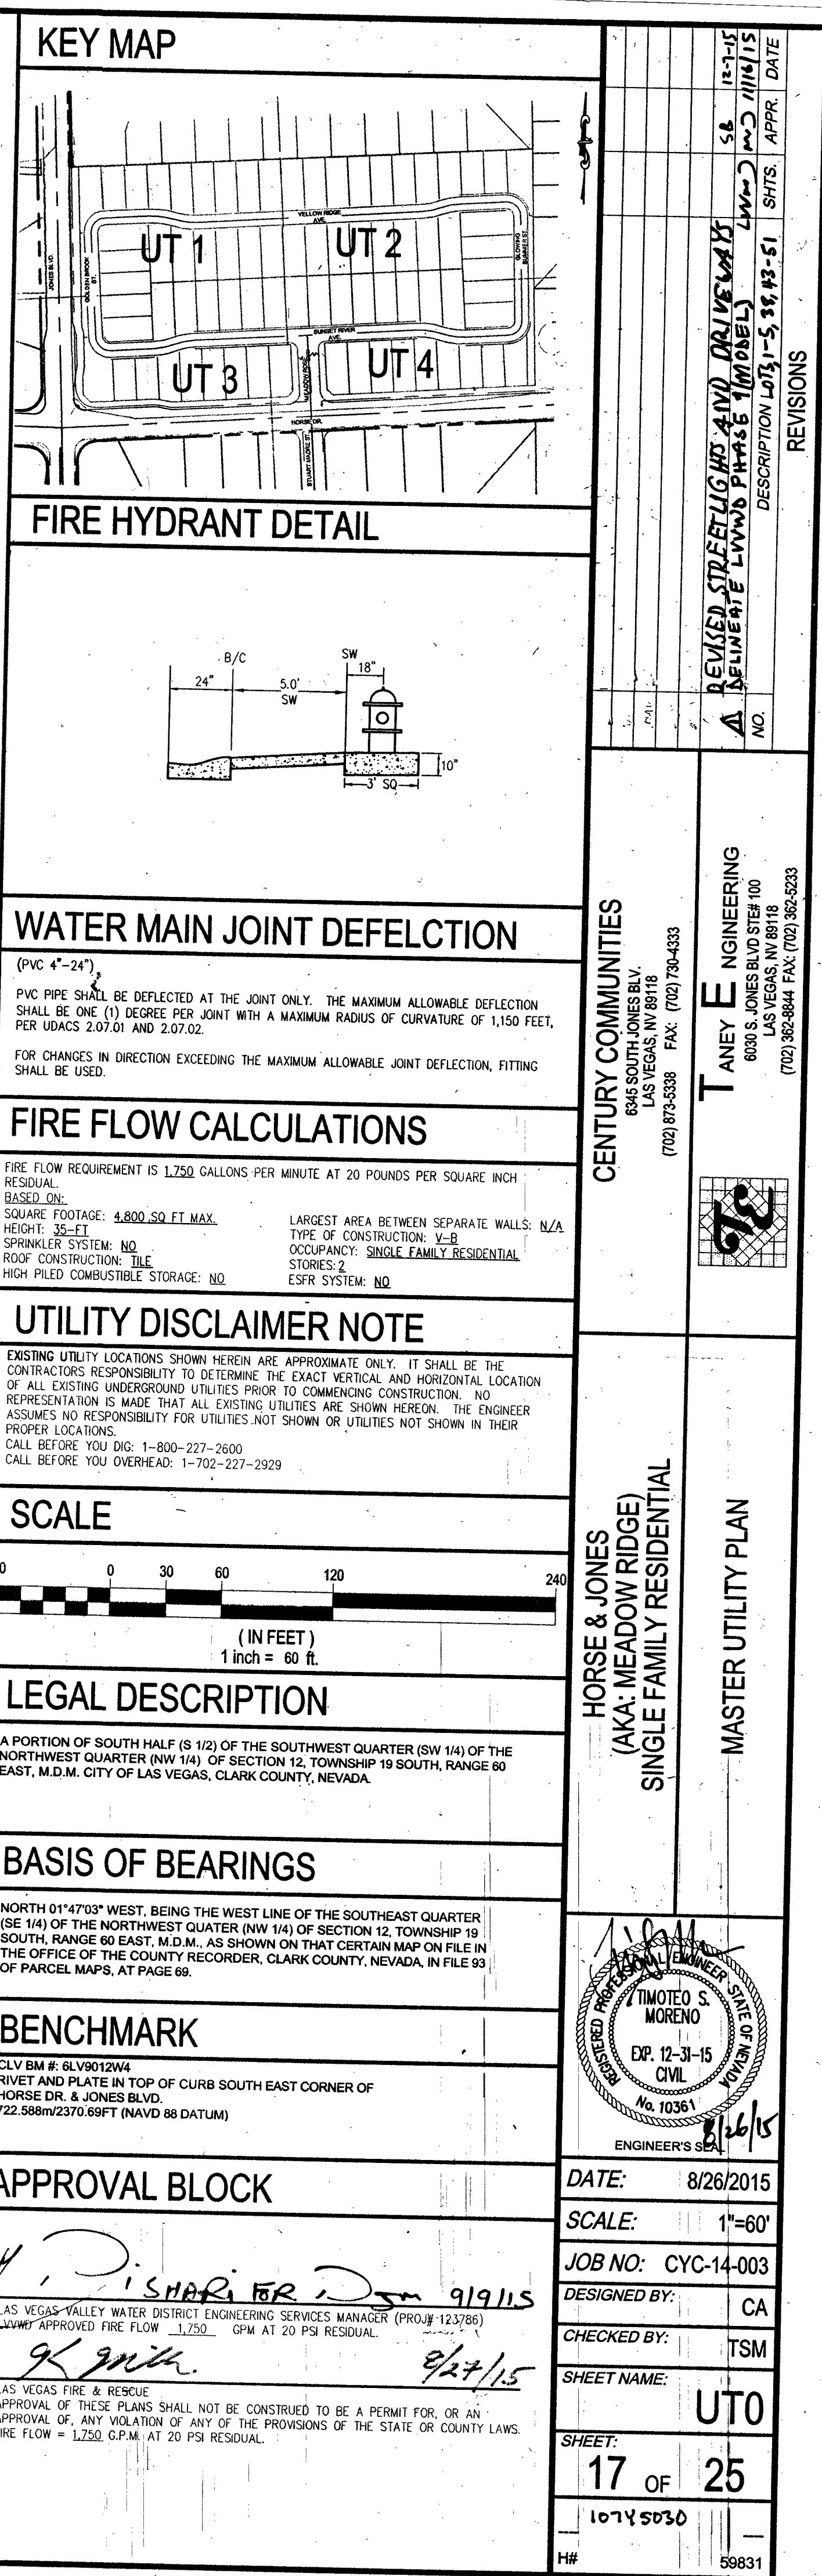

FILE NAME: CYC14003 UTIL SHEET DWG