
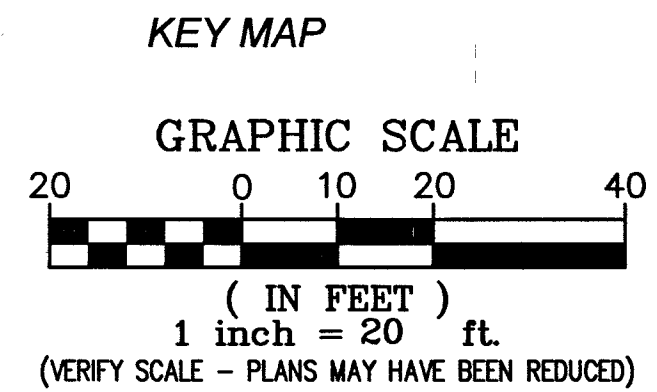
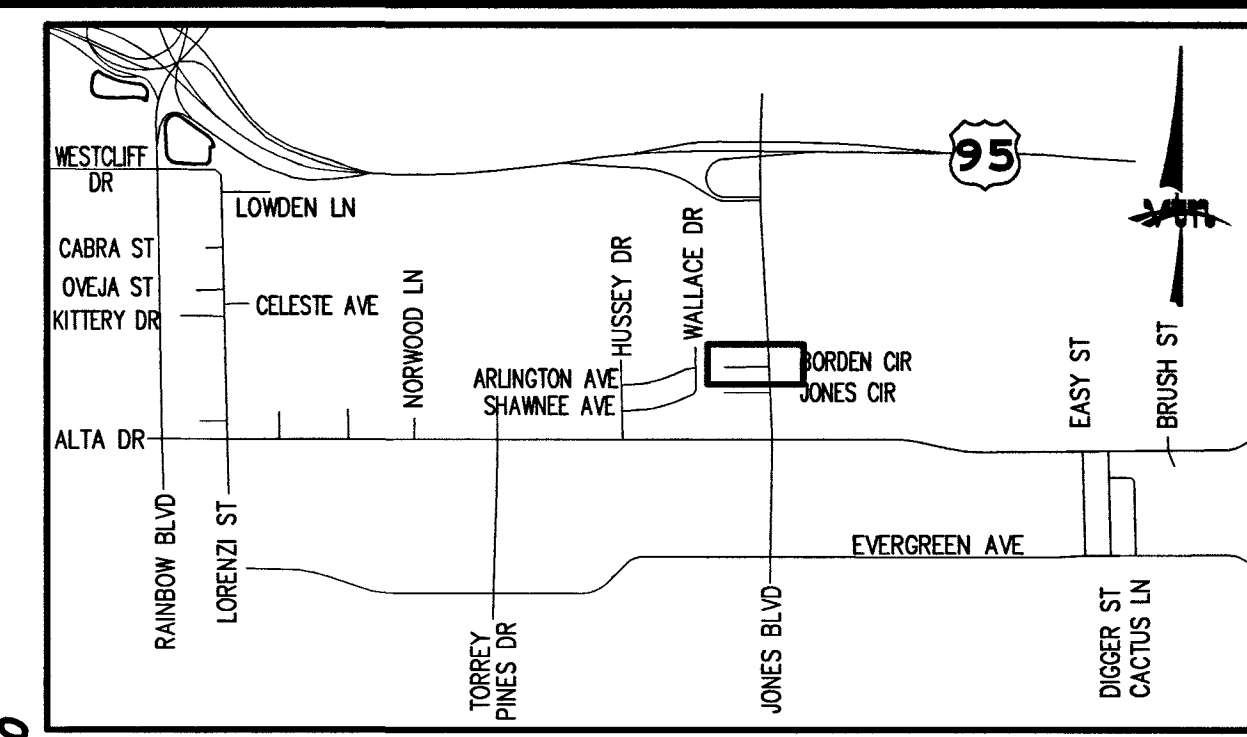


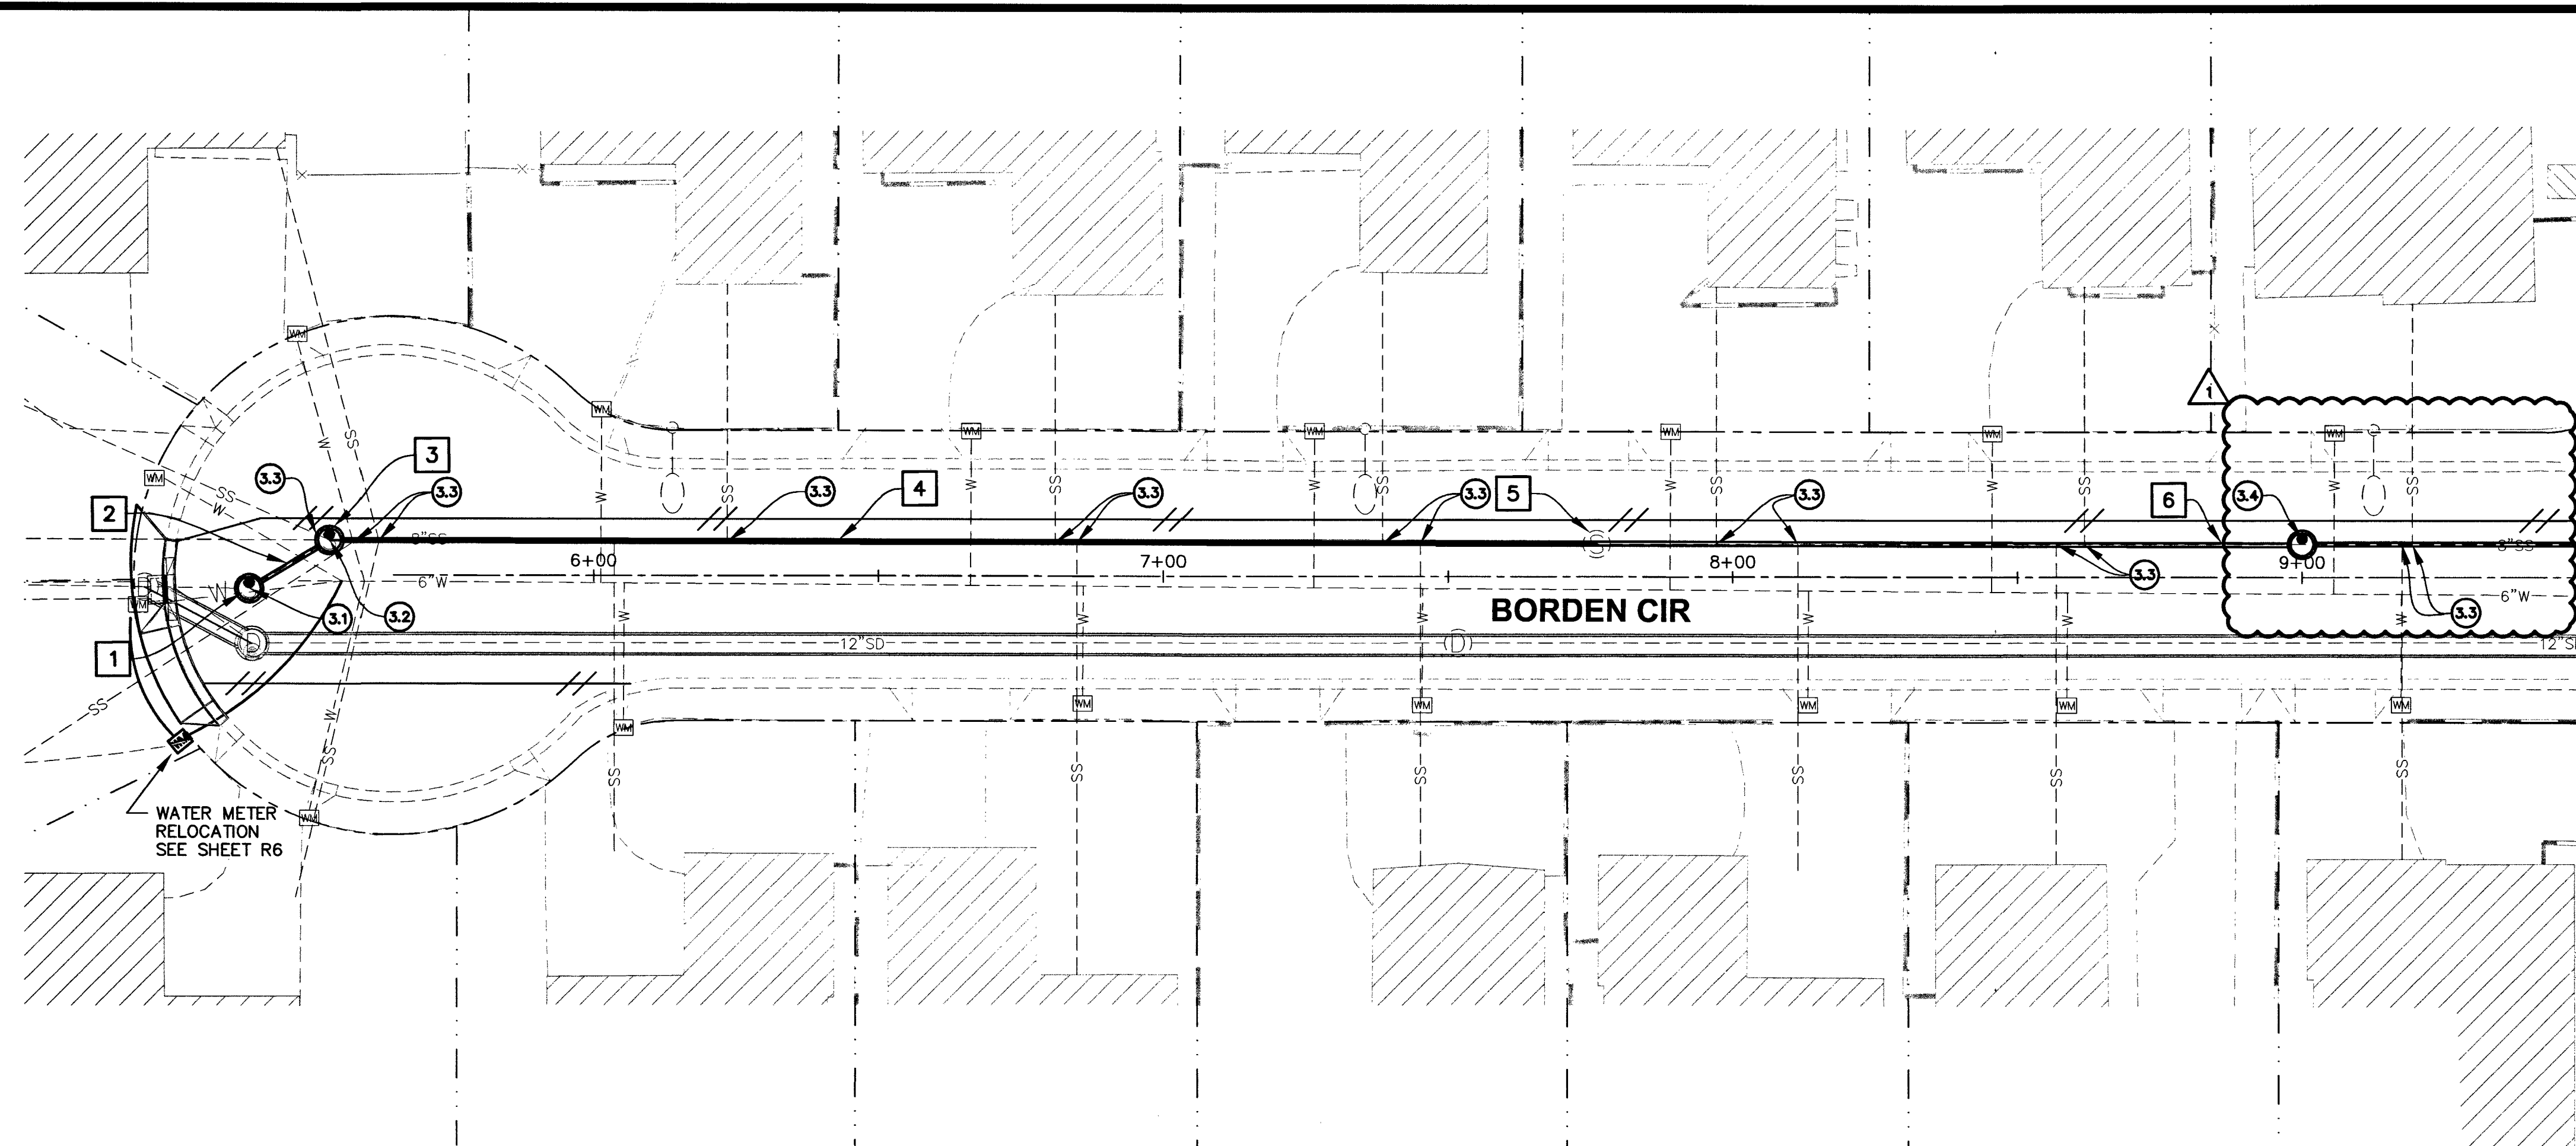

CONSTRUCTION NOTES

- ① "BC" 5+47.9±, 0.3± RT
CONSTRUCT 48" SANITARY SEWER MANHOLE
BEGIN SANITARY SEWER RELOCATION
N 26768309.7490
E 761953.7670
INSTALL 16.42 LF OF 8" PVC SANITARY SEWER MAIN
CONNECT TO EXISTING SANITARY MAIN WEST
- ② "BC" 5+53.6±, 6.2± LT
CONSTRUCT 48" SANITARY SEWER MANHOLE
WITH T-LOCK LINING
N 26768318.2660
E 761967.8620
INSTALL 346.40 LF OF 8" PVC SANITARY SEWER MAIN
- ③ EXISTING SANITARY SEWER LATERAL
CONNECT TO NEW 8" SANITARY SEWER MAIN
PER DCSWCS STD DWG NO SD-17
- ④ "BC" 9+00.00, 5.8± LT
CONSTRUCT 48" SANITARY SEWER MANHOLE
N 26768317.7879
E 762314.2186
INSTALL 50.00 LF OF 8" PVC SANITARY SEWER MAIN

REMOVAL NOTES

- 1 REMOVE EXISTING SAN SEWER MANHOLE
- 2 REMOVE 16.47 L.F. EXISTING 8" SAN SEWER MAIN
- 3 REMOVE EXISTING SAN SEWER MANHOLE
- 4 REMOVE 222.44 L.F. EXISTING 8" SAN SEWER MAIN
- 5 REMOVE EXISTING SAN SEWER MANHOLE
- 6 REMOVE 173.92 L.F. EXISTING 8" SAN SEWER MAIN

SHEET NOTES

1. REFER TO SHEET D7 FOR SANITARY SEWER DETAILS.

APPROVED
11-12-08
Date
Las Vegas Valley Water District
Project #114809

Call before you Dig
Avoid cutting underground utility lines. It's costly.
Call 811
1-702-227-2929
NEVADA POWER ENVIRONMENT AND SAFETY SERVICES DEPARTMENT
1-800-227-2600
CLARK COUNTY PUBLIC OPERATIONS
1-702-455-7544

DEPARTMENT OF PUBLIC WORKS 2727 SOUTH RAINBOW BOULEVARD LAS VEGAS, NEVADA 89146-5148 400 E. STEWART AVE. LAS VEGAS, NEVADA 89101 702-228-8272		MEADOWS ALTA PARALLEL PROJECT PHASE II
SANITARY SEWER RELOCATION PLAN & PROFILE BORDEN CIRCLE	DRAWN BY: VTN DESIGNED BY: VTN CHECKED BY: JNG PROJECT NO: 8812 SCALE: HORIZ. 1"=20' VERT. 1"=2'	SHEET 883 OF 12 SHEETS DRAWING NO. 3274281
REVISION BY: VTN DATE: 11/10/2008 ADDITIONAL 8" SS RELOCATION & 14" WATERLINE REPLACEMENT		

