

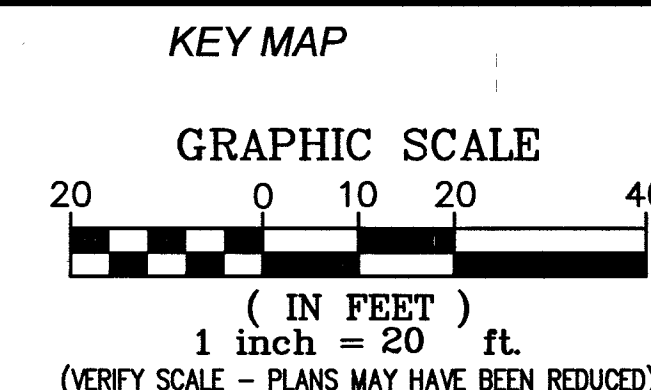
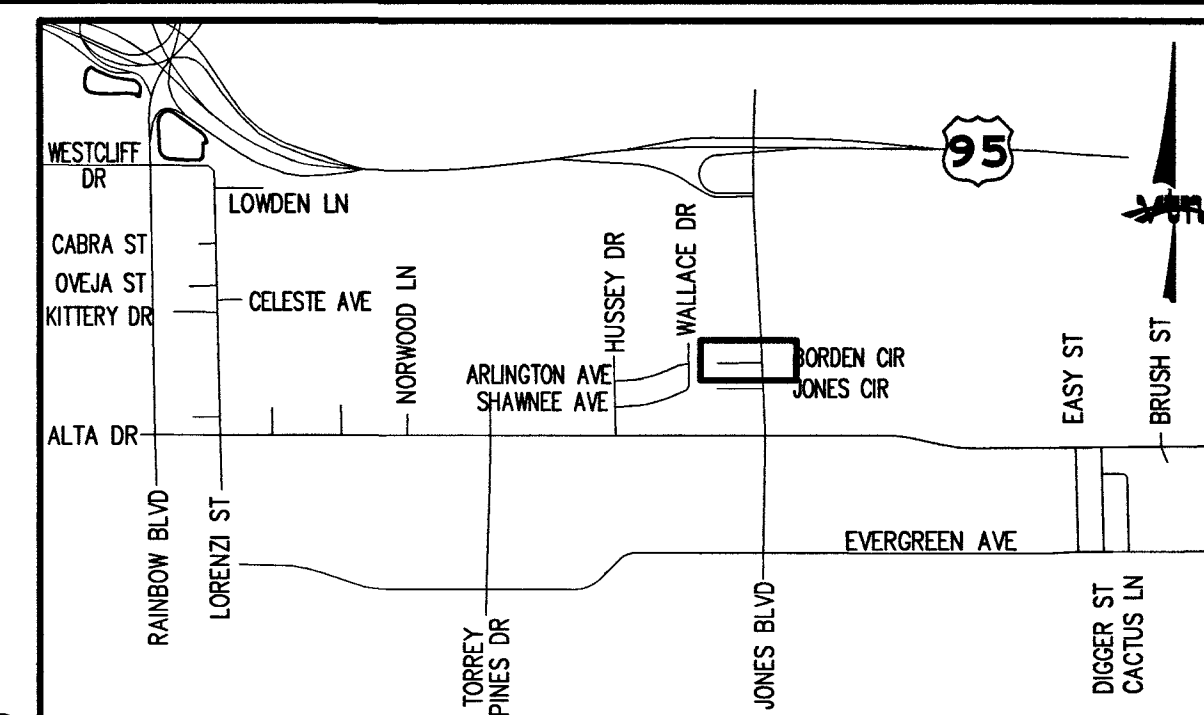


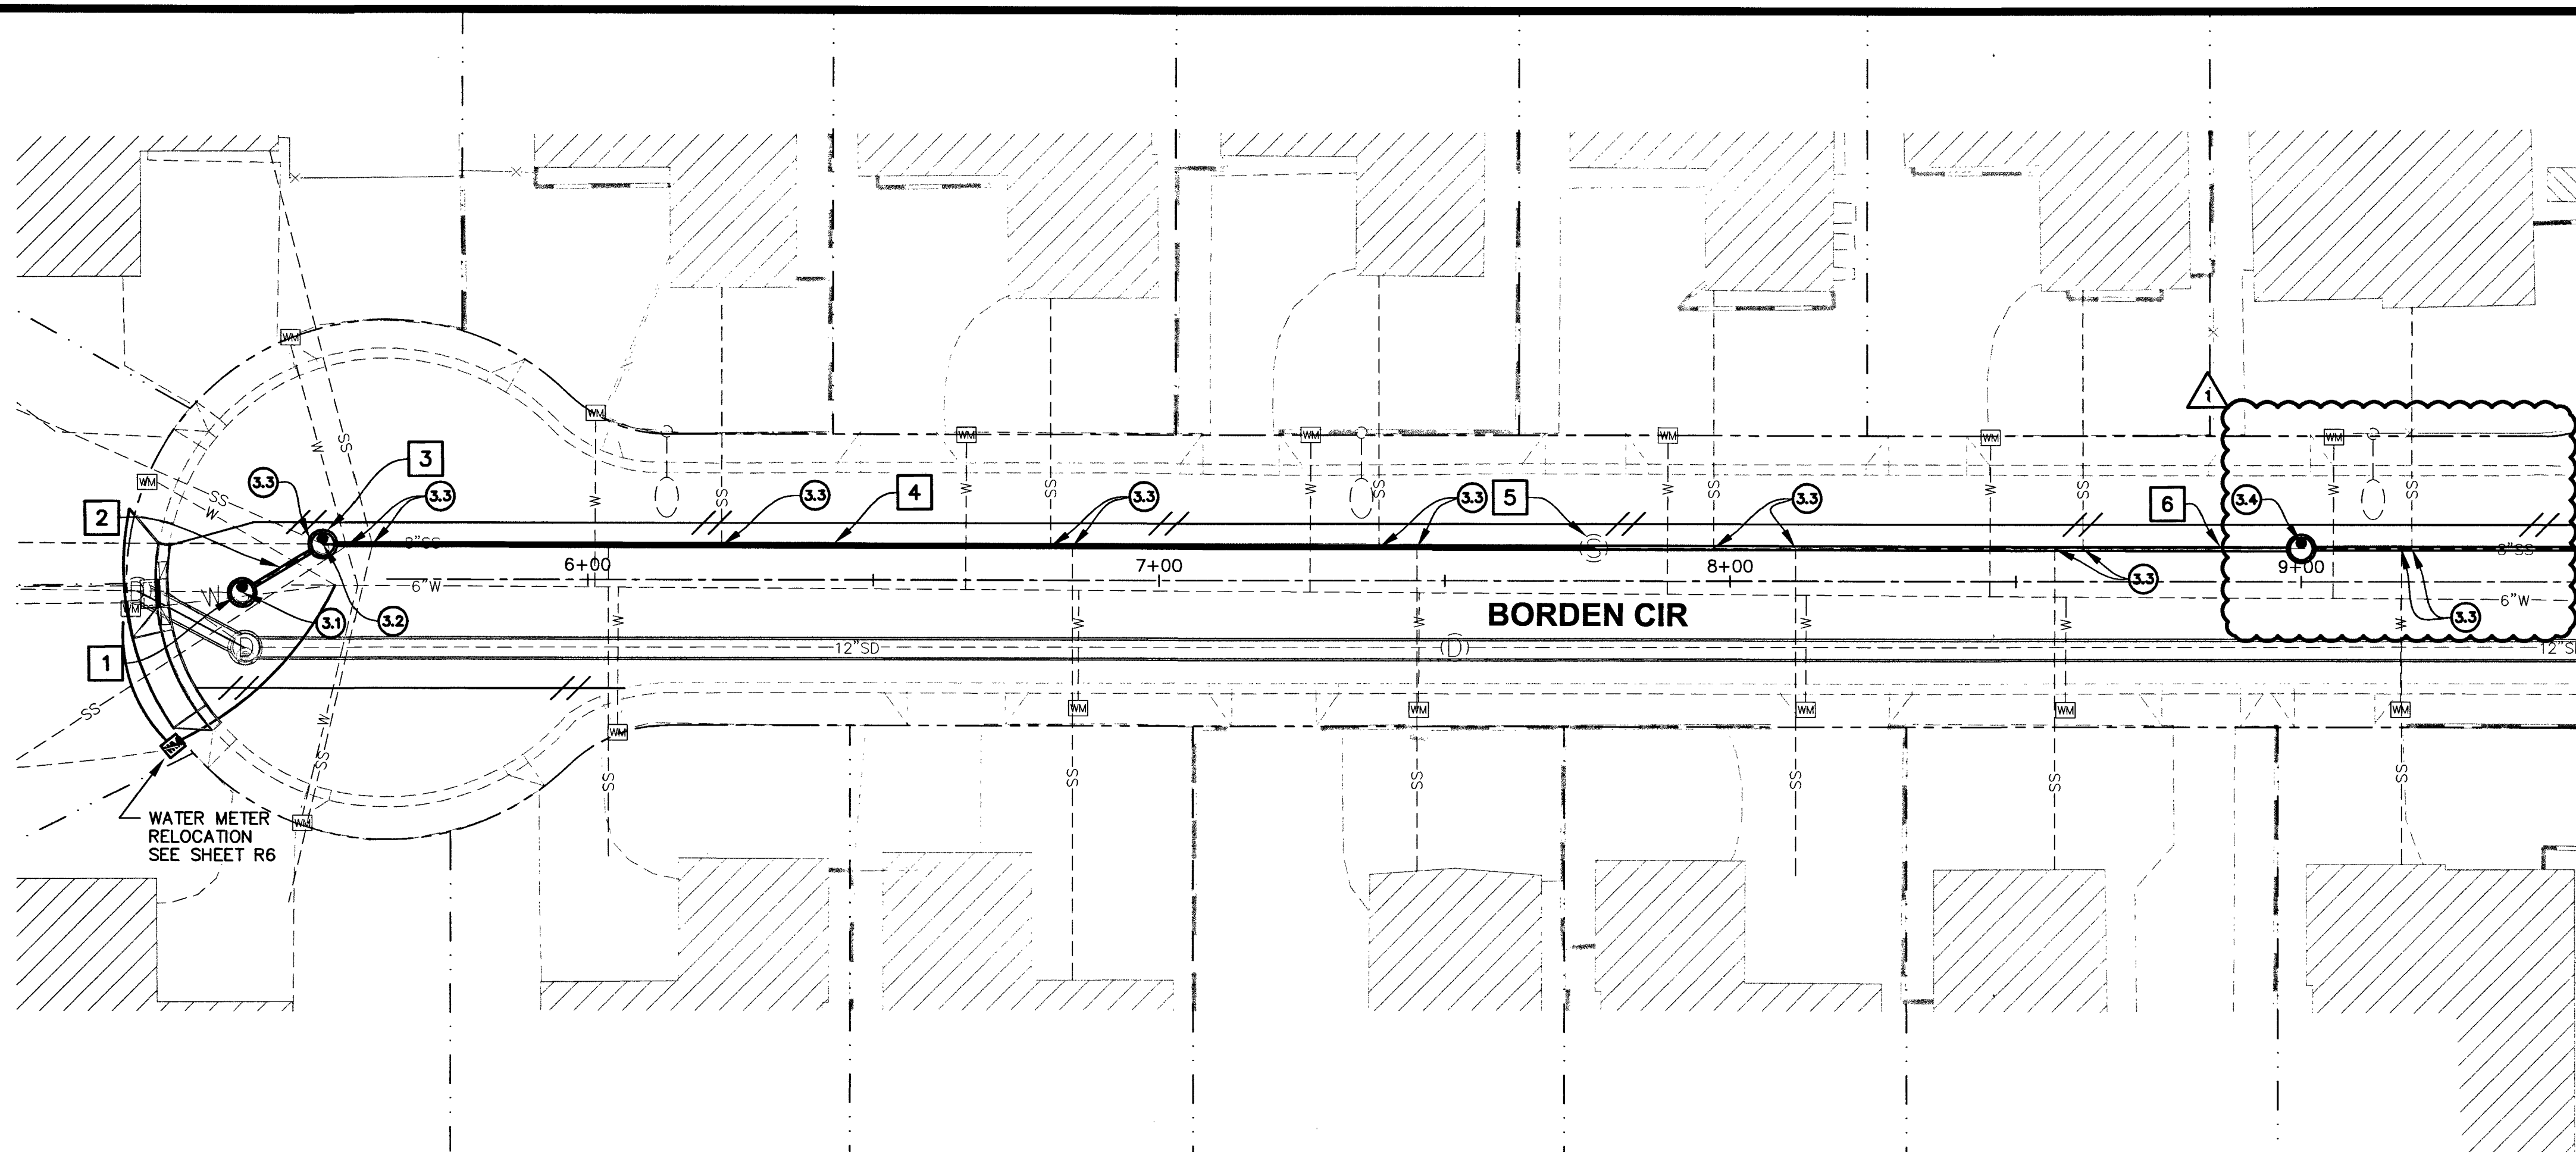

- CONSTRUCTION NOTES**
- ① "BC" 5+47.9±, 0.3± RT
CONSTRUCT 48" SANITARY SEWER MANHOLE
BEGIN SANITARY SEWER RELOCATION
N 26768309.7490
E 761953.7670
INSTALL 16.42 LF OF 8" PVC SANITARY SEWER MAIN
CONNECT TO EXISTING SANITARY MAIN WEST
 - ② "BC" 5+53.6±, 6.2± LT
CONSTRUCT 48" SANITARY SEWER MANHOLE
WITH T-LOCK LINING
N 26768318.2660
E 761967.8620
INSTALL 346.40 LF OF 8" PVC SANITARY SEWER MAIN
 - ③ EXISTING SANITARY SEWER LATERAL
CONNECT TO NEW 8" SANITARY SEWER MAIN
PER DCSWCS STD DWG NO SD-17
 - ④ "BC" 9+00.00, 5.8± LT
CONSTRUCT 48" SANITARY SEWER MANHOLE
N 26768317.7879
E 762314.2186
INSTALL 50.00 LF OF 8" PVC SANITARY SEWER MAIN


- REMOVAL NOTES**
- ① REMOVE EXISTING SAN SEWER MANHOLE
 - ② REMOVE 16.47 L.F. EXISTING 8" SAN SEWER MAIN
 - ③ REMOVE EXISTING SAN SEWER MANHOLE
 - ④ REMOVE 222.44 L.F. EXISTING 8" SAN SEWER MAIN
 - ⑤ REMOVE EXISTING SAN SEWER MANHOLE
 - ⑥ REMOVE 173.92 L.F. EXISTING 8" SAN SEWER MAIN

SHEET NOTES
 1. REFER TO SHEET D7 FOR
 SANITARY SEWER DETAILS.

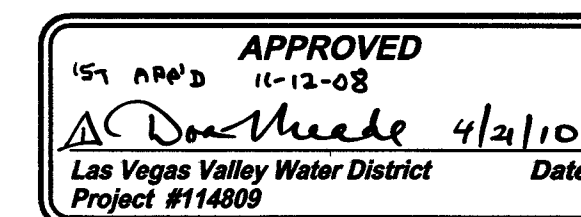

Call before you Dig
 1-702-227-2929
 NEVADA POWER ENVIRONMENT AND
 SAFETY SERVICES DEPARTMENT

Call before you Dig
 1-800-227-2600
 CLARK COUNTY PUBLIC UTILITIES
 1-702-455-7544

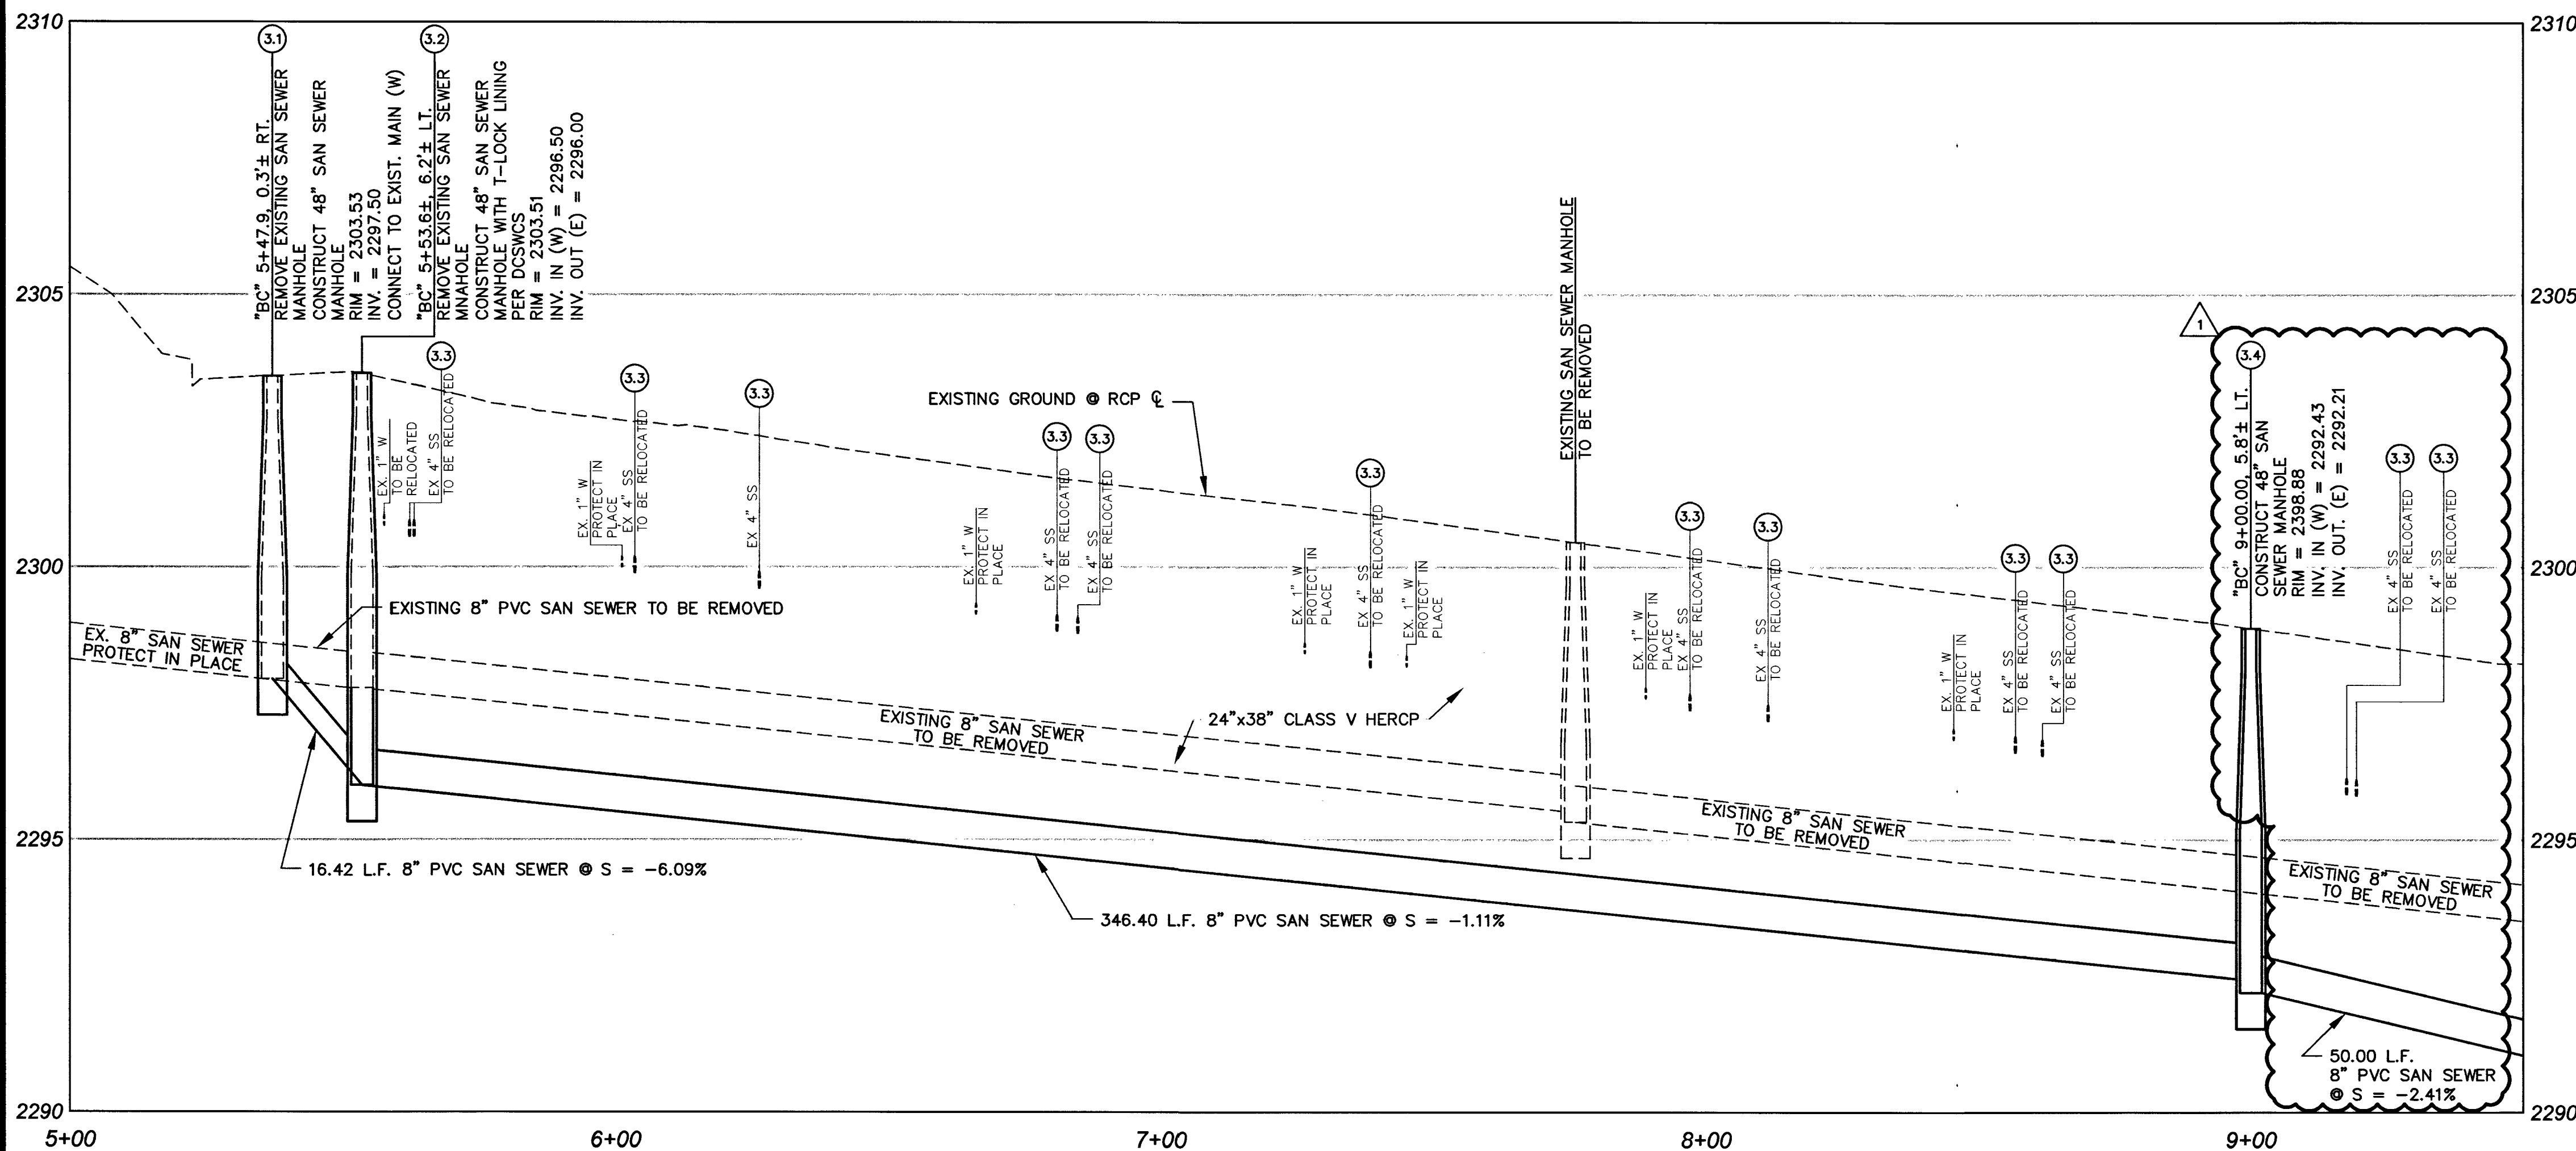

DEPARTMENT OF PUBLIC WORKS			
SANITARY SEWER RELOCATION PLAN & PROFILE BORDEN CIRCLE			
MEADOWS ALTA PARALLEL PROJECT PHASE II			
DRAWN BY: VIN	DESIGNED BY: VIN	CHECKED BY: JNG	PROJECT NO.: 8812
NOV 10, 2008		NOV 10, 2008	
NOV 10, 2008		NOV 10, 2008	
SCALE: HORIZ. 1"=20'		VERT. 1"=2'	
SHEET 883 OF 12 SHEETS DRAWING NO. 3274281			