


CURVE DATA B/C

L	R	T
① 87°33'15" 48.70' 32.00' 30.66'		
② 88°54'03" 49.65' 32.00' 31.37'		
③ 87°24'46" 48.82' 32.00' 30.59'		

- ① - INSTALL SIDEWALK RAMP
- ② - INSTALL 1 1/2" SERVICE # METERS. # METERS NOT INSTALLED WITHIN SIDEWALKS TO HAVE CONCRETE COLLARS PER LVVWD STD PLATE 2-A.
- ③ - INSTALL 4-14"x45" BENDS AS SHOWN ON SHEET 16

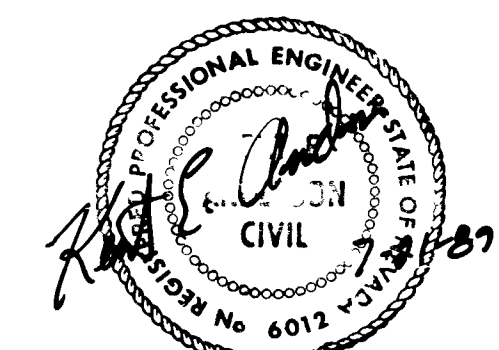

LAS VEGAS VALLEY WATER DISTRICT
 DATE 11-7-89

REV	DATE	BY	REVISION
1	11-20-89	REA	ADD 1 1/2" SERVICE PER LANDSCAPE CAT 12-13-17
2	1-5-90	DA	Added Pipecap

CONSULTING ENGINEERS - PLANNERS
 2300 PASEO DEL PRADO BUILDING A SUITE 100
 LAS VEGAS, NEVADA 89102 PHONE (702) 873-7550

APPLE DRIVE STREET PLAN AND PROFILE
PECCOLE RANCH

NO. 3804
 BY JLU
 DATE 7-89
 HORIZ 1"=40'
 SCALE VERT. 1"=4'

SHEET
20
 OF 56 SHEETS
 1077-4070-1

