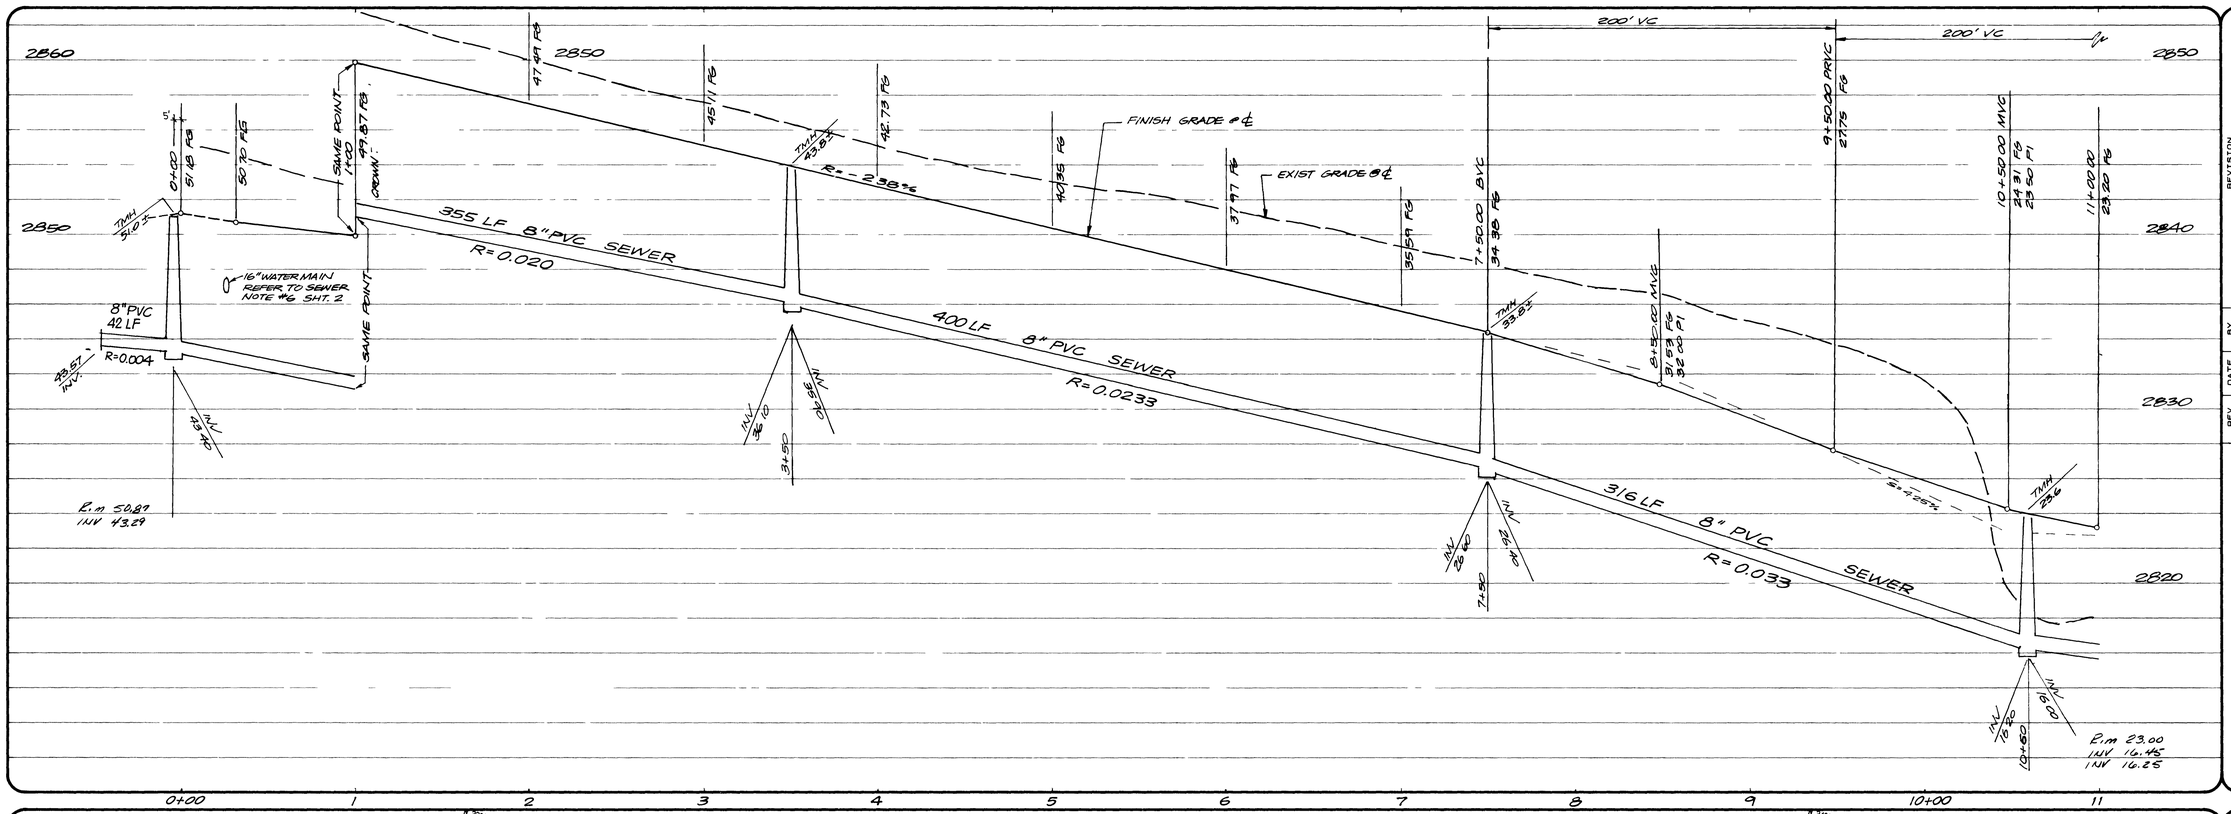

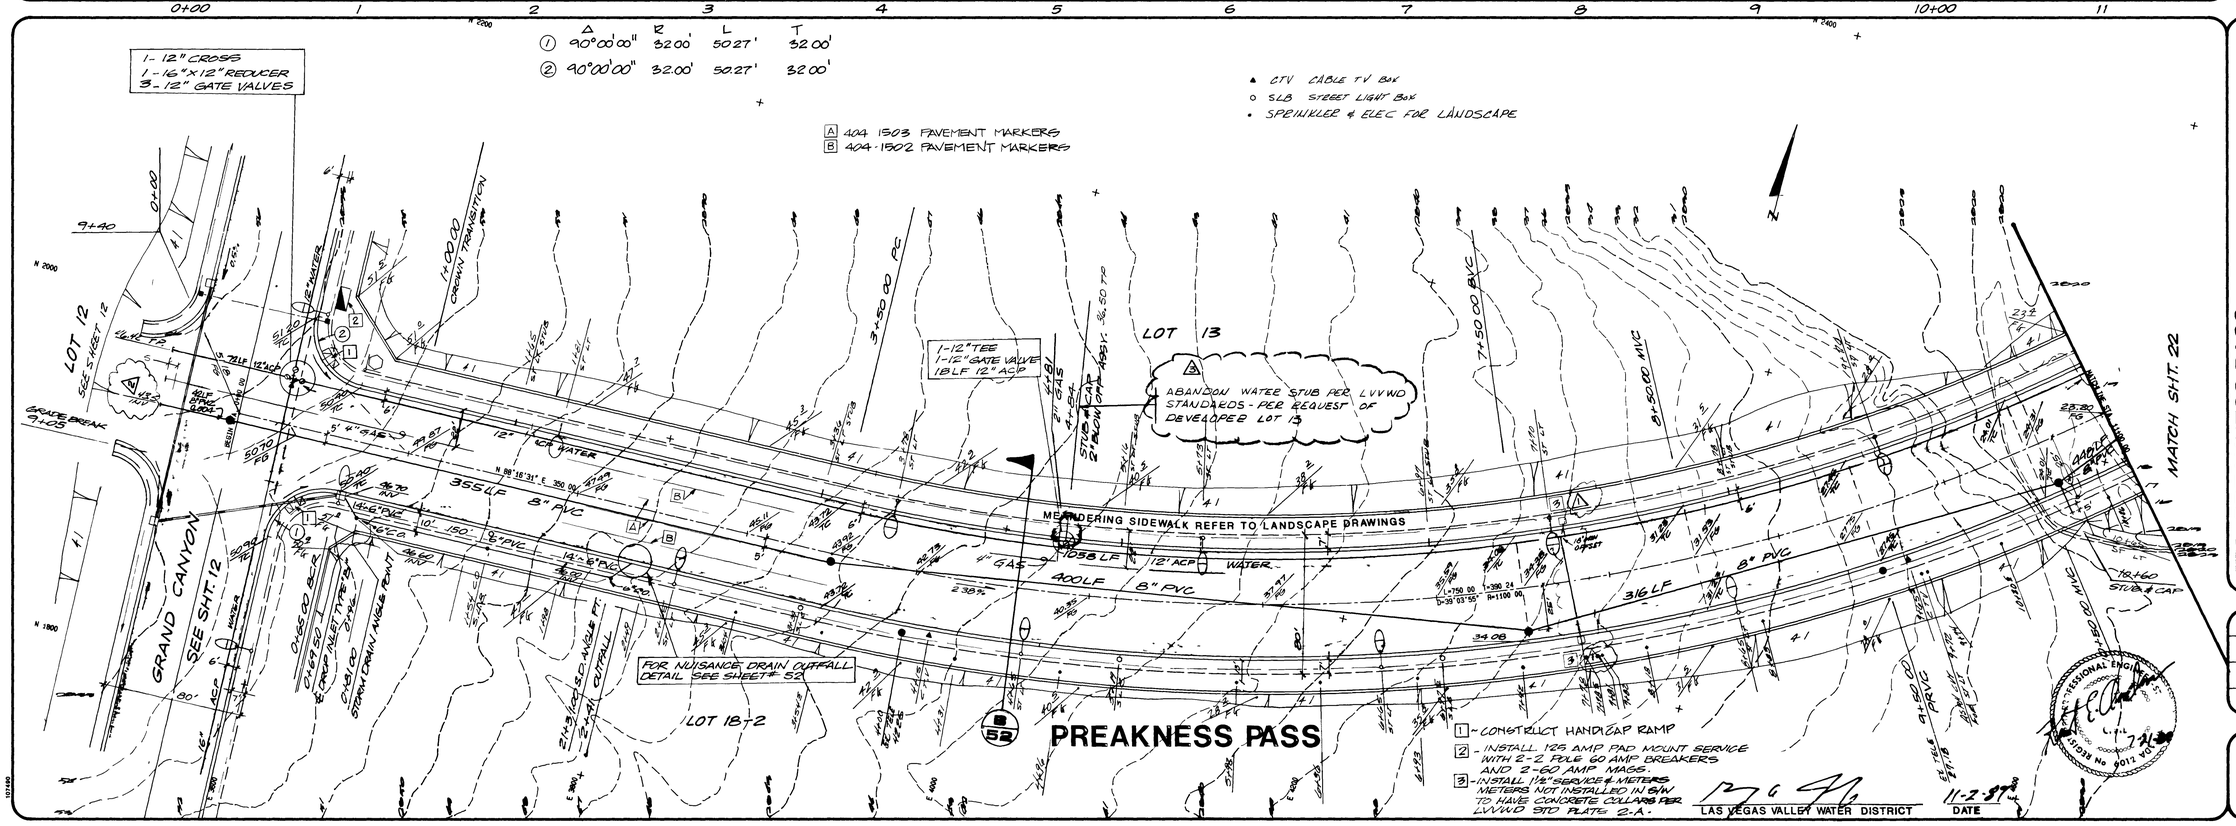

REV	DATE	BY	REVISION
1	11-20-89	KEA	ADD 1½" METER PER LANDSCAPE PLAT 12-13-89
2	1-22-90	DH	ADD INTERSECTION @ GRAND CANYON & PREAKNESS
3	12-10-90	DH	ABANDON WATER STUB TO LOT 13 - 4-24-91

CONSULTING ENGINEERS – PLANNERS
2300 PASEO DEL PRADO BUILDING A SUITE 100
LAS VEGAS, NEVADA 89102 PHONE (702) 873-7550

vtn nevada

TITLE: PREAKNESS PASS STREET PLAN AND PROFILE

PROJECT: PECCOLE RANCH

WO NO. 3804
BY JU
DATE 7-89
SCALE HORIZ 1" = 40' VERT 1" = 4'

SHEET 21 OF 56 SHEETS

1074-4070-1

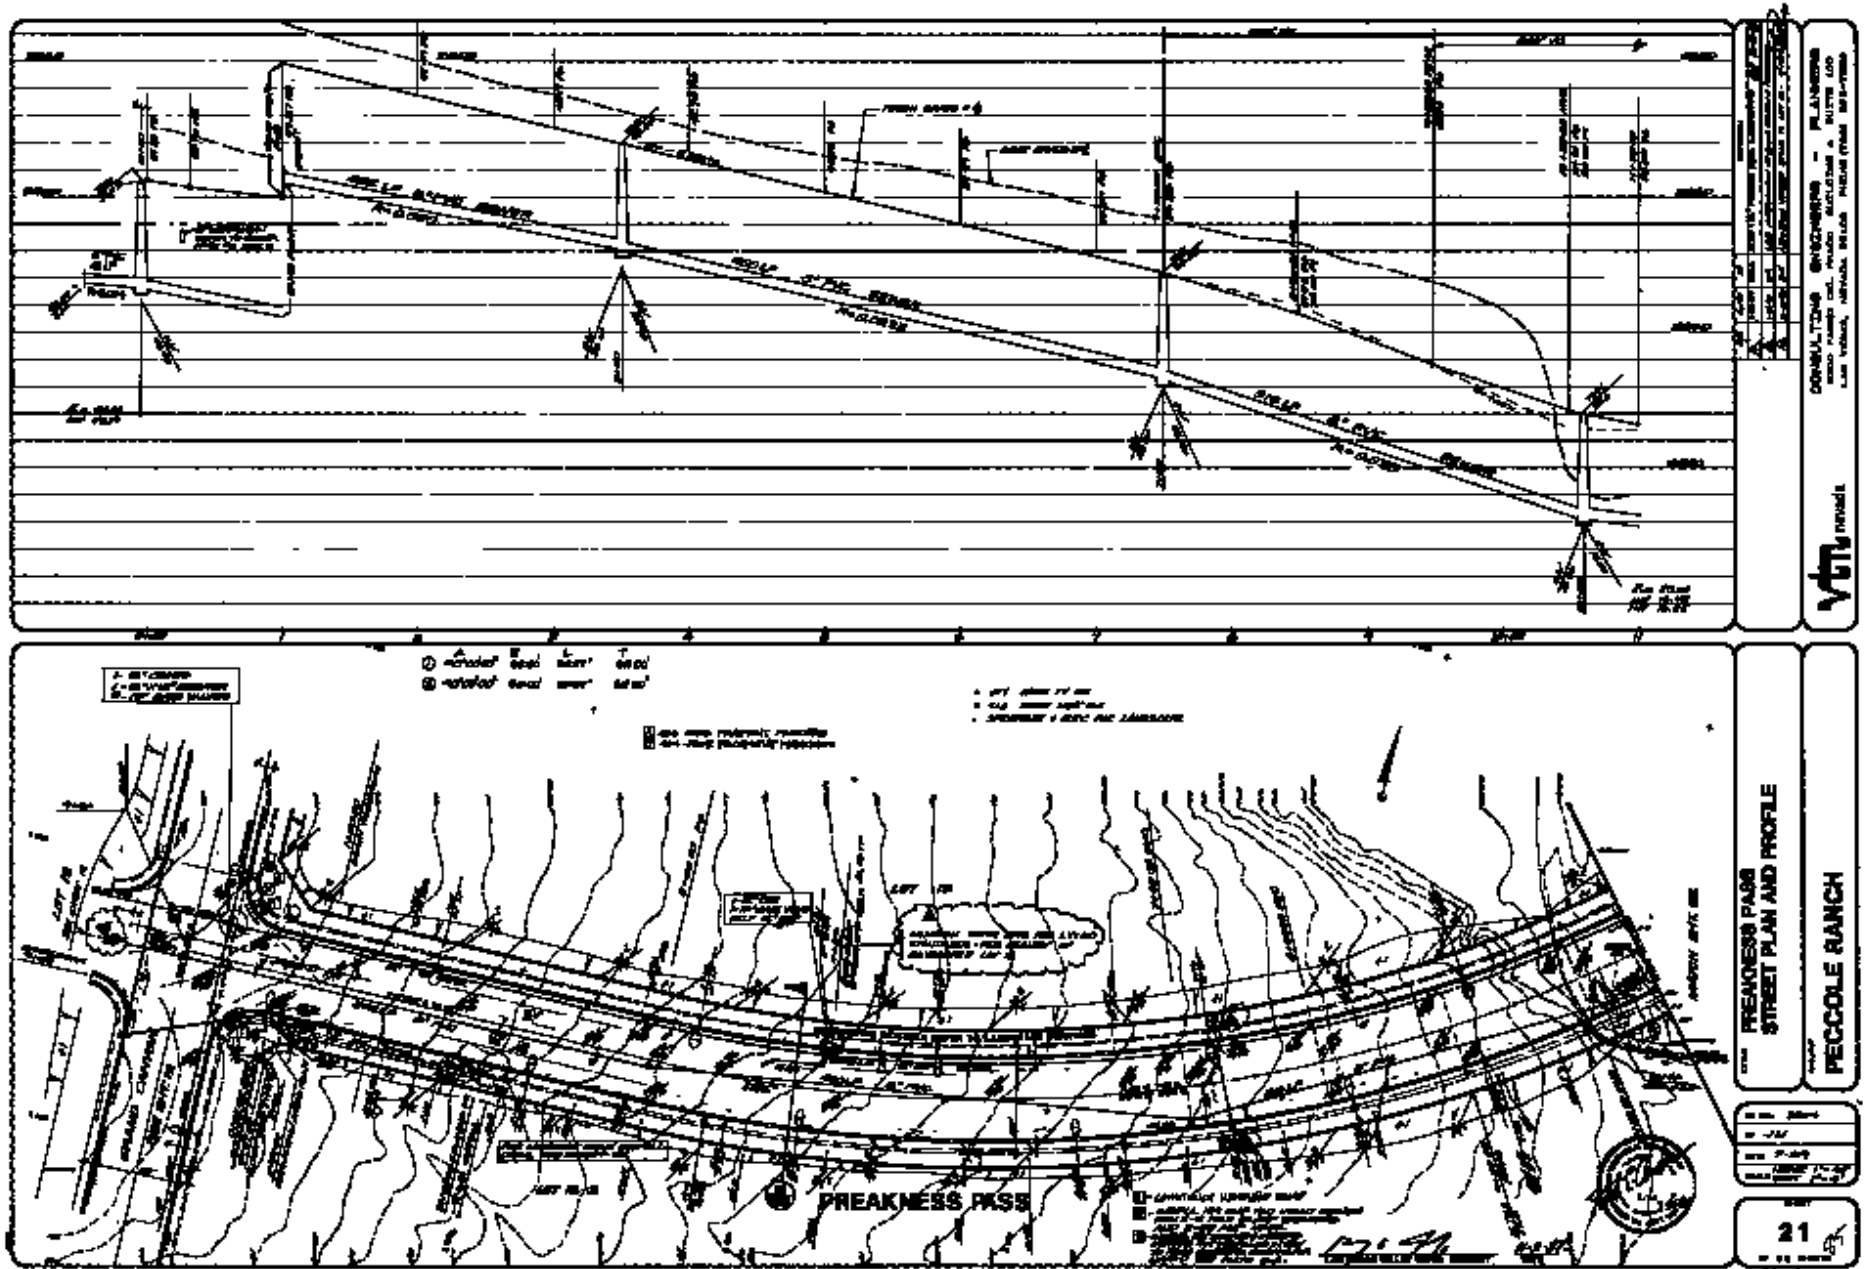
PREAKNESS PASS
PREAKNESS PASS
STREET PLAN AND PROFILE
PECCOLE RANCH
21