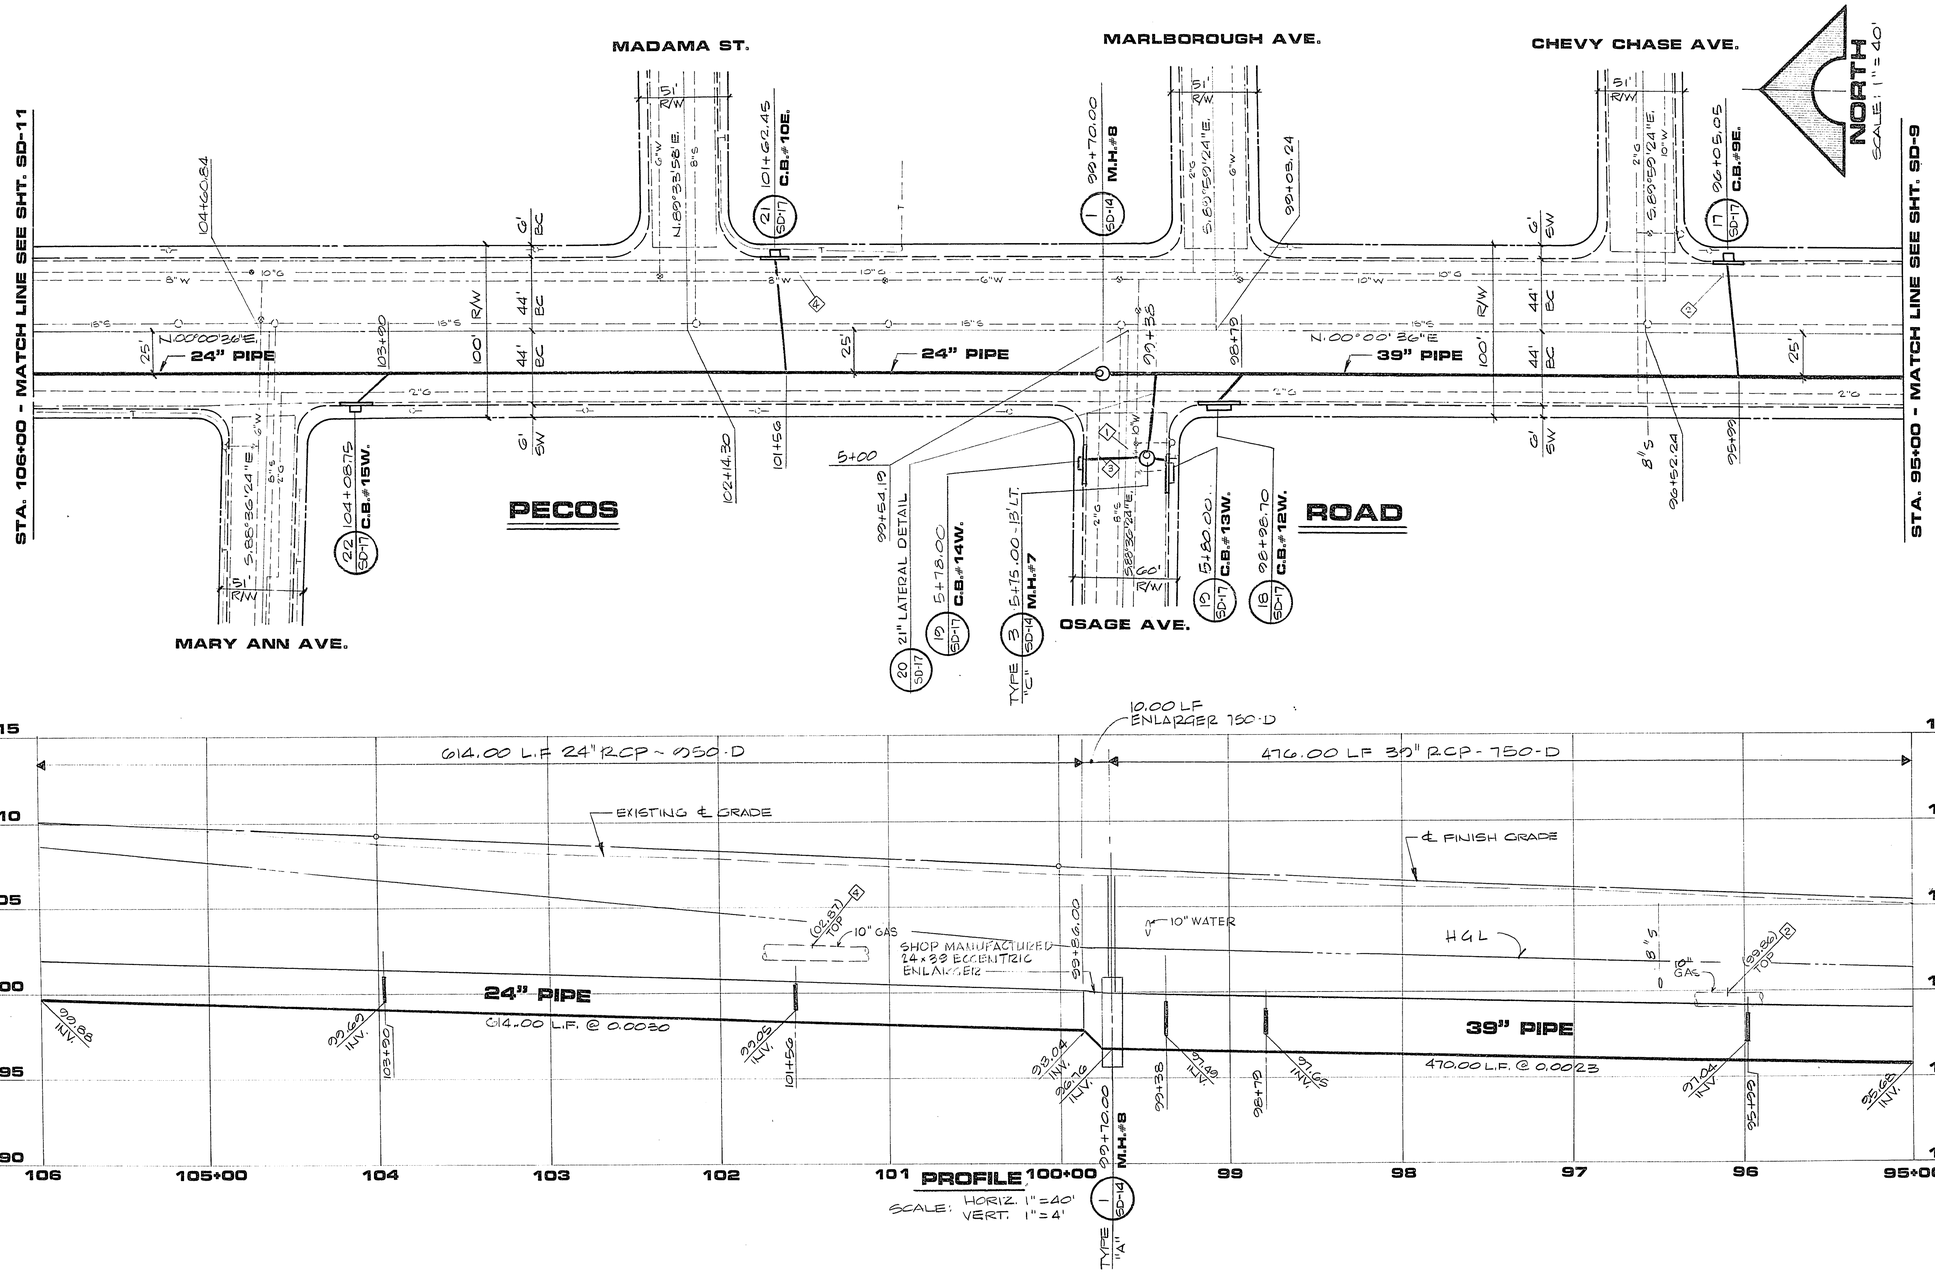

JOB NO. 472.160

9/78 DIETERICH-POST 65329

29-4-62. 107-V1245

REV	DATE	DESCRIPTION

R.E. NO. 247 DATE 12/1/78

RECORD DRAWING — REGISTERED PROFESSIONAL ENGINEER — STATE OF NEVADA — CLARK COUNTY

G. C. WALLACE
Consulting Engineers, Inc.
1100 East Sahara Ave. • Las Vegas, Nevada 89104 • 732-3330

DEPARTMENT OF PUBLIC SERVICES
PECOS ROAD - STORM DRAIN
PLAN & PROFILE STA. 95+00 TO 106+00

SHEET SD-10 OF 61 SHEETS