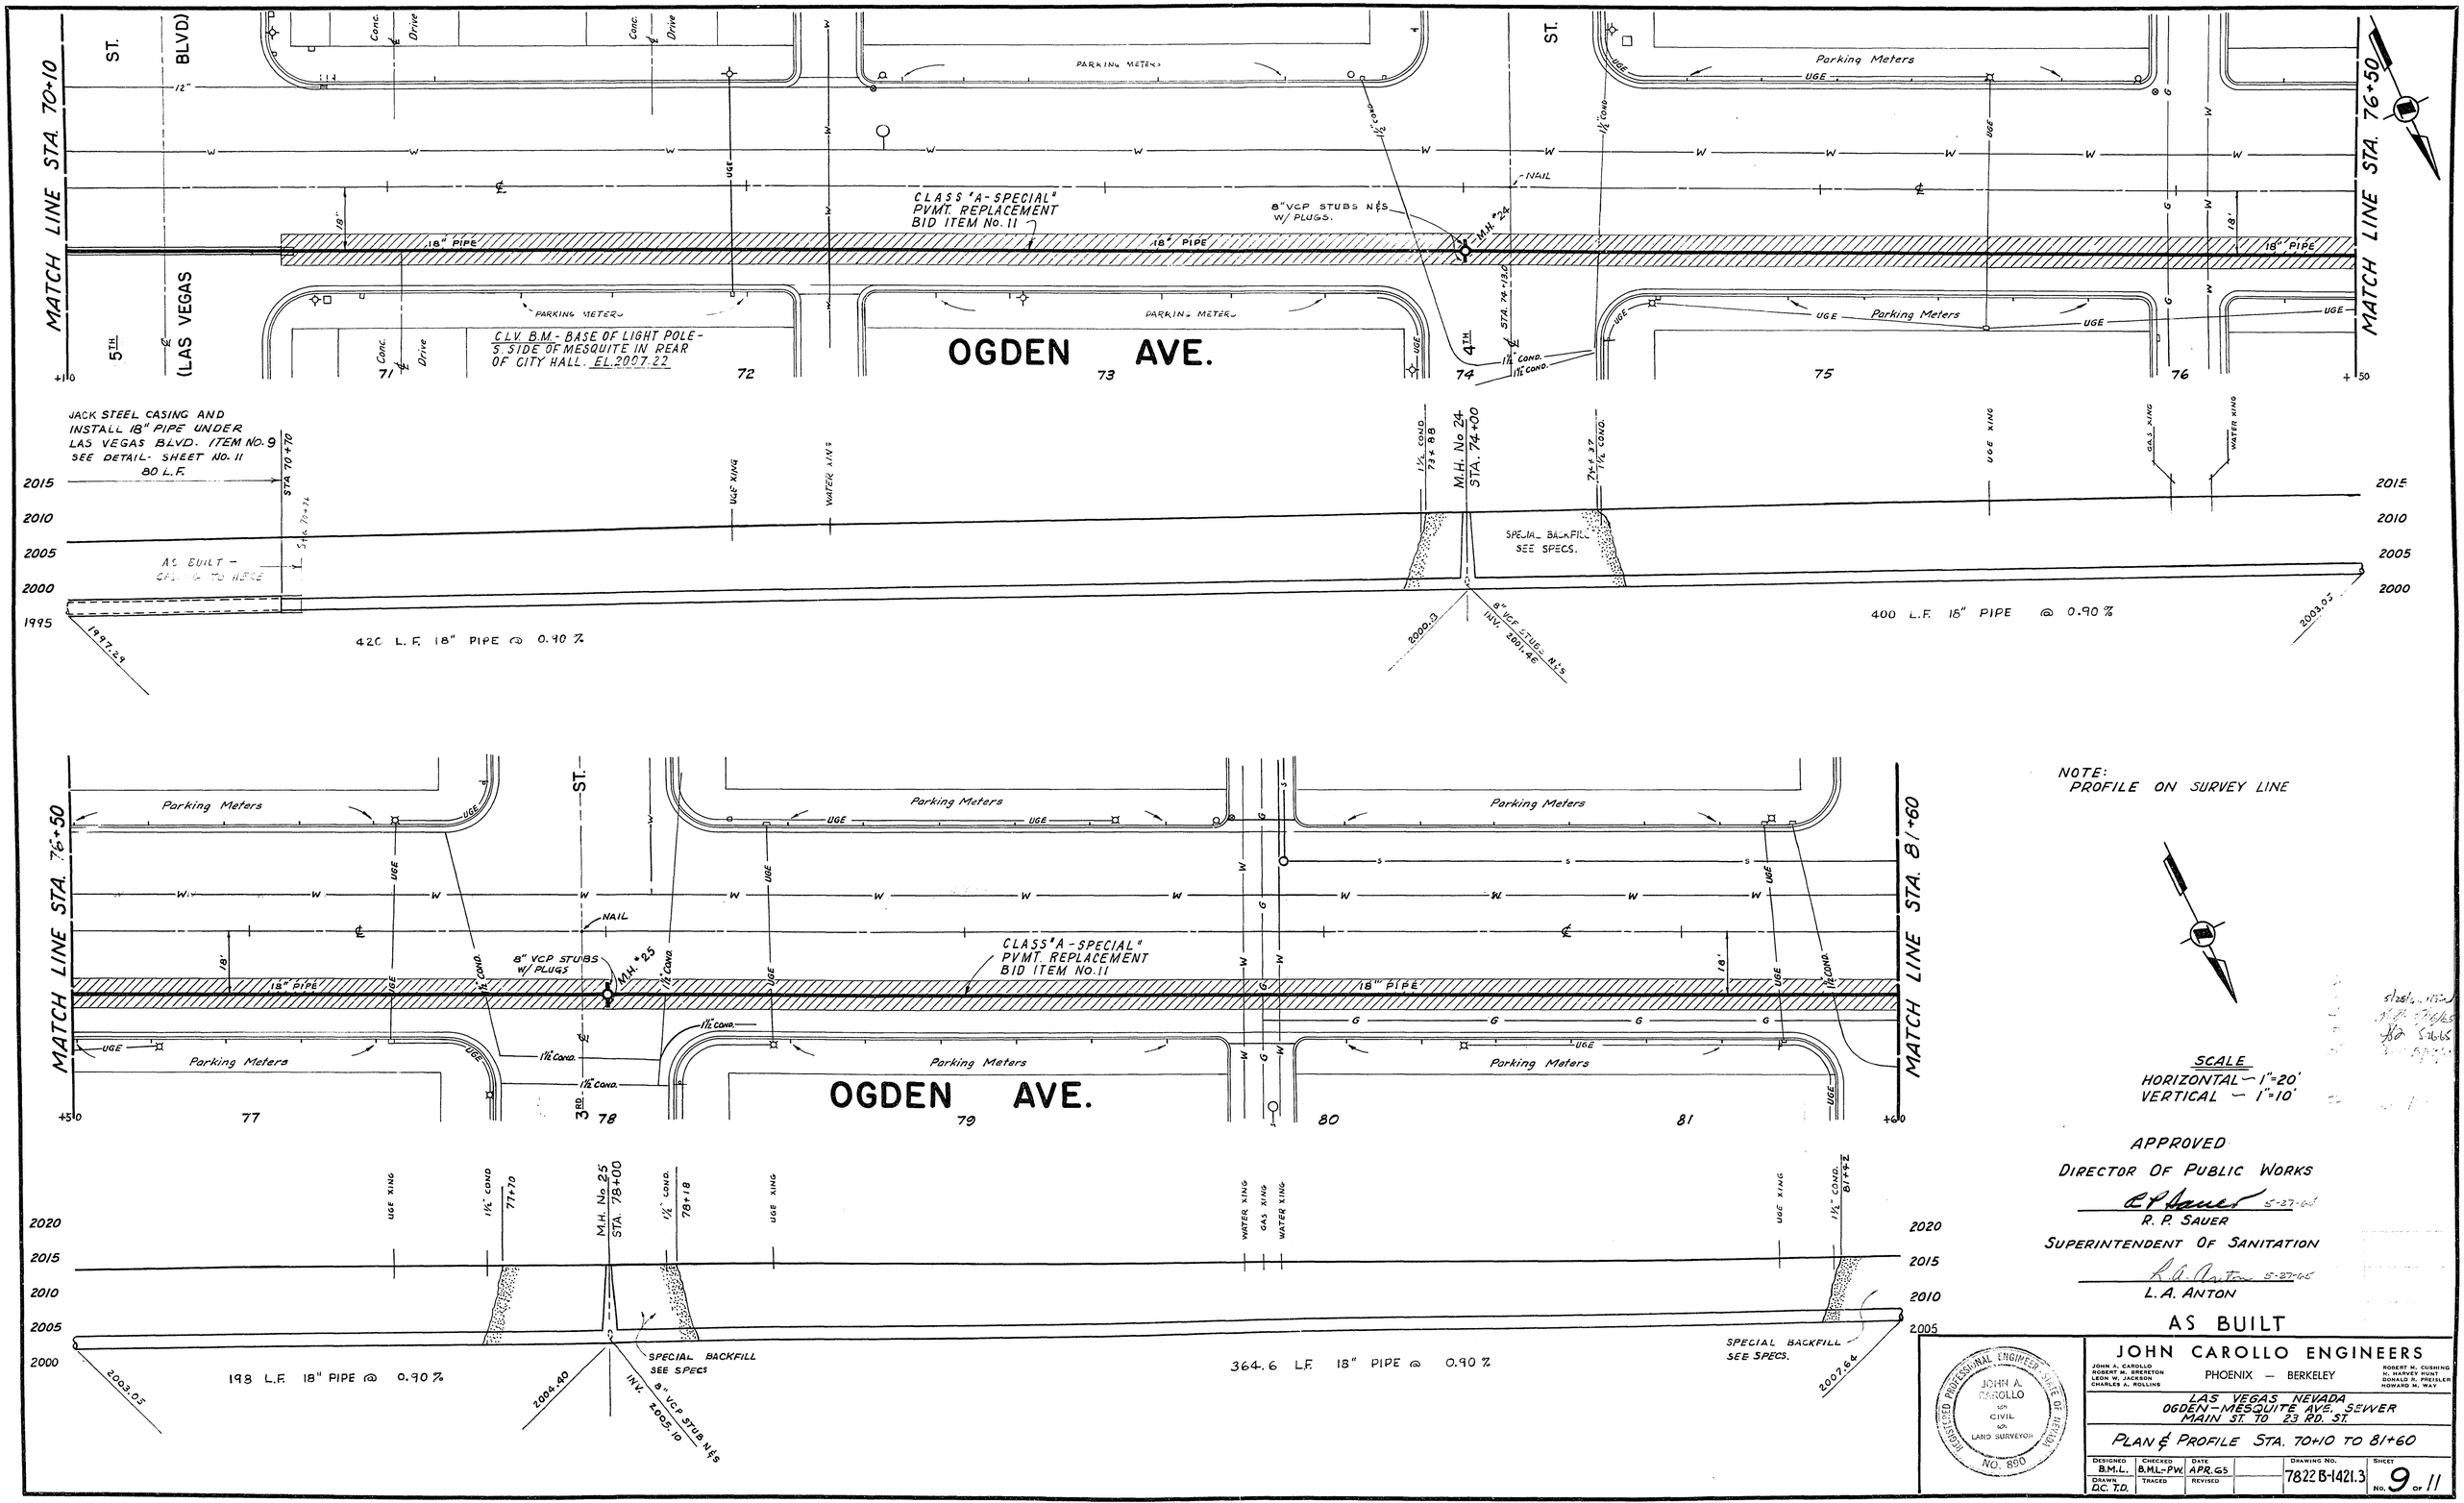

NOTE:
PROFILE ON SURVEY LINE

SCALE
HORIZONTAL — 1"=20'
VERTICAL — 1"=10'

APPROVED
DIRECTOR OF PUBLIC WORKS
R. P. Sauer 5-27-65
R. P. SAUER
SUPERINTENDENT OF SANITATION
L. A. Anton 5-27-65
L. A. ANTON

AS BUILT

REGISTERED PROFESSIONAL ENGINEER STATE OF NEVADA
JOHN A. CAROLLO
CIVIL
LAND SURVEYOR
NO. 890

JOHN CAROLLO ENGINEERS
JOHN A. CAROLLO, ROBERT M. BRERETON, LEON W. JACKSON, CHARLES A. ROLLINS
PHOENIX — BERKELEY
ROBERT M. CUSHING, SCHALEK E. HUNT, CHARLES F. PREISLER, HOWARD M. WAY

LAS VEGAS NEVADA
OGDEN-MESQUITE AVE. SEWER
MAIN ST. TO 23 RD. ST.

PLAN & PROFILE STA. 70+10 TO 81+60

DESIGNED	CHECKED	DATE	DRAWING NO.	SHEET
B.M.L.	B.M.L.-P.W.	APR. 65	7822 B-1421.3	No. 9 OF 11
DRAWN D.C. T.D.	TRACED	REVISED		