


NOTES:
 ① STREET R.I.W.S AND DIMENSIONS ARE TAKEN FROM M.S.A.D. 469 AND ARE NON EXISTENT AT THIS DATE, EXCEPT AS NOTED.
 ② SEWER LATERALS TO BE LOCATED IN FIELD AND LAID ACCORDING TO CLV STANDARD 5-112.
 ③ CONTACT ALL UTILITY CO'S BEFORE EXCAVATING - BARRICADE ACCORDING TO CLV BARRICADE MANUAL.

— S — ○ EXISTING SEWER
 — ● — PROPOSED SEWER

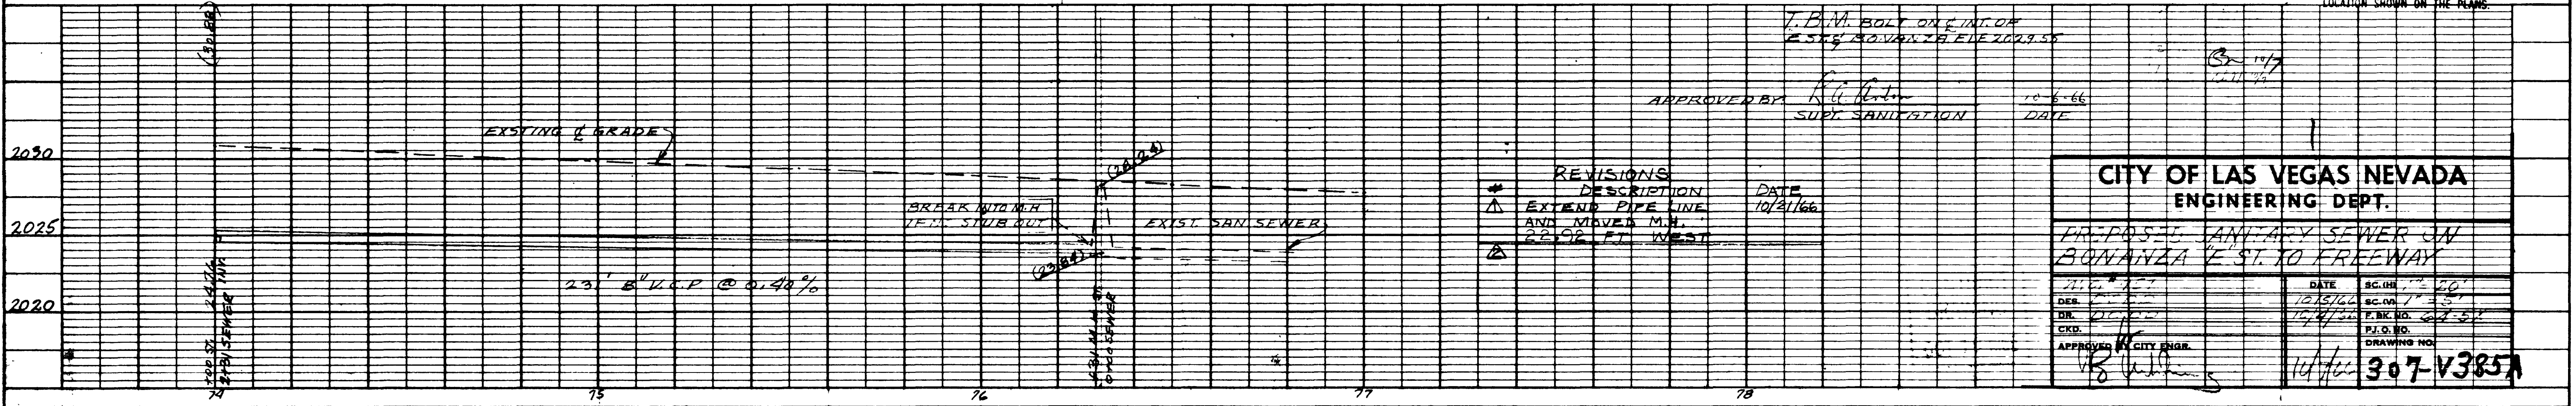

I.B.M. BOLT ON E. INT. OF E. ST. TO BONANZA FREEWAY 2029.55

APPROVED BY: *R.G. Kerton* DATE: 10-6-66
 SUPV. SANITATION

REVISIONS	DESCRIPTION	DATE
1	EXTEND PIPE LINE AND MOVE M.H. 22.02 FT. WEST	10/31/66

CITY OF LAS VEGAS NEVADA
 ENGINEERING DEPT.

PROPOSED SANITARY SEWER ON BONANZA E. ST. TO FREEWAY

DATE	10/15/66	SC. INCH	1" = 20'
DR.	DR. [Signature]	F. BK. NO.	27-57
CKD.		P.J.O. NO.	
APPROVED BY CITY ENGR.	[Signature]	DRAWING NO.	307-V3857