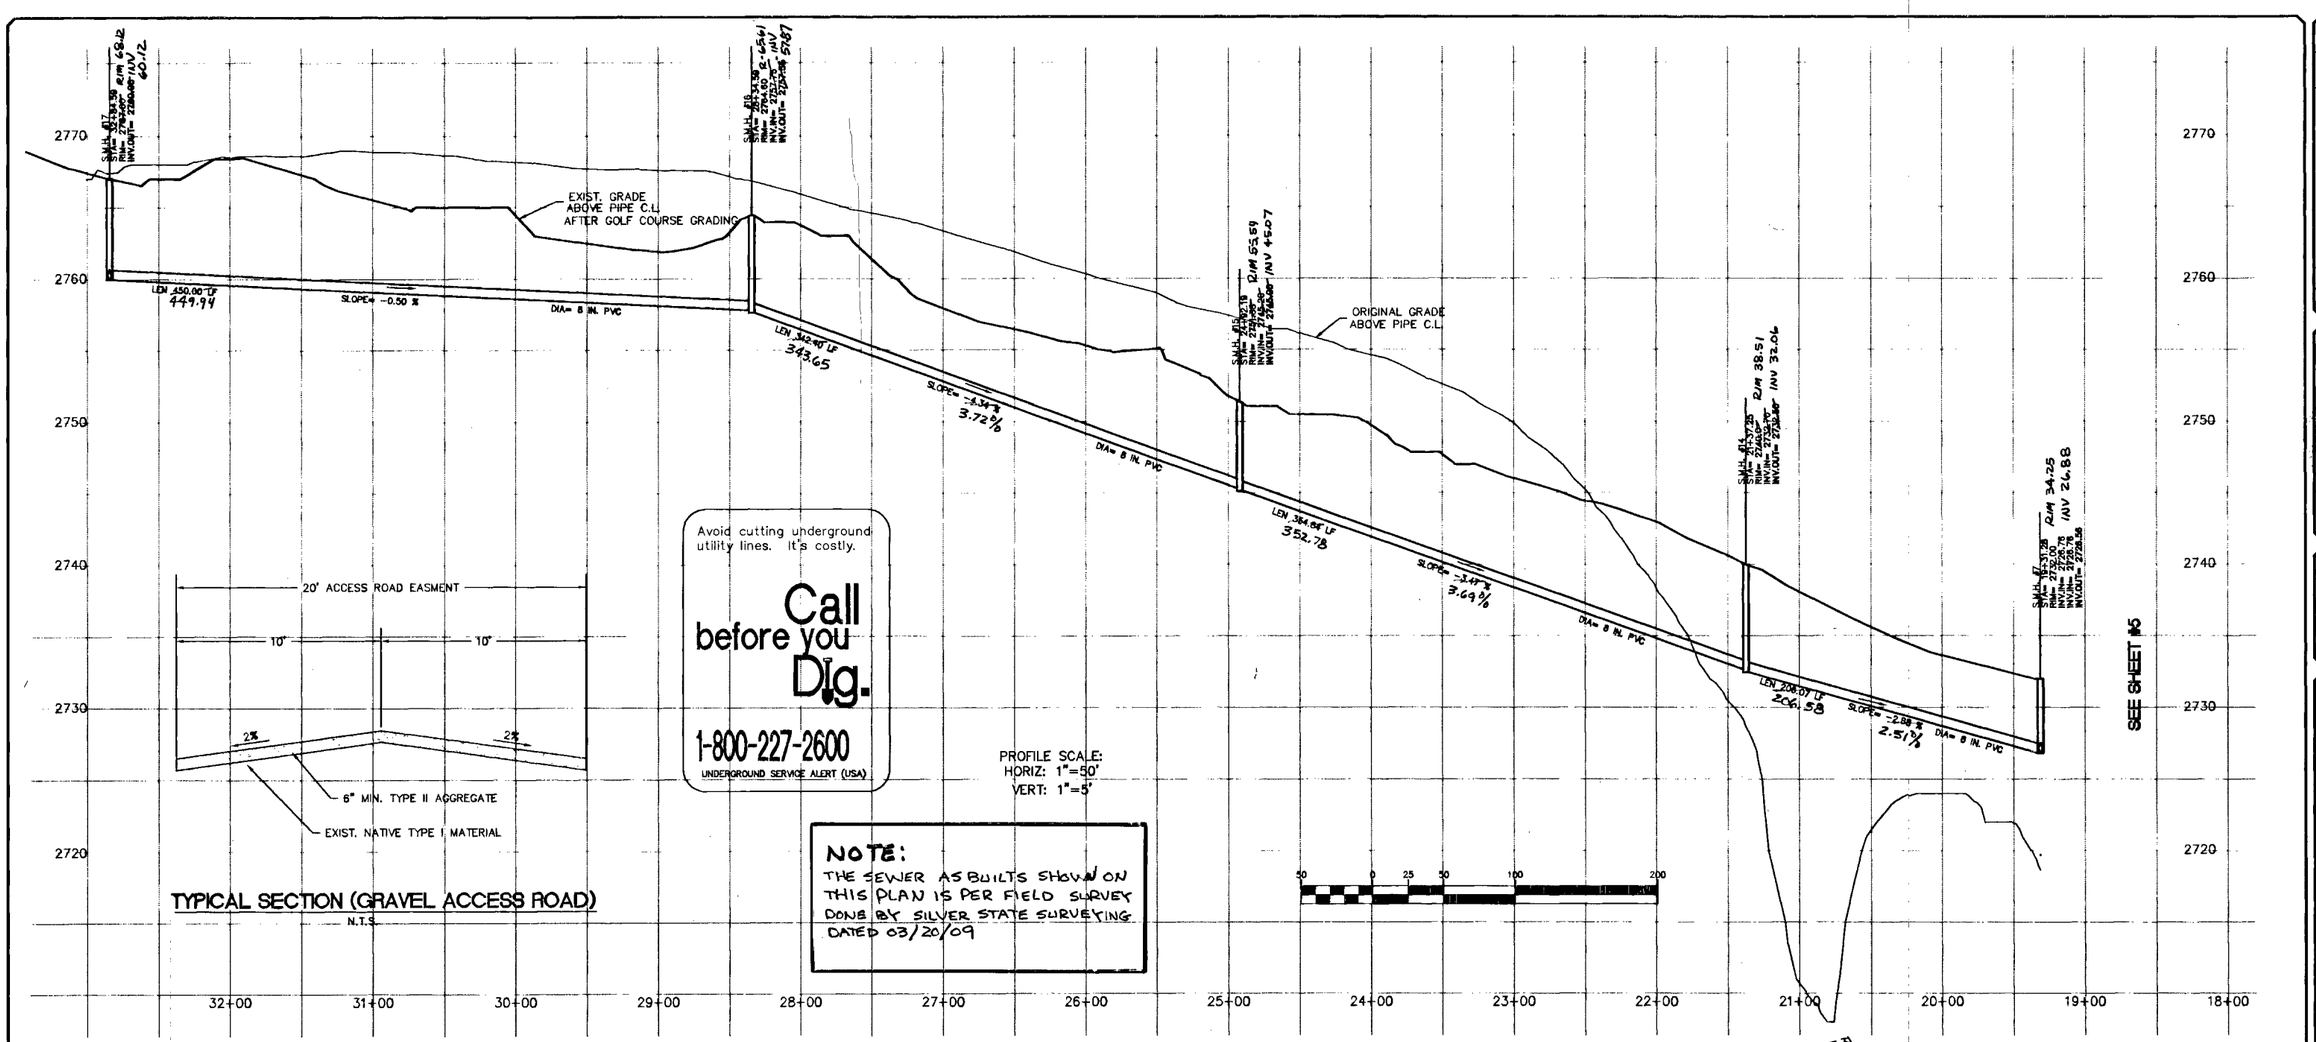

TYPICAL SECTION (GRAVEL ACCESS ROAD)
N.T.S.

Avoid cutting underground utility lines. It's costly.

Call before you Dig.

1-800-227-2600

UNDERGROUND SERVICE ALERT (USA)

NOTE:
THE SEWER AS BUILTS SHOWN ON THIS PLAN IS PER FIELD SURVEY DONE BY SILVER STATE SURVEYING DATED 03/20/09

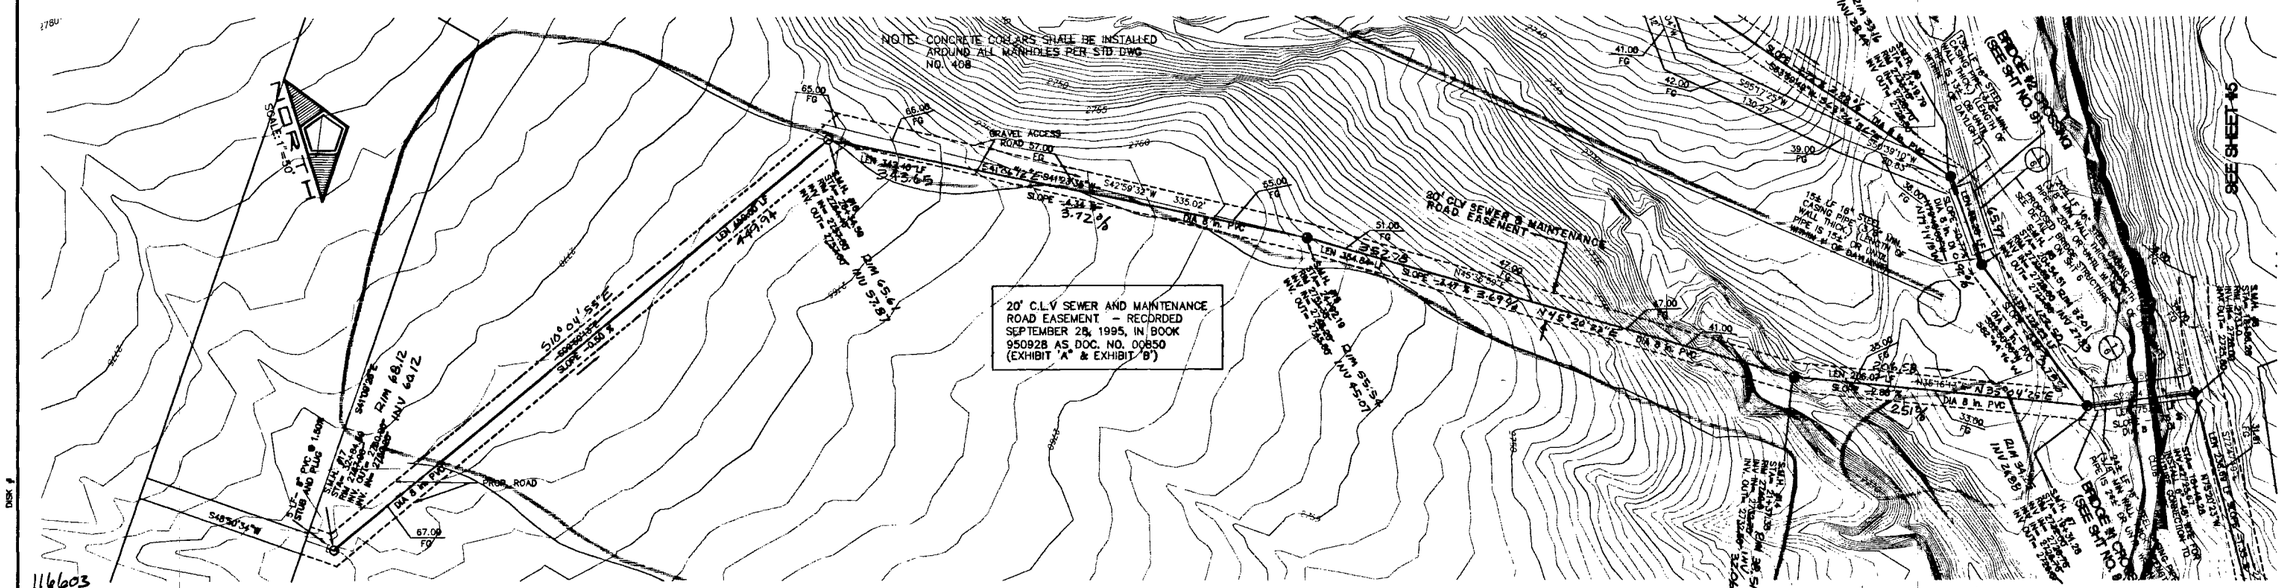

NO.	DESCRIPTION	DATE	APP'D

RECOMMENDED:
DANIEL LA RUBIA, JR.
R.E. # 16425
11-13-95
DATE

DATE : OCT.MARCH-95
DRAWN BY :
DESIGNED BY :
CHECKED BY :
JOB NO. : 145.0012
SCALE : 1"=50'

PENTACORE
Engineering, Inc.
6763 West Charleston Boulevard
Las Vegas, Nevada 89102
(702) 258-0115

PECCOLE NEVADA CORP.
PECCOLE WEST
GOLF COURSE SEWER
PLAN AND PROFILE

SHEET 7 OF 9

2058

AS CONSTRUCTED 307-V737-1