

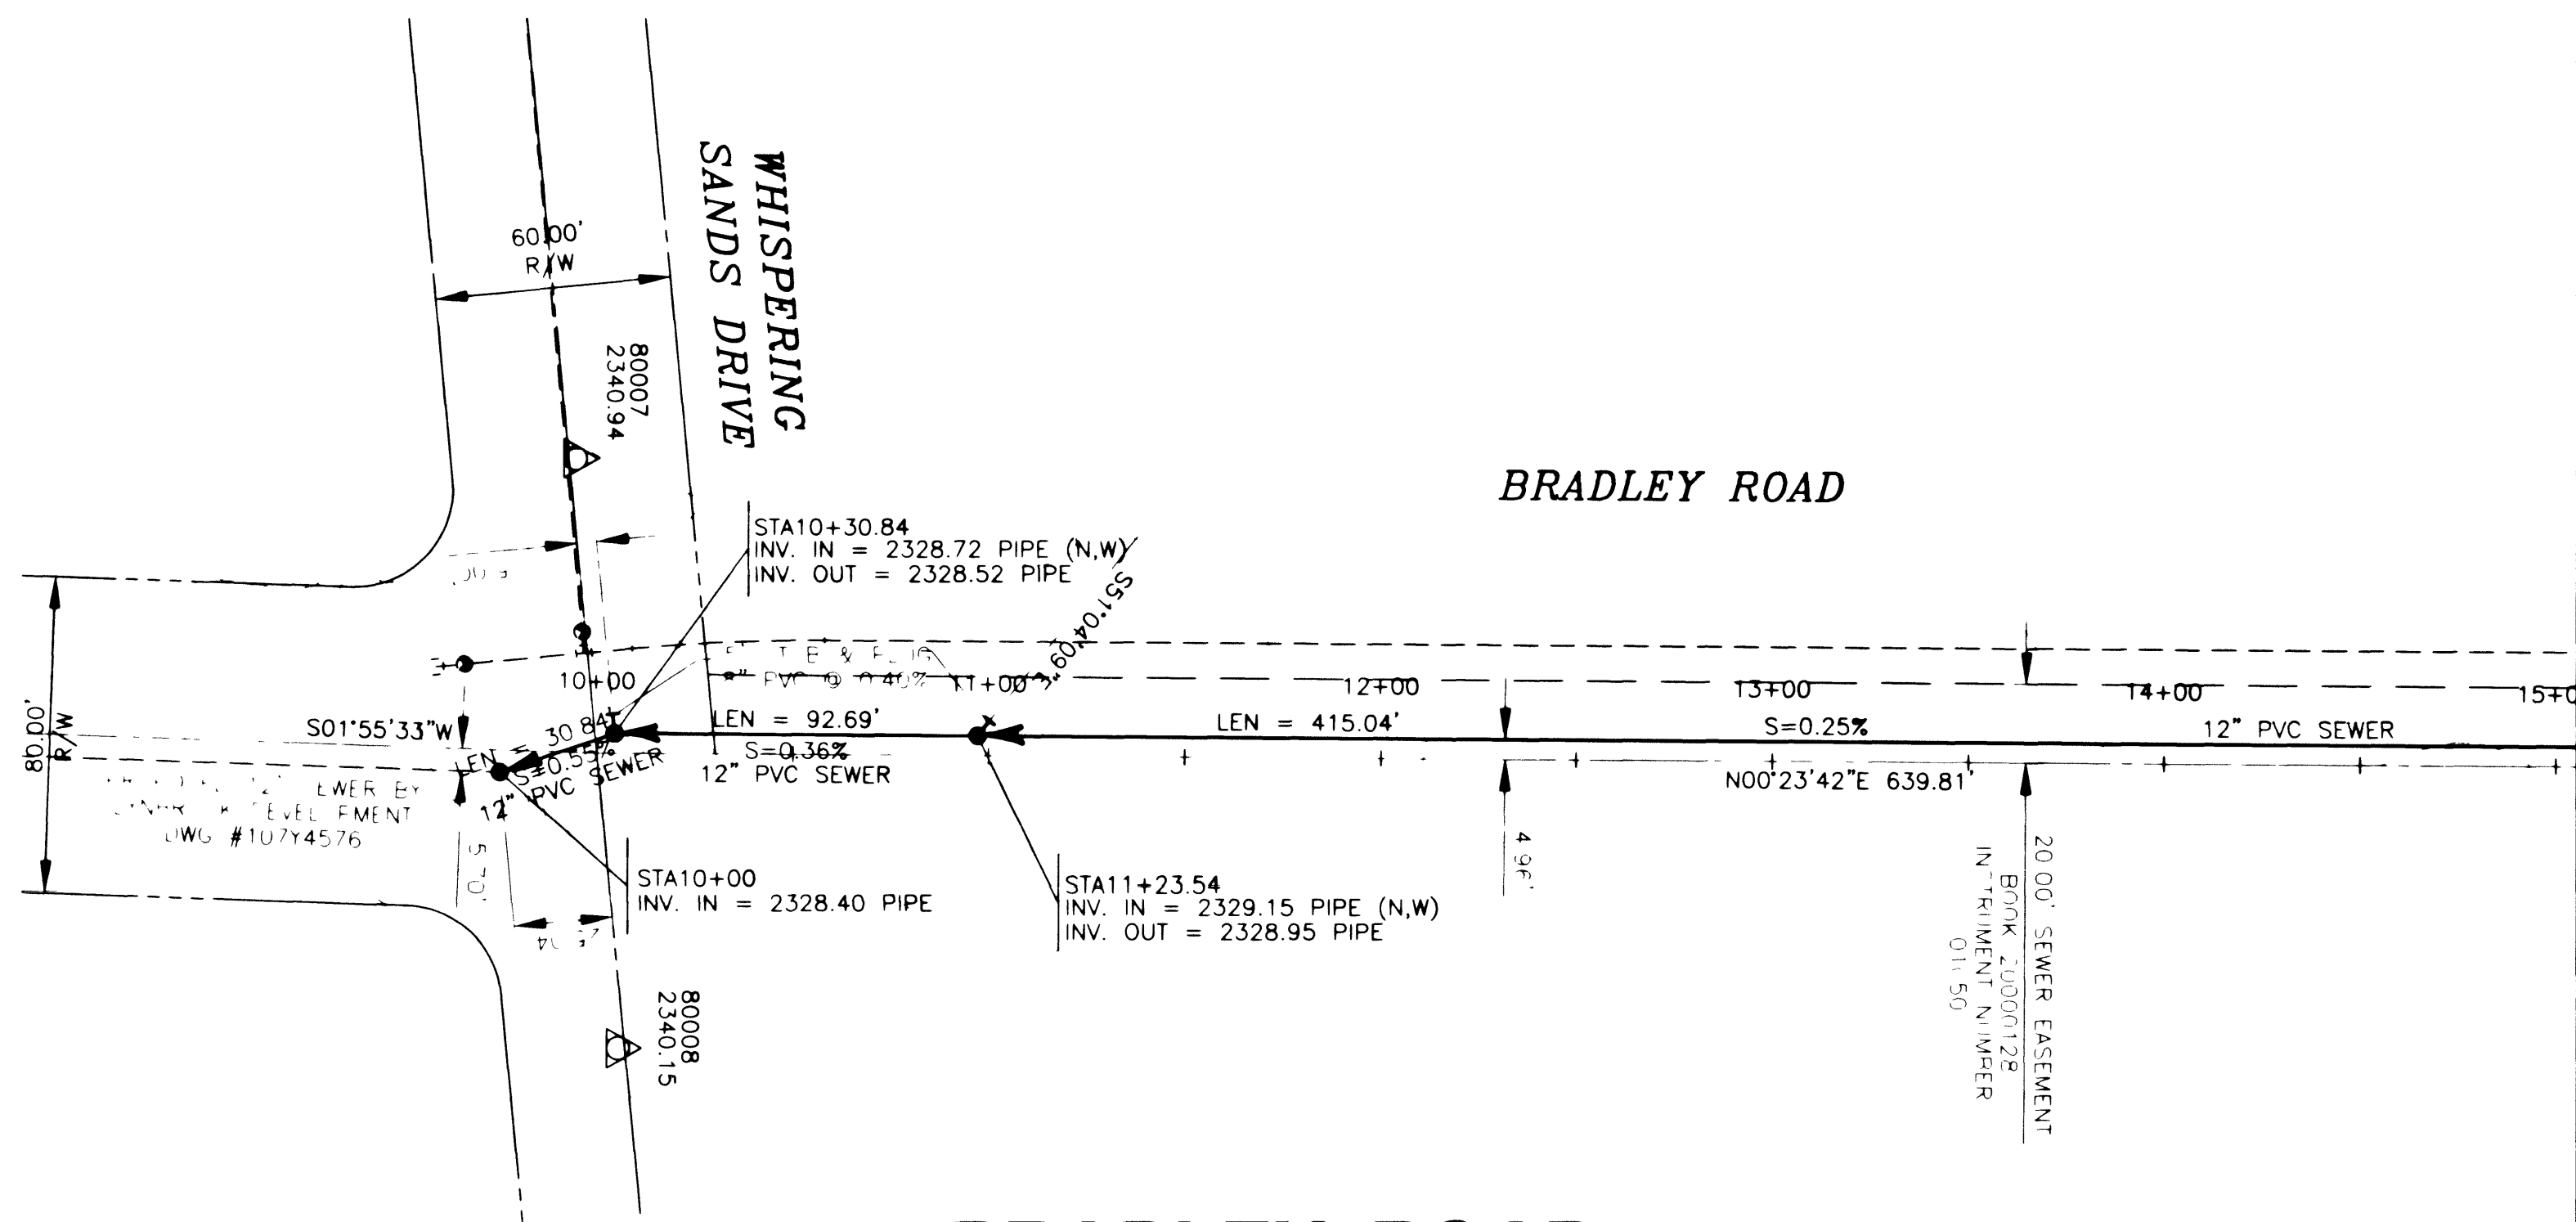


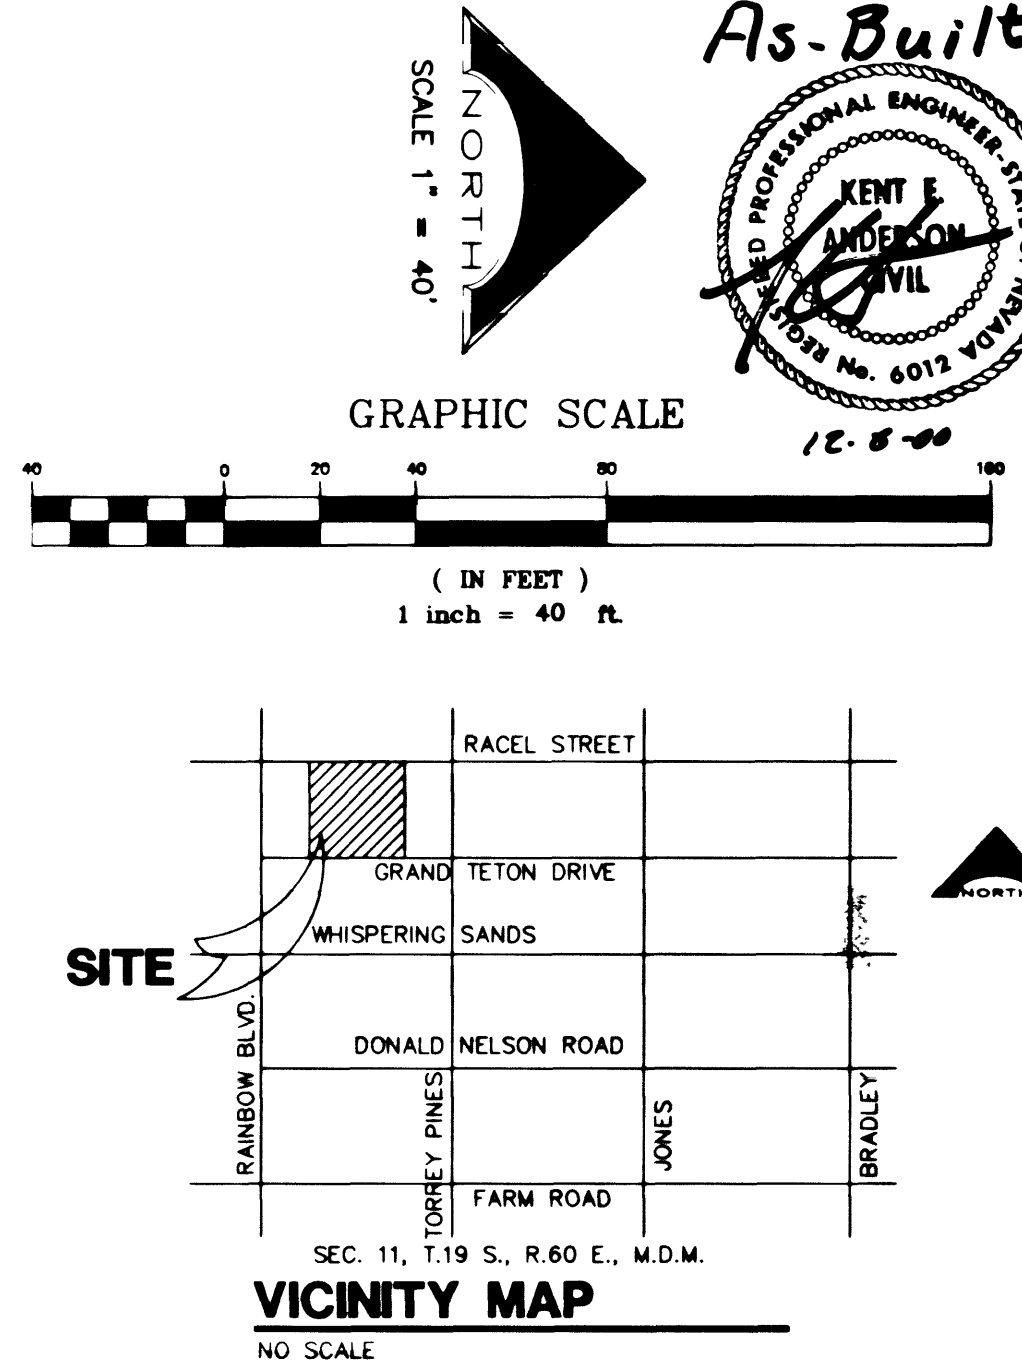

BRADLEY ROAD
FROM STA. 10+00 TO STA. 15+00

SEE SHEET 10 OF 11

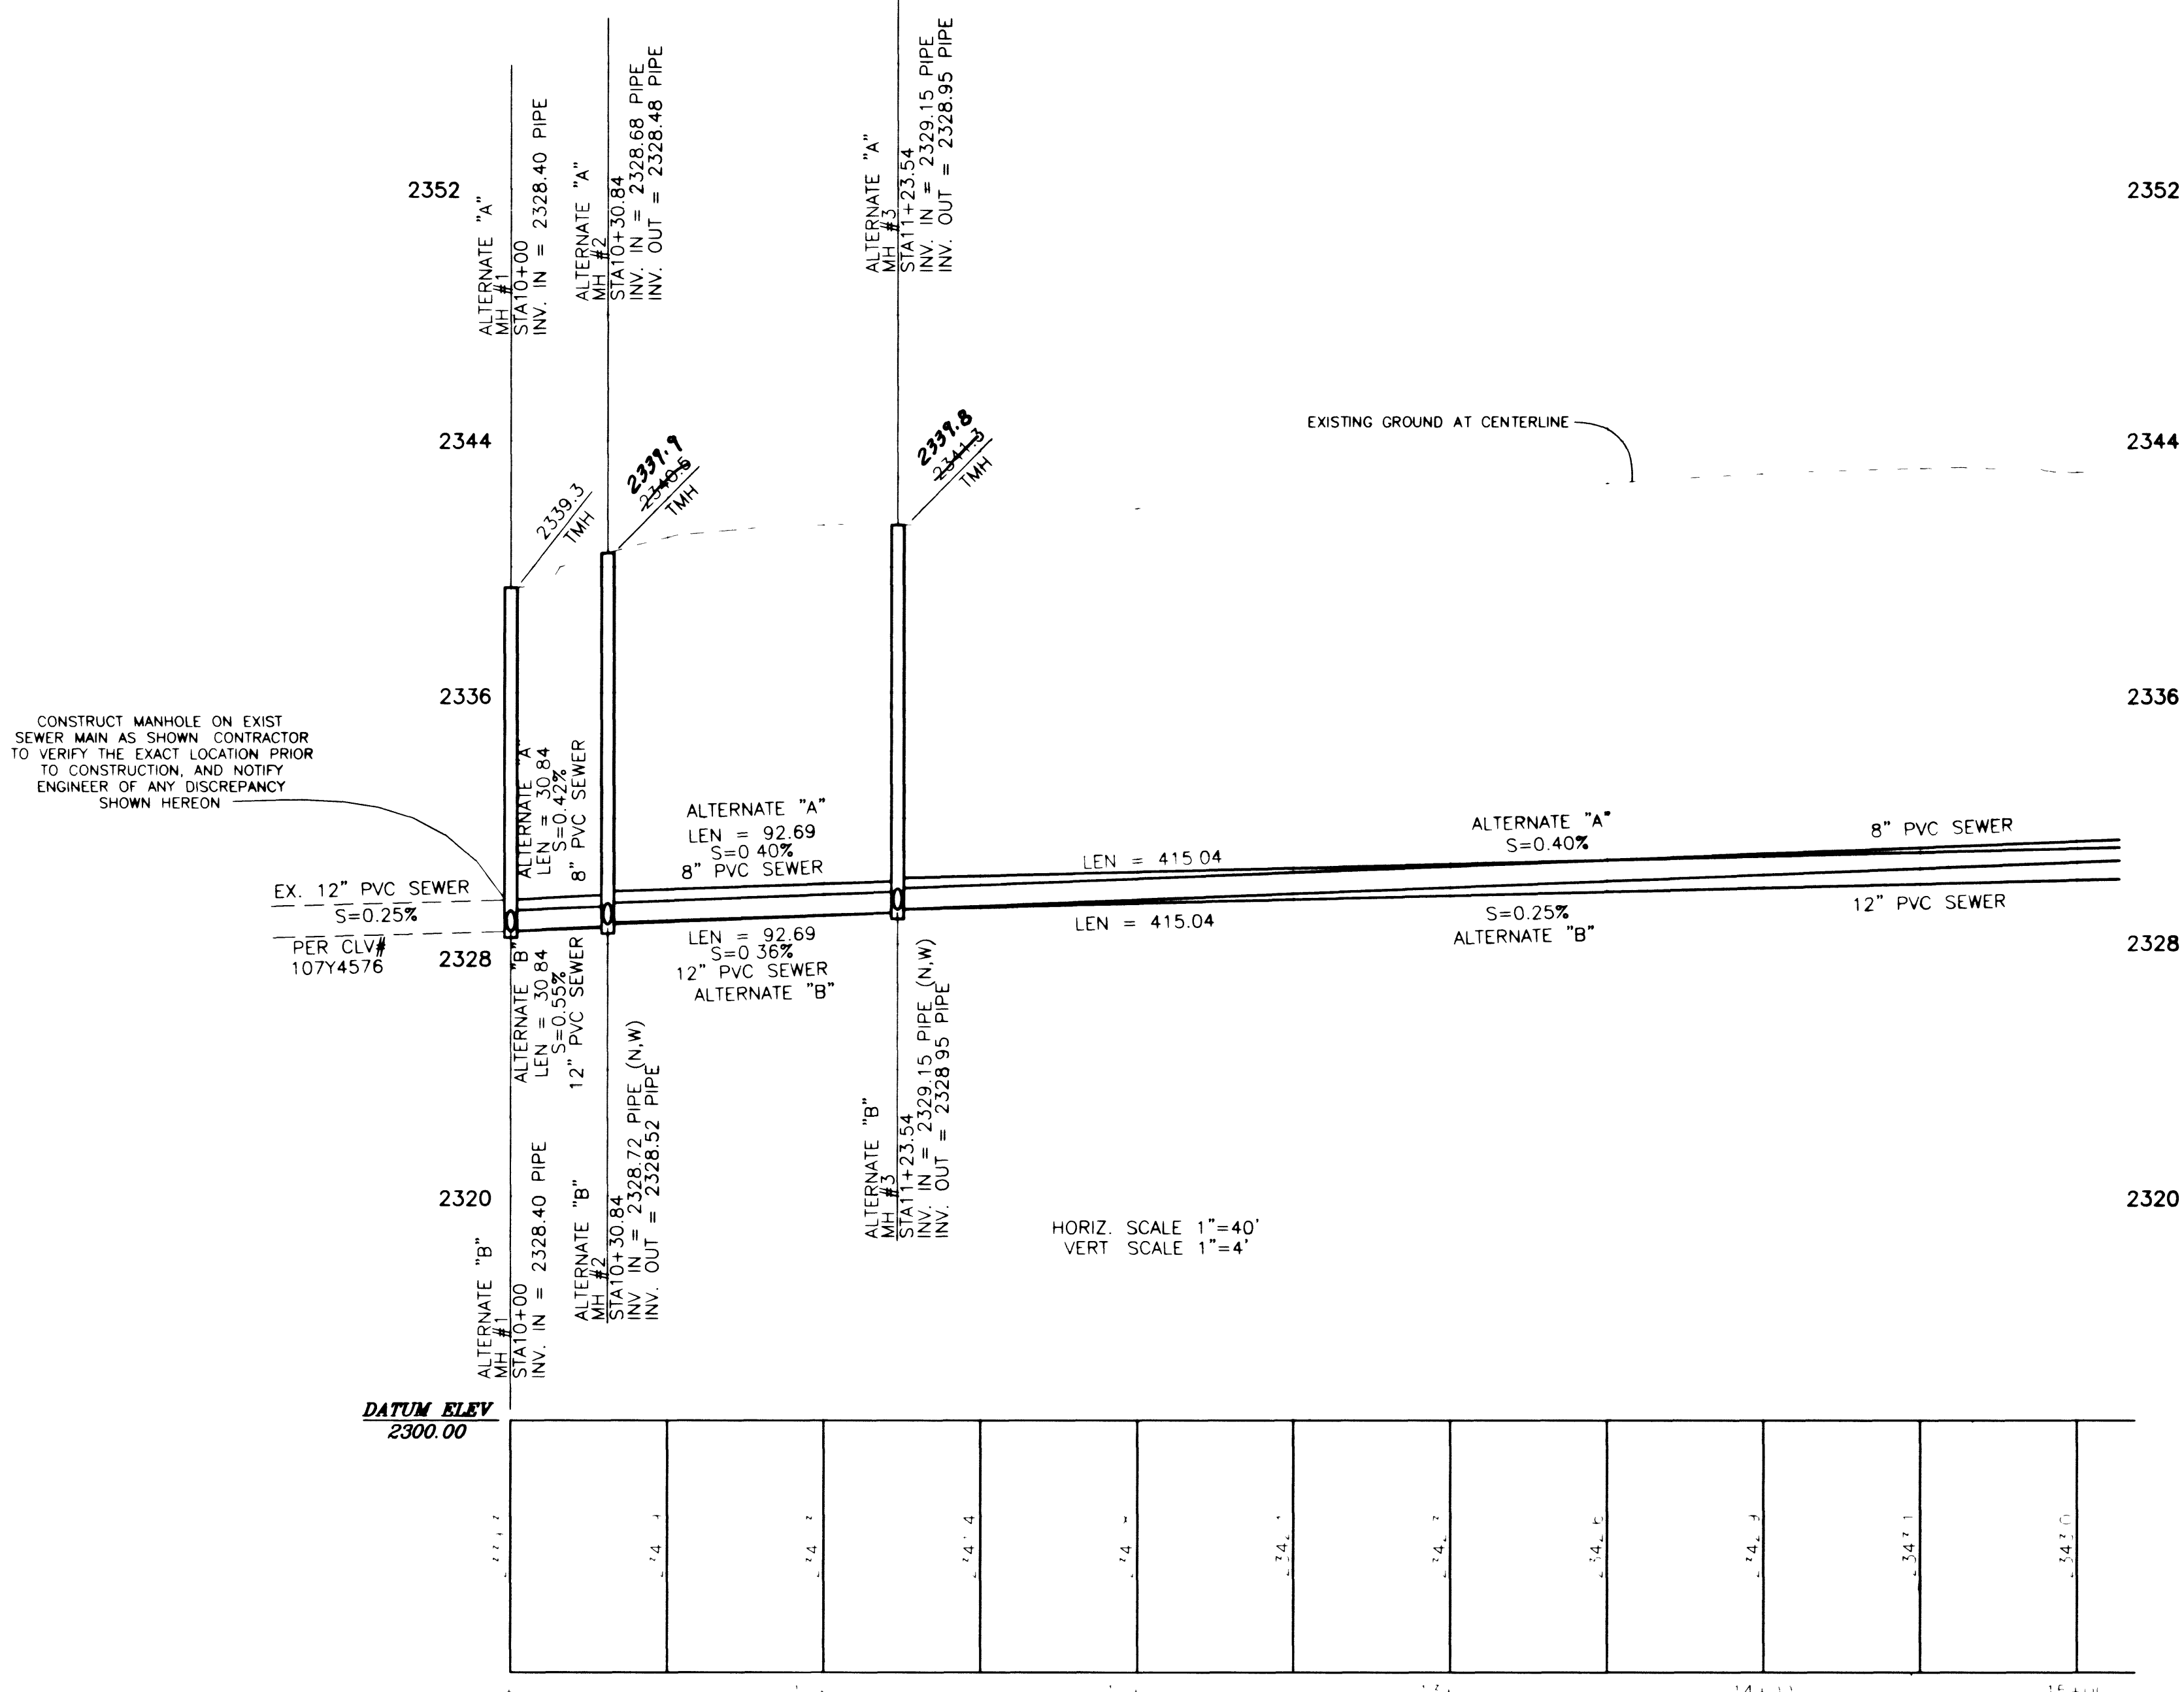


NOTE:
ALTERNATE "A" FOR
BIDDING PURPOSES ONLY.

BASIS OF BEARINGS
SOUTH 89°11'27" EAST BEING THE SOUTH LINE OF THE SOUTHWEST QUARTER (SW 1/4) OF SECTION 11, TOWNSHIP 19 SOUTH, RANGE 60 EAST, M.D.M., CLARK COUNTY NEVADA, AS SHOWN ON A MAP ON FILE IN THE COUNTY RECORDER'S OFFICE AS FILE 73, PAGE 14 OF PARCEL MAPS.

BENCHMARK
1LV90 14N4
ELEVATION = 2371.13 FEET (NAVD '88)
BLM BRASS CAP, GRAND TETON DRIVE & TORREY PINES DRIVE.

DISCLAIMER NOTE
UTILITY LOCATIONS SHOWN HEREON ARE APPROXIMATE ONLY. IT SHALL BE THE CONTRACTOR'S RESPONSIBILITY TO DETERMINE THE EXACT HORIZONTAL AND VERTICAL LOCATION OF ALL EXISTING UNDERGROUND UTILITIES PRIOR TO COMMENCING CONSTRUCTION. NO REPRESENTATION IS MADE THAT ALL EXISTING UTILITIES ARE SHOWN HEREON. THE ENGINEER ASSUMES NO RESPONSIBILITY FOR UTILITIES NOT SHOWN OR UTILITIES NOT SHOWN IN THEIR PROPER LOCATION.

Call before you Dig
1-800-227-2600
UNDERGROUND SERVICE (USA)

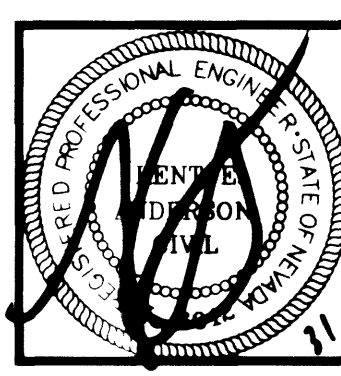

DESIGNED BY:	MOB	DRAWN BY:	MOB	CHECKED BY:	MOB
NO.		NO.		NO.	
REVISION		REVISION		REVISION	
DATE		DATE		DATE	
APPL		APPL		APPL	

L. R. NELSON CONSULTING ENGINEERS, INC.
• STRUCTURAL
• CIVIL
• SURVEY
3035 East Patrick Lane Suite 9
Las Vegas, Nevada 89120
(702) 798-7978
(702) 451-2296 FAX

OFF-SITE SEWER LINE FOR STEEPLECHASE
PLAN & PROFILE
CITY OF LAS VEGAS NEVADA

SHEET NUMBER
11
OF 11 SHEETS
333-120-982

2886

307-VJ37