


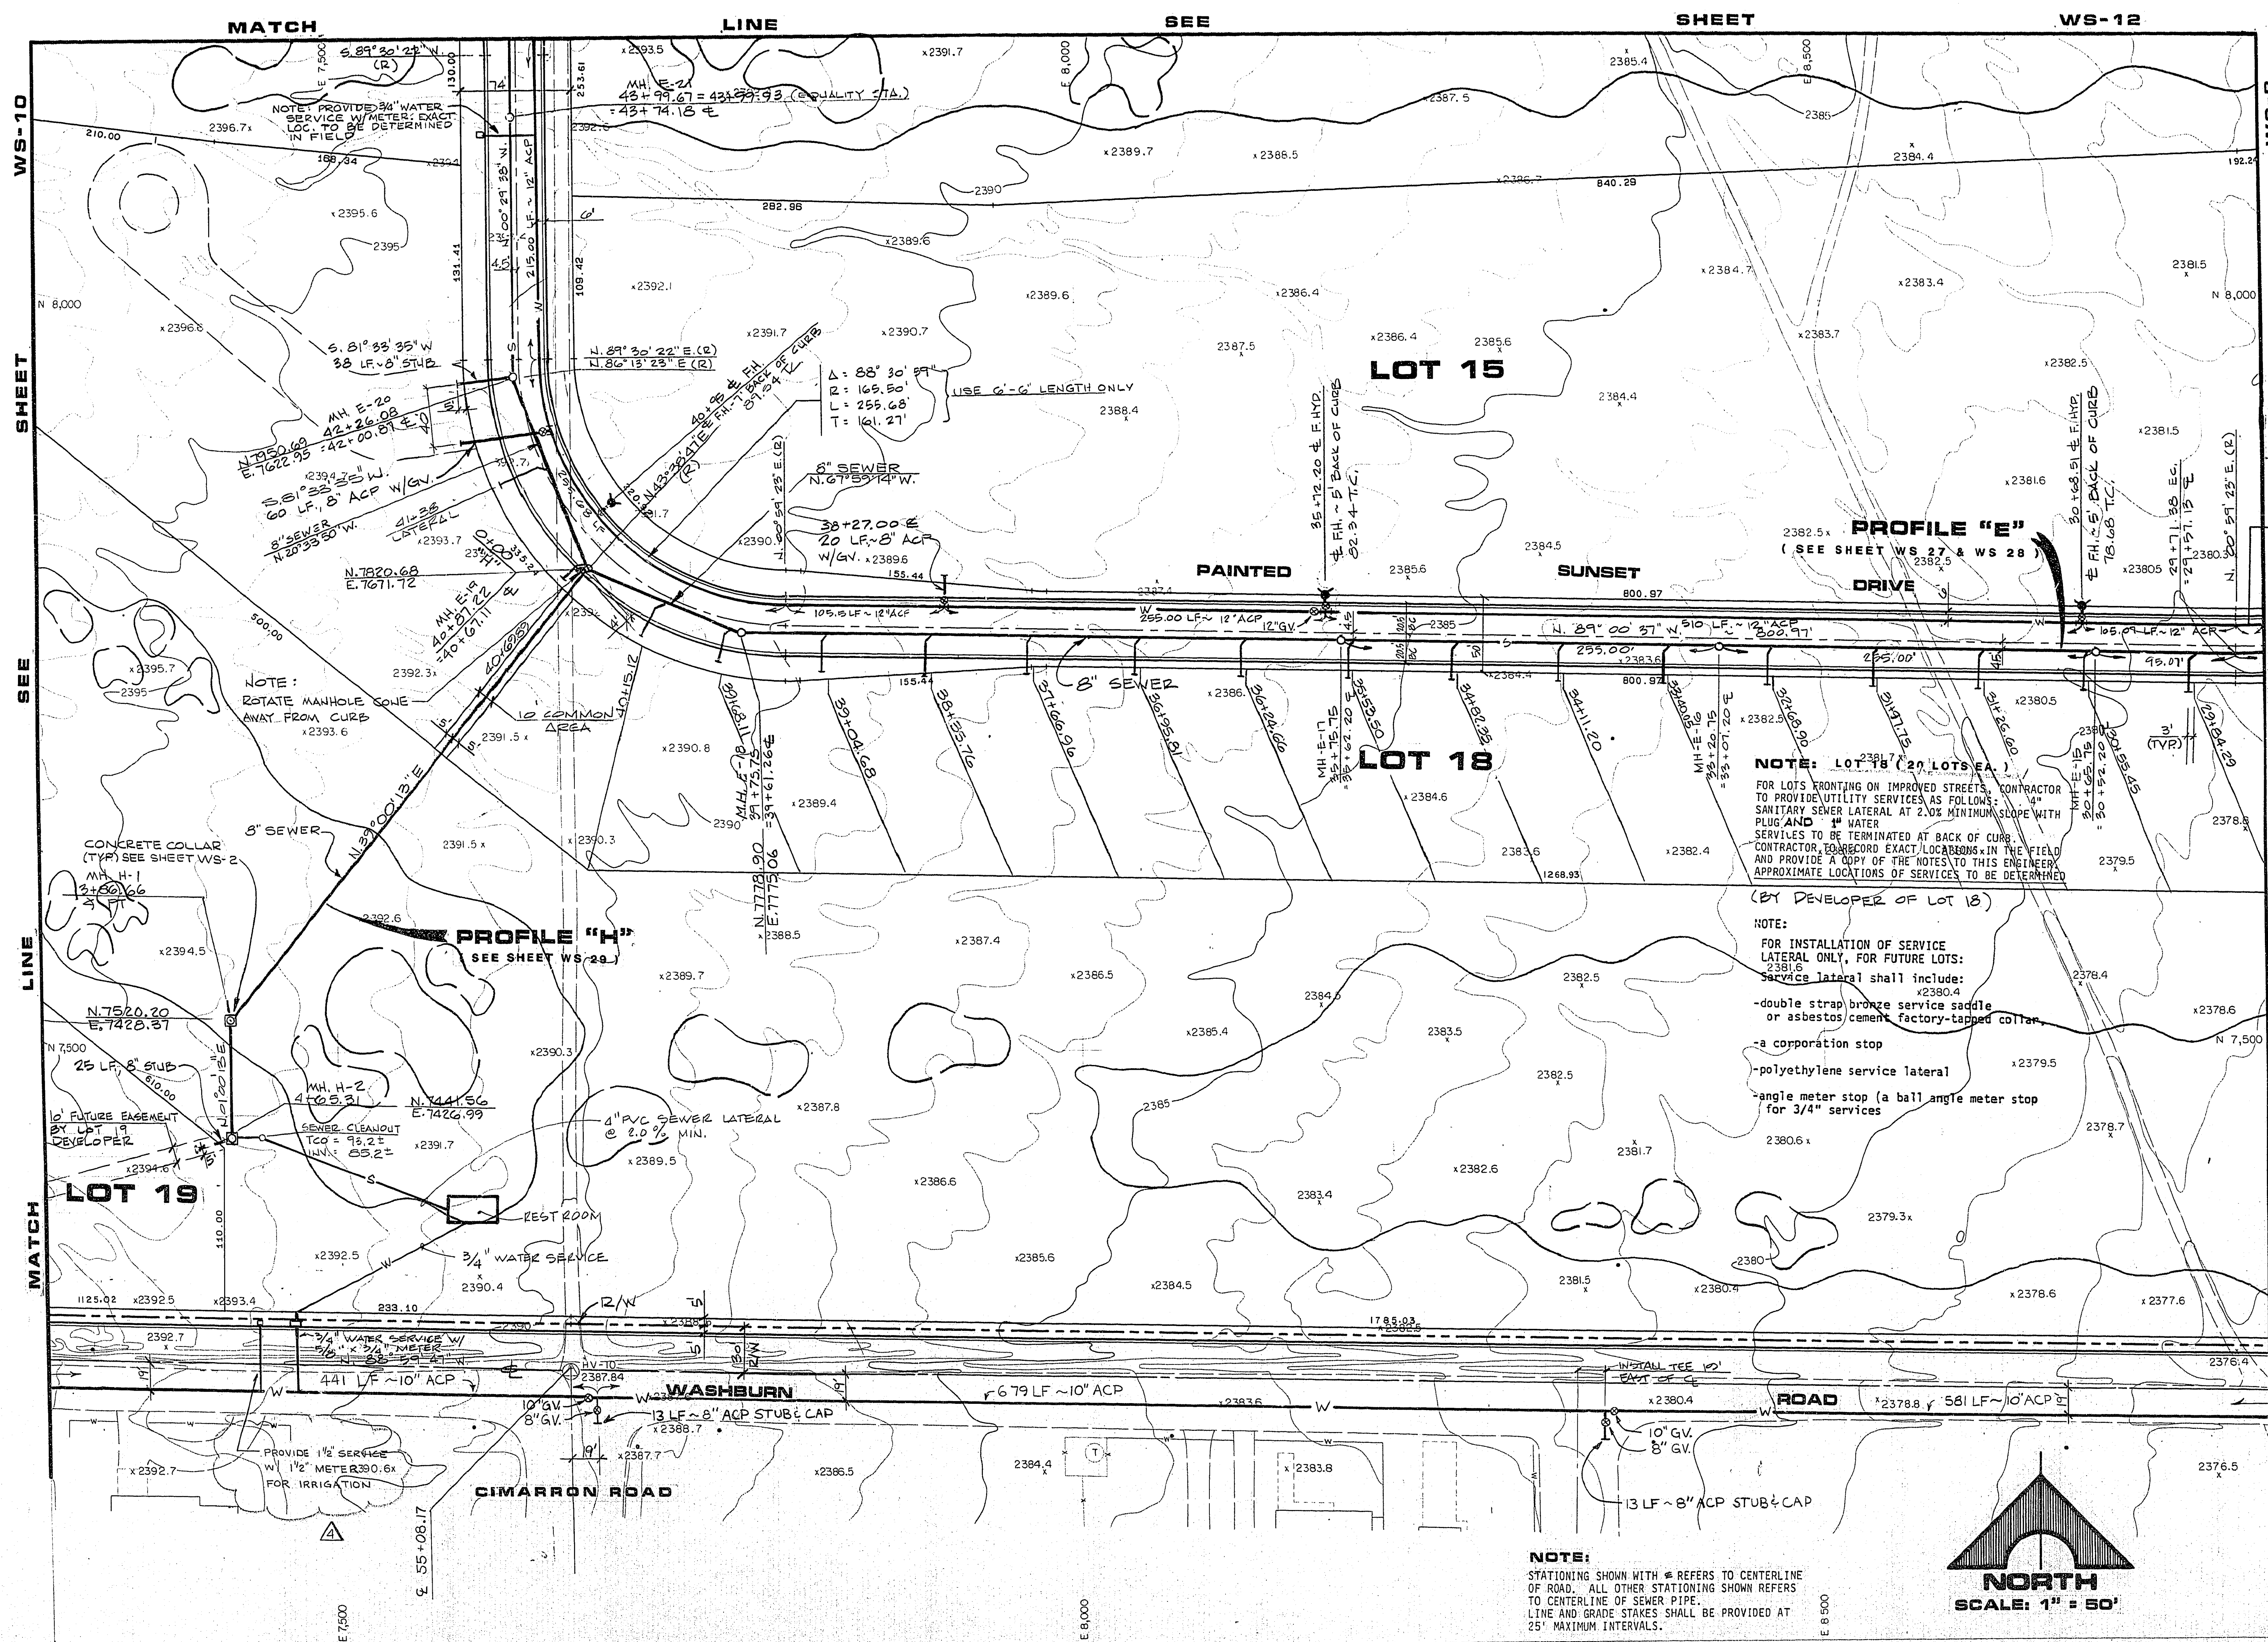

SEE COVER SHEET
CIV. CHIEF LAND DEVELOPMENT

DATE _____

H.B.C. INVESTMENTS, INC.

PAINTED DESERT

PHASE II

WATER AND SEWER PLAN

SHEET
WS
9

OF 30 SHEETS

1555 SOUTH RAINBOW BLVD., LAS VEGAS, NEVADA 89102

983 - 1200

G.C. WALLACE, INC.
Engineering/Architecture

REV	DATE	DESCRIPTION
1	1/2/59	REVERSE WATER LINE DESIGN
2	1/16/60	REV. SERVICE DESIGN PROFILES & C/H
3	1/14/60	R.E. NO. 100
4	2/5/61	REV. MAIN DRAIN 30" DIA. TO 10"
5	2/5/61	REV. MAIN DRAIN 30" DIA. TO 10"
