



PALM TREE PLANTING

C

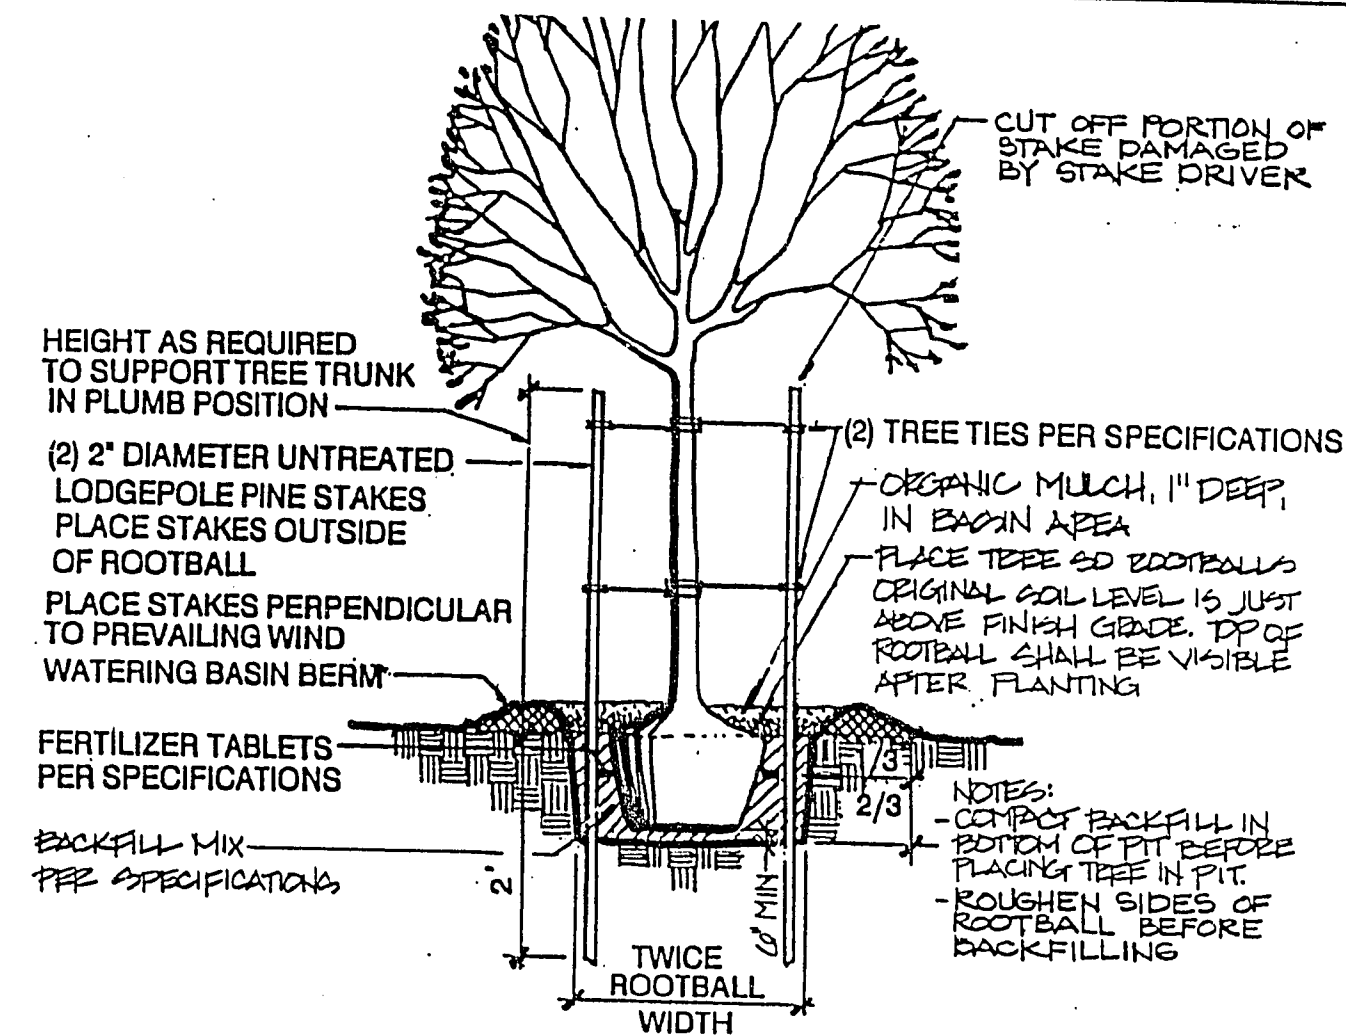

TREE PLANTING/STAKING

B

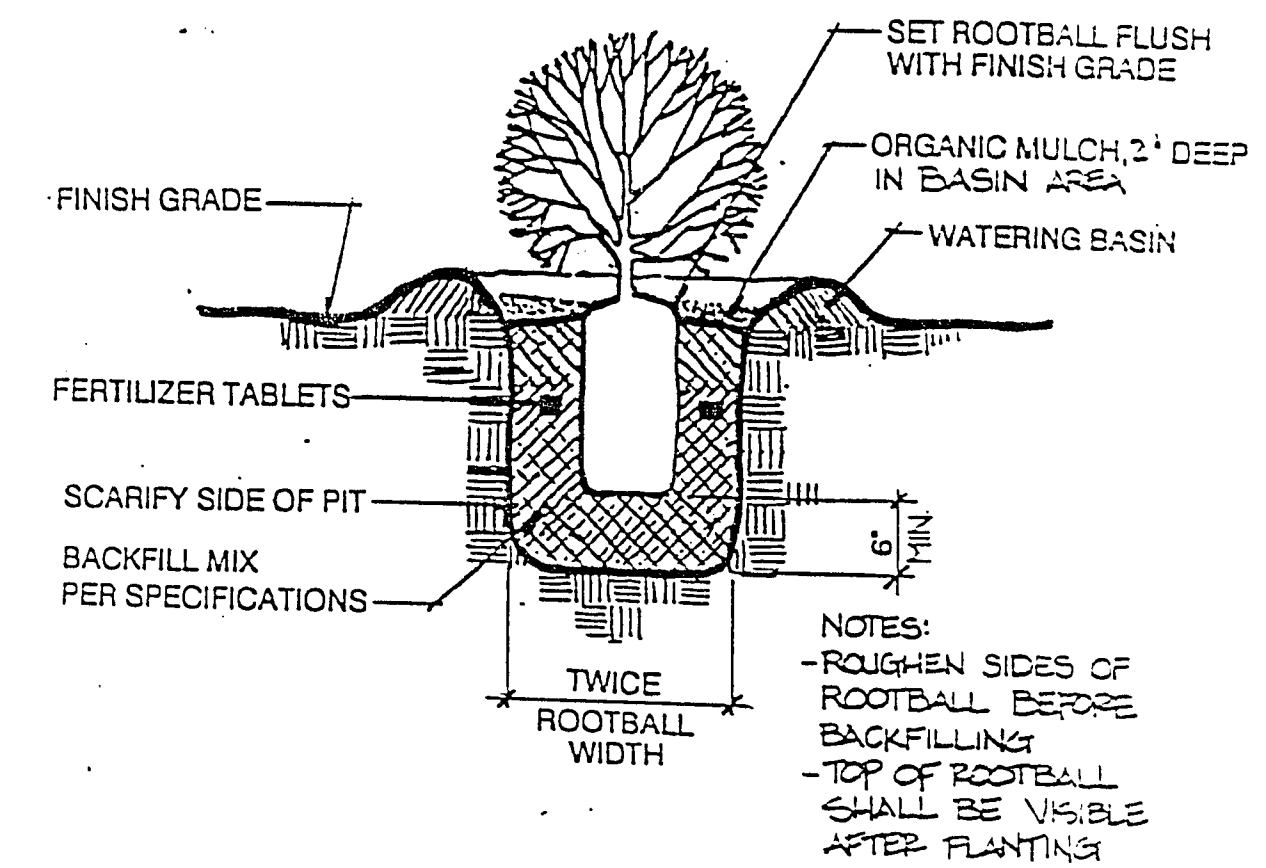

SHRUB PLANTING

A

REISSUED 10-16-92 WITHOUT REVISION

REVISIONS
REV. DATE BY
1-20
1-20
1-20

MARK	DATE	BY	REVISION


DESIGNED: CVT

DRAWN: CVT

CHECKED: TU

PROJECT ENGINEER _____ DATE _____

PROJECT MANAGER _____ DATE _____

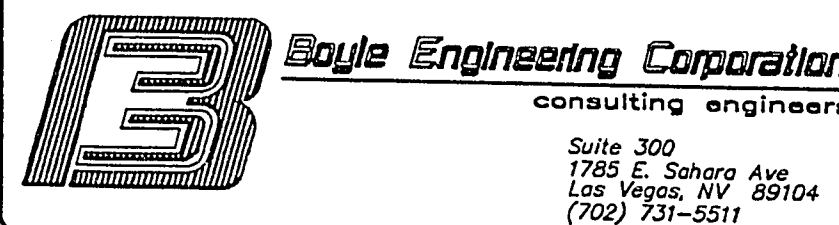

CITY OF LAS VEGAS
DEPARTMENT OF PUBLIC WORKS

OGDEN AVENUE UNDERPASS AND ROADWAY

PLANTING DETAILS

**RECORD
DRAWINGS**

CLV DRAWING NO. 107-V2011

DRAWING

L4

OF 125

OGD-L4

3-2-126