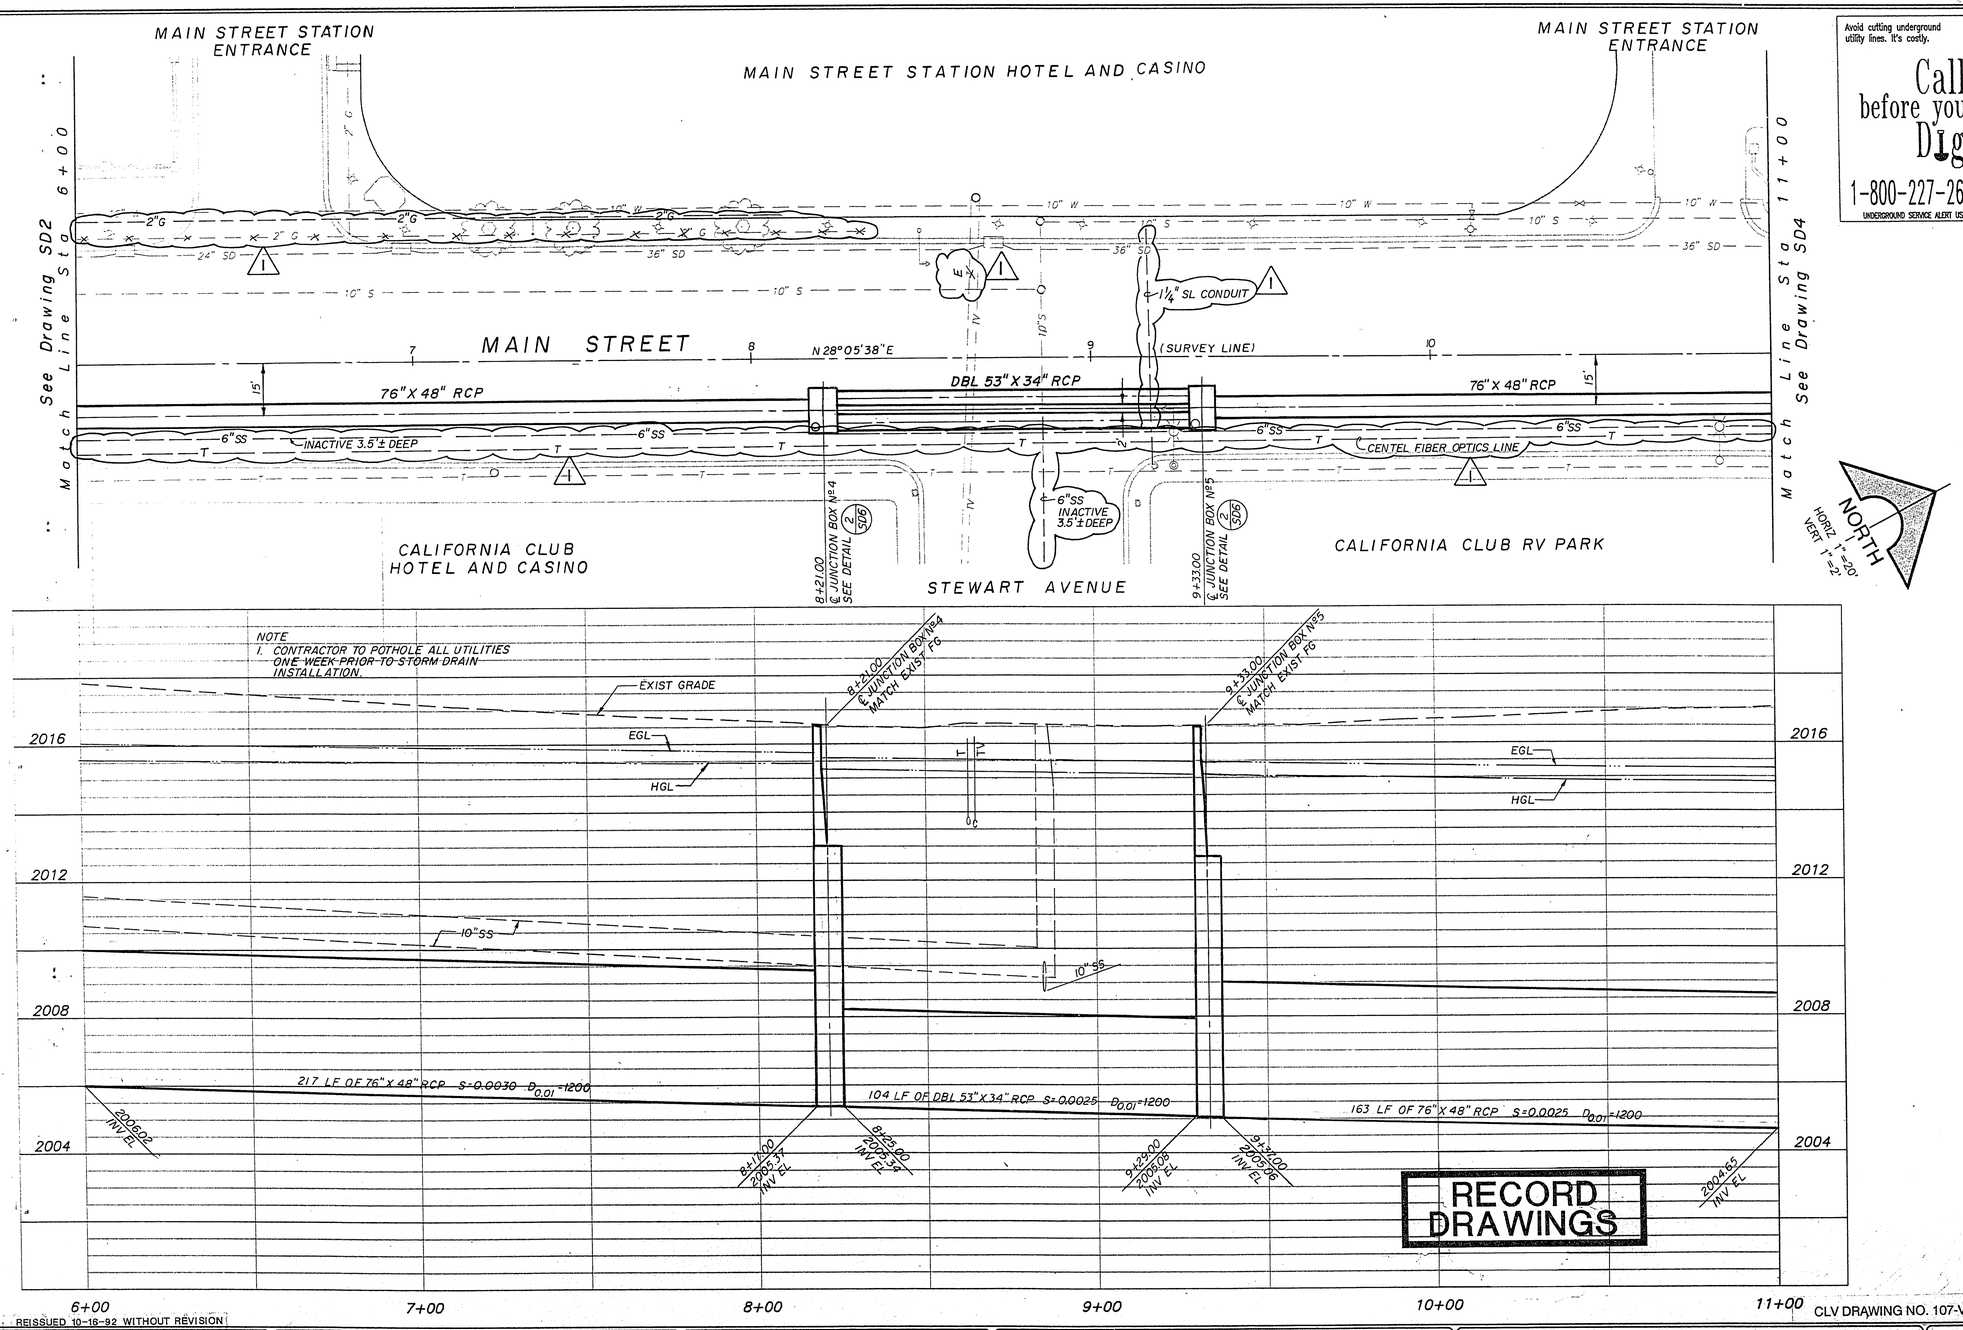

Avoid cutting underground utility lines. It's costly.

Call before you Dig.

1-800-227-2600

UNDERGROUND SERVICE ALERT USA

RECORD DRAWINGS

REISSUED 10-16-92 WITHOUT REVISION

CLV DRAWING NO. 107-V201.1

MARK	DATE	BY	REVISION
1	10/3/94	BE	RECORD DRAWINGS

DESIGNED: JPM
DRAWN: AH
CHECKED: GPM

PROJECT ENGINEER DATE
PROJECT MANAGER DATE

Boyle Engineering Corporation
consulting engineers
Suite 300
1785 E. Sahara Ave
Las Vegas, NV 89104
(702) 731-5511

CITY OF LAS VEGAS
DEPARTMENT OF PUBLIC WORKS

OGDEN AVENUE UNDERPASS AND ROADWAY

MAIN STREET STORM DRAIN
PLAN & PROFILE

DRAWING SD3
25 OF 125

3-2-96